



SITE STATISTICS				
ITEM		PROPOSED		
LOT FRONTAGE	11.6 m	38'-1"		
LOT AREA	313.20 sq,m	3371.28 sq, ft.		
MAX. ALLOWABLE COVERAGE (%)		55		
BUILDING COVERAGE CALCULATION	COVERAGE W/O PORCH		142.50 sq,m	
	LOT COVERAGE		45.50 %	
BUILDING HEIGHT CALCULATION	FIN. FLOOR ELEV.	AVG. (EST.) GRADE	FF TO AVG. GRADE	FF TO MEAN OF ROOF
	293.14	292.07	1.07	7.54 m
	PROP. BUILDING HEIGHT 5.61 m 28'-3"			
MAX BUILDING HEIGHT		12m FROM AVG. GRADE TO MEAN		

FRONT YARD LANDSCAPE AREA	
FRONT YARD AREA :	54.35 m2
DRIVEWAY AREA:	31.25 m2
COVERED PORCH AREA:	5.19 m2
SOFT LANDSCAPE AREA :	28.29 m2
LANDSCAPE / OPEN SPACE:	52.05 %

City File D19-20001	
MODEL NO.	3813
HOUSE STYLE (I.E. BUNGALOW, WALKOUT ETC.)	2 STOREY
BUILDING CLASSIFICATION	GROUP C
	-



Richmond Hill City of Richmond Hill Building Division  
**ZONING REVIEWED**  
Initials: **BH**

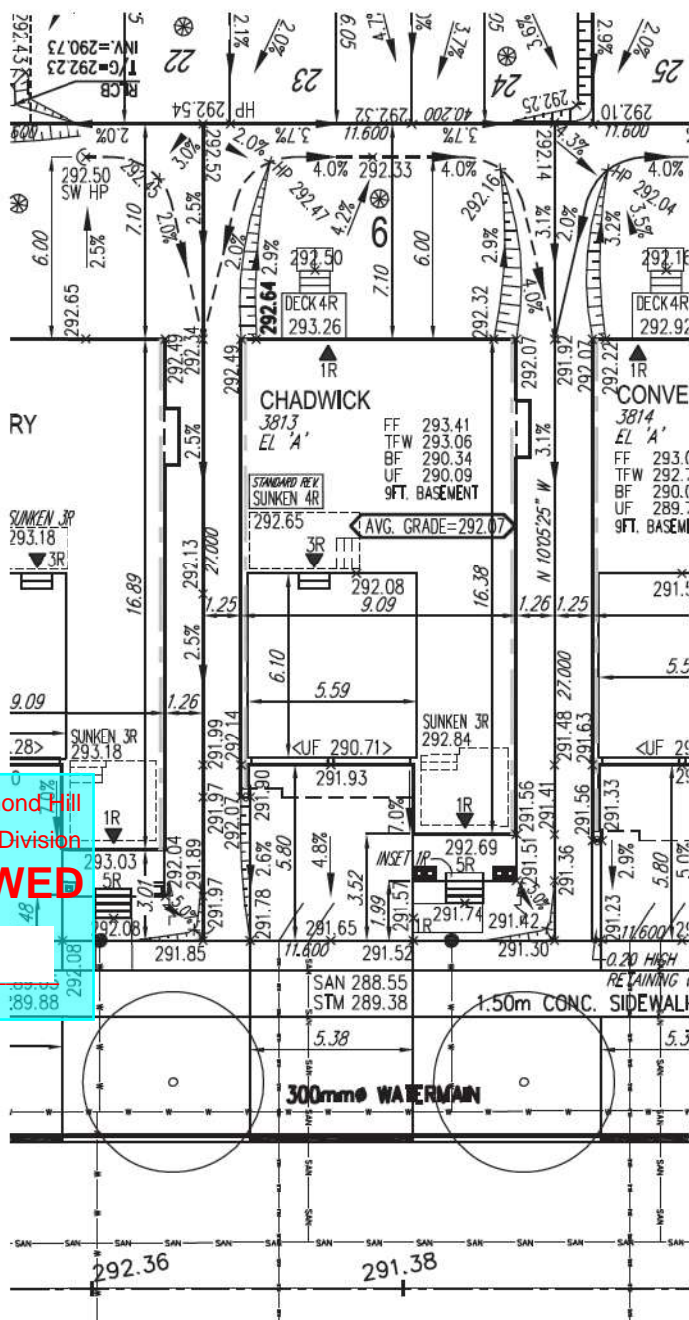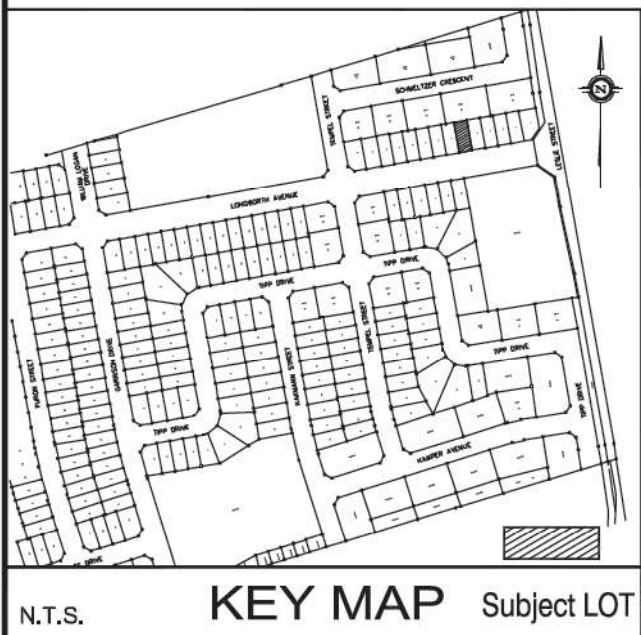

LONGWORTH AVENUE

CITY OF RICHMOND HILL  
BUILDING DIVISION

03/10/2022

RECEIVED

Per: joshua.nabua

W Architect Inc.  
DESIGN CONTROL REVIEW  
FEBRUARY 07, 2022

FINAL BY: GGE

This stamp is only for the purposes of design control and carries no other professional obligations.

REVIEWED ONLY AS TO GENERAL COMPLIANCE WITH THE INTENT OF THE GRADING AND SERVICING DRAWINGS. THE ENGINEER DOES NOT WARRANT THAT THE INFORMATION CONTAINED ON THIS PLAN IS EITHER ACCURATE OR CORRECT. SOLE RESPONSIBILITY FOR CORRECT DESIGN, DETAILS AND DIMENSIONS WILL REMAIN WITH THE PARTY SUBMITTING THE DRAWING

- ☒ REVIEWED  
☐ REVIEWED AS NOTED  
☐ REVISE AND RESUBMIT

The MUNICIPAL INFRASTRUCTURE Group Ltd.

Date: Feb 03, 2023 By: Abdul Ahmadzai

GENERAL NOTES:

- BUILDER TO VERIFY LOCATION OF UTILITIES AND OTHER SERVICES. IF MIN. DIMENSIONS ARE NOT MAINTAINED, BUILDER IS TO RELOCATE AT BUILDER'S EXPENSE.
- BUILDER TO VERIFY ELEV. OF STM. AND SAN. LATERALS IN RELATION TO BASEMENT U/S OF FOOTING ELEVATIONS FOR COMPLIANCE WITH MUNICIPAL STANDARDS PRIOR TO EXCAVATION.
- APPROVED PERMIT DRAWINGS & CONSTRUCTION NOTES MUST BE REVIEWED AND FOLLOWED IN CONJUNCTION WITH THE SITING AND GRADING PLAN. BUILDER TO VERIFY BUILDING ENVELOPE ON SITE PLAN MATCHES APPROVED PERMIT DRAWINGS & CONSTRUCTION NOTES PRIOR TO POURING CONCRETE. IF THERE ARE ANY DISCREPANCIES, THEY ARE TO BE BROUGHT TO THE ATTENTION OF HUNT DESIGN ASSOCIATES INC.
- UNLESS NOTED ON BUILDING ENVELOPE OR APPROVED PERMIT DRAWINGS & CONSTRUCTION NOTES, ALL TOP OF FOUNDATION WALLS INCLUDING GARAGE WALLS TO BE CONSISTENT WITH THE ELEVATION PROVIDED FOR TFW ON SITING AND GRADING PLAN. THE EXTERIOR OF THE FOUNDATION WALL TO BE PROVIDED WITH A REDUCTION OF THICKNESS FOR MASONRY VENEER AS REQUIRED.

ISSUED FOR FINAL APPROVAL	MM	2022.01.13
REVISED AS PER CLIENT COMMENTS	MM	2022.01.10
ISSUED FOR FINAL APPROVAL	MM	2021.12.02
ISSUED FOR PRELIMINARY APPROVAL	MM	2021.11.25



ENGINEERED FILL LOTS	SANITARY MANHOLE	WATER SERVICE	BELL PEDESTAL	HYDRO TRANSFORMER	SAN. SANITARY LINE	DOWNSPOUTS	FINISHED FLOOR
STREET TREE	STORM MANHOLE	HYDRO SERVICE	CABLE PEDESTAL	PADMOUNTED MOTOR	STW. STORM WATER LINE	WINDOWS PERMITTED	TOP OF FOUNDATION WALL
RETAINING WALL	VALVE & CHAMBER	SHEET DRAINAGE	HYDRO POLE	EXISTING GRADES	WATERLINE	45 MINUTE FIRE RATED WALL	BASEMENT FLOOR
CATCH BASIN	VALVE & BOX	STREET LIGHT PEDESTAL	HYDRO POLE GUY	PROPOSED GRADES	HYDRO LINE	SIDEYARD DISTANCE IS LESS	UNDERSIDE OF FOOTING
DOUBLE / SINGLE STM & SAN CONNECTION	HYDRANT	STREET LIGHT	STREET SIGN	SWALE DIRECTION	GAS LINE	THAN 1.2m TO LOT LINE	WALKOUT DECK
		TRAFFIC SIGNAL POWER PEDESTAL	COMMUNITY MAILBOX	EMBANKMENT / BERM	CABLE LINE	(NO WINDOWS PERMITTED)	WALKOUT BASEMENT
				MAX 3:1 SLOPE	BELL	EXTERIOR DOOR LOCATION	MODIFIED
					HYDRO, GAS, BELL, CABLE LINE	IF GRADE PERMITS	REVERSED
							NO DOOR
							HIGHLIGHTED GRADE

SITING AND GRADING PLAN

THE UNDERSIGNED HAS REVIEWED AND TAKES RESPONSIBILITY FOR THIS DESIGN AND HAS THE QUALIFICATIONS AND MEETS THE REQUIREMENTS SET OUT IN THE ONTARIO BUILDING CODE TO BE A DESIGNER.

QUALIFICATION INFORMATION

DEREK R. SANTOS

37308

NAME

SIGNATURE

BCIN

REGISTRATION INFORMATION

HUNT DESIGN ASSOCIATES INC.

19695

**HUNT**  
DESIGN ASSOCIATES INC.  
www.huntdesign.ca

Lot LONGWORTH AVENUE

Royal Pine Homes / Centerfield Properties Inc - 216102  
"OAKRIDGE MEADOWS", RICHMOND HILL, ON

Drawn By: MM Checked By: DS Scale: 1:250 File Number: 216102-SP01.DWG Lot / Page Number: 6

8966 Woodbine Ave, Markham, ON L3R 0J7 T 905.737.5133 F 905.737.7326

All drawings specifications related documents and design are the copyright property of Hunt Design Associates (H.D.A.). Reproduction of this property in whole or in part is strictly prohibited without H.D.A.'s written permission. H.D.A. assumes no responsibility or liability for this property unless it bears the appropriate BCIN number and original signature.