


No unprotected openings permitted within 1.2 meters of the lot line as per article 9.10.14 of the Ontario Building Code.

As per OBC 2012, Div.B, 9.10.14.5(5), projections such as balconies, eaves, stairs, etc., that are more than 1m above grade, shall be non-combustible when within 1.2m of a property line or 2.4m of a combustible projection on another building on the same property.

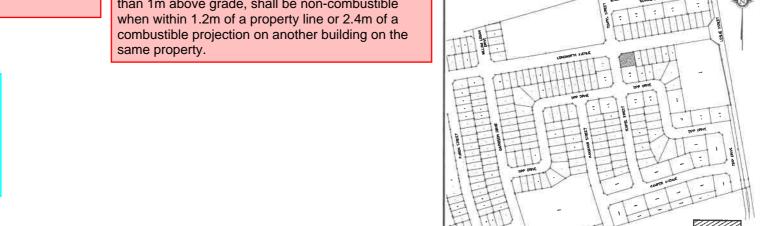

Building Division ZONING REVIEWED KNC Initials:

Richmond Hill City of Richmond Hill

CITY OF RICHMOND HILL **BUILDING DIVISION**

08/16/2021

REVISED Per: _KNC

W Architect Inc. **DESIGN CONTROL REVIEW** AUG. 13, 2021 RECERT

BY: MMI FINAL This stamp is only for the purposes of design atral and carries no other professional obligation REVIEWED ONLY AS TO GENERAL COMPLIANCE WITH THE INTENT OF THE GRADING AND SERVICING DRAWINGS. THE ENGINEER DOES NOT WARRANT THAT THE INFORMATION CONTAINED ON THIS PLAN IS EITHER ACCURATE OR CORRECT. SOLE RESPONSIBILITY FOR CORRECT DESIGN, DETAILS AND DIMENSIONS WILL REMAIN WITH THE PARTY SUBMITTING THE DRAWING.

紅 REVIEWED

☐ REVIEWED AS NOTED

☐ REVISE AND RESUBMIT

- HYDRO POLE

The MUNICIPAL INFRASTRUCTURE Group Ltd.

Date: A19 16 2021

ENGINEERED FILL LOTS HYDRO TRANSFORMER -B BELL PEDESTAL STREET TREE CABLE PEDESTAL STORM MANHOLE

~ SHEET DRAINAGE

STREET LIGHT PEDESTAL O- HYORO POLE GUY VALVE & BOX CATCH BASIN STREET SIGN DOUBLE / SINGLE HYDRANT TRAFFIC SIGNAL POWER PEDESTAL COMMUNITY MAILBOX

RETAINING WALL

2.0% SWALE DIRECTION

EMBANKMENT / BERM MAX 3:1 SLOPE

ISSUED FOR FINAL APPROVAL ISSUED FOR PRELIMINARY APPROVAL PADMOUNTED MOTOR — STV.— STORM WATERLINE - STORM WATER LINE WINDOWS PERMITTED $_{\rm 189}$,65 Existing grades -c--- Gas line -c--- Cable line 190.10 PROPOSED GRADES

HUNT DESIGN ASSOCIATES INC.

N.T.S.

GENERAL NOTES: 1. BUILDER TO VERIF

45 MINUTE FIRE RATED WALL SEDEVARD DISTANCE IS LESS THAN 1.2m TO LOT LINE (NO WINDOWS PERMITTED) EXTERIOR DOOR LOCATION EXTERIOR DOOR LOCATION IF GRADE PERMITS MIS ACOUSTIC FENCE

MAINTAINED, BUILDER IS TO RELOCATE AT BUILDER'S EXPENSE.

SUMP PUMP AND SURFACE DISCHARGE LOCATION UPGRADE ELEVATION CHAIN LINK FENCE FENCE AND GATE PRIVACY FENCE

DS 2021.08.12

KEY MAP

BUILDER TO VERIFY ELEV. OF STM. AND SAN, LATERALS IN RELATION TO BASEMENT US OF FOOTING ELEVATIONS FOR COMPLIANCE WITH MUNICIPAL STANDARDS PRIOR TO EXCAVATION.

UNLESS NOTED ON BUILDING ENVELOPE OR APPROVED PERMIT DRAWINGS & CONSTRUCTION NOTES, ALL TOP OF FOUNDATION WALLS INCLUDING GARAGE WALLS TO BE CONSISTENT WITH THE ELEVATION PROVIDED FOR THW ON SITING AND GRADING PLAN, THE EXTERIOR OF THE FOUNDATION WALL TO BE PROVIDED WITH A REDUCTION OF THICKNESS FOR MASONRY VENEER AS REQUIRED,

APPROVED PERMIT DRAWINGS & CONSTRUCTION NOTES MUST BE REVIEWED AND FOLLOWED IN CONJUNCTION WITH THE SITING AND GRADING PLAN, BUILDER TO VERIEY BUILDING ENVELOPE ON SITE PLAN MATCHES APPROVED PERMIT DRAWINGS & CONSTRUCTION NOTES PRIOR TO POURING CONCRETE, IF THERE ARE ANY DISCREPANCIES, THEY ARE TO BE BROUGHT TO THE ATTENTION OF

> DS 2021.04.21 FF FINISHED FLOOR
> TFW TOP OF FOUNDATION WAL
> BE BASEMENT FLOOR
> UP UNDERSIDE OF FOOTING
> WOD WALKOUT BECK
> WOB WALKOUT BASEMENT
> MOD MODIFIED
> REV REVERSED
> ND NO DOOR

Subject LOT

SITING AND GRADING PLAN

THE UNDERSIGNED HAS REVIEWED AND TAKES RESPONSIBILITY FOR THIS DESIGN AND HAS THE QUALIFICATIONS AND MEETS THE REQUIREMENTS SET OUT IN THE ONTARIO BUILDING CODE TO BE A DESIGNER.

DEREK R. SANTOS 37308 HUNT DESIGN ASSOCIATES INC. 19695 DESIGN ASSOCIATES INC.

www.huntdesign.ca

BLOCK 55 TEMPEL STREET Royal Pine Homes / Centerfield Properties Inc - 216102 "OAKRIDGE MEADOWS", RICHMOND HILL, ON

REVISED AS PER ZONING COMMENTS & RE-ISSUED

DS DS 1:250 216102-SP01.DWG 8966 Woodbine Ave, Markham, ON L3R 0J7 T 905.737.5133 F 905.737.7326

HYDRO, GAS, BELL, CABLE LINE

— в — BELL

BLOCK 55