

## CONSTRUCTION SUMMARY 2185715 Ontario Inc.

PURCHASERS: BHUPINDER KAHLON and SHARANJIT, KAUR RAI // RAKESH SHARMA

TEL: RES.: 905-499-1100

LOT NUMBER	PHASE	HOUSE TYPE	CLOSING DATE	
037	1	SOPHIA-5 BEDROOM-ELEVATION B	17-Nov-22	

BONUS PACKAGE - PURCHASER TO RECEIVE \$20,000 (INCLUSIVE OF TAXES) WORTH OF UPGRADES AT THE Offer DECOR CENTER AT TIME OF COLOUR CHART. Note: Workshee

**Invoice Number: 7903** Date Added: 03-May-22

6 - BASEMENT- Install SIX (X6) larger basement windows, 36"x24 in lieu of teh builders standard. (With Possible window wells) (See Sketch)

1 - SIDE EXTERIOR DOOR- Install the optional side door with applicable coach llight (See Sketch)

Note:

1 - FRONT EXTERIOR DOOR- Install an extended height single front door and side lights, in lieu of the builders standard (Delete transom above) (See Sketch)

Note:

1 - MASTER ENSUITE- Delete the full wall next to the free standing tub in teh master ensuite, and Install frameless glass, additional curb with stone top (See Sketch)

Note:

1 - KITCHEN- Install a pot filler rough in above stove (See Sketch)

Note: \*\*Purchaser accepts & acknowledges that the above price is ONLY for the rough in plumbing and the pot filler finish will be chosen at time of colour chart\*\*

1 - PURCHASER HAS ATTENDED A STRUCTURAL APPOINTMENT AT THE DESIGN STUDIO AND HAS DECLINED ANY ADDITIONAL **UPGRADES** 

Note:


1 - BONUS PACKAGE-PURCHASER TO RECEIVE \$20,000 (INCLUSIVE OF TAXES) WORTH OF UPGRADES AT THE DESIGN STUDIO AT TIME OF STRUCTURAL / COLOUR CHART

Note: \*\*Purchaser has a remaining Bonus package of \$3,728.00 (INCLUSIVE OF TAXES) WORTH OF UPGRADES AT THE DESIGN STUDIO AT TIME OF COLOUR CHART

1 - PURCHASER AWARE AND ACCEPTS THAT ANY CHANGES MADE TO UPGRADES AFTER SIGNING THIS PURCHASERS EXTRA FORM ARE SUBJECT TO A MINIMUM ADMINISTRATION FEE OF \$1,000

Note:

This Document is Extremely Time Sensitive - Printed 4 May 22 at 15:51

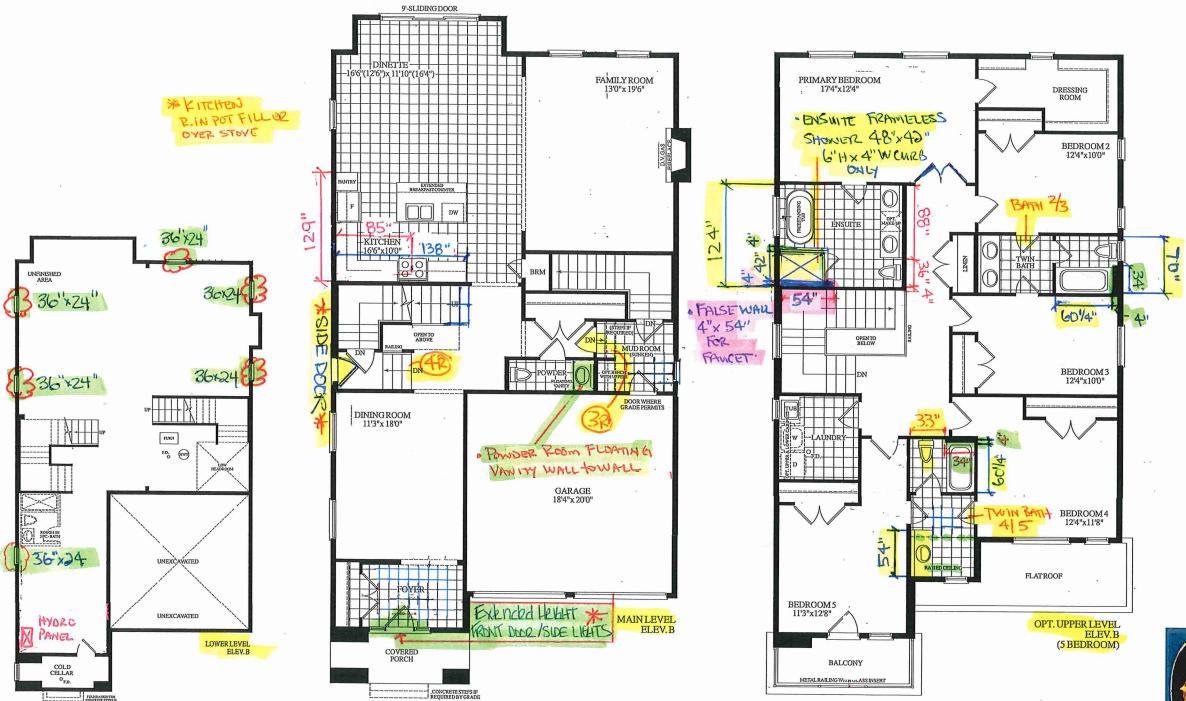



37

LOT