



CONSTRUCTION SUMMARY  
2185715 Ontario Inc.

PURCHASER: RAJWINDER,SINGH DHALIWAL

TEL: RES.: 416-417-6169



LOT NUMBER	PHASE	HOUSE TYPE	CLOSING DATE	
052	1	ISABELLA-OPT MAIN-4 BEDROOM-ELEVATION C		

Offer	BONUS PACKAGE - PURCHASER TO RECEIVE \$20,000 (INCLUSIVE OF TAXES) WORTH OF UPGRADES AT THE DECOR CENTER AT TIME OF COLOUR CHART.
Worksheet	Note:

Date Added: 12-May-22 Invoice Number: 8248

2 - BASEMENT WINDOWS - Install Larger Basement Windows in lieu of builders standard 30"x16". Install TWO (2) 30"x24" Basement Windows (with possible window wells) at Rear Elevation (See Sketch) Note:
3 - BASEMENT WINDOWS - Install Larger Basement Windows in lieu of builders standard 30"x16". Install THREE (3) 36"x24" Basement Windows (with possible window wells) at Rear Elevation (See Sketch) Note:
1 - BASEMENT WINDOWS - In addition to basement windows, Install ONE (1) ADDITIONAL Larger Basement Window 36"x24" (with possible window well) To be installed on side elevation (See Sketch) Note:
1 - SIDE EXTERIOR - Install OPTIONAL SIDE DOOR Entrance (Includes Applicable Exterior Coach Light) (See Sketch) Note:
1 - GARAGE - Relocate Central Vac Trunk Rough-In to Garage in lieu of basement (Vendor to Determine Location) Note:
22 - SECOND FLOOR - INTERIOR DOORS - Install Upgrade EXTENDED HEIGHT INTERIOR DOORS (8'-0") (Standard Door Style Only) - To be installed throughout second floor interior doors, where applicable (x22 doors) (See Sketch) Note:
1 - FRONT EXTERIOR - In addition to builders standard exterior coach light, Install ONE (1) EXTERIOR PORTICO CEILING LIGHT on Seperate Switch (Includes Basisc Fixture) - To be installed at front porch ceiling (See Sketch) Note:
1 - BONUS PACKAGE - PURCHASER HAS APPLIED \$20,000.00 (Incudes Taxes) WORTH OF UPGRADE PROMOTIONAL PACKAGE TOWARDS THE PURCHASE OF STRUCTURAL UPGRADES COMPLETED AT THE DECOR CENTRE Note:
1 - PURCHASER HAS ATTENDED A STRUCTURAL APPOINTMENT AT THE DESIGN STUDIO AND HAS DECLINED ANY ADDITIONAL UPGRADES. Purchaser accepts and acknowledges that there will be no further structural changes/additions/deletions to be made upon signing on MAY 12,2022 Note:
1 - PURCHASER AWARE AND ACCEPTS THAT ANY CHANGES MADE TO UPGRADES AFTER SIGNING THIS PURCHASERS EXTRA FORM ARE SUBJECT TO A MINIMUM ADMINISTRATION FEE OF \$1,000 Note:

This Document is Extremely Time Sensitive - Printed 13 May 22 at 10:03

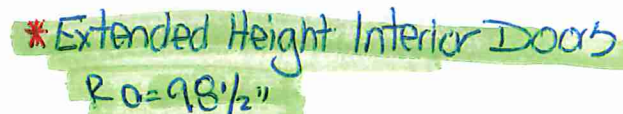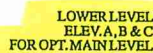

REAR UPGRADE ELEVATION

**LOT 52 . Isabella . 40-06 . OPTIONAL MAIN 4 BEDROOMS**

**3470 sq.ft. .  
ELEV. C**

