



FILE  
SITE COPY

Structural

CONSTRUCTION SUMMARY

2185715 Ontario Inc.

PURCHASERS: VARINDER SINGH and SONIA SANDHU TEL: RES.: 647-444-1111 BUS.: 647-883-6000




LOT NUMBER	PHASE	HOUSE TYPE	CLOSING DATE
049	1	ALEXIE-OPT MAIN-5 BEDROOM-ELEVATION A	

Offer	BONUS PACKAGE - PURCHASER TO RECEIVE \$20,000 (INCLUSIVE OF TAXES) WORTH OF UPGRADES AT THE DECOR CENTER AT TIME OF COLOUR CHART.
Worksheet	Note:

Date Added: 01-Jun-22 Invoice Number: 8241

5 - BASEMENT WINDOWS - Install Larger Basement Windows in lieu of builders standard 30"x16". Install FIVE (5) 36" x 24" Basement Windows (with possible window wells) (See Sketch) Note:
1 - SIDE EXTERIOR - Install OPTIONAL SIDE DOOR Entrance with Applicable Exterior Coach Light (See Sketch) Note:
1 - FRONT EXTERIOR - DOOR - Install EXTENDED HEIGHT Single Front Door with Applicable Side Light (Delete Transom Window Above) (See Sketch) Note:
1 - FRONT EXTERIOR - PORCH - In addition to builders standard exterior coach light, Install ONE (1) EXTERIOR PORTICO CEILING LIGHT (Includes Basic Fixture) on Seperate Switch - To be installed at front porch ceiling (See Sketch) Note:
1 - FRONT EXTERIOR - In addition to builders standard exterior GFI plug, Install ONE (1) FESTIVE SOFIT PLUG on a Single Pole Switch (See Sketch) Note:
1 - BONUS PACKAGE - PURCHASER HAS APPLIED \$20,000.00 (Incudes Taxes) WORTH OF UPGRADE PROMOTIONAL PACKAGE TOWARDS THE PURCHASE OF STRUCTURAL UPGRADES COMPLETED AT THE DECOR CENTRE Note: **Remaining Bonus Package of \$9,208.50 (Includes Taxes) will be applied to upgrades completed during decor appointment**
1 - PURCHASER HAS ATTENDED A STRUCTURAL APPOINTMENT AT THE DESIGN STUDIO AND HAS DECLINED ANY ADDITIONAL UPGRADES. Purchaser accepts and acknowledges that there will be no further structural changes/additions/deletions to be made upon signing on JUNE 1,2022 Note:
1 - PURCHASER AWARE AND ACCEPTS THAT ANY CHANGES MADE TO UPGRADES AFTER SIGNING THIS PURCHASERS EXTRA FORM ARE SUBJECT TO A MINIMUM ADMINISTRATION FEE OF \$1,000 Note:

This Document is Extremely Time Sensitive - Printed 6 Jun 22 at 11:27

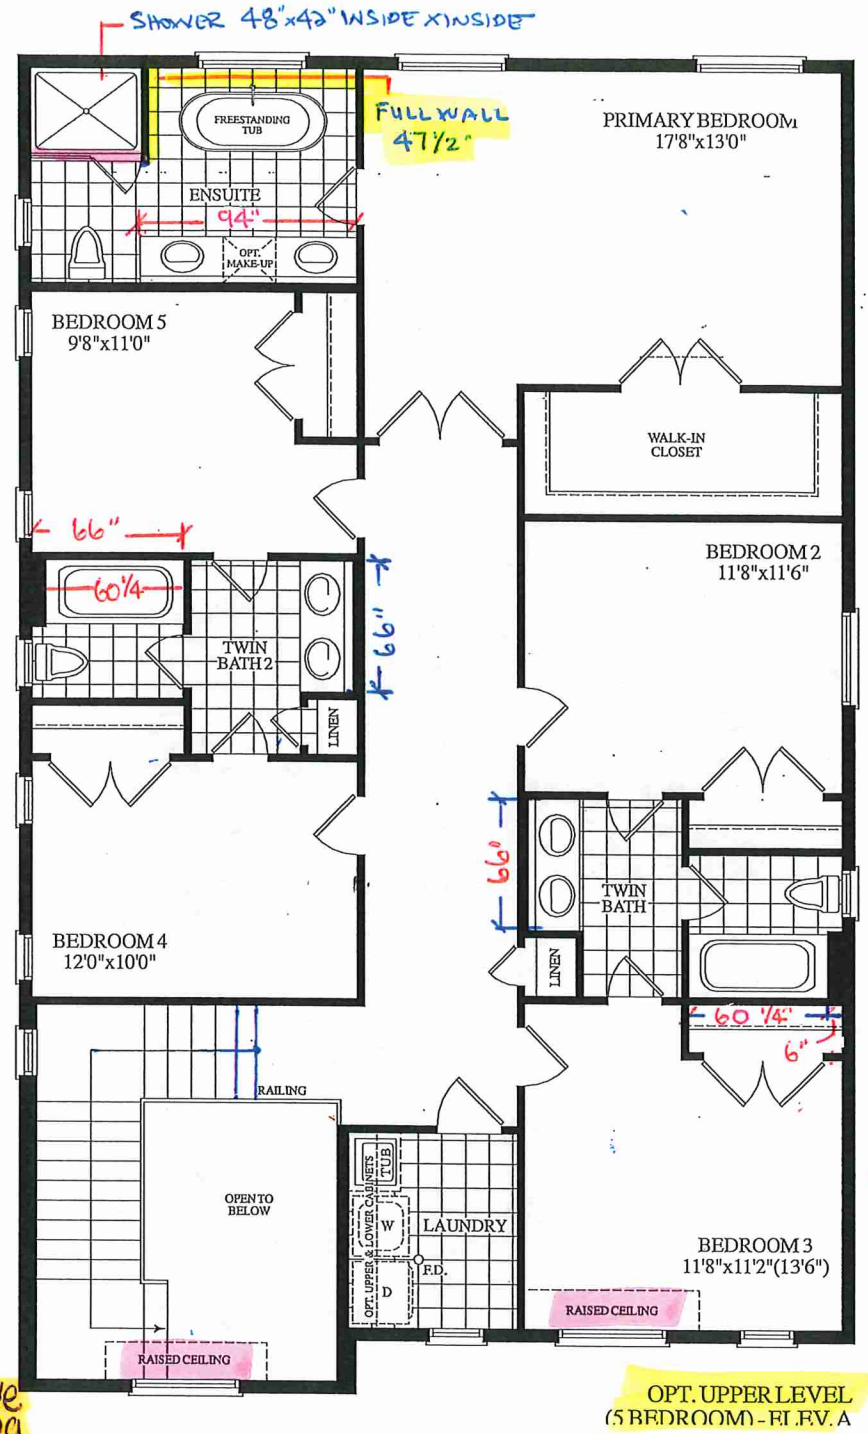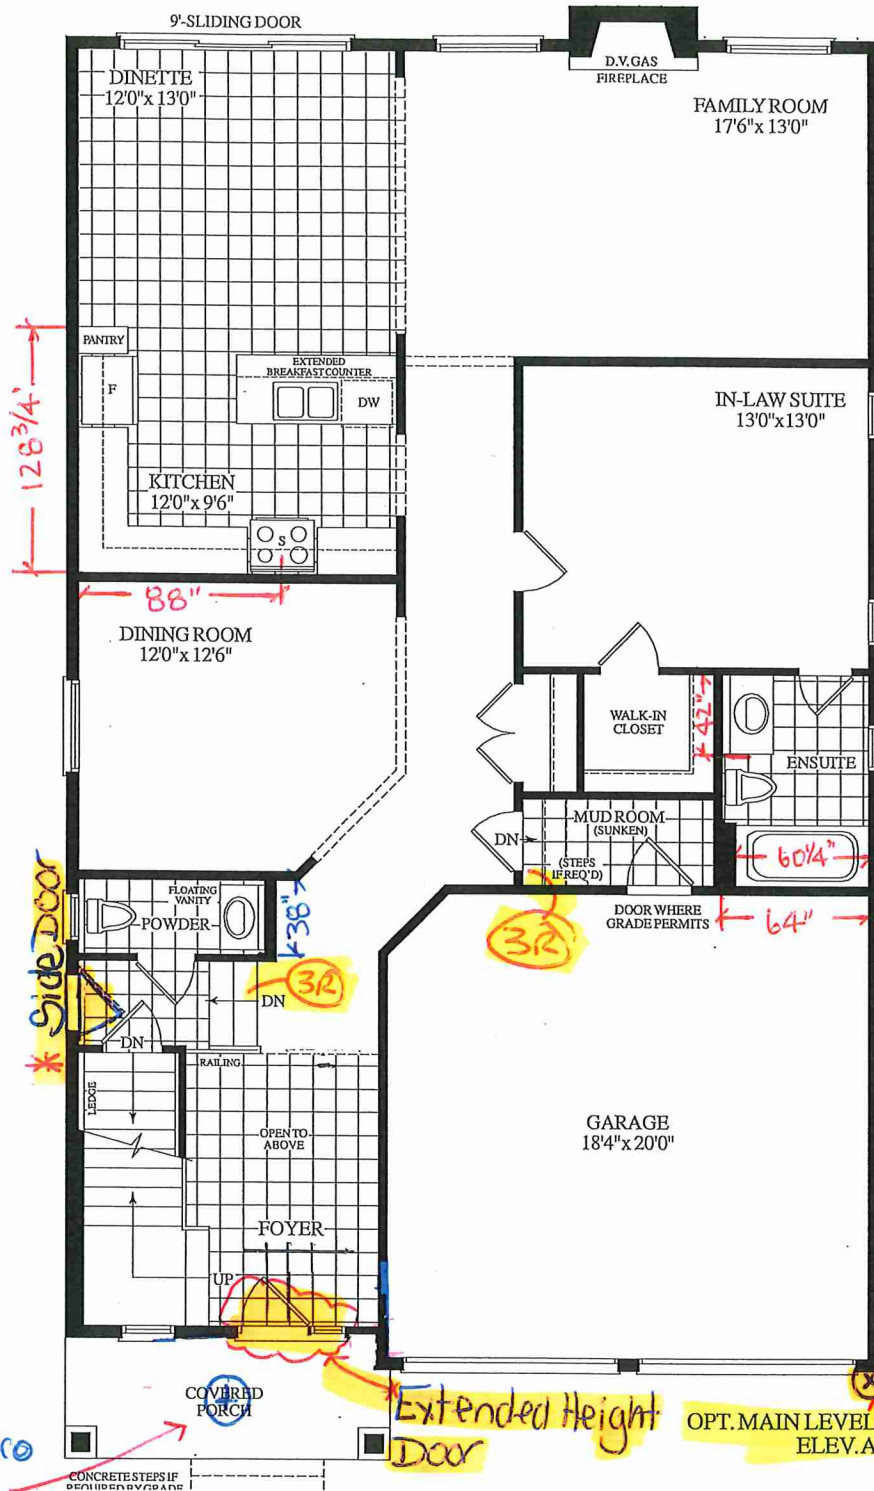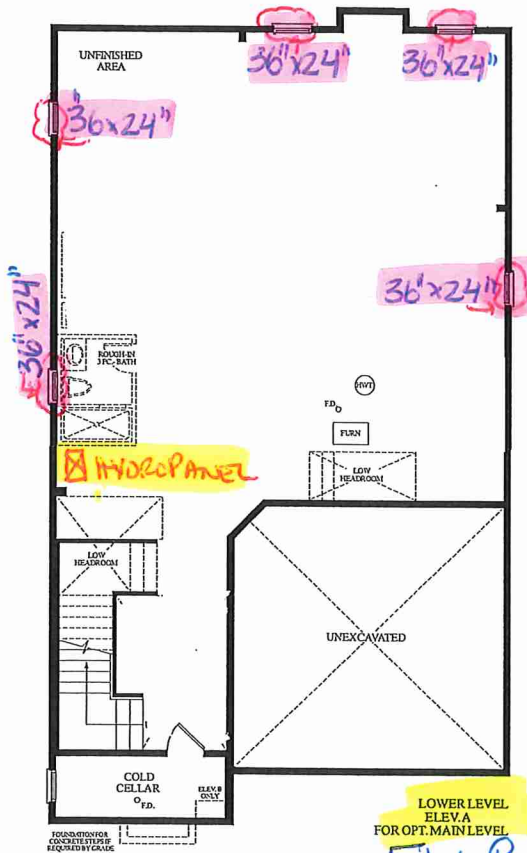

UPGRADE REAR ELEVATION

40-05  
LOT 49 . Alexie . OPTIONAL MAIN . 5 BEDROOM

3230 SQ. FT.  
ELEV. A

