

#### SITE COPY



#### CONSTRUCTION SUMMARY

Forestside Estates Inc.

PURCHASERS: Muhammad Umair Ghani and 13713709 Canada Inc / 11231596 Canada Inc

TEL:

LOT NUMBER	PHASE	HOUSE TYPE	CLOSING DATE	
347 BLOCK 5	6-III	Holly 2C	04-May-23	

Date Added: 07-Jun-22

1 - APPLIANCE PACKAGE- Install the Standard Appliance Package. To be installed throughout the suite, where applicable (See Sketch)

**Invoice Number: 8296** 

Note:

1 - MAIN FLOOR - FLOORING - Install UPGRADE 2 FLOOR TILES (18x18 Livorno Gris) throughout the main floor where applicable in lieu of the builder's standard floor tiles. To include; Foyer, Laundry Room, Mech. Room, and Powder Room.

Note: To be installed straight/stacked (See Sketch)

- 1 KITCHEN & BATHROOMS Purchaser has DECLINED All Upgrades offered during decor appointment at the decor centre for kitchen & bathroom cabinetry. Standard Kitchen Layout & Standard Bathroom Vanities to be installed as per standard plan. (See Sketch)
  Note:
- 1 KITCHEN- PLUMBING Kitchen Faucet STANDARD- DELTA Chrome Osler Pull Down Kitchen Faucet (Single Hole) Model # 976 LF Note:
- 1 KITCHEN PLUMBING Install the UPGRADED UNDERMOUNT sink in the kitchen- Install the BLANCO QUATRUS U1 SUPER SINGLE-Model # 401248. To include cut and polish (see sketch) (see sketch)

Note: To be installed with standard kitchen faucet

- 1 KITCHEN COUNTERTOP Install Builders Standard Stone Countertop Emmerstone Maple White with STANDARD " A " EDGE PROFILE To be installed throughout kitchen, where applicable (does not include stone backsplash) (See Sketch)
- 1 POWDER ROOM COUNTERTOP Install Builders Standard Stone Countertop Emmerstone Maple White with STANDARD " A " EDGE PROFILE To be installed throughout the Powder Room where applicable. To include 3" Splash(See Sketch) Note:
- 1 STAIRCASE STAIN STAIN STAIRCASE COMPLETE throughout where applicable from main to second floor. To be stained Mirage Red Oak Driftwood. To include handrail, treads, and posts.

Stringers and risers to remain painted white

Note: The purchaser agrees that the vendor is to be exempt from any and all claims by the purchaser regarding this colour variance.

#### 1 - STAIRCASE VS FLOORING

WOOD SPECIES DIFFERENCE:

STAIRCASE - The purchaser was advised and therefore accepts and acknowledges that the wood species of the staircase and flooring chosen do not match. This difference may result in a stain colour variance.

Note: The purchaser agrees that the vendor is to be exempt from any and all claims by the purchaser regarding this colour variance.

#### 1 - STAIRCASE VS FLOORING

STAINING DIFFERENCE:

STAIRCASE - The purchaser was advised and therefore accepts and acknowledges that the stain of the staircase and flooring chosen do not match. This difference might result in an undesirable colour variance.

Note: The purchaser agrees that the vendor is to be exempt from any and all claims by the purchaser regarding this colour variance.

- 1 MAIN BATH- FLOORING Purchaser accepts & acknowledges that the floor tiles on the Main Bath will be installed stacked NOT brick pattern.

  Note:
- 1 MASTER ENSUITE / MAIN BATH/ POWDER ROOM- Install the builders standard Plumbing Fixtures throughout all bathrooms, where applicable. To Include the Master Ensuite, Main Bath, & Powder Room
  Note:
- 1 MASTER ENSUITE / MAIN BATH/ POWDER ROOM- Install the Standard 3" Splash throughout all bathroom vanity counter tops, where applicable. To include the Powder Room, Main Bath and the Master Ensuite Note:
- 1 MAIN BATH COUNTERTOP Install Builders Standard Stone Countertop Emmerstone Maple White with STANDARD " A " EDGE PROFILE To be installed throughout the main bath where applicable. To include 3" Splash(See Sketch)

  Note:



#### SITE COPY



### **CONSTRUCTION SUMMARY**

Forestside Estates Inc.

PURCHASERS: Muhammad Umair Ghani and 13713709 Canada Inc / 11231596 Canada Inc

TEL:

LOT NUMBER	PHASE	HOUSE TYPE	CLOSING DATE	
347 BLOCK 5	6-III	Holly 2C	04-May-23	

Date Added: 07-Jun-22 Invoice Number: 8296

- 1 MASTER ENSUITE COUNTERTOP Install Builders Standard Stone Countertop Emmerstone Maple White with STANDARD " A " EDGE PROFILE To be installed throughout the Master Ensuite where applicable. To include 3" Splash(See Sketch) Note:
- 1 KITCHEN/MAIN BATH/ POWER ROOM/ MASTER ENSUITE COUNTER-Stone slabs vary in size & all seams are visible & the fabricator reserves the right to position the seams as necessary.

  Note:
- 1 2ND FLOOR FLOORING Install UPGRADE 2 FLOOR TILES (18x18 Livorno Gris) throughout the 2nd floor where applicable in lieu of the builder's standard floor tiles. To be installed straight/stacked. To include; Master Ensuite & Main Bath Note: To be installed with standard shower wall tiles
- 1 || || PURCHASER AWARE AND ACCEPTS THAT ANY CHANGES MADE TO UPGRADES AFTER SIGNING THIS PURCHASERS EXTRA FORM ARE SUBJECT TO A MINIMUM ADMINISTRATION FEE OF \$1000 PLUS A 10% HOLDBACK FEE.
- 1  $\|$   $\|$  PURCHASER HAS ATTENDED A STRUCTURAL AND COLOR APPOINTMENT AT THE DECOR CENTRE AND HAS DECLINED ANY ADDITIONAL UPGRADES. Note:

This Document is Extremely Time Sensitive - Printed 10 Jun 22 at 14:10



HOLLY

2 BEDROOM | 2.5 BATH


### **1028-1065** SQ FT


PLUS APPROXIMATELY 56 SQ FT PATIO/BALCONY AREA

**SUITE: 347** 

BUILDING C




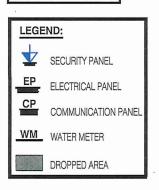

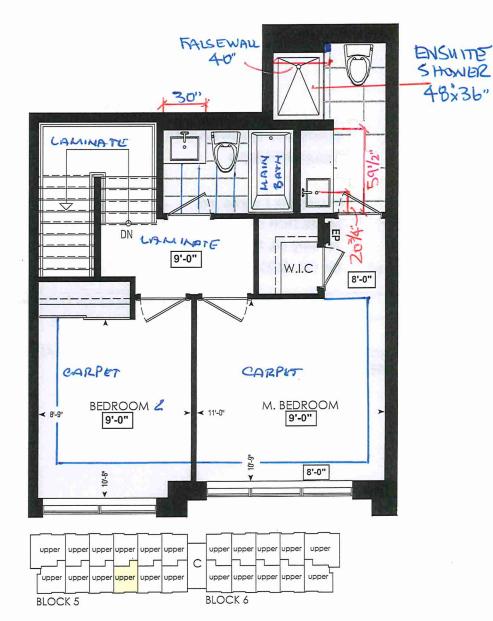

48×36"


### FOURTH FL.

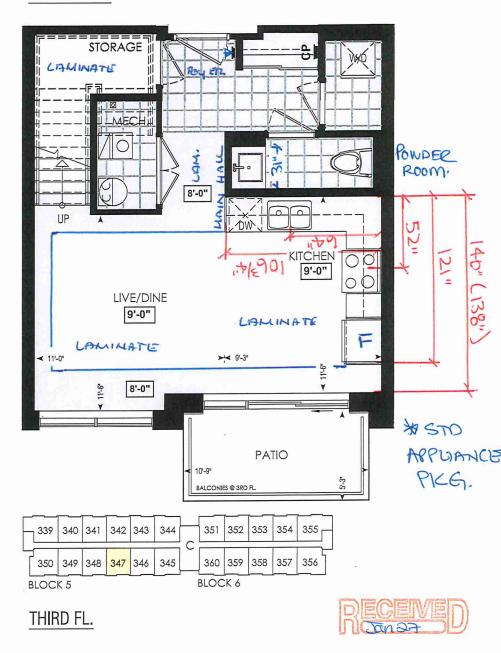

(ROATE HAD)		······································		* INTERIOR	COLOUR	SCHEME *			1301LT	DING C
		chasers	Decor Consulta	ant Model and Elevation	Tele	phone Res. / Bus	Project	Clo	osing Date	Property
ımmad Umair Ghani &	13713	709 Canada Inc / 11231596 Canac	Denise Sue	Holly 2C			Forestside Estates Inc	2. (	04/05/2023	347 BLOCK 5
Page 1 of 3		Flooring		- Wall Tile			, , , , , , , , , , , , , , , , , , , ,			Plumbing —
Master Ensuite	L	Description 18x18 Livrono Gris (UPGRADE)		<u>Main</u> 8X10 Golf Grigio (STANDARD)	Accent/Insert		<u>Border / Listello</u> N/A		Pattern N/A	
Main Bathroom	1	18x18 Livrono Gris (UPGRADE)		8X10 Golf Grigio (STANDARD)	N/A		N/A		N/A	
					7 (20/2		] [WA	****	<u> </u>	WHITE
					7					
Powder Room	<i>ا</i> ل:	18x18 Livrono Gris (UPGRADE)		N/A	N/A			, , , , , , , , , , , , , , , , , , , ,		
Kitchen		8" Watson Natural Oak EE-H-292(S					N/A	Marie Constant Administration of the Constant	N/A	'WHITE
Laundry	١,	18x18 Livrono Gris (UPGRADE)		3X6 C&D Artic Bright White-Stacked (STD)	N/A		N/A		N/A	See Notes
Laundry		TOX TO LIVIOTO GIIS (UPGRADE)		N/A	N/A		N/A		N/A	N/A
							N/A		N/A	N/A
Foyer					<u> </u>					
_	,	18x18 Livrono Gris (UPGRADE)		- Railings and Stairs Railings ❤ (Std) Oval Red Oak Driftwood (	/IDC\	Landing - Upper Watson	N. C. LOCAL ET (1999)	: i	ling / Medalion-	
Mech. Room		18x18 Livrono Gris (UPGRADE)		Pickets N/A	uro)	Landing - Upper Walson Landing - Lower N/A	Natural Oak EE-H-292	Foyer	N/A	
Storage Room		8" Watson Natural Oak EE-H-292(S)	<u>rd)</u>	Posts 3 1/2" Square W/ Cap - Mirage	Drifwood (Upg)	Ledge - Upper N/A		Living Room Dining Room	N/A	
Living Room	_	8" Watson Natural Oak EE-H-292(S)		Stringers Painted White (STANDARD)		Ledge - Lower N/A		Family Room	N/A N/A	
Dining Room ,		8" Watson Natural Oak EE-H-292(ST		Treads Red Oak -Mirage Driftwood (UF	PGRADE)	]		Main Hall	N/A	
MAIN HALL	V	B"NOTEMNOTUM BOKEFT	1.1	Risers Painted White (STANDARD)		]		Kitchen	N/A	
				Runner _N/A				2nd Floor Hall	N/A	
				-Trim						
2nd Floor Hall	V	8" Watson Natural Oak EE-H-292(ST	rn\ !!!	Baseboard & Casing STANDARD Front Door Glass N/A		Knobs STANDAR Hinges STANDAR				
				Interior Doors STANDARD		Grip Set STANDAR				
Master Bedroom	レ	Opening Night 4002-20(STANDARD	)	- Notes -						
Bedroom 2	レ	Opening Night 4002-20(STANDARD	)	KITCHEN- PLUMBING - Kitchen Faucet S	STANDARD- DEI	TA Chrome Osler Pull Down Ki	itchen Faucet (Single Hole) - Mo	idel # 976 LF KITCHE	N - PLUMBING -	Install the
				UPGRADED UNDERMOUNT sink in the I	kitchen- Install the	∋ BLANCO QUATRUS U1 SUP	PER SINGLE- Model # 401248.			
			<i>F</i>	Page 1 of 3						
				Cl		DocuSigned by:	DocuSigned by:	-DocuSigned by:		)
				Consultant:	Purchaser:	U Shaw	Purchaser:	Jaha Ch -ODBEZ50708DC4Z3 Vende		s-market
				Denise Sue	-	Muhammad Umalr Ghanl	13713709 Canada Inc.		Forestside Estates In	nc.

RUATION Du				* INTERIO	R COLO	UR SCHE	EME *				130161	DING C
ru	rchasers	Decor C	onsultant	Model and Elevati	on	Telephon	e Res. / Bus		Project		Closing Date	Property
ımmad Umair Ghani & 1371	3709 Canada Inc. / 11231596 Canac	Deni	se Sue	Holly 2C			1		orestside Estates Inc.		04/05/2023	347 BLOCK 5
Page 2 of 3	Interior Paint		Cabinet-		· · · · · · · · · · · · · · · · · · ·	.,,						***
Master Ensuite	Description DISTANT GRAY (STANDARD)		Style	NOO Diaman I D.I AANIMATE (OTANE)	nn.			Countertop		Counter E		Handle / Knob
				022 Bianco LP LAMINATE (STANDA			<b>~</b>	Emmerstone M	aple White (STANDARD)	A" (STAND) الم	ARD)	DH00010(STD
Main Bathroom	DISTANT GRAY (STANDARD)		CAT.1 QT10	222 Bianco LP LAMINATE (STANDA	(RD)		L	Emmerstone M	aple White (STANDARD)	"A" (STAND	ARD)	DH00010(STD
							*************					
									***************************************	<u>"] [                                   </u>		
Powder Room	DISTANT GRAY (STANDARD)		CAT.1 QT10	22 Bianco LP LAMINATE (STANDA	RD)	~~~	レ	Emmerstone M	aple White (STANDARD)	' A" (STAND	ARD)	DH00010(STD
Kitchen	DISTANT GRAY (STANDARD)		CAT.1 QT10	22 Bianco LP LAMINATE (STANDA	RD)		L/	Emmerstone M		Ta" (STAND		DH00010(STD
Laundry	DISTANT GRAY (STANDARD)		N/A					N/A		N/A		N/A
Mech. Room	DISTANT GRAY (STANDARD)		N/A					N/A		N/A		N/A
Storage Room	DISTANT GRAY (STANDARD)		N/A			***************************************		N/A		N/A		N/A
Foyer	DISTANT GRAY (STANDARD)		N/A					N/A		N/A		N/A
Main Hall	DISTANT GRAY (STANDARD)		L				M		Notes			
				e Opening/Dimension					*STANDARD KITCHEN A	APPLIANCES	· · · · · · · · · · · · · · · · · · ·	
Living Room	DISTANT GRAY (STANDARD)		1	STANDARD	Range	STANDARD	***************************************		1			
_			Built-Ins Hood Fan	None O.T.R MICRO (STD)		e O.T.R MICRO						
Dining Room	DISTANT GRAY (STANDARD)			er Cabinet Std 24in Opening	_ Exnaust C	pening 🚷	6" 08"					
			21011114011	or odornor <u>Std 24th Opening</u>								
2nd Floor Hall	DISTANT GRAY (STANDARD)											
			Fireplace Fireplace	minutes.								
Master Bedroom	DISTANT GRAY (STANDARD)			N/A Flooring N/A		replace ocation Floor	N/A					
Bedroom 2	DISTANT GRAY (STANDARD)		Style	N/A	~~~~~	tyle	N/A					
modi ooiii z	DISTAINT GRAT (STAINDARD)		Finish	N/A		nish	N/A					
			Marble	N/A		arble	N/A					
			Hearth	N/A	He	earth 	<u>N/A</u>					
			Page 2 of 3	}								
				10		(1)	gned by: Mar			Docusigned by: Fahal Ch		
			Decor Cons	Sultant:	Purch	laser. — DABGE	BCAA268466	_ Purchas	er: CESSOEB3B71E458	0DBF750708DC4 <b>V</b> @1	(	
Lot: 347 BLOCK 5 Project	ct: Forestside Estates Inc. Mod	el: Holly 2	С	Duniae Out		Muhammad	i Umair Ghani		13713709 Canada Inc. / 1123	31596 Canad	Forestside-Estates	Inc. un 06 2022 1:35 nm

Printed Jun 06, 2022 1:35 pm

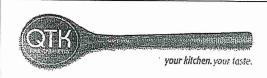


CLIENT: ROYAL PINE HOMES	JOB NAME: 2C, 2Ca HOLLY, 2D REDPINE	ROOM: KITCHEN	DRAWN BY: GS
SITE: FORESTSIDE ESTATES	DOOR STYLE; QTS 1022	DOOR HANDLE:	SCALE: 1/2" = 1'-0"
PHONE:	FINISH:	DRW HANDLE:	DATE: JUNE 12, 2020
EMAIL:	SPECIES: LAMINATE	TOP:	PAGE:
COMMENTS:			1.7,02.

Customer Agrees and Accepts the following conditions: 1. The Drawing is a representation only and the installed cabinetry may vary slightly in product size, measurements, handle appearance and location and other details. Although Quality Tops & Kitchens Ltd. (QTK) does it's best to manufacture exactly what is shown here outside factors may prevent that and some variance is to be expected and accepted by the customer. 2. These drawings represent the intellectual property of QTK and as such the customer understands and accepts that all deposits given by the customer to QTK are non-refundable after QTK has supplied drawings (either physically or electronically) to the customer. If the customer decides to cancel the order after QTK has submitted drawings to the customer, the deposit will then be considered a design fee and no money will be


# KITCHEN PLAN 2C, 20a, 20

Note: Model-type 2D cannot have an optional pantry due to window configuration

2C : 24 nos. FC nos

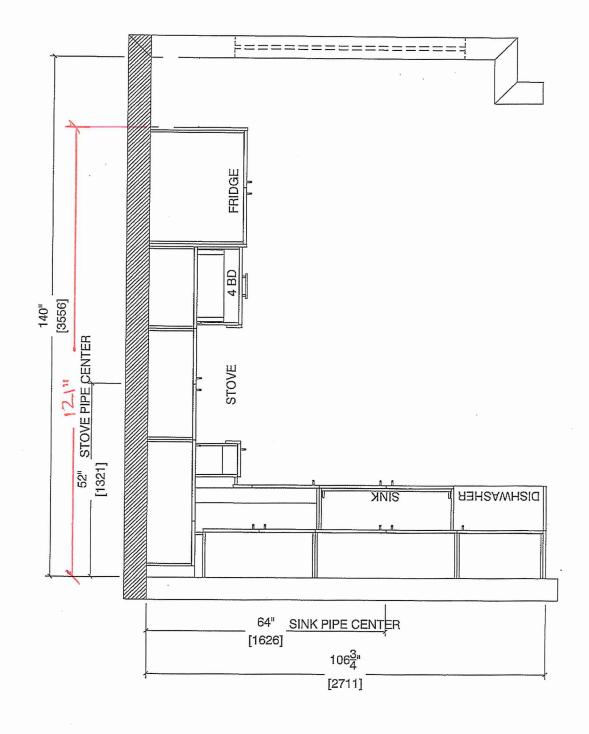


Note: Model-type 2D cannot have an optional pantry due to window configuration

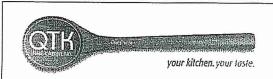

CLIENT: ROYAL PINE HOMES	JOB NAME: 2C, 2Ca HOLLY, 2CT MAGNOLIA, 2D REDPINE	ROOM: KITCHEN	DRAWN BY: GS
SITE; FORESTSIDE ESTATES	DOOR STYLE: QTS 1022	DOOR HANDLE:	SCALE: 1/2" = 1'-0"
PHONE:	FINISH:	DRW HANDLE:	DATE: JUNE 5, 2020
EMAIL:	SPECIES: LAMINATE	TOP:	PAGE;

Customer Agrees and Accepts the following conditions: 1. The Drawing is a representation only and the installed cabinetry may vary slightly in product size, measurements, handle appearance and location and other details. Although Quality Tops & Kitchens Ltd. (QTK) does it's best to manufacture exactly what is shown here outside factors may prevent that and some variance is to be expected and accepted by the customer. 2. These drawings represent the intellectual property of QTK and as such the customer understands and accepts that all deposits given by the customer to QTK are non-refundable after QTK has supplied drawings (either physically) or electronically) to the customer. If the customer decides to cancel the order after QTK has submitted drawings to the customer, the deposit will then be considered a design fee and no money will be eturned to the customer.

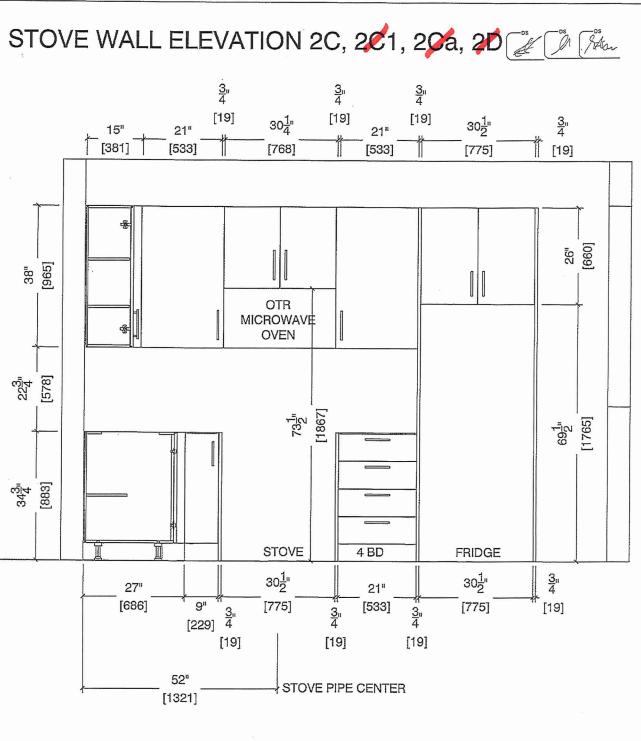




CLIENT: ROYAL PINE HOMES	JOB NAME: 2C, 2Ca HOLLY,	ROOM: KITCHEN	DRAWN BY: GS
SITE: FORESTSIDE ESTATES	DOOR STYLE: QTS 1022	DOOR HANDLE:	SCALE: 1/2" = 1'-0"
PHONE:	FINISH:	DRW HANDLE:	DATE: JUNE 5, 2020
EMAIL:	SPECIES: LAMINATE	TOP:	PAGE:

BUILDING C SUITE 347 RIK 5

Customer Agrees and Accepts the following conditions: 1. The Drawing is a representation only and the installed cabinetry may vary slightly in product size, measurements, handle appearance and location and other details. Although Quality Tops & Kitchens Ltd. (QTK) does it's best to manufacture exactly what is shown here outside factors may prevent that and some variance is to be expected and accepted by the customer. 2. These drawings represent the intellectual property of QTK and as such the customer understands and accepts that all deposits given by the customer to QTK are non-refundable after QTK has supplied drawings (either physically or electronically) to the customer. If the customer decides to cancel the order after QTK has submitted drawings to the customer, the deposit will then be considered a design fee and no money will be returned to the customer.

# SINK WALL ELEVATION 2C, 20 (FC)




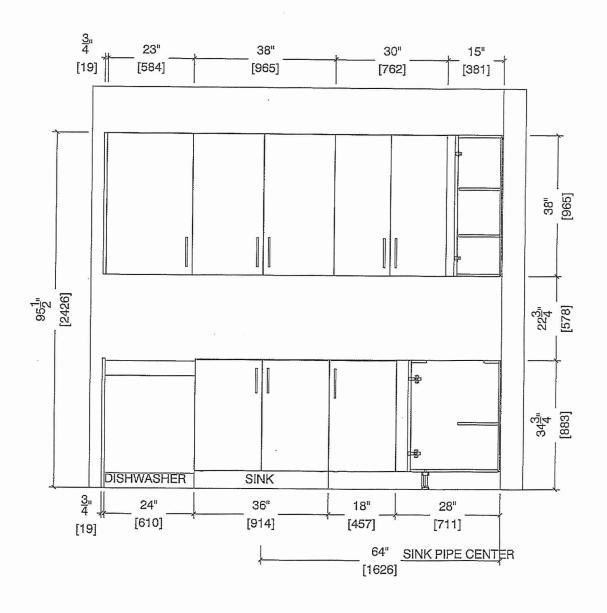



CLIENT: ROYAL PINE HOMES	JOB NAME: 2C, 203 HOLLY,	ROOM: KITCHEN	DRAWN BY: GS
SITE: FORESTSIDE ESTATES	DOOR STYLE: QTS 1022	DOOR HANDLE:	SCALE: 1/2" = 1'-0"
PHONE:	FINISH:	DRW HANDLE:	DATE: JUNE 12, 2020
EMAIL:	SPECIES: LAMINATE	TOP:	PAGE:

Customer Agrees and Accepts the following conditions: 1. The Drawing is a representation only and the installed cabinetry may vary slightly in product size, measurements, nandle appearance and location and other details. Although Quality Tops & Kitchens Ltd. (QTK) does it's best to manufacture exactly what is shown here outside factors may prevent that and some variance is to be expected and accepted by the customer. 2. These drawings represent the intellectual property of QTK and as such the customer understands and accepte that all deposits given by the customer to QTK are poperfundable after QTK has supplied drawings (either physically or electronically) to the understands and accepts that all deposits given by the customer to QTK are non-refundable after QTK has supplied drawings (either physically or electronically) to the customer. If the customer decides to cancel the order after QTK has submitted drawings to the customer, the deposit will then be considered a design fee and no money will be returned to the customer.

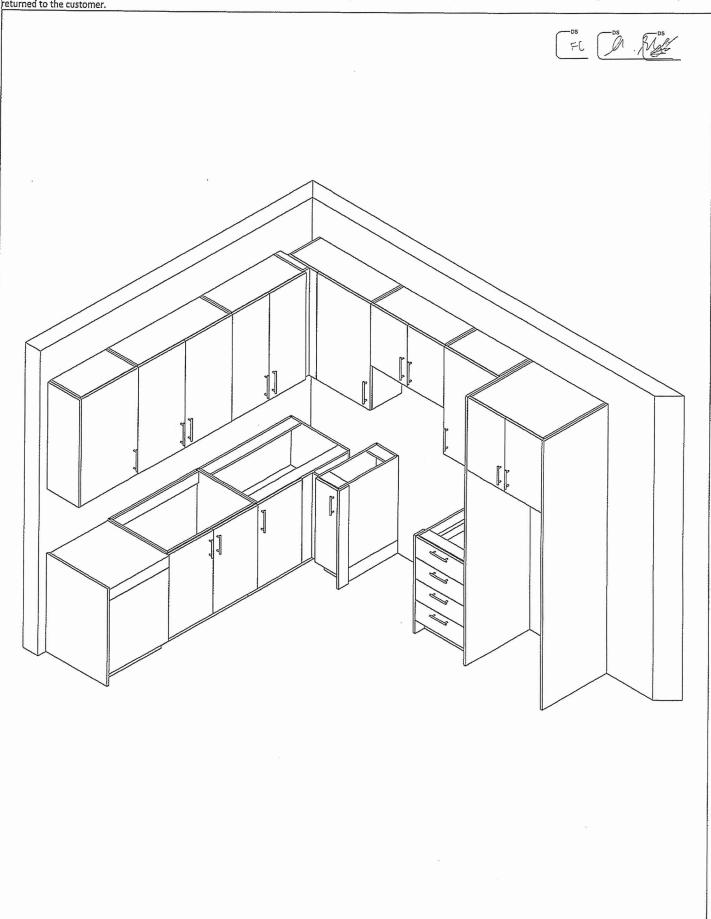



CLIENT: ROYAL PINE HOMES	MODEL: 2C, 2C3 HOLLY, 2C1 MAGNOLIA 2D RED PINE, 2C1 WINTERGREEN	ROOM: VANITY	DRAWN BY; GS
SITE: FORESTSIDE ESTATES	DOOR STYLE: QTS 1022	DOOR HANDLE:	SCALE: 1/2" = 1'-0"
PHONE:	FINISH:	DRW HANDLE:	DATE: JUNE 12, 2020
EMAIL:	SPECIES: LAMINATE	TOP:	PAGE:


COMMENTS:

BUILDING C SUITE 347 BLK 5


Customer Agrees and Accepts the following conditions: 1. The Drawing is a representation only and the installed cabinetry may vary slightly in product size, measurements, neadle appearance and location and other details. Although Quality Tops & Kitchens Ltd. (QTK) does it's best to manufacture exactly what is shown here outside factors may prevent that and some variance is to be expected and accepted by the customer. 2. These drawings represent the intellectual property of QTK and as such the customer understands and accepts that all deposits given by the customer to QTK are non-refundable after QTK has supplied drawings (either physically or electronically) to the customer. If the customer decides to cancel the order after QTK has submitted drawings to the customer, the deposit will then be considered a design fee and no money will be returned to the customer.


## POWDER ROOM PLAN (2C, 202, 201, 20, 202)



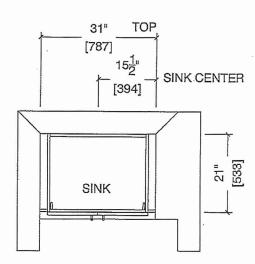

# POWDER ROOM ELEVATION (2C, 20a, 201, 20, 202)

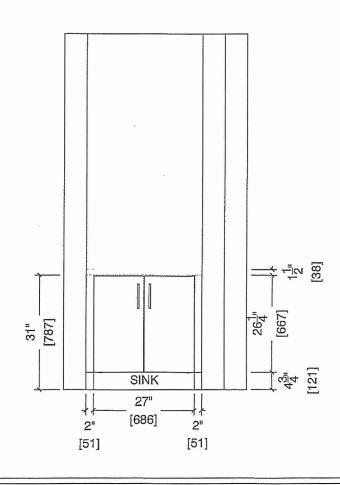

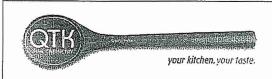


CLIENT: ROYAL PINE HOMES	MODEL: 2C, 2C(a), 2C(b) HOLLY	ROOM: VANITY	DRAWN BY: GS
SITE: FORESTSIDE ESTATES	DOOR STYLE: QTS 1022	DOOR HANDLE:	SCALE: 1/2" = 1'-0"
PHONE:	FINISH: _	DRW HANDLE:	DATE: JUNE 12, 2020
EMAIL:	SPECIES: LAMINATE	TOP:	PAGE:

COMMENTS:

BUILDING C SUITE 347 BIKS


Customer Agrees and Accepts the following conditions: 1. The Drawing is a representation only and the installed cabinetry may vary slightly in product size, measurements, handle appearance and location and other details. Although Quality Tops & Kitchens Ltd. (QTK) does it's best to manufacture exactly what is shown here outside factors may prevent that and some variance is to be expected and accepted by the customer. 2. These drawings represent the intellectual property of QTK and as such the customer understands and accepts that all deposits given by the customer to QTK are non-refundable after QTK has supplied drawings (either physically or electronically) to the customer. If the customer decides to cancel the order after QTK has submitted drawings to the customer, the deposit will then be considered a design fee and no money will be returned to the customer.

## BATH PLAN (26b, 26a, 2C)

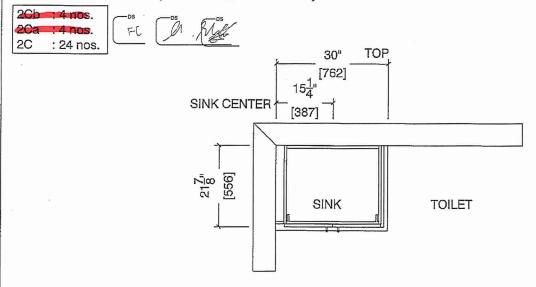

MAIN BATH

# BATH ELEVATION (20b, 20a, 2C)

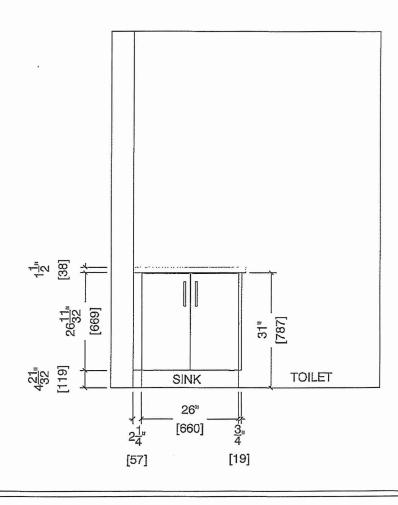




CLIENT: ROYAL PINE HOMES	MODEL: 2C,20(a) 2C(b) HOLLY	ROOM: VANITY	DRAWN BY: GS
SITE: FORESTSIDE ESTATES	DOOR STYLE: QTS 1022	DOOR HANDLE:	SCALE: 1/2" = 1'-0"
PHONE:	FINISH; _	DRW HANDLE:	DATE: JUNE 12, 2020
EMAIL:	SPECIES: LAMINATE	TOP:	PAGE:

COMMENTS:


BUILDING C SUITE 347 BLK 5

Customer Agrees and Accepts the following conditions: 1. The Drawing is a representation only and the installed cabinetry may vary slightly in product size, measurements, nandle appearance and location and other details. Although Quality Tops & Kitchens Ltd. (QTK) does it's best to manufacture exactly what is shown here outside factors may be orevent that and some variance is to be expected and accepted by the customer. 2. These drawings represent the intellectual property of QTK and as such the customer understands and accepts that all deposits given by the customer to QTK are non-refundable after QTK has supplied drawings (either physically or electronically) to the customer. If the customer decides to cancel the order after QTK has submitted drawings to the customer, the deposit will then be considered a design fee and no money will be returned to the customer.

# MASTER ENSUITE PLAN (20b, 20a, 20)

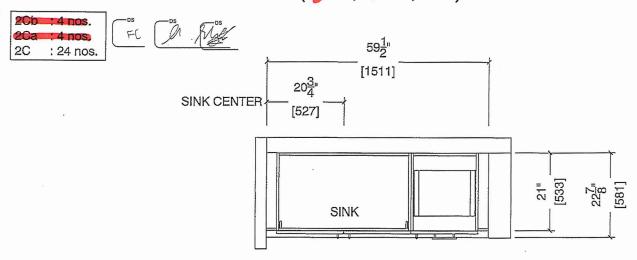

# MASTER ENSUITE ELEVATION (20b, 20a, 20)

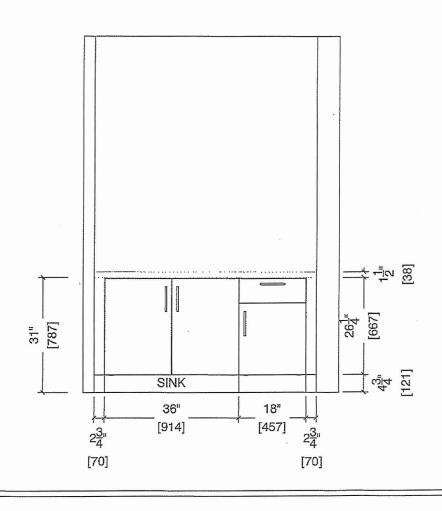

# BUILDING C SUITE 347 BLK 5

# BLANCO

### Sink Specifications

Cólour

SKU

brushed finish

401248

### Design and planning tips

· Min cabinet size: 36 in (915 mm)

Bowl Depth: 9 in ( 230.0 mm )

#### Specifications:

Installation clips, Sink template, Installation instructions, 3 ½" (90 mm) stainless steel strainer


Depending on cabinet construction, a different cabinet size may be required. Consult the cabinet manufacturer.

Codes/Standards: ASME A112.19.3-2017/ CSA B45.4-17

### QUATRUS U 1 SUPER SINGLE

Stainless steel brushed finish



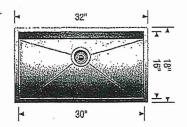



STANDARD KITCHEN FAUCET

#### Warranty

Limited lifetime warranty on all sinks and faucets. One-year warranty on all accessories and soap dispensers.

#### Code/Standards Compliance

BLANCO sinks and faucets are third-party tested and certified to CSA, cUPC, ANSI/ASME, IAPMO and NSF standards and listed by applicable certification bodies. For more information on individual product listings, contact our office or listing organization.



Need support? Learn more by watching our sink & faucet How-to videos: <a href="https://www.blanco.com/ca-en/support/how-to-videos/how-to-videos-for-sinks/">https://www.blanco.com/ca-en/support/how-to-videos/how-to-videos-for-sinks/</a>



BLANCO Canada Inc 100 Corporation Drive Brampton ON L6S 6B5 Tel & Fax

Tel: 905-494-2400 Toll free: 1-877-425-2626 Fax: 905-494-2425 Toll free: 1-877-825-2626

While BLANCO strives to provide accurate information, all images and dimensions in this document are intended for reference only and are subject to change at any time without notice. This document is not intended for use as an installation guide. For technical installation details, refer to installation instructions provided with the product. BLANCO assumes no responsibility for the use of superseded or voided specifications.