

## PURCHASER'S EXTRAS QUOTATION

The Estates of West River - Phase 1 2/857/5 Cotalio Inc TEL: RES.: 647-535-5007

PURCHASER: TARJINDER GARCHA


020

HOUSE TYPE ISABELLA-STD MAIN-4 BEDROOM-ELEVATION B

ITEM EXTRA / CHANGE UNIT PRICE EXTENDED OTY DINING ROOM- Refer to item #22 from PE#7823. DELETE the oprning created at time of 1 structural appointment. Purchaser request to close the wall between Dining Room and Main Hall as per the original floor plan layout (See Sketch) 215018 Approved As per Fonzie \*2 PURCHASER AWARE AND ACCEPTS THAT ANY CHANGES MADE TO UPGRADES 1 AFTER SIGNING THIS PURCHASERS EXTRA FORM ARE SUBJECT TO A MINIMUM ADMINISTRATION FEE OF \$1,000 PLUS A 10% HOLDBACK FEE. 20080



215019

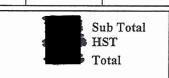

- In the event the work on the house has progressed beyond the point where the items covered by this extra cannot be installed without entailing any unusual expense, then this order is to be cancelled and any deposit paid in connection with the same is to be refunded to the Purchaser.

  The Vendor will undertake to incorporate the work covered by the sales extra in the construction of the house but will not be liable to the purchaser in any way, if for any reason the work covered by the extra is not carried out. In that event, any monies paid in connection with the same shall be returned to the Purchaser. It is understood and agreed that if for any reason whatsoever the transaction of Purchase and Sale is not completed, the total cost of extras ordered are not refundable to the Purchaser(s).

  Extras or changes will not be processed unless signed by the Vendor.

  These extras may not be amended without the written consent of 2185715 Ontario Inc..

  The Purchaser(s) and the Vendor acknowledge and agree that this form shall not be deemed to be part of the Agreement of Purchase and Sale entered into between them, nor an addendum thereto.

- them, nor an addendum thereto.
- No Estimates or orders will be accepted once construction has commenced.
- Prices are estimates only and guaranteed for a period of 5 days only.

  Any cancellations to this order, providing they can be cancelled, are subject to a \$500 minimum administration charge and a 10% cancellation charge for the total amount being cancelled.
- For Visa, Mastercard and Debit paments, transactions are identified on you statement as "SHERWAY CONSTRUCTION LTD", an Authorized Visa /Mastercard/Debit Merchant and authorized Royal Pine Homes company.


Paid By Amount			1	
Power 1	Bonus Package offe	ering (includes tax	(es) from	
Bonus Total Parmant	Royal Pine Homes	Décor Centre is b	eing applied	
Total Payment:	to this order.			
	Any remaining bala	nce(s) will be app	plied	
	accordingly to extra	as purchased.		
	Bonus Package Of	fering		
	Invoice Number	<u>Date</u>	Amount	
	8344			
	Total Bonus Used:			
	7823	12-May-22		
	Total Bonus Used:			
	Remaining Balanc	e:		
DocuSigned by:				
URCHASER: Taninder Gardia	26-Jul-22	VENDOR:		
TARHADER4GARCHA	DATE			PER: 2185715 Ontario Inc.

TAX#:1

PREPARED BY: Laura Di Pede PRINTED: 26-Jul-22 at 9:19 am

RoyluvoiceSQL.rpt 07aug20

CONSTRUCTION S	CHEDULING APPROVAL
PER:	

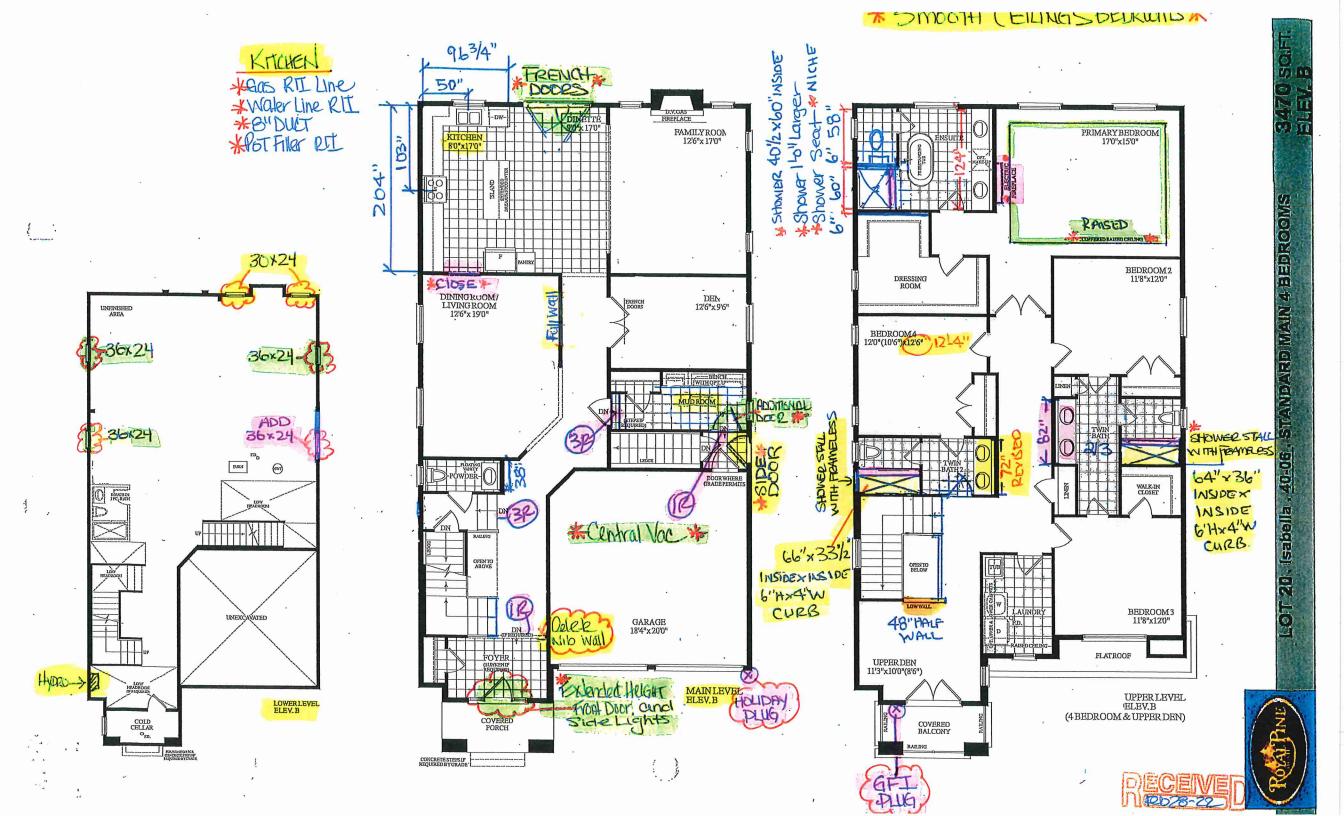







## **CONSTRUCTION SUMMARY**

2185715 Ontario Inc.

PURCHASER: TARJINDER GARCHA

TEL: RES.: 647-535-5007

LOT NUMBER	PHASE	Í	ISABELLA-S	HOUSE		ELEVATIO	N B	CLO	SING DATE		
Date Added: 12	2-May-2			Number: 7			l .				
2 - BASEMENT- I Possible Window Note:		O (X2) Large	er Basement wi	indows, in lieu o	of the builde	rs standard 30	"x16". Install	TWO (X	(2) 30"X24"	(See	Sketch) (With
3 - BASEMENT- I (With Possible With Note:			rger Basement	windows, in lie	eu of the buil	ders standard	30"x16". Insta	all THRE	E (X3) 36"X	(24" (	(See Sketch)
1 - BASEMENT- I window well) Note:	n addition	to the basem	ent windows, l	Install ONE (X	1) additional	36"x24" win	dow in the bas	sement (S	ee Sketch) (	With	Possible
1 - FRONT EXTER height door (See St Note:		tall an Extend	ded Height Sin	gle Front Door	and Side Lig	thts. Delete th	e transom abo	ove the do	oor to accom	moda	ate extended
1 - BACK EXTER Note:	IOR- Dele	ete the builde	rs standard Pat	io sliders, and in	nstall double	French door	s (See Sketch)				
1 - KITCHEN- Ins Note:	tall an 8" l	Duct, in lieu o	of the builders	standard 6" (Se	e Sketch)						
1 - TWIN BATH (with stone top, sho Note:					ver, and insta	ll a shower st	all, To include	2x2 sho	wer stall floo	or mo	osaic, Curb
1 - TWIN BATH # top, shower pot lig Note:				/Shower, and in	stall a showe	er stall, To inc	clude 2x2 show	wer stall f	loor mosaic,	Curb	with stone
1 - SECOND FLOO Note:	OR BEDR	COOMS- Inst	all Smooth ceil	lings throughou	t the second	floor bedroor	ns (Inlcudes a	ll 2nd flo	or closets)		
1 - PRIMARY BE VENDOR SPECIF Note:					10FT RAISE	D COFFERE	D CEILINGS	IN MAS	TER BEDRO	OOM	I AS PER
1 - MASTER ENS with stone and add Note:				tall larger by Al	PPROX. 1'-(	" towards the	toilet. Install	additiona	ıl wall tile, 2	x2 m	osaic, curb
1 - MASTER ENS Note:	UITE- Ins	tall a floating	shower seat in	n the Master Ens	suite shower	stall (See Ske	tch)				
1 - MASTER ENS Note: **Install 4				he Master Ensu	ite shower st	all (See Sketo	ch)				
1 - GARAGE- Relo Note:	ocate the C	Central Vac T	runk to the Gar	rage (See Sketch	———— h)						

1 - SECOND FLOOR EXTERIOR BALCONY- Install an exterior GFI plug on the second floor balcony, next to the French doors (See Sketch)

Note:





## CONSTRUCTION SUMMARY 2185715 Ontario Inc.

PURCHASER: TARJINDER GARCHA

TEL: RES.: 647-535-5007

LOT NUMBER	PHASE	HOUSE TYPE	CLOSING DATE	
020	1	ISABELLA-STD MAIN-4 BEDROOM-ELEVATION B		

Date Added: 12-May-22

**Invoice Number: 7823** 

1 - EXTERIOR- Install a Festive Soffit plug on a single pole switch (See Sketch)

Note:

1 - KITCHEN- Install a Pot Filler Rough In, in the kitchen, above the stove.

Note: \*\*PLEASE NOTE\*\* The above price is for the rough in ONLY, purchaser accepts & acknowledges that the Pot Filler finish will be chosen at time of colour chart

1 - KITCHEN- Install a Gas Line Rough In for stove (See Sketch)

Note: \*\*PLEASE NOTE\*\* builders standard electrical for electric stove to remain

1 - PRIMARY BEDROOM- Install the optional electric fireplace in the Primary Bedroom. Install the Dimplex Ignite XLF50 (See Sketch)

Note: \*\*PLEASE NOTE\*\* Price above is ONLY for the electric fireplace unit. Purchaser to select the fireplace surround at time of colour chart

1 - SIDE DOOR- Install the optional Side door, (If Grade Permits) to include builders standard exterior light (See Sketch)

Note:

1 - MUD ROOM- Install a builders standard Interior Door from the garage landing to the Mud Room (See Sketch)

Note: \*\*Approved As Per Tony

1 - DINING ROOM- Create an opening from the Main Hall to the Dining Room. Opening to be the same width as the Den opening. Return wall to match with the Den. (See Sketch)

Note: \*\*Approved As Per Fonzie / Tony

1 - KITCHEN- Close the entrance from the Kitchen to the Dining Room. (See Sketch)

Note: \*\*Purchaser accepts and acknowledges that the additional cabinetry for the kitchen, will be chosen and charged at time of colour chart\*\*

1 - FOYER- Delete the Nib Wall at the foyer (Between foyer and Main Hall) (See Sketch)

Note: \*\*Approved As Per Tony

1 - PURCHASER HAS ATTENDED A STRUCTURAL APPOINTMENT AT THE DESIGN STUDIO AND HAS DECLINED ANY ADDITIONAL UPGRADES

Note:

1 - PURCHASER AWARE AND ACCEPTS THAT ANY CHANGES MADE TO UPGRADES AFTER SIGNING THIS PURCHASERS EXTRA FORM ARE SUBJECT TO A MINIMUM ADMINISTRATION FEE OF \$1,000 Note:

1 - BONUS PACKAGE-PURCHASER TO RECEIVE \$20,000 (INCLUSIVE OF TAXES) WORTH OF UPGRADES AT THE DESIGN STUDIO AT TIME OF COLOUR CHART

Note:

This Document is Extremely Time Sensitive - Printed 13 May 22 at 10:04