



## SITE INSTRUCTION

**Forestside Estates**  
 Attmar & Palleschi Drive  
 Brampton, Ontario  
 Attn: **Vince Staffieri**

### SI A20

**PROJECT** : Forestside  
**PROJECT #** : 1331.15  
**DATE** : May. 10, 2022

Site instructions/memos and Addendums are issued only for the purpose of recording any clarification or interpretation of the contract documents or giving direction on problems resulting from field conditions. These memos are subject to the provisions of the contract documents and unless reviewed with and authorized by the Client, will not affect the contract. Should the Contractor require a change in the contract price or project schedule, he shall submit to the Client, prior to commencement of work outlined in this memo, an itemized proposal for approval.

**Title:** Revisions to plans as itemized.

Reference:		Changes:
A102	Door Schedule	<ul style="list-style-type: none"> <li>Remove Door Label B105 from door schedule.</li> </ul>
A211A	P1 Underground	<ul style="list-style-type: none"> <li>Remove Small electrical room walls and door under building D.</li> </ul>

**Reason:** Revisions to plans to remove small electrical room under building 'D' as per site request.



**GRAZIANI + CORAZZA**  
 ARCHITECTS INC

**D. Biase** C.E.T.  
 Principal

**Distribution:**


Royal Pine Homes	Vince Staffieri Cinzia Caruzo	<a href="mailto:vince@royalpinehomes.com">vince@royalpinehomes.com</a> <a href="mailto:Cinzia@royalpinehomes.com">Cinzia@royalpinehomes.com</a>
Jablonski Engineering	Kevin Deonaraine	<a href="mailto:kdeonaraine@astint.on.ca">kdeonaraine@astint.on.ca</a>
United Engineering	Rene Cuales Leonard Matthews Susan Pan Mark Giorgi	<a href="mailto:rene@u-eng.ca">rene@u-eng.ca</a> <a href="mailto:Lenard@u-eng.ca">Lenard@u-eng.ca</a> <a href="mailto:susan@u-eng.ca">susan@u-eng.ca</a> <a href="mailto:mark@u-eng.ca">mark@u-eng.ca</a>
Candevcon Limited	Diarmund Hogan Dudister Damnaraigh	<a href="mailto:dhorgan@candevcon.com">dhorgan@candevcon.com</a> <a href="mailto:dude@candevcon.com">dude@candevcon.com</a>
Starfire Sprinkler Systems	Elite Novosselova Peter Adrian	<a href="mailto:elitecanada@hotmail.com">elitecanada@hotmail.com</a> <a href="mailto:Peter@starfiresystems.biz">Peter@starfiresystems.biz</a>
Strybos Barron King Ltd.	Bryn Barron Kaleigh Gills Sydney Martel	<a href="mailto:bbarron@strybos.com">bbarron@strybos.com</a> <a href="mailto:kgillis@strybos.com">kgillis@strybos.com</a> <a href="mailto:smartel@strybos.com">smartel@strybos.com</a>
Graziani + Corazza Architects	Domenic Biase Gino Colangelo Fernando Croatto	<a href="mailto:dbiase@gc-architects.com">dbiase@gc-architects.com</a> <a href="mailto:gcolangelo@gc-architects.com">gcolangelo@gc-architects.com</a> <a href="mailto:FCroatto@gc-architects.com">FCroatto@gc-architects.com</a>



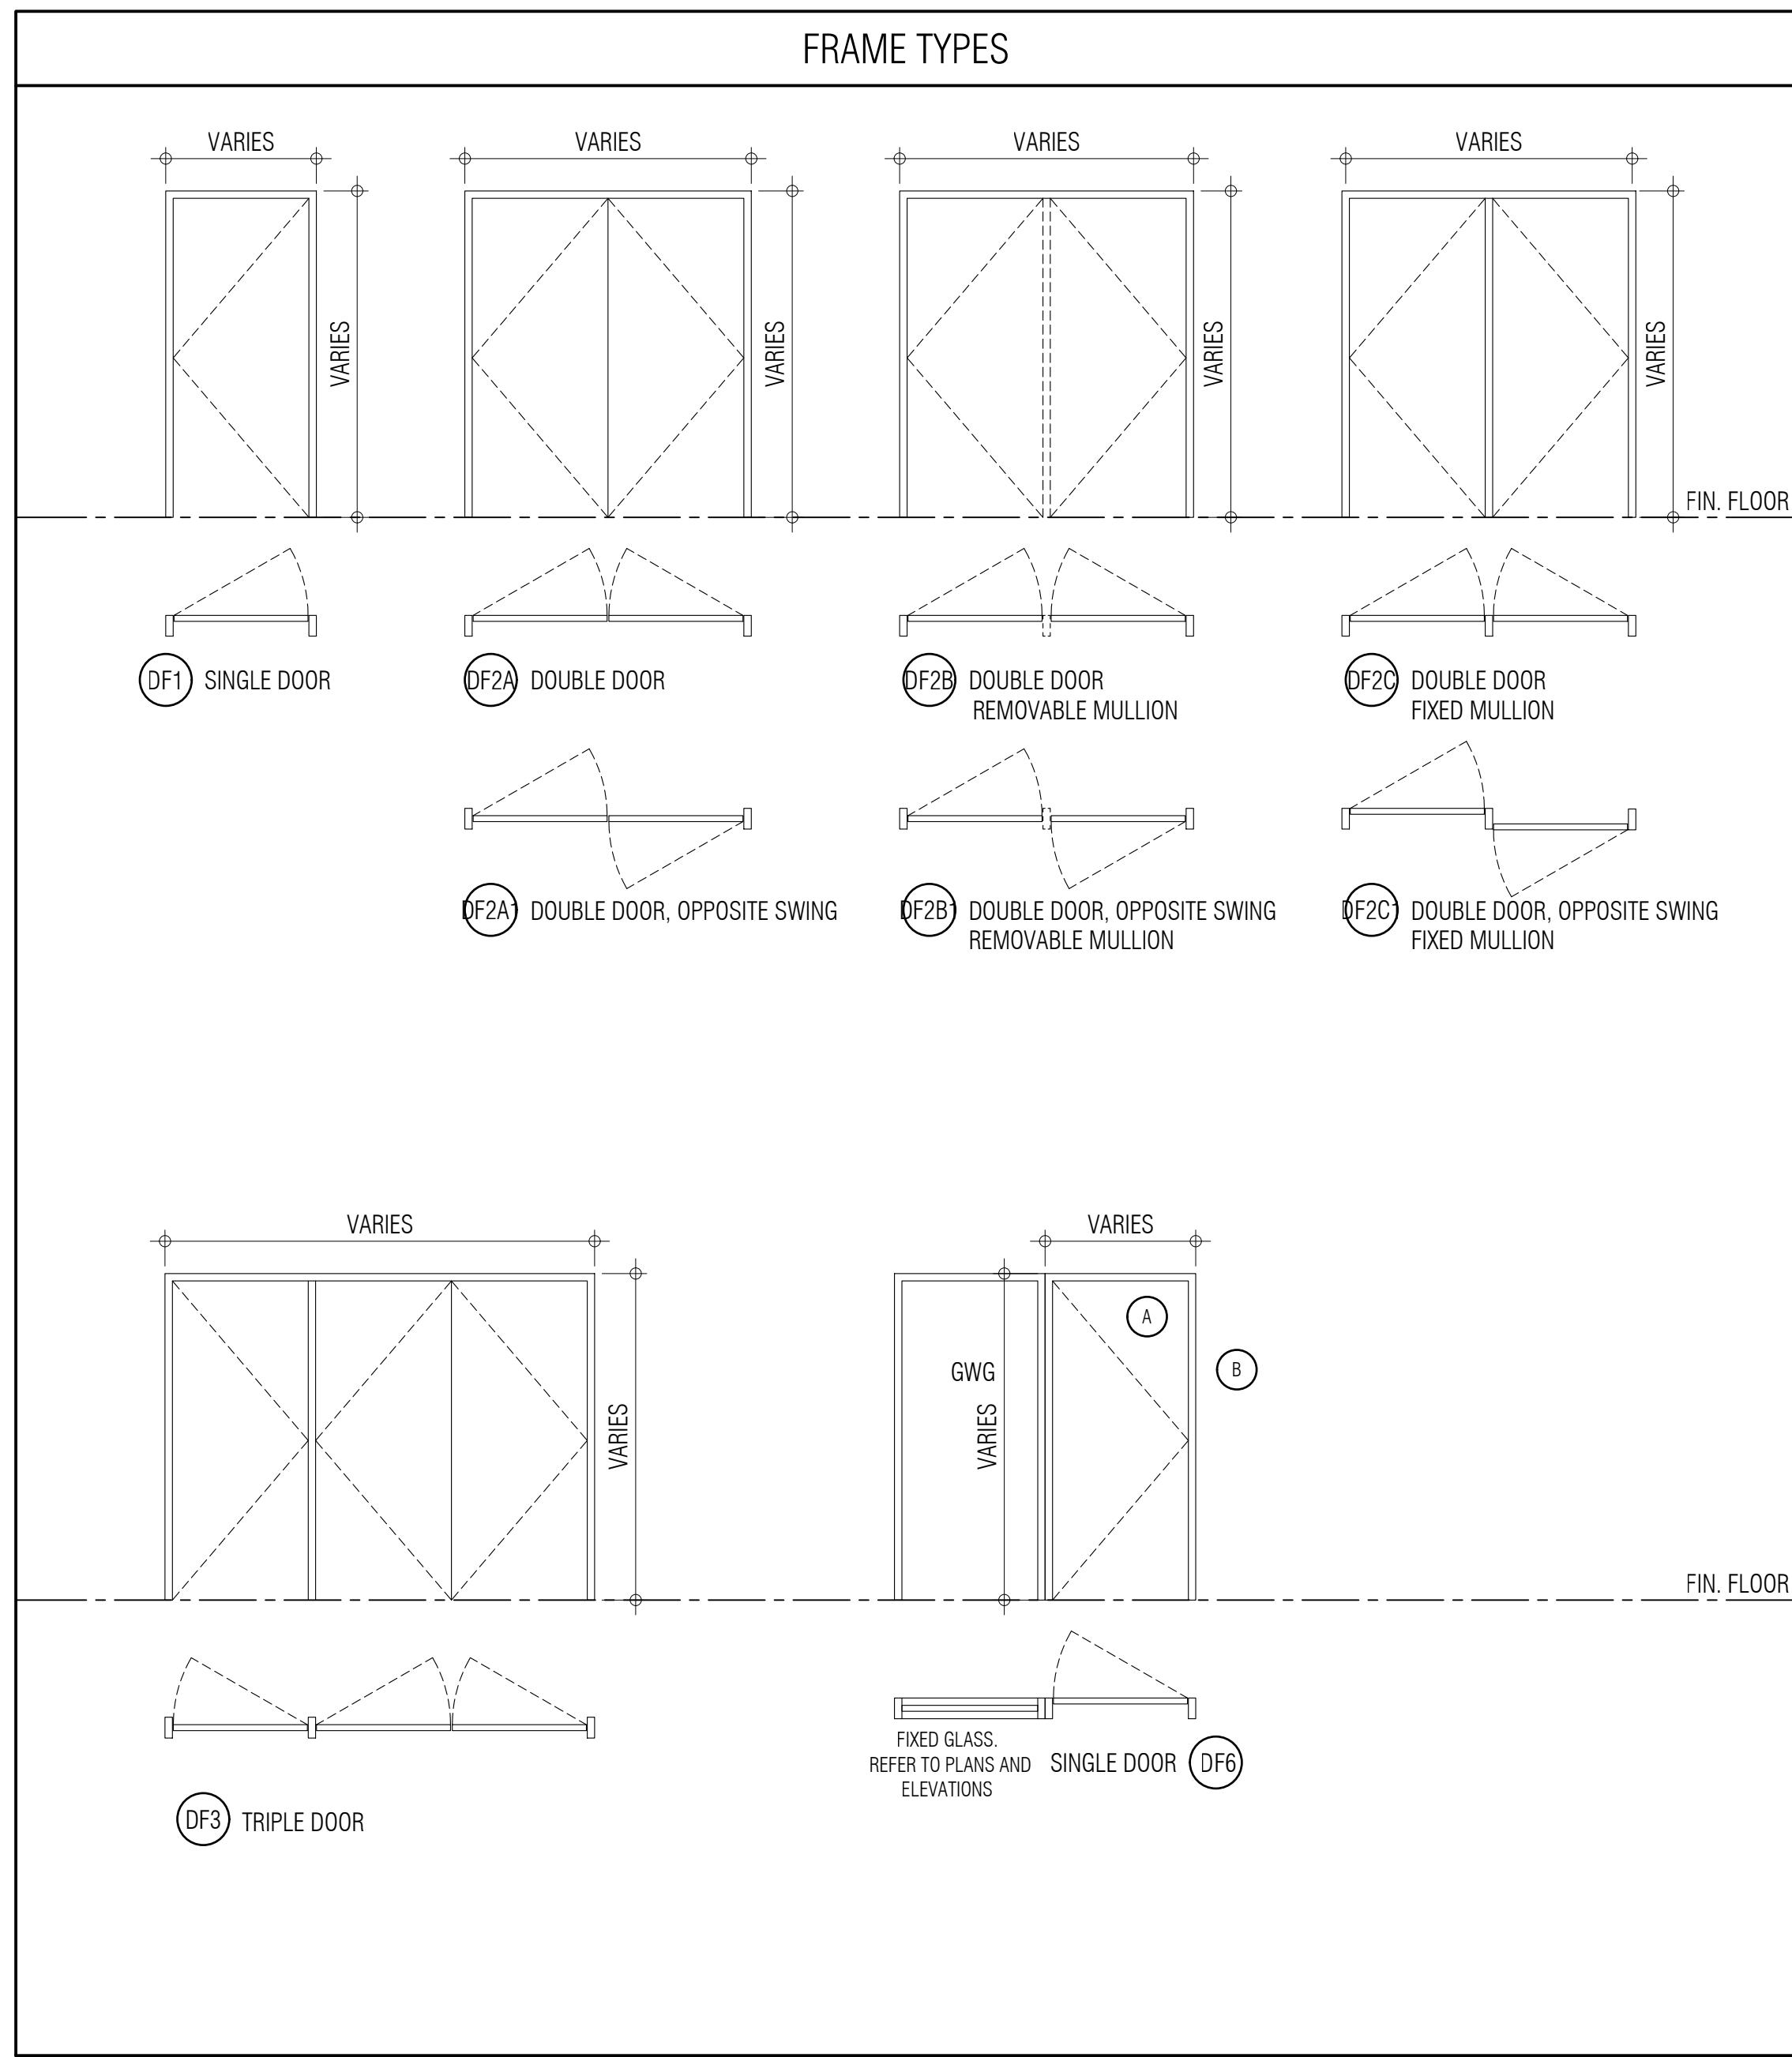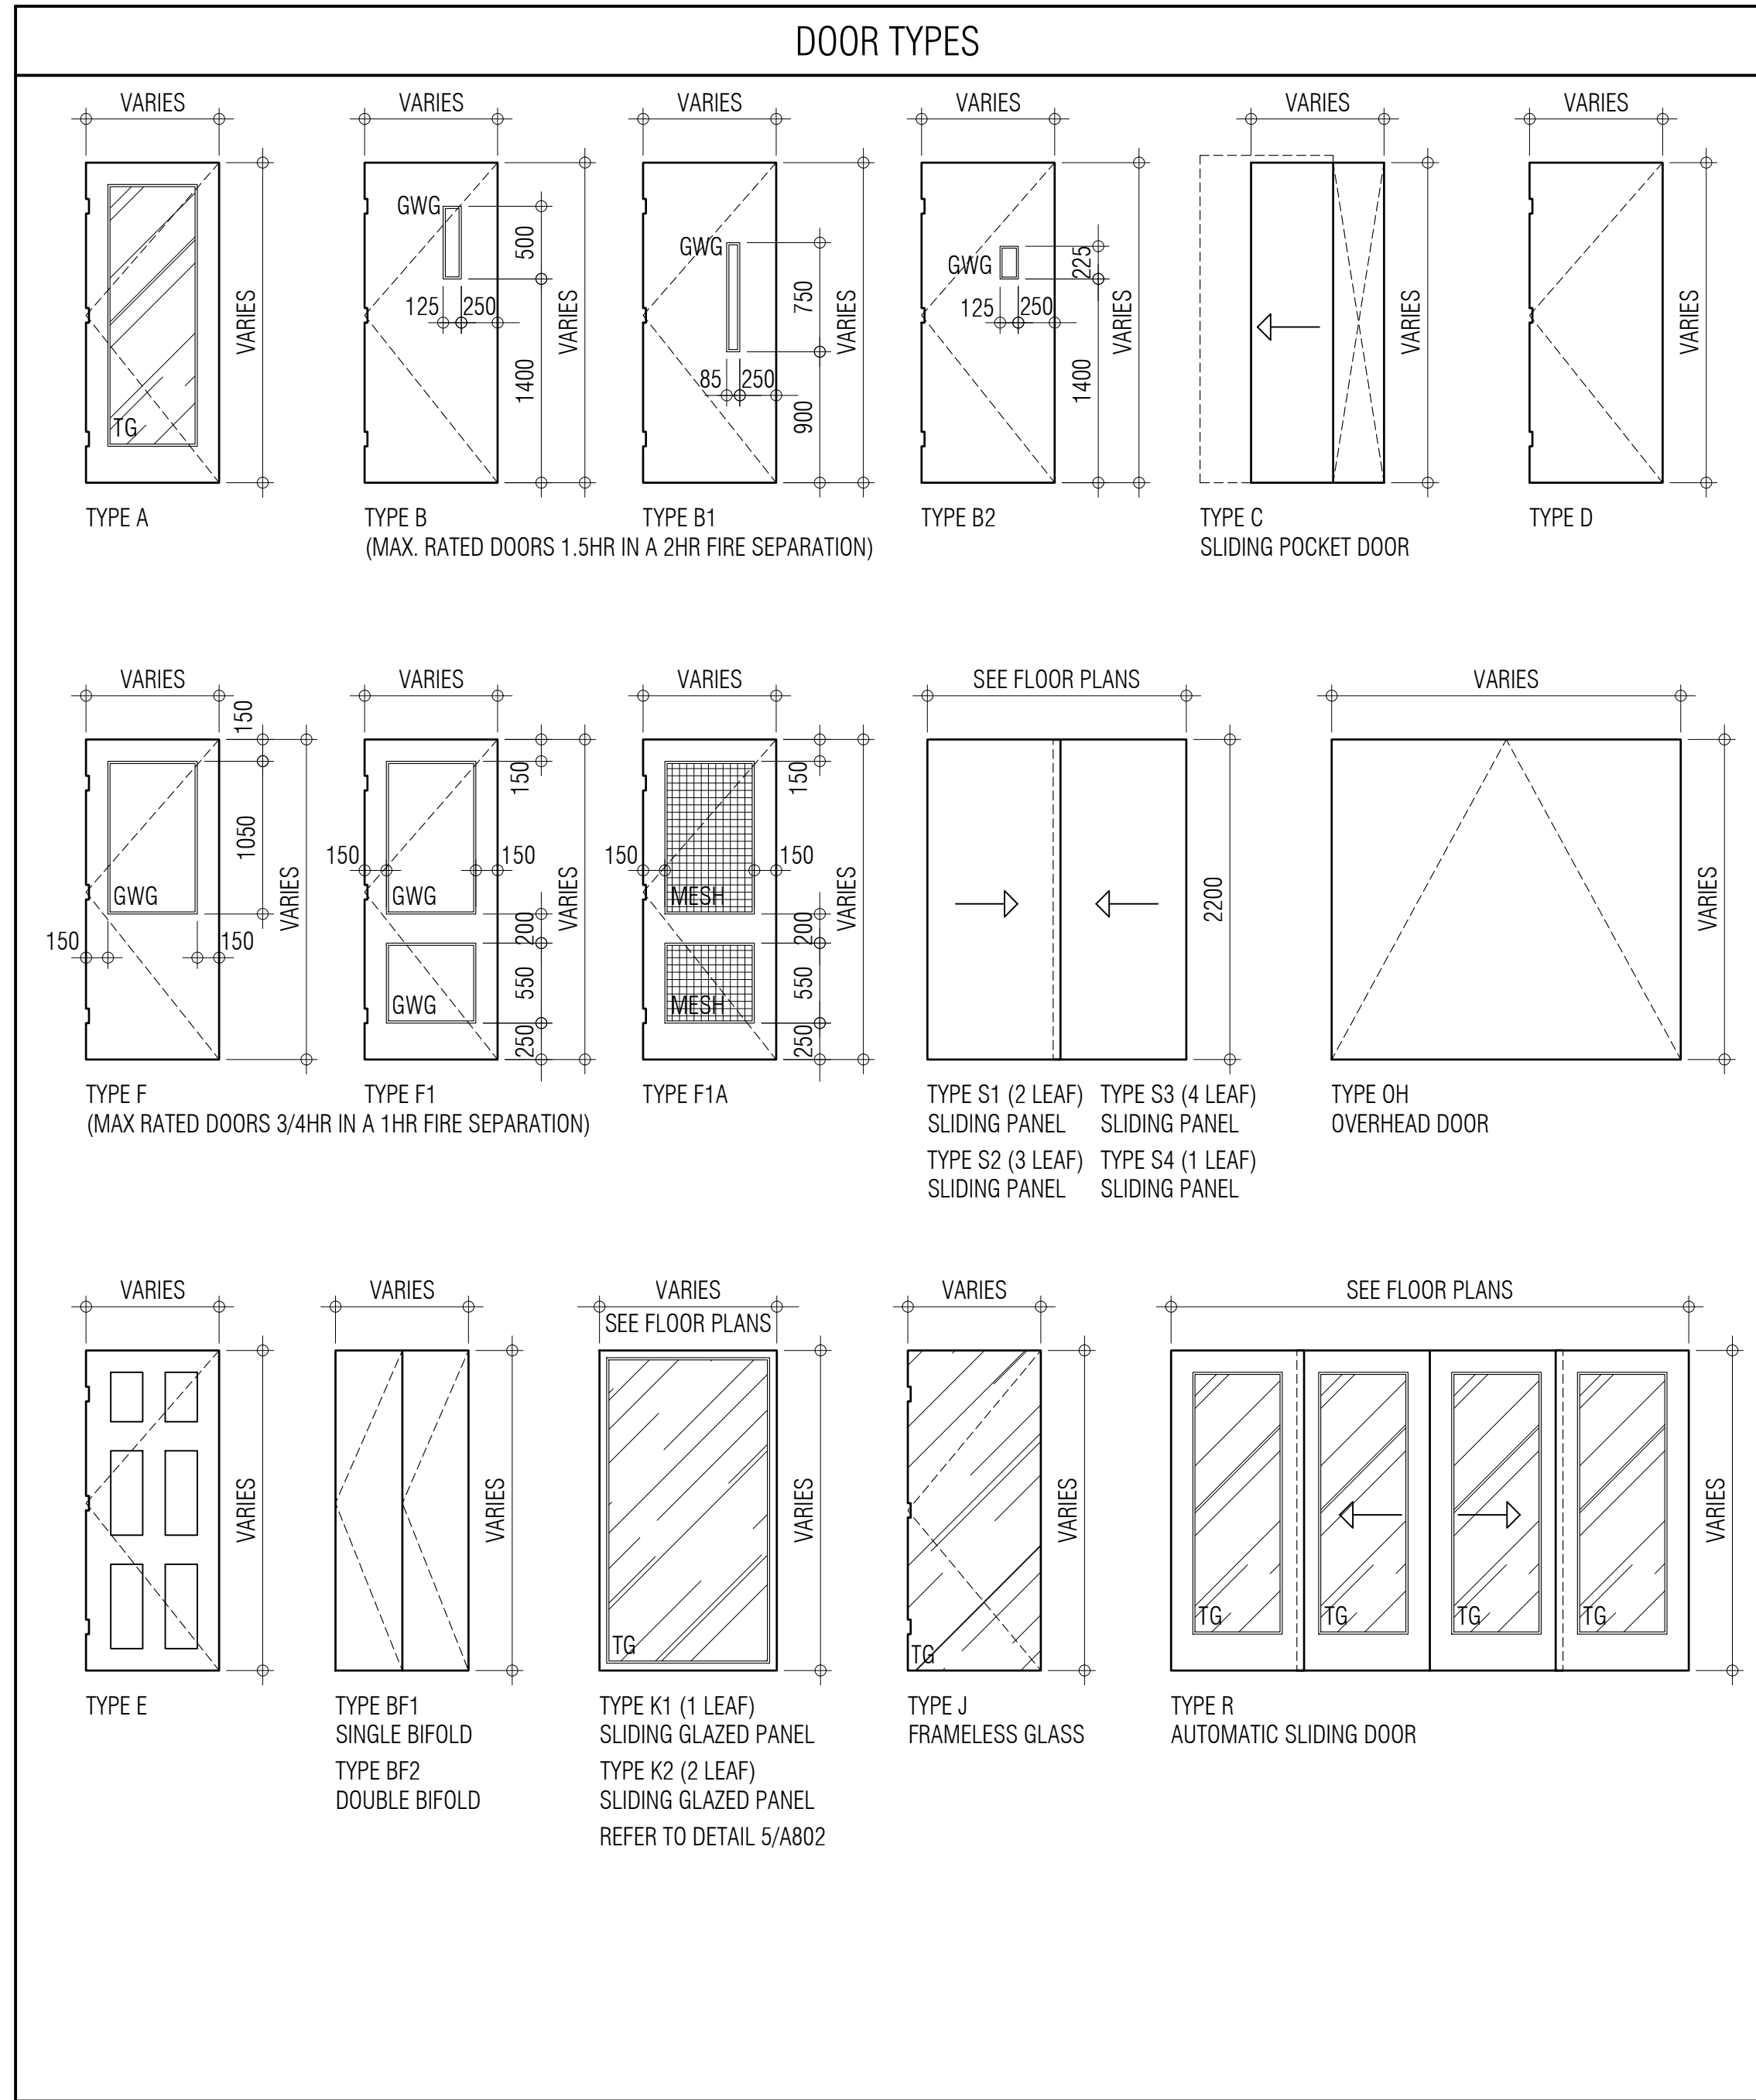


DOOR SCHEDULE																
DOOR NO.	LOCATION		FIRE RATING	TYPE	DOORS					FRAMES			THRESHOLD		REMARKS	
	FROM	TO			WIDTH	SIZE HEIGHT	THICK.	MATERIAL	GLASS	FINISH	TYPE	MATERIAL	FINISH	MATERIAL		FINISH
TYPICAL SUITE DOORS	S01	CORRIDOR	SUITE	20 MIN.	D	965	2130	45	SC		PT	DF1	HM	PT		
	S02	BEDROOM			D	810	2130	35	HC		PT	DF1	WD	PT		
	S02A	BEDROOM														
	S02B	BEDROOM														
	S03	BATHROOM		D	810	2130	35	HC		PT	DF1	WD	PT			
	S03A	BATHROOM		D	760	2130	35	HC		PT	DF1	WD	PT			
	S04	CLOSET(SLIDING)		S	VARIES	2130										
	S05	W/D		D	760	2130	35	HC		PT	DF1	WD	PT			
	S06	PWD ROOM		D	810	2130	35	HC		PT	DF1	WD	PT			
	S07	STORAGE		D	810	2130	35	HC		PT	DF1	WD	PT			
	S08	MECH.		D	2-610	2130	35	HC		PT	DF1	WD	PT			
S09	W.I.C		D	810	2130	35	HC		PT	DF1	WD	PT				
S10	W.I.C		D	760	2130	35	HC		PT	DF1	WD	PT				
S10A	W.I.C		D	710	2130	35	HC		PT	DF1	WD	PT				
TYPICAL DOORS	T01	EXIT STAIR	CORRIDOR	1.5 HR	B1	860	2130	45	HM	GWG	PT	DF1	HM	PT		
	T01A	EXIT STAIR	CORRIDOR	1.5 HR	B1	860	2130	45	HM	GWG	PT	DF1	HM	PT		PANIC HARDWARE
	T01B	STAIR LANDING	STAIR LANDING		F1A	860	2130	45	HM		PT	DF1	HM	PT		PANIC HARDWARE
	T02	ELECTRICAL CLOSET	CORRIDOR	45 MIN.	D	2-965	2130	45	HM		PT	DF2A	HM	PT		
	T03	GARBAGE DISPOSAL	CORRIDOR	45 MIN.	D	965	2130	45	HM		PT	DF	HM	PT		
P1 UNDERGROUND LEVEL DOORS	B101	GENERATOR ROOM	VISITOR PARKING	1.5 HR	D	2-965	2130	45	HM		PT	DF2A	HM	PT		
	B102	AIR LOCK 'b'	VISITOR PARKING	1.5 HR	B	860	2130	45	HM	GWG	PT	DF1	HM	PT		PANIC HARDWARE
	B103	EXIT STAIRS 'b'	AIR LOCK 'b'	1.5 HR	B	860	2130	45	HM	GWG	PT	DF1	HM	PT		PANIC HARDWARE
	B104	LOCKERS RM 1	VISITOR PARKING	1.5 HR	D	915	2130	45	HM		PT	DF1	HM	PT		ELECTRIC STRIKE, AUTO DOOR OPERATOR
	B105	RESERVED														
	B106	B.W.H 'a'	PARKING	1.5 HR	D	965	2130	45	HM		PT	DF1	HM	PT		
	B107	GARBAGE ROOM 'a'	PARKING	1.5 HR	D	2-915	2130	45	HM		PT	DF2a	HM	PT		
	B108	MACHINE ROOM 'a'	PARKING	1.5 HR	D	915	2130	45	HM		PT	DF1	HM	PT		
	B109	JANITOR RM	PARKING	1.5 HR	D	965	2130	45	HM		PT	DF1	HM	PT		
	B110	ELEV. LOBBY 'd'	JANITOR RM	1.5 HR	D	965	2130	45	HM		PT	DF1	HM	PT		
	B111	LOCKERS RM '3'	PARKING	1.5 HR	D	965	2130	45	HM		PT	DF1	HM	PT		ELECTRIC STRIKE, AUTO DOOR OPERATOR
	B112	SUB ELEC ROOM 'D'	PARKING	1.5 HR	B	965	2130	45	HM	GWG	PT	DF1	HM	PT		
	B112a	ELEVATOR LOBBY 'D'	AIR LOCK 'd'	1.5 HR	B	965	2130	45	HM	GWG	PT	DF1	HM	PT		
	B113	AIR LOCK '1'	PARKING	1.5 HR	B	965	2130	45	HM	GWG	PT	DF1	HM	PT		PANIC HARDWARE
	B114	LOCKERS RM '3'	PARKING	1.5 HR	D	965	2130	45	HM		PT	DF1	HM	PT		ELECTRIC STRIKE, AUTO DOOR OPERATOR
	B115	MECH. ROOM 1	PARKING	1.5 HR	D	915	2130	45	HM		PT	DF1	HM	PT		
	B116	AIR LOCK 'd1'	PARKING	1.5 HR	B	860	2130	45	HM	GWG	PT	DF1	HM	PT		PANIC HARDWARE
	B117	EXIT STAIRS 'd1'	AIR LOCK 'd1'	1.5 HR	B	860	2130	45	HM	GWG	PT	DF1	HM	PT		PANIC HARDWARE
	B118	SUB ELEC ROOM 1	PARKING	1.5 HR	D	915	2130	45	HM		PT	DF1	HM	PT		
	B119	AIR LOCK 'c1'	PARKING	1.5 HR	B	860	2130	45	HM	GWG	PT	DF1	HM	PT		PANIC HARDWARE
	B120	EXIT STAIRS 'c1'	AIR LOCK 'c1'	1.5 HR	B	860	2130	45	HM	GWG	PT	DF1	HM	PT		PANIC HARDWARE
	B121	VISITOR PARKING	U/G PARKING		OH	5500	2130									overhead door c/w vibration isolated mounting hardware
	B122	AIR LOCK 'b1'	PARKING	1.5 HR	B	860	2130	45	HM	GWG	PT	DF1	HM	PT		PANIC HARDWARE
	B123	EXIT STAIRS 'b1'	AIR LOCK 'b1'	1.5 HR	B	860	2130	45	HM	GWG	PT	DF1	HM	PT		PANIC HARDWARE
	B124	LOCKERS RM '5'	AIR LOCK 'c1'	1.5 HR	D	965	2130	45	HM		PT	DF1	HM	PT		ELECTRIC STRIKE, AUTO DOOR OPERATOR
	B124a	LOCKERS RM '2'	PARKING	1.5 HR	D	965	2130	45	HM		PT	DF1	HM	PT		ELECTRIC STRIKE, AUTO DOOR OPERATOR
	B125	SUB ELEC ROOM 'c'	PARKING	1.5 HR	D	915	2130	45	HM		PT	DF1	HM	PT		
	B126	GARBAGE ROOM 'c'	PARKING	1.5 HR	D	2-915	2130	45	HM		PT	DF2a	HM	PT		
	B127	B.W.H 'c'	GARBAGE ROOM 'c'	1.5 HR	D	965	2130	45	HM		PT	DF1	HM	PT		
	B128	AIR LOCK 'c'	PARKING	1.5 HR	B	965	2130	45	HM	GWG	PT	DF1	HM	PT		ELECTRIC STRIKE, AUTO DOOR OPERATOR
	B129	ELEV. LOBBY 'c'	AIR LOCK 'c'	1.5 HR	B	965	2130	45	HM	GWG	PT	DF1	HM	PT		ELECTRIC STRIKE, AUTO DOOR OPERATOR
	B130	MACHINE RM. 'C'	ELEV. LOBBY 'c'	1.5 HR	D	965	2130	45	HM		PT	DF1	HM	PT		
	B131	STORAGE 'C'	PARKING	1.5 HR	D	965	2130	45	HM		PT	DF1	HM	PT		
	B132	GARBAGE ROOM 'b'	PARKING	1.5 HR	D	2-915	2130	45	HM		PT	DF2a	HM	PT		
	B132a	GARBAGE ROOM 'a'	PARKING	1.5 HR	D	2-965	2130	45	HM		PT	DF2a	HM	PT		
	B132b	GARBAGE ROOM 'a'	PARKING	1.5 HR	D	965	2130	45	HM		PT	DF2a	HM	PT		
	B133	MAIN ELECTRICAL ROOM	GARBAGE ROOM 2	1.5 HR	D	965	2130	45	HM		PT	DF1	HM	PT		
	B134	B.W.H 'b'	ELEV. LOBBY 'b'	1.5 HR	D	965	2130	45	HM		PT	DF1	HM	PT		
	B135	MACHINE ROOM 'b'	ELEV. LOBBY 'b'	1.5 HR	D	965	2130	45	HM		PT	DF1	HM	PT		ELECTRIC STRIKE, AUTO DOOR OPERATOR
B136	SUB ELEC ROOM 'b'	PARKING	1.5 HR	D	965	2130	45	HM		PT	DF1	HM	PT		ELECTRIC STRIKE, AUTO DOOR OPERATOR	
B137	ELEV. LOBBY 'b'	AIR LOCK 'b'	1.5 HR	B	965	2130	45	HM	GWG	PT	DF1	HM	PT			
B138	AIR LOCK 'b'	PARKING	1.5 HR	B	965	2130	45	HM	GWG	PT	DF1	HM	PT			
B139	AIR LOCK 'a'	PARKING	1.5 HR	D	2-915	2130	45	HM		PT	DF2a	HM	PT			
B140	MACHINE RM. 'a'	ELEVATOR LOBBY 'a'	1.5 HR	D	915	2130	45	HM		PT	DF2a	HM	PT		ELECTRIC STRIKE, AUTO DOOR OPERATOR	
B141	MAIN TELECOM RM	PARKING	1.5 HR	D	965	2130	45	HM		PT	DF1	HM	PT		ELECTRIC STRIKE, AUTO DOOR OPERATOR	
B142	AIR LOCK '4'	WALKWAY	1.5 HR	B	965	2130	45	HM	GWG	PT	DF1	HM	PT		ELECTRIC STRIKE, AUTO DOOR OPERATOR	
B143	SUB ELECTRICAL ROOM 'a'	PARKING	1.5 HR	B	965	2130	45	HM	GWG	PT	DF1	HM	PT			
B144	ELEV. LOBBY '4'	AIR LOCK '4'	1.5 HR	B	965	2130	45	HM	GWG	PT	DF1	HM	PT			
B145	B.W.H 'a'	ELEV. LOBBY 'a'	1.5 HR	D	965	2130	45	HM		PT	DF1	HM	PT			
B146	B.W.H 'a'	GARBAGE ROOM 'a'	1.5 HR	D	965	2130	45	HM		PT	DF1	HM	PT			
B147	AIR LOCK 'a'	ELEV. LOBBY 'a'	1.5 HR	D	965	2130	45	HM		PT	DF1	HM	PT			
B148	B.W.H	GARBAGE ROOM 4	1.5 HR	D	965	2-915	45	HM		PT	DF2a	HM	PT			
B149	SPRINK. / MAIN MECH. ROOM 'a'	PARKING	1.5 HR	D	965	2130	45	HM		PT	DF1	HM	PT			
B150	(ROGERS)	PARKING	1.5 HR	D	915	2130	45	HM		PT	DF1	HM	PT		ELECTRIC STRIKE, AUTO DOOR OPERATOR	
B151	LOCKERS ROOM #4	PARKING	1.5 HR	D	965	2130	45	HM		PT	DF1	HM	PT		ELECTRIC STRIKE, AUTO DOOR OPERATOR	
B152	AIR LOCK 'd'	PARKING	1.5 HR	B	860	2130	45	HM	GWG	PT	DF1	HM	PT		PANIC HARDWARE	
B153	EXIT STAIRS 'd'	AIR LOCK 'd'	1.5 HR	B	860	2130	45	HM	GWG	PT	DF1	HM	PT		PANIC HARDWARE	
B154	AIR LOCK 'b2'	PARKING	1.5 HR	B	860	2130	45	HM	GWG	PT	DF1	HM	PT		PANIC HARDWARE	
B155	EXIT STAIRS 'b2'	AIR LOCK 'b2'	1.5 HR	B	860	2130	45	HM	GWG	PT	DF1	HM	PT		PANIC HARDWARE	
B156	AIR LOCK 'a2'	PARKING	1.5 HR	B	860	2130	45	HM	GWG	PT	DF1	HM	PT		PANIC HARDWARE	
B157	EXIT STAIRS 'a2'	AIR LOCK 'a2'	1.5 HR	B	860	2130	45	HM	GWG	PT	DF1	HM	PT		PANIC HARDWARE	
B158	MECHANICAL RM	PARKING	1.5 HR	D	2-965	2130	45	HM		PT	DF1	HM	PT			
B159	INTAKE SHAFT	PARKING	1.5 HR	D	965	2130	45	HM		PT	DF1	HM	PT			
GROUND FLOOR DOORS	LOCATION			FIRE RATING	TYPE	DOORS					FRAMES			THRESHOLD		REMARKS
	FROM	TO	WIDTH			SIZE HEIGHT	THICK.	MATERIAL	GLASS	FINISH	TYPE	MATERIAL	FINISH	MATERIAL	FINISH	
	G01	TOWNHOUSE	PATIO		A	915	2105	45	ALUM			DF1	ALUM	ANOD		
	G02	TOWNHOUSE	EXTERIOR		A	860	2105	45	ALUM			DF1	ALUM	ANOD		
	G03	SERVICE ROOM	EXTERIOR	45 MIN.	D	915	2130	45	HM		PT	DF	HM	PT		
	G04	EXTERIOR	U/G PARKING		OH	5585	2130									overhead door c/w vibration isolated mounting hardware
	G05	EXIT STAIRS	EXTERIOR	45 MIN.	F1	965	2105	45	ALUM	GWG		DF6	ALUM	ANOD		PANIC HARDWARE
	G06	LOBBY	EXTERIOR													HOC, PANIC HARDWARE
G07	LOBBY	VESTIBULE		REFER TO WINDOW WALL SYSTEM SCHEDULE											ADO, ELECTRIC STRIKE, PANIC HARDWARE	
G08	VESTIBULE	EXTERIOR													ADO,SLIDER (BREAK OPEN)	



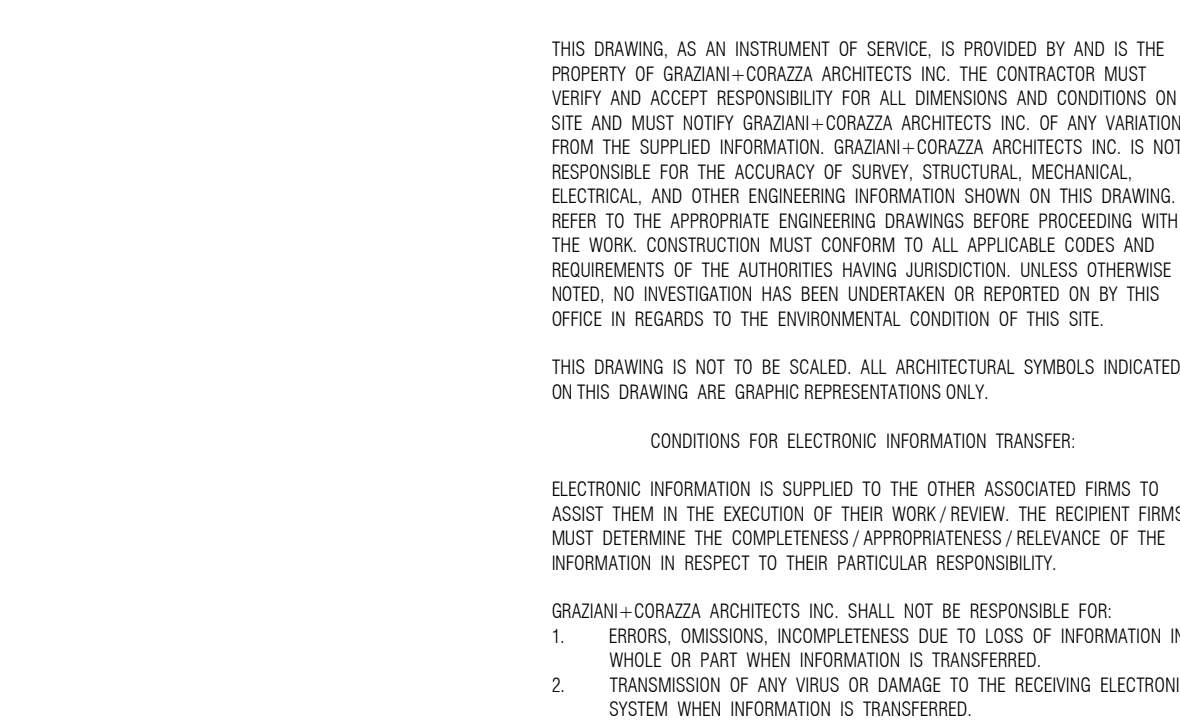

01.	Oct 07, 2019	issued for tender
02.	Mar. 13, 2020	issued for design coordination #2
03.	Mar.16,2020	issued for addendum #2
04.	Mar.16,2020	issued for addendum #3
05.	Aug.24,2020	issued for addendum #4
06.	Sept. 28, 2020	issued for permit
07.	Oct.20,2020	issued for addendum #5
08.	Nov.23,2020	issued for addendum #6
09.	Dec.14,2020	issued for addendum #7
10.	Jan.18,2021	issued for addendum #8
11.	Mar. 2, 2021	issued for permit
12.	Mar.09,2021	issued for addendum #9
13.	Mar.10,2021	issued for addendum #9R
14.	Mar.26,2021	issued for progress
15.	May 14, 2021	issued for Site Instruction #1
16.	June 15, 2021	issued for Site Instruction #2
17.	July 7, 2021	re-issued for permit
18.	July 15, 2021	issued for Site Instruction #3
19.	July 27, 2021	issued for Site Instruction #4
20.	Aug. 3, 2021	issued for Site Instruction #5
21.	Aug. 18, 2021	issued for Site Instruction #6
22.	Aug. 20, 2021	Re-issued for permit.
23.	Sept. 07, 2021	issued for Site Instruction #7
24.	Sept. 09, 2021	issued for Site Instruction #8
25.	Sept. 16, 2021	issued for Building D Permit Revisions
26.	Sept. 22, 2021	issued for Site Instruction #9
27.	Oct. 6, 2021	Re-issued for permit.
28.	Oct. 28, 2021	issued for Site Instruction #10
29.	Oct. 28, 2021	issued for Site Instruction #11
30.	Nov. 05, 2021	issued for Site Instruction #12
31.	Dec. 3, 2021	issued for Site Instruction #13
32.	Dec. 6, 2021	issued for Site Instruction #14
33.	Dec. 7, 2021	issued for Site Instruction #15
34.	Jan. 26, 2022	issued for Site Instruction #16
35.	Jan. 31, 2022	issued for Site Instruction #17
36.	Mar. 11, 2022	issued for Site Instruction #18
37.	Apr. 29, 2022	issued for Site Instruction #19
38.	May. 10, 2022	issued for Site Instruction #20

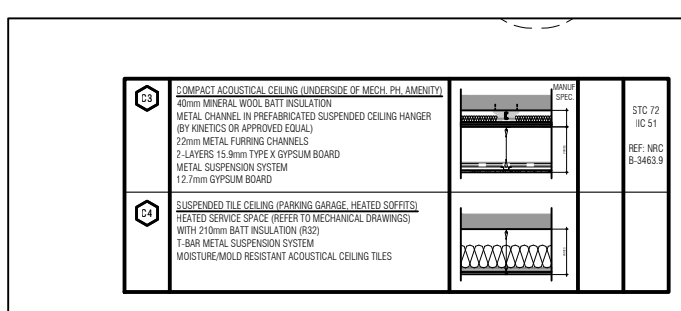[illegible]