THE CHARLEST STATE OF THE STATE	EAU-9F1U-4B IU-B9B1-9Z1U100111118			OLOUR SCHEME *	Donaloslin	GOLE	12	×
	urchasers	Decor Consultan	Model and Elevation	Telephone Res. / Bus	Project 101			Property
AHYOUNG STEPHANIE	E MANGAL & BORIS MANGAL	Melissa Di Marino	LAWRENCE Elev B1	(929) 351-2063 /	Grovetrail Developments		10/2022	11 Block 56
Page 1 of 3	-Flooring-	11	Vall Tile					——————————————————————————————————————
Master Ensuite	Description 13X13 MALENA CARBON (STD)		a <u>in</u> (10 MALENA CARBON (STD)	Accent/Insert	Border / Listello		Pattern	· /ambing
Main Bathroom	13X13 UNQUE GREV			DS DS:	N/A		NONE	WHITE
Bsmt. Bath	13X13 "COSTA WHITE		10 CINDUE GREY	N/A SM BM	N/A		NONE	WHITE
	TOXIO COS IX VVAILE		10: UNIWAL WHITE GLOSSY	N/A Disc	[N/A		NONE	WHITE
Powder Room	KOWO Co Co							
	43X13 (DSTA WHITE	N/A	A	N/A	N/A		NONE	WHITE
Kitchen/Dinette	8"Highland Alderson Oak EE-H-285		4 White Herringbone Marble (UPGD)	N/A	N/A		NONE	STD
Laundry	13X13 COSTA WHITE	N/A	A	N/A	N/A		NONE	STD
	L						7/10/12	
							JL	
oyer	20X20 CALACATTA GRIS (UPGD)		Railings and Stairs			Camaia - 881-11	<u> </u>	
laîn Hall	8*Highland Alderson Oak EE-H-285	(STD)	ailings (STD) Vintage Red Oak PEWTE	R (STD) Landing - Upper Alde	erson Oak EE-H-285 (STD)	Cornice Moulding	NONE NONE	
Breat Room	8"Highland Alderson Oak EE-H-285	(STD) II !	ickets (STD) PLAIN FLAT BLACK	Landing - Lower 13X	(13 MALENA ICE (STD)	Living Room	NONE	
•			osts (STD) Vintage Red Oak PEWTE			Dining Room	NONE	
smt. Rec.Room	8"Highland Alderson Oak EE-H-285	(STD)	tringers (STD) Vintage Red Oak PEWTE			Family Room	NONE	
			reads (STD) Vintage Red Oak PEWTE isers (STD) Vintage Red Oak PEWTE			Main Hall	NONE	
			isers (STD) Vintage Red Oak PEWTE unner N/A	<u>R(STD)</u>		Kitchen	NONE	
			irim—————			2nd Floor Hall	NONE	
Jpper Hall	OSI II-bland All OLET HORE		aseboard & Casing STANDARD-COL	ONIAL Knobs STAND	DARD			
pper rian	8"Highland Alderson Oak EE-H-285	F	ront Door Glass STANDARD	Hinges STAND				
<i>a</i> , , , , , ,			terior Doors STD-CarraraSmoo	oth Grip Set STAND	DARD			
Taster Bedroom	8"Highland Alderson Oak EE-H-285		lotes		J			
edroom 2	8"Highland Alderson Oak EE-H-285	(UPGD)	*MASTER ENSUITE- INSTALL PENNY R *STANDARD INTERIOR DOORS- CARR	OUND BLACK MATTE (UPGD) SHOWER S ARA SMOOTH MAIN FLOOR- 2ND FLOOR	STALL FLOOR MOSAIC AND WHIT	E QUARTZ SHOWER	CURB TOP**	
edroom 3	8*Highland Alderson Oak EE-H-285	(UPGD)	1	MA COMOCALL MINING L'ÉGOK-SIAD L'ÉGOK	EXTENDED HEIGHT CARRARAS	ΜΌΟΤΗ̈́		
				·				
		Pag	ge 1 of 3	h				
/				DocuSigned by:	DocuSigned by:			
		Cor	nsultant:	Purchaser: Myoung Stephanic	Mangaler Bons Many			9
t: 11 Block 56 Project:	Grovetrail Developments Inc.	Model: AMPENCE	Melissa Di Marino	AHYOUNG STEPHANIE MANGAL	BORIS MANGAL	Vendor:	Grovelrail Develonme	intelar
	The state of the s	MONDI LAWNENCE	riev D1		55-5 statem (2000 100 100 100 100 100 100 100 100 100			7 11, 2022 4:19 pm





PURCHASER'S EXTRAS QUOTATION Oak Ridge Meadows - Phase 1

PURCHASERS: AHYOUNG STEPHANIE MANGAL and BORIS MANGAL

TEL: RES.: 929-351-2063


LOT NUMBER	PHASE	HOUSE-TYPE	
11 Block 56	1	LAWRENCE Elev B1	

ITEM	EXTRA / CHANGE	ОТУ	UNIT PRICE	EXTENDED
1	BASEMENT - Install a Rough-In Line Set for future Air Conditioner for basement.	1		
215900	**Priced as per Steve			
*2 13386	PURCHASER AWARE AND ACCEPTS THAT ANY CHANGES MADE TO UPGRADES AFTER SIGNING THIS PURCHASERS EXTRA FORM ARE SUBJECT TO A MINIMUM ADMINISTRATION FEE OF \$1,000 PLUS A 10% HOLDBACK FEE.		\$0.00	\$0.00
215901				,



Payment Summary

Paid By

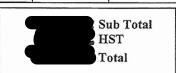

- In the event the work on the house has progressed beyond the point where the items covered by this extra cannot be installed without entailing any unusual
- expense, then this order is to be cancelled and any deposit paid in connection with the same is to be refunded to the Purchaser.

 The Vendor will undertake to incorporate the work covered by the sales extra in the construction of the house but will not be liable to the purchaser in any way, if for any reason the work covered by the extra is not carried out. In that event, any monies paid in connection with the same shall be returned to the Purchaser. It is understood and agreed that if for any reason whatsoever the transaction of Purchase and Sale is not completed, the total cost of extras ordered are not refundable to the Purchaser(s). 2.

- Extras or changes will not be processed unless signed by the Vendor.

 These extras may not be amended without the written consent of Grovetrail Developments Inc..

 The Purchaser(s) and the Vendor acknowledge and agree that this form shall not be deemed to be part of the Agreement of Purchase and Sale entered into between them are an addendum thereto. them, nor an addendum thereto.
- No Estimates or orders will be accepted once construction has commenced.

- Prices are estimates only and guaranteed for a period of 5 days only.

 Any cancellations to this order, providing they can be cancelled, are subject to a \$500 minimum administration charge and a 10% cancellation charge for the total
- Any cancellation to this close, providing and state of the state of th 10.

Bonus Summary

Paid By Amount Amendment Total Payment:	Bonus Package offer Royal Pine Homes D to this order. Any remaining balan accordingly to extras	écor Centre is being ce(s) will be applied purchased.	g applied	
	Bonus Package Offe	ring		
·	Invoice Number	<u>Date</u>	Amount	
	7520 Total Bonus Used: Remaining Balance:	4-Oct-21	B	
PURCHASER: Lugung Stephanic Mangal AHOOEDIC STEPHANIE MANGAL Docusigned by:	16-Aug-22 DATE	VENDOR:	PER	e Grovetrail Developments Inc.
PURCHASER: Bon's Mangal BORJESTEINGAL	16-Aug-22 DATE			

TAX#:1

PREPARED BY: Laura Di Pede PRINTED: 16-Aug-22 at 9:39 am

RoyInvoiceSQL.rpt 07aug20

CONSTRUCTION SCHEDULING APPROVAL
PER:
DATE:





CONSTRUCTION SUMMARY

Grovetrail Developments Inc.

PURCHASERS: AHYOUNG STEPHANIE MANGAL and BORIS MANGAL

TEL: RES.: 929-351-2063

LOT NUMBER	PHASE	HOUSE TYPE	CLOSING DATE	
11 Block 56	1	LAWRENCE Elev B1	11-Oct-22	

Date Added: 19-Jan-22

Invoice Number: 7659

1 - Standard Cable, Telephone and Conduit Rough (See Sketch)

Note:

1 - GARAGE DOOR- Install the builders standard garage door handle with lock

Note:

1 - APPLIANCE PACKAGE- Install the Standard Appliance Package throughout the home, where applicable.

Note:

1 - KITCHEN- Kitchen Redesign Fee for below upgrades

Note:

1 - KITCHEN- Install a 1st Upgrade counter top, throughout the kitchen, where applicable, in lieu of the builders standard counter top.

Note: Price includes additional 2'-0" of 1st upgrade counter top for the island and additional 5'-0" of 1st Upgrade counter top for the stove wall. (See Sketch for the revsied kitchen layout)

Priced as per Continental

1 - KITCHEN- Extend the island cabinetry approximately 2'-0" towards the Dinette area (STANADRD CABINET) (See Villa Kitchen Sketch)

Note:

1 - KITCHEN- Extend the island counter top approximately 2-0" of additional towards the Dinette area. Install additional 2'-0" of 1st Upgrade counter top Emmerstone Carrara White.

Note: **Includes Standard "A" Edge

PLEASE NOTEPrice for additional 1st Upgrade counter top is included in above Item #5

1 - KITCHEN- Install an additional 5'-0" of Standard Upper Cabinets on the stove wall, to be installed towards the Dientte area. Price includes additional standard crown moulding (See Sketch)

Note

1 - KITCHEN- Install an additional 5'-0" of Standard Base Cabinets on the stove wall, to be installed towards the Dinette area. (See Sketch)

Note:

1 - KITCHEN- Install an additional 5'-0" (APPROX) of 1st upgrade counter top on the stove wall, towards the Dinette area. Install the Emmerstone Carrara White

Note: **Includes Standard "A" Edge

PLEASE NOTEPrice for additional 1st Upgrade counter top is included in above Item #5

35 - KITCHEN- Install an upgrade #7 kitchen backsplash, 1x4 White Herringbone Marble throughout the kitchen, where applicable, in lieu of the builders standard kitchen backsplash. Price includes additional backsplash tile, as per the extended cabinetry.

Note:

1 - KITCHEN- Install a built in microwave in base cabinet with drawer below. To be installed on the additional cabinetry area of stove wall.

Note: **Purchaser to provide microwave specification and trim kit**

1 - KITCHEN- Install electrical outlet on a dedicated line for the built in micro, to be installed on base cabinetry (See Sketch for location)

Note: **Price for electrcial plug is subject to change, once teh microwave specifications have been received and reviewed**

95 - FOYER- Install a 1st Upgrade floor tile on the Foyer ONLY, in lieu of the builders standard floor tile. Install the 20X20 CALACATTA GRIS

Note:

1 - KITCHEN/DINETTE- Install Laminate throughout the Kitchen/Dientte area, in lieu of the builders standard floor tile. Install the 8" Highland Alderson Oak EE-H-285.

Note:





CONSTRUCTION SUMMA

Grovetrail Developments Inc.

PURCHASERS: AHYOUNG STEPHANIE MANGAL and BORIS MANGAL

TEL: RES.: 929-351-2063

LOT NUMBER	PHASE	HOUSE TYPE	CLOSING DATE	
11 Block 56	1	LAWRENCE Elev B1	11-Oct-22	

Date Added: 19-Jan-22

Invoice Number: 7659

1 - SECOND FLOOR- Install Laminate throughout the 2nd floor, in lieu of the builders standard carpet. Install the 8" Highland Alderson Oak, throughout the Master Bedroom, bedroom #2, and #3 Note:

15 - MASTER ENSUITE SHOWER STALL- Install upgraded shower stall floor, in lieu of the builders standard 2x2 mosaic. Install the Upgrade 6-Penny Round Black Matte, on the Master Ensuite shower stall floor ONLY

Note:

1 - MASTER ENSUITE- Upgrade the Master Ensuite shower stall faucet, INstall the Moen ALIGN Positemp Shower Only with 3 Function Transfer Valve/Trim and Slide Bar with Hand Shower In Chrome Model # T2192EP/U361CI/UT4191/62320/3887EP/A725 C

Note: **Please note** Purchaser accepts & ackowledges that the standard plumbing faucet and tub faucet will NOT match the style of the Moen upgraded Align

1 - MASTER ENSUITE- Purchaser's request to install an additional GFI plug behind the toilet, or as close as possible to behind the Toilet, for a possible future Electronic Washlet/bidet.

Note: (To be installed by the purchaser on tehir own after closing)

1 - KITCHEN- In addition to the builders standard kitchen ceiling light in the kitchen area, install a Ceiling light on a seperate switch, above the island, centred (See Sketch)

Note:

1 - Purchaser to receive TEN (X10) Potlights on Main floor as per their Standard Features and Finishes List **SEE BELOW**

Note:

1 - GREAT ROOM- In addition to the builders standard ceiling light and switch, install TEN (X10) Potlights in the Great Room. All TEN (X10) potlights to be on one sepereate switch (See Sketch)

1 - GREAT ROOM- Raise and install the builders standard conduit pipe in the great room, above the fireplace for a future TV on wall. Conduite pipie to be raised and installed at APPROX. 60" AFF (See Sketch)

Note:

1 - GREAT ROOM- Install an electrical plug above the fireplace for a future TV on wall. Installed next to the conduit pipe, at APPROX. 60" AFF (See Sketch)

Note:

1 - GREAT ROOM- Purchaser's request to NOT install a mantle for the fireplace. Purchaser accepts and acknowledges that the wall will protrude into the Great Room APRROX. 7"-8".

Note: Fireplace wall to be drywalled from floor to ceiling and painted the standard SILVER BIRCH colour.

PLEASE NOTE Fireplace Unit to be installed at approximately 18" AFF

1 - PURCHASER HAS ATTENDED A STRUCTURAL AND COLOR APPOINTMENT AT THE DECOR CENTRE AND HAS DECLINED ANY ADDITIONAL UPGRADES.

Note:

1 - PURCHASER AWARE AND ACCEPTS THAT ANY CHANGES MADE TO UPGRADES AFTER SIGNING THIS PURCHASERS EXTRA FORM ARE SUBJECT TO A MINIMUM ADMINISTRATION FEE OF \$1,000 PLUS A 10% HOLDBACK FEE.

Note:

Date Added: 04-Oct-21 **Invoice Number: 7520**

1 - BASEMENT- Install FINISHED BASEMENT - TOWNHOME

*See Attached Schedule A-1 **

Note:

10 - SECOND FLOOR- Install extended height interior doors throughout the 2nd floor doors, where applicable. To include TEN (X10) Approximate door height 96"

Note:





CONSTRUCTION SUMMARY

Grovetrail Developments Inc.

PURCHASERS: AHYOUNG STEPHANIE MANGAL and BORIS MANGAL

TEL: RES.: 929-351-2063

LOT NUMBER	PHASE	HOUSE TYPE	CLOSING DATE	
11 Block 56	1	LAWRENCE Elev B1	11-Oct-22	

Date Added: 04-Oct-21

Invoice Number: 7520

1 - SECOND FLOOR (UPPER HALL & BEDROOMS) Install SMOOTH CEILINGS throughout the - UPPER HALL AND BEDROOMS - TOWNHOMES

Note:

1 - GREAT ROOM- Install the Optional Electric Fireplace in the Great Room. Install the Napoleon Model # NEFL42CHS (See Sketch)

Note: **Selection of Mantle/Finishes for fireplace mantle will be discussed and chosen at the decor appointment. The above price is strictly for the electric fireplace unit**

1 - PURCHASER HAS ATTENDED A STRUCTURAL APPOINTMENT WITH THE DECOR CENTRE VIA PHONE AND HAS DECLINED ANY ADDITIONAL UPGRADES.

Note:

1 - PURCHASER AWARE AND ACCEPTS THAT ANY CHANGES MADE TO UPGRADES AFTER SIGNING THIS PURCHASERS EXTRA FORM ARE SUBJECT TO A MINIMUM ADMINISTRATION FEE OF \$1,000 PLUS A 10% HOLDBACK FEE.

Note

1 - BONUS PACKAGE - PURCHASER HAS APPLIED \$7,500 UPGRADE PROMOTIONAL PACKAGE TOWARDS THE PURCHASE PURCHASE OF UPGRADES IN THIS AGREEMENT.

Note:


This Document is Extremely Time Sensitive - Printed 26 Jan 22 at 13:31


StaConstructionSuymmarySQL.rpt 23nov10


DocuSign Envelope ID: 97BC3FD7-6D98-4669-83EF-74A5456B6078


* INTERIOR COLOUR SCHEME *

	'urcnasers IE MANGAL & BORIS MANGAL	Melissa Di Marino	Model and Elevation LAWRENCE Elev B1	Telephone Res. / Bus (929) 351-2063 /	Grove	Project etrail Developments Inc.	Closing Date	Property 11 Block 56
	┌Interior Paint	Cabinet			1			ļ
Page 2 of 3	<u>Description</u>	Style			Countertop	Co	unter Edge	Handle / Knob
Master Ensuite	STD - SILVER BIRCH		MAPLE SOAPSTONE				(STD)	930396DBK 50
Main Bathroom	STD - SILVER BIRCH	(STD) EURO	MAPLE SOAPSTONE		Emmerstone MA	PLE WHITE (STD) A"	(STD)	930396DBK 616
Bsmt. Bath	STD - SILVER BIRCH	(STD) EURO	MAPLE SOAPSTONE		Emmerstone MA	PLE WHITE (STD) ("A"	(STD)	930396DBK
Davidson.	land out the pipe.							
Powder Room	STD - SILVER BIRCH	(STD) EURO	MAPLE SOAPSTONE		Emmerstone MA	PLE WHITE (STD) "A"	(STD)	930396DBK
Kitchen/Dinette	STD - SILVER BIRCH	(STD) THEF	RMOFOIL NEW YORK WHITE	V	Emmerstone Car	rrara White (UPGD)"A"	(STD)	930396DBKS
Laundry	STD - SILVER BIRCH	N/A	**************************************		j 🗀			
							, , , , , , , , , , , , , , , , , , ,	
Foyer	STD - SILVER BIRCH							
Main Hall	STD - SILVER BIRCH							
Great Room	STD - SILVER BIRCH		mission mission management	V. 1070-1072-1072-1072-1072-1072-1072-1072-	**************************************	Notes		
		Applianc	e Opening/Dimension			**STANDARD APPLIANCES**	9 700 0 F	
			ze 36" OPENING Rang	e STANDARD		**36" FRIDGE OPENING** **STANDARD STAINLESS STE	EL EXHAUST FAN**	
		Built-Ins		wave None		*		
Bsmt. Rec.Room	STD - SILVER BIRCH			ust Opening 6" 08"		***************************************		
	[Dishwash	er Cabinet Std 24in Opening	21172 Stotel Color				
Upper Hall	STD - SILVER BIRCH		× .		3.000			
	1	Fireplace	Test transfer out of the control of					
		Fireplace		Fireplace N/A				l i
Master Bedroom	STD - SILVER BIRCH		Flooring LAMINATE (STD)	Location Flooring N/A				
Bedroom 2	STD - SILVER BIRCH	Style Finish	Drywall Box Pinted Drywall	Style N/A N/A				
Bedroom 3	STD - SILVER BIRCH	Marble	N/A	Marble N/A				
		Hearth	N/A	Hearth N/A				
		Page 2 of Decor Cor		Docusigned by: Uyoung Stephan occupations occupations	ui Manad Purohas	Docusigned by: Boris Mangal F49D0959F9F7442 BORIS MANGAI	Vendon:	
Lot: 11 Block 56 Proje	ct: Grovetrail Developments Inc	. Model: LAWRENCE F	ilev B1	AHYOLING STEPHANIF MANGAL		BORIS MANGAI	Gravelra Develo	Jan 44, 2022 4:40 pm

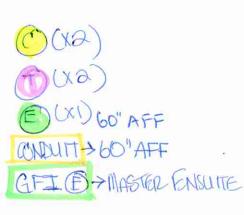

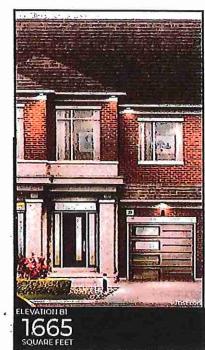

 

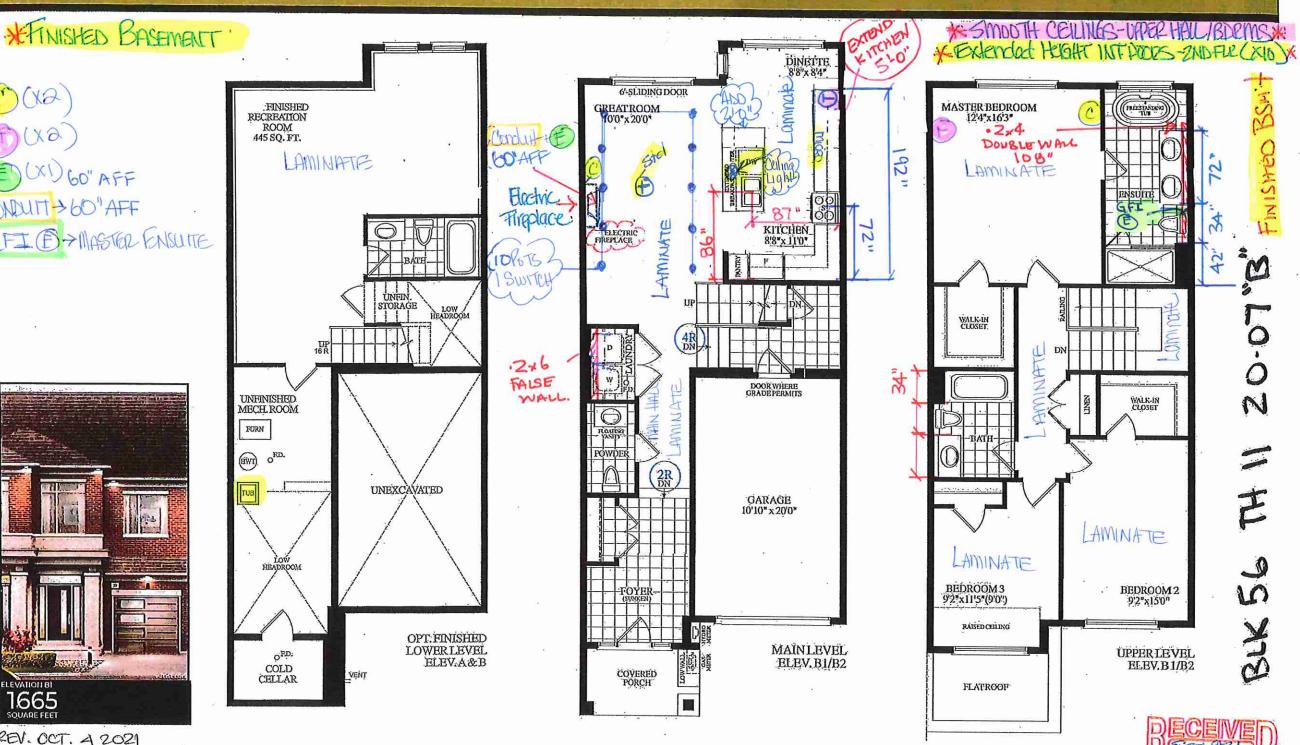



8111 Jane St. Unit 10 Concord, Ontario L4K 4L7 Tel. (905) 669-7028 Fax. (905) 669-7903 email: designstudio@villakitchens.ca www.villakitchens.ca

CLIENT: ROYAL PINE HOMES PROJECT: CENTERFIELD ADDRESS: RP-CE-MASTER MODEL: LAWRENCE 2007

KITCHEN


NOTE: BULKHEAD BASED ON A STANDARD PROFILED CROWN

BLK 56 LOT 11

DRAWN BY: DIDI DATE: SEPT 09/2021

REVISION: JANUARY 05/2022

PAGE: 1 OF 1

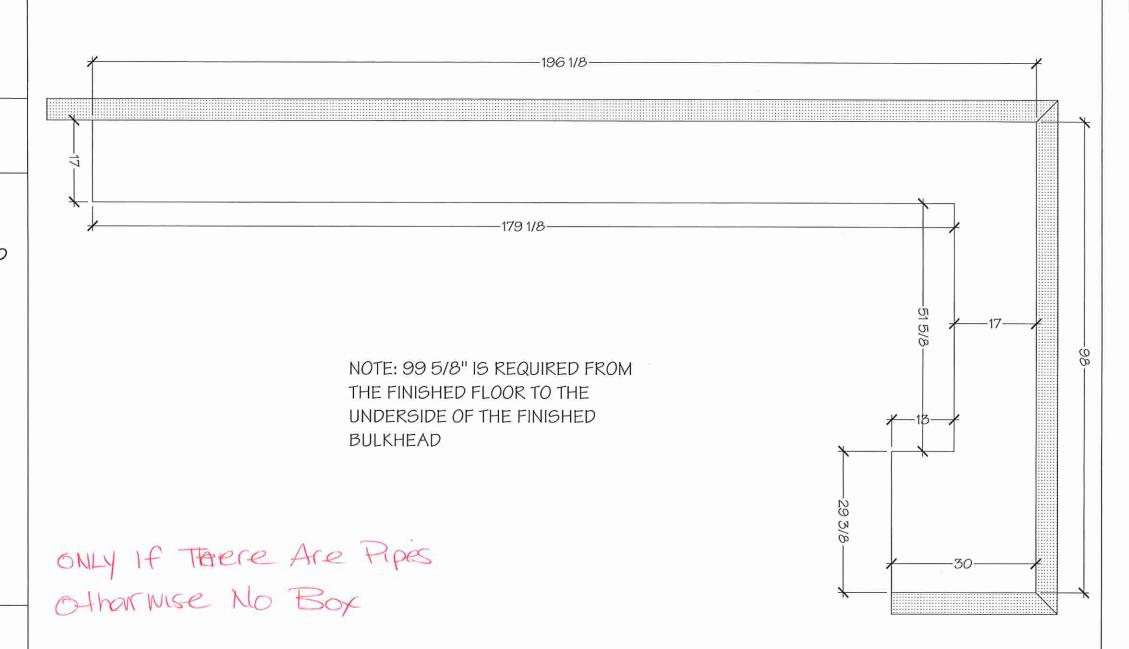

WITCHENS & FINE CABINETRY LTD

8111 Jane St. Unit 10 Concord, Ontario L4K 4L7 Tel. (905) 669- 7028 Fax. (905) 669 - 7903 email: designstudio@villakitchens.ca www.villakitchens.ca

CLIENT: ROYAL PINE HOMES PROJECT: CENTERFIELD

ADDRESS: RP-CE-BLK 56 LOT 11

MODEL: LAWRENCE 2007

KITCHEN

NOTE: THIS SITE GETS STD-CROWN

5M



-192--138 MICRO C/L--72 DUCT C/L-W. M 341/2 341/2/ 341/2/ 29 / 313/4/ 25 1/8 / 89 1/8 39 1/8 39 1/8 39 1/8 25 1/2 26 5/8 39 1/8/24 21 1/8 / 30 17 38 3/434 143/8 4 DWR FRIDGE RANGE 391/8 30 1/2-BUILT IN MICRO 17 82 SINK C/L SPECS REQUIRED 37 5/8 23 1/8 FRIDGE 24 1/8-25 1/4 D/W 34 1/8 22 1/2 / PANTRY FLAT PANEL -86 1/2 SINK C/L *NOTE MEASURES ARE BASED ON FINISHED DRYWALL*

DRAWN BY: DIDI

DATE: JUNE 20/2021

REVISION: DECEMBER 22/2021

PAGE: 1 OF 10



8111 Jane St. Unit 10 Concord, Ontario L4K 4L7 Tel. (905) 669-7028 Fax. (905) 669-7903 email: designstudio@villakitchens.ca www.villakitchens.ca

CLIENT: ROYAL PINE HOMES

PROJECT: CENTERFIELD

ADDRESS: RP-CE-BLK 56 LOT 11

MODEL: LAWRENCE 2007

KITCHEN

NOTE: THIS SITE GETS STD-CROWN






DRAWN BY: DIDI

DATE: JUNE 20/2021

REVISION; DECEMBER 22/2021

PAGE: 3 OF 10

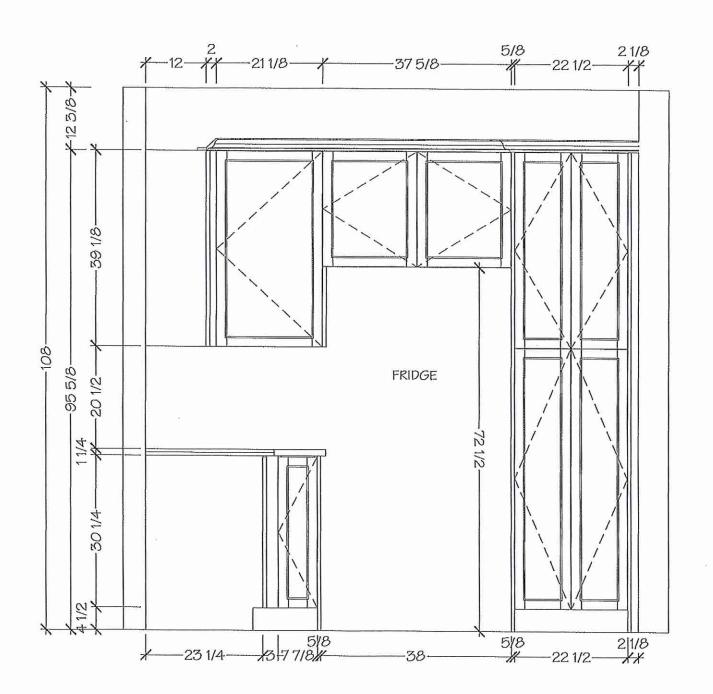

KITCHENS & FINE CABINETRY LTD

8111 Jane St. Unit 10 Concord, Ontario L4K 4L7 Tel. (905) 669-7028 Fax. (905) 669-7903 email: designstudio@villakitchens.ca www.villakitchens.ca

CLIENT: ROYAL PINE HOMES PROJECT: CENTERFIELD

ADDRESS: RP-CE-BLK 56 LOT 11


MODEL: LAWRENCE 2007

KITCHEN

NOTE: THIS SITE GETS STD-CROWN

SM

BM

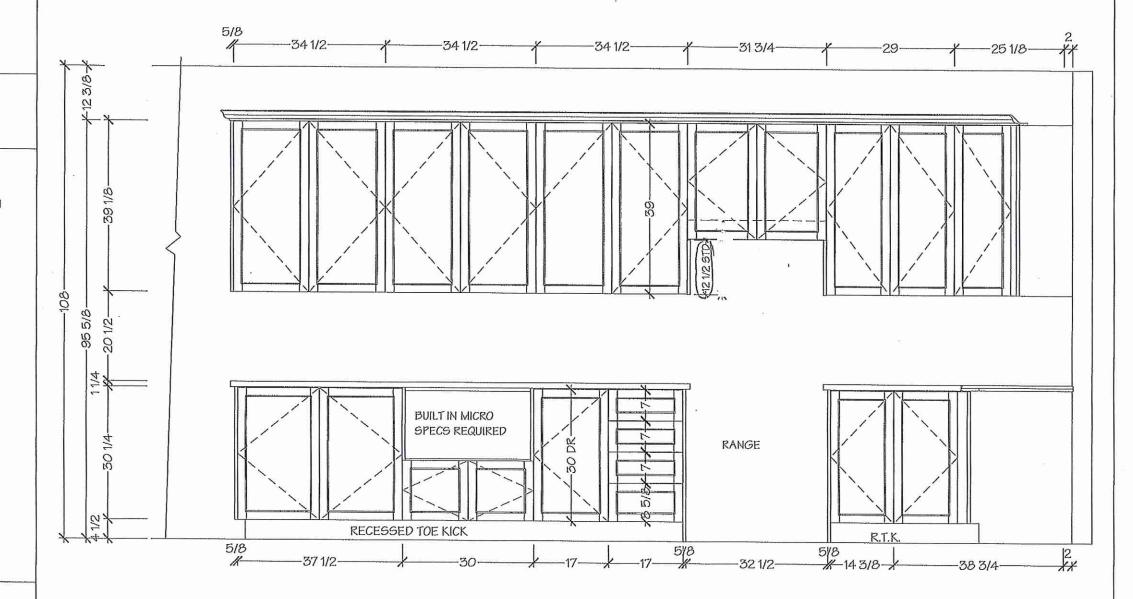

DRAWN BY: DIDI

DATE: JUNE 20/2021

REVISION: DECEMBER 22/2021

PAGE: 2 OF 10

- DocuSign Envelope ID: 97BC3FD7-6D98-4669-83EF-74A5456B6078



8111 Jane St. Unit 10 Concord, Ontario L4K 4L7 Tel. (905) 669-7028 Fax. (905) 669-7903 email: designstudio@villaklichens.ca www.villakitchens.ca

CLIENT: ROYAL PINE HOMES

PROJECT: CENTERFIELD

ADDRESS: RP-CE-BLK 56 LOT 11

MODEL: LAWRENCE 2007

KITCHEN

NOTE: THIS SITE GETS STD-CROWN







DRAWN BY: DIDI

DATE: JUNE 20/2021

REVISION: DECEMBER 22/2021

PAGE: 4 OF 10

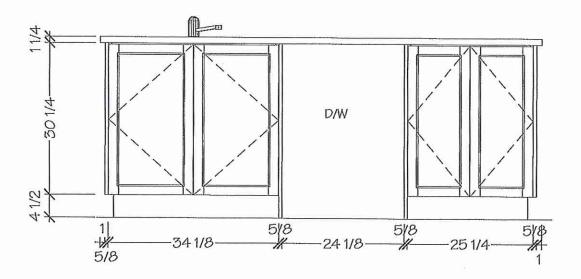

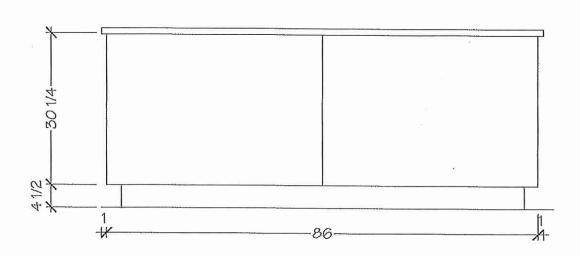



8111 Jane St. Unit 10 Concord, Ontario L4K 4L7 Tel. (905) 669-7028 Fax. (905) 669-7903 email: designstudio@villakitchens.ca www.villakitchens.ca

CLIENT: ROYAL PINE HOMES PROJECT: CENTERFIELD

ADDRESS: RP-CE-BLK 56 LOT 11

MODEL: LAWRENCE 2007

POWDER ROOM







DRAWN BY: DIDI DATE: JUNE 20/2021

REVISION: DECEMBER 22/2021

PAGE: 5 OF 10

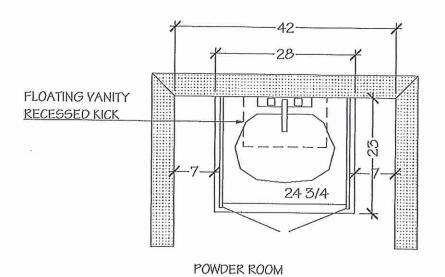

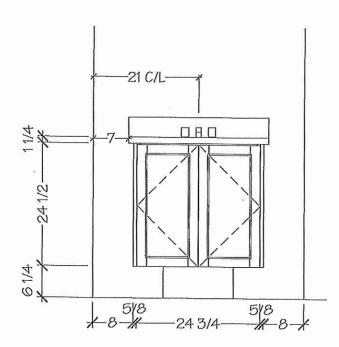



8111 Jane St. Unit 10 Concord, Ontario L4K 4L7 Tel. (905) 669 - 7028 Fax. (905) 669 - 7903 email: designstudio@villakitchens.ca www.villakitchens.ca

CLIENT: ROYAL PINE HOMES

PROJECT: CENTERFIELD

ADDRESS: RP-CE-BLK 56 LOT 11

MODEL: LAWRENCE 2007

MASTER ENSUITE




M BM


DRAWN BY: DIDI DATE: JUNE 20/2021

REVISION: DECEMBER 22/2021

PAGE: 6 OF 10

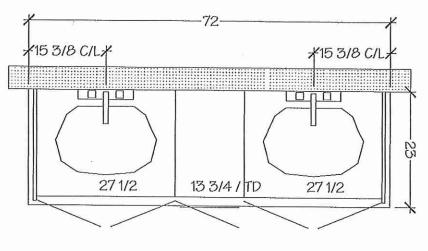

MASTER ENSUITE

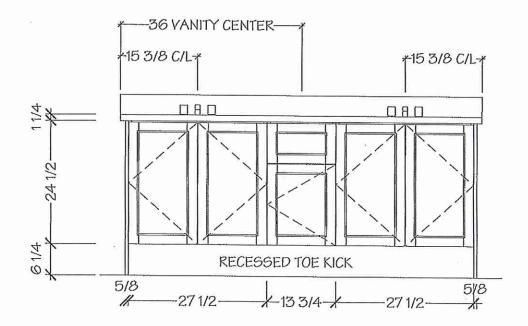

NOTE MEASURES ARE BASED ON FINISHED DRYWALL

DocuSign Envelope ID: 97BC3FD7-6D98-4669-83EF-74A5456B6078



8111 Jane St. Unit 10 Concord, Ontario L4K 4L7 Tel. (905) 669-7028 Fax. (905) 669-7903 email: designstudio@villakitchens.ca www.villakitchens.ca

CLIENT: ROYAL PINE HOMES

PROJECT: CENTERFIELD

ADDRESS: RP-CE-BLK 56 LOT 11

MODEL: LAWRENCE 2007

MAIN BATH







DRAWN BY: DIDI

DATE: JUNE 20/2021

REVISION: DECEMBER 22/2021

PAGE: 7 OF 10

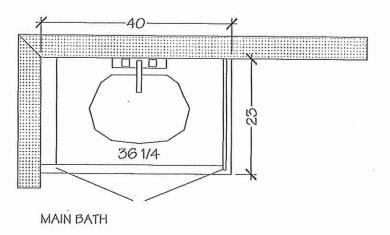

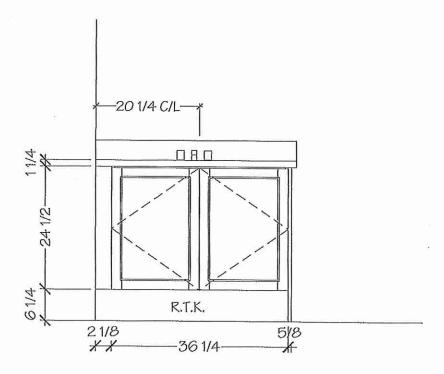

NOTE MEASURES ARE BASED ON FINISHED DRYWALL



8111 Jane St. Unit 10 Concord, Ontario L4K 4L7 Tel. (905) 669- 7028 Fax. (905) 669- 7903 email: designstudio@villakitchens.ca www.villakitchens.ca

CLIENT: ROYAL PINE HOMES
PROJECT: CENTERFIELD
ADDRESS: RP-CE-MASTER
MODEL: LAWRENCE 2007


REC ROOM


LOT 11BLK56

DRAWN BY: DIDI DATE: JUNE 20/2021

REVISION: NOVEMBER 05/2021

PAGE: 12 OF 13

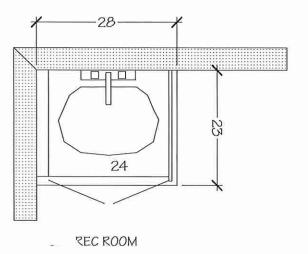

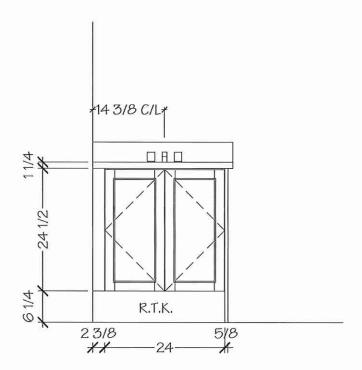

NOTE MEASURES ARE BASED ON FINISHED DRYWALL



*PLEASE NOTE > NO MANTLE *


ALLURAVISION™ SLIM 42" ELECTRIC FIREPLACE




Specifications

Model	DTU	Wi	dth	Hei	ight	De	pth	Viewing Area (U. MA)
Model	BTU	Actual	Framing	Actual	Framing	Actual	Framing	Viewing Area (H x W)
NEFL42CHS-1	5000	44 7/16	42 9/16	17 5/16	16 1/8	4 1/4	4 1/2	11 1/16 x 40 1/14

Dimensions

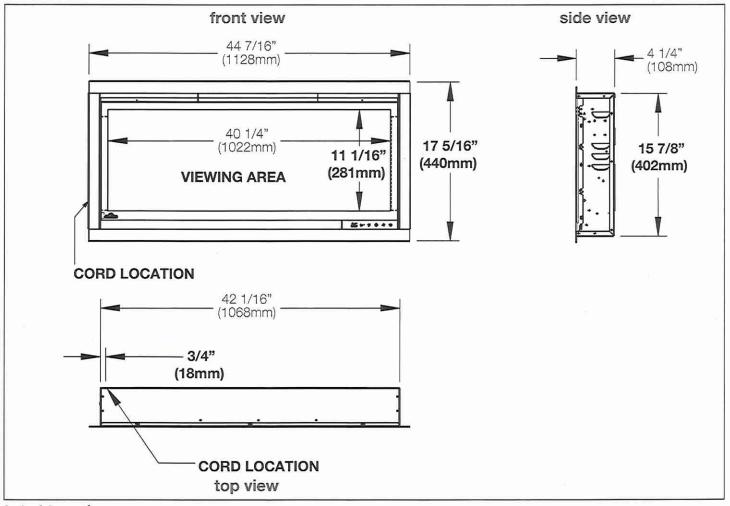

Label Location

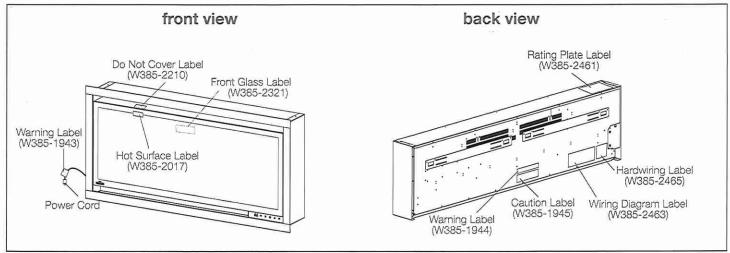

W415-2872 / 03.20.20

Wolf Steel Ltd., 24 Napoleon Rd., Barrie, ON L4M 0G8 Canada · 1(866)820-8686 · www.napoleon.com




ALLURAVISION™ SLIM 42" ELECTRIC FIREPLACE



Clearances

Minimum Mantel Clearances

When using paint or lacquer to finish the mantel, the paint or lacquer must be heat resistant to prevent discolouration. Mantel 8" (203mm) Wall Floor Side View (Wall Mount) Side View (recessed into a wall)

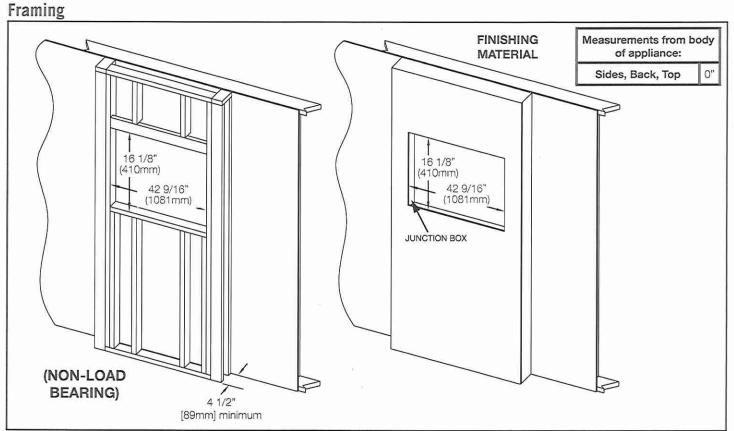

Product information provided is not complete and is subject to change without notice. Please consult the installation manual for the most up to date installation information.

W415-2872 / 03.20.20

Wolf Steel Ltd., 24 Napoleon Rd., Barrie, ON L4M 0G8 Canada · 1(866)820-8686 · www.napoleon.com

LOT 11 BLK


* MASTER ENSUITE *

Align® Traditional | Transitional | Modern

From large, open master baths to minimalist powder rooms, Align faucets and accessories bring a refreshed modern look to your home.





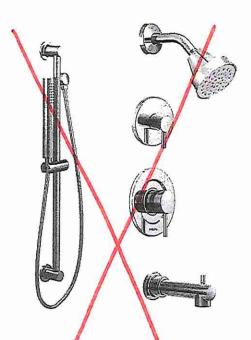

Posi-Temp® Tub/Shower Faucet with 3 Function Transfer Valve/Trim and Slide Bar with Hand Shower * Model T2193EP / U361CIV UT4191 / 62320 / 3887EP / A725

Chrome

- \$1,608,18

Other

- \$2,540.88






Posi-Temp® Shower Only with 3 Function Transfer Valve/Trim and Slide Bar with Hand Shower * Model T2192EP / U361CI / UT4191 / 62320 / 3887EP / A725

Chrome

- \$1,306.26

-Other

\$2,120.16

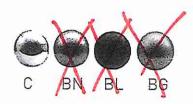

FINISH OPTIONS:

To order, combine the model number with one of these finish letter(s): LifeShine® Brushed Nickel (BN), Matte Black (BL) & Brushed Gold (BG) To order Chrome (C) model, use model number only. Please see the 2020 Shower Design Guide for installation




DIMENSIONS


1 of 10

BUILT-IN MICROWAVES WITH TRIM KITS

PRODUCT DIMENSIONS

MODEL#		KIT MODELS C/KMBT5011K	STANDARD TRIM KIT MODELS VMT55511K / KMBT5511X		
Unit of Measurement	in	em	N N	eyn.	
Overall width of microwave (A)	2713/16	70.7	2713/18	70.7	
Overall height of microwave (B)	105/16	26.2	105/16	26.2	
Height of the door (C)	105/16	26.2	105/16	26.2	
Depth without door (D)	16³/s	41.6	16³/ ₈	41.6	
Depth with door (E)	18	45.7	18	45.7	
Depth with door open 90° (F)	421/8	107	42 ¹ /ε	107	
Distance from fixed wall to door open 90° (G)	1/2	1.3	1/2	1.3	

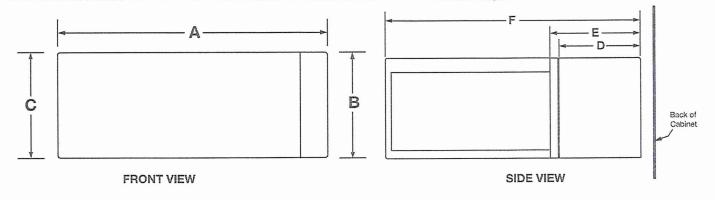

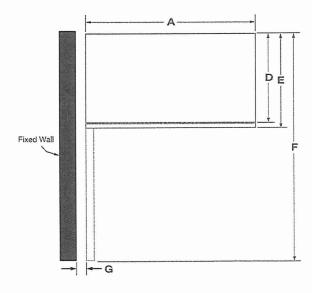

IMPORTANT: Dimensional specifications are provided for planning purposes only.

Do not make any cutouts based on this information. Refer to the Installation Guide before selecting cabinetry, verifying electrical/gas connections, making cutouts or beginning installation. All Whirlpool® appliances are appropriately UL, CUL or CSA approved.

TOP VIEW

W11436613A







DIMENSIONS

2 of 10

TRIM KIT FRAME DIMENSIONS

MODEL#		KIT MODELS / KMBT5011K	STANDARD TRIM KIT MODELS WMT55511K / KMBT55,1K		
Unit of Measurement	in in	em em	in	m	
Overall width of trim kit frame (H)	293/4	75.6	293/4	75.6	
Overall height of trim kit frame (J)	14	35.6	191/8	48.6	
Trim kit frame inner opening height (K)	109/16	26.9	109/16	26.9	
Width of trim kit inner opening (L)	28	71.1	28	71.1	
Depth of trim kit frame (M)	25/16	5.8	25/16	5.8	
Trim kit frame thickness (visible) (N)	7/8	2.2	7/8	2.2	

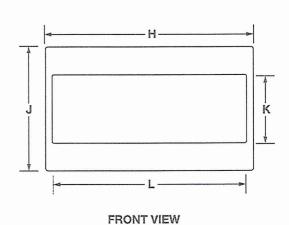

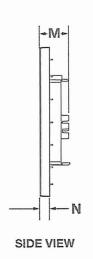

IMPORTANT: Dimensional specifications are provided for planning purposes only.

Do not make any cutouts based on this information. Refer to the Installation Guide before selecting cabinetry, verifying electrical/gas connections, making cutouts or beginning installation. All Whirlpool® appliances are appropriately UL, CUL or CSA approved.

__DS SM — DS BM


LOT 11 BLK54


DIMENSIONS


3 of 10

DIMENSION AS INSTALLED

MODEL#	SLIM TRIM KIT MODELS WMT50011K / KMBT5011K		STANDARD TRIM KIT MODELS WMT55511K / KMBT5511K	
Opening/Clearance Measurement	in .	GIII	\ in	en/
Height of the door (A)	10 ⁵ / ₁₆	26.2	105/16	26.2
Overall heigth of trim kit frame (B)	14	35.6	19¹/a	48.6
Overall heigth of microwave (C)	10 ⁵ / ₁₆	26.2	10 ⁵ / ₁₆	26.2
Overall height with rail (D)	11 ³ / ₁₆	28.3	11 ³ / ₁₆	28.3
Depth with door (E)	18	45.7	18	45.7
Depth with door open 90° (F)	42¹/ ₈	93.7	421/8	93.7
Trim kit frame overhang-upper frame (G)	1	2.6	1 🕺	2.6
Trim kit frame overhang-lower frame (H)	1	2.6	1 / \	2.6
Overall width of trim kit frame (J)	293/4	75.6	293/4	75.6
Overall height of microwave (K)	105/16	26.2	10 ⁵ /16	26.2
Overall height of trim kit frame (L)	14	35.6	1,91/8	48.6
Trim kit frame overhang-left frame (M)	5/8	1.6	5/8	1.6
Trim kit frame overhang-right frame (N)	5/8	1.6	5/8	1.6
Distance from fixed wall to door open 90° (P)	1/2	1.3	1/2	1.3

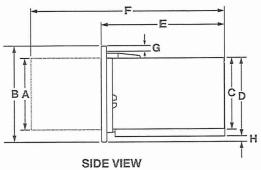

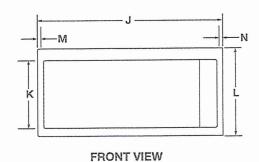

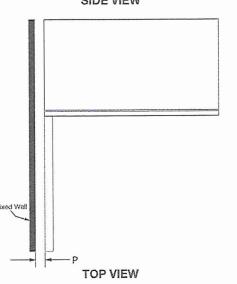

IMPORTANT: Dimensional specifications are provided for planning purposes only.

Do not make any cutouts based on this information. Refer to the Installation Guide before selecting cabinetry, verifying electrical/gas connections, making cutouts or beginning installation. All Whirlpool® appliances are appropriately UL, CUL or CSA approved.




LOT 11 BLK 5.6.


DIMENSIONS

4 of 10

MICROWAVE INTERIOR CAVITY DIMENSIONS

MODEL#	SLIM TRIM KI WMT50011K /		STANDARD TRIM KIT MODELS WMT55511K / KMBT5611K	
Unit of Measurement	in	cm -	il	CHT
Cavity Height (J)	7	17.7	7	17.7
Cavity Height from the Highest Point of the Turntable (K)	6 ⁷ /s	17.5	6 ⁷ /8	17.5
Cavity Width (L)	18 ⁷ /8	48	18 ⁷ / ₈	48
Cavity Depth (M)	14	35.6	14	35.6
Turntable Diameter (N)	12	30.5	12	30.5

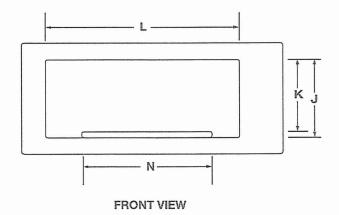

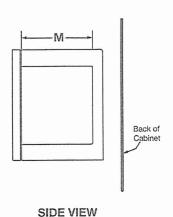

IMPORTANT: Dimensional specifications are provided for planning purposes only.

Do not make any cutouts based on this information. Refer to the Installation Guide before selecting cabinetry, verifying electrical/gas connections, making cutouts or beginning installation. All Whirlpool® appliances are appropriately UL, CUL or CSA approved.




LOTII BLK56

DIMENSIONS

5 of 10

OPENING/CLEARANCE DIMENSIONS

MODEL#	SLIM TRIM KIT MODELS WMT50011K / KMBT5011K		STANDARD TRIM KIT MODELS WMT55511K / KMBT5511K			
Unit of Measurement	in	em	in	Sitt		
Width of cabinet opening (min.)* (A)	30	76.2	30	76.2		
Width of cutout (B)	28 ¹ / ₂	72.4	281/2	72.4		
Height of cutout (C)	12	30.5	17 ¹ /s	43.5		
Top of cutout to bottom of upper cabinet door (min.) (D)	2	5.1	2	5.1		
Bottom of cutout to top of lower cabinet door (min.) (E)	1 ⁹ /16	4	1º/16	4		
Depth of cutout (min.) (F)	21 ³ / ₄	55.2	21 ³ / ₄	55.2		
Bottom of cutout to floor (min.) (G)	36	91.4	36	91.4		
Back of the microwave oven to the surface of junction box (H)	4" (10.2 cm) < H < 40" (102 cm)					
Recommended junction box location (e)	Upper right quadrant					
Can this product be installed flush? Flush refers to the appliance not protruding past the cabinet depth. (Y/N) (J)	N					

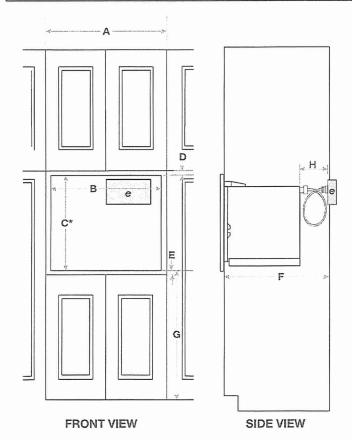


ELECTRICAL REQUIREMENTS

120 V, 60 Hz, AC only, 15 or 20 A fused, electrical supply is required. A time-delay fuse or dedicated circuit is recommended. Use a grounded 3 prong outlet. Do not use an extension cord.

LOCATION REQUIREMENTS

- This is a built-in appliance. Do not use as countertop microwave oven.
- Minimum of 36" from the floor to cut-out floor.
- Complete enclosure around the recessed portion of the microwave oven.
- This microwave oven must be installed into a wood cabinetry. The location must provide:
 - 1. Cutout opening that is plumb and square.
 - 2. Cutout floor that is solid, level and flush with bottom of cabinet cutout.
 - 3. Support for weight of at least 150 lbs (68 kg), which includes microwave oven and items placed inside.

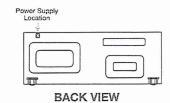

IMPORTANT: Dimensional specifications are provided for planning purposes only.

Do not make any cutouts based on this information. Refer to the Installation Guide before selecting cabinetry, verifying electrical/gas connections, making cutouts or beginning installation. All Whirlpool® appliances are appropriately UL, CUL or CSA approved.