



SITE FILE COPY

STRUCTURAL

CONSTRUCTION SUMMARY

Forestside Estates Inc. Ph. 8

PURCHASER: AMANDEEP KAUR PUREWAL

TEL:

LOT NUMBER	PHASE	HOUSE TYPE	CLOSING DATE
46	8	SILVER MAPLE (40-01C4) - ELEV C - 4 BEDRM	12-Jun-24

Offer	BONUS PACKAGE -PURCHASER TO RECEIVE \$20,000 (INCLUSIVE OF TAXES) WORTH OF UPGRADES AT DECOR CENTRE AT TIME OF COLOUR CHART
Worksheet	Note:



Date Added: 06-Jul-23 Invoice Number: 8502

1 - SIDE DOOR- Install the Optional Side Door, Includes applicable standard Coach Light. (See Sketch) Note:
1 - PURCHASER AWARE AND ACCEPTS THAT ANY CHANGES MADE TO UPGRADES AFTER SIGNING THIS PURCHASERS EXTRA FORM ARE SUBJECT TO A MINIMUM ADMINISTRATION FEE OF \$1,000 Note:
1 - PURCHASER HAS ATTENDED A STRUCTURAL APPOINTMENT AT THE DESIGN STUDIO AND HAS DECLINED ANY ADDITIONAL UPGRADES Note:
1 - BONUS PACKAGE-PURCHASER TO RECEIVE \$20,000 (INCLUSIVE OF TAXES) WORTH OF UPGRADES AT THE DESIGN STUDIO AT TIME OF COLOUR CHART. PURCHASER HAS A REMAINING \$12,316 (INCLUSIVE OF TAXES) TO BE USED AT TIME OF COLOUR CHART. Note:


Date Added: 06-Jul-23 Invoice Number: 8488

1 - BASEMENT - Purchaser has declined the extended 9'-0" Ceiling height. Note:
1 - PURCHASER AWARE AND ACCEPTS THAT ANY CHANGES MADE TO UPGRADES AFTER SIGNING THIS PURCHASERS EXTRA FORM ARE SUBJECT TO A MINIMUM ADMINISTRATION FEE OF \$1,000 Note:


This Document is Extremely Time Sensitive - Printed 5 Sep 23 at 16:27

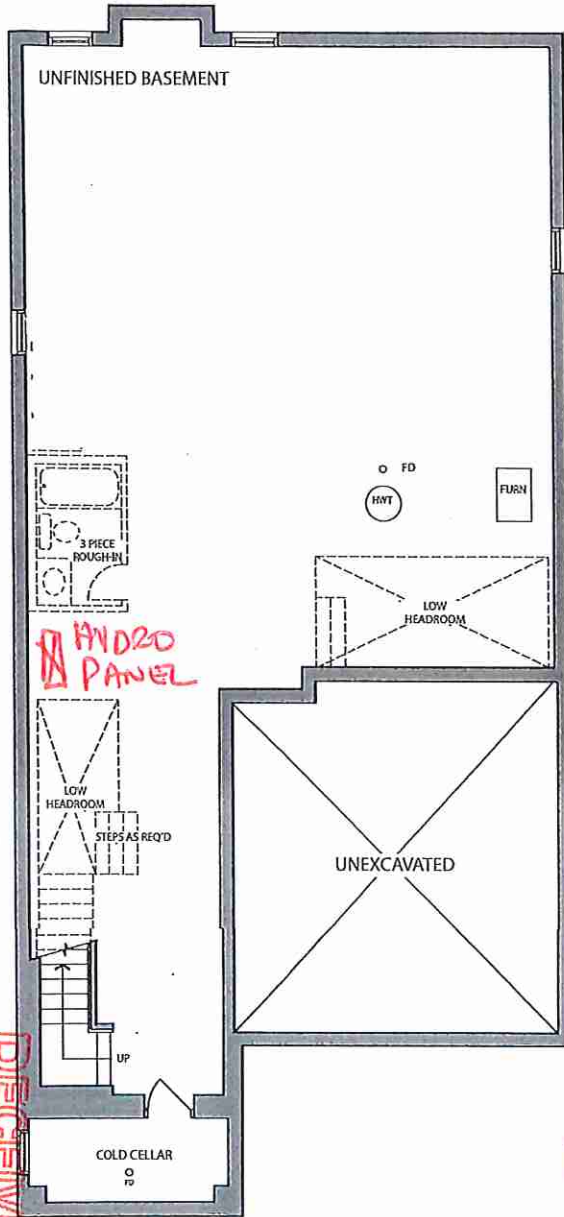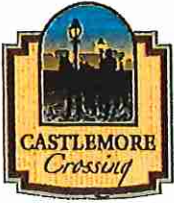

BASEMENT  
ELEV. C

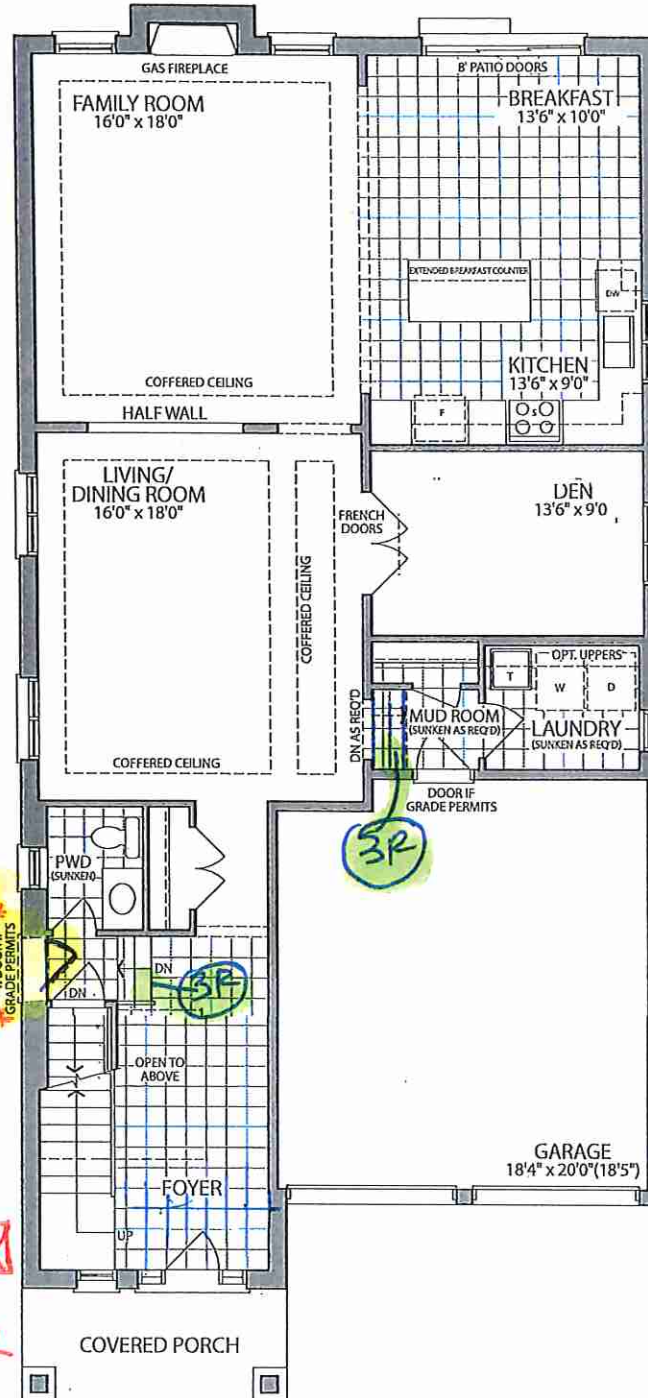

GROUND FLOOR ELEV. C

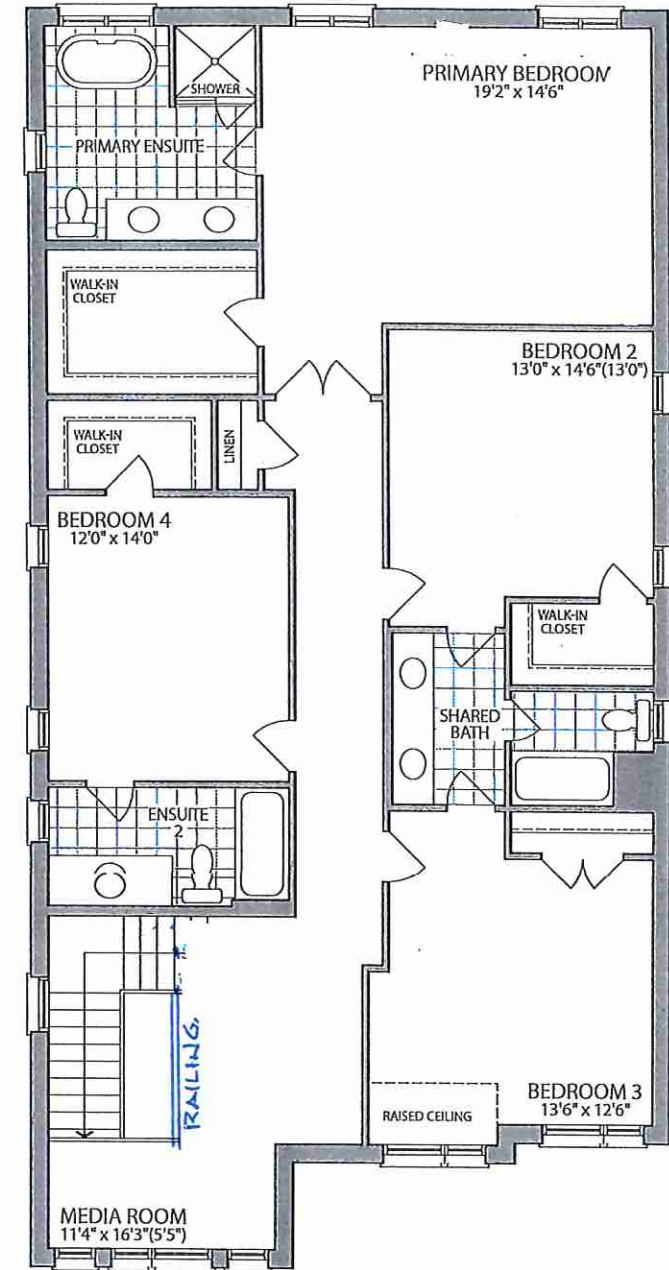

SECOND FLOOR ELEV. C

s, specifications and floor plans are subject to change without notice. All renderings are artist's concept. plans are approximate dimensions. Actual usable floor space may vary from the stated floor area. E.&O.E.

LOT 46 . 40-01 . Silver Maple . El. C. 4 Bedroom . 3340 SQ. FT.