



CONSTRUCTION SUMMARY

Forestside Estates Inc. Ph 8

 $\ensuremath{\textbf{PURCHASERS:}}$ DALBIR SINGH OTAL and DALBIR ,KAUR OTAL

TEL:

LOT NUMBER	PHASE 8	HOUSE TYPE BLUE ELDER (38-03C) - ELEV C	CLOSING DATE 20-Aug-24					
ate Added: 19-Sep-23 Invoice Number: 8515								
1 - BASEMENT- No extended height basement Note:								
1 - BASEMENT- Install ONE (X1) Larger Basement window, 30"x24", in lieu of the builders standard window. (With possible widnow well) (See Sketch) Note:								
1 - MAIN FLOOR- Install Extended height 10'-0" Main Floor ceilings. Includes extended height archways and 8'-0" Standard interior doors (See Sketch) Note:								
1 - FRONT EXTERIOR DOORS- Delete the builders standard single front door and sidelites, and Install Extended height Double Front Doors (See Sketch) Note:								
1 - SIDE EXTERIOR- Install the optional side door with builders standard coach light (If Grade Permites) (See Sketch) Note:								
1 - BASEMENT- AMP- Install 200 Amp Service to the house (See Sketch) Note:								
1 - FRONT EXTERIOR- In addition to the builders standard coach light at the front door, Install an additional Coach Light. to be one the same switch as the standard (See Sketch) Note:								
1 - FRONT EXTERIOR- In addition to the 2 Coach Lights, Install an exterior portico ceiling light. To be on its own switch (See Sketch) Note:								
1 - BACK EXTERIOR- In addition to the builders standard coach light at the back patio sliders, Install an additional Coach Light, to be one the same switch as the standard (See Sketch) Note:								
1 - FRONT EXTERIOR- Install a Festive Soffit Plug on a single Pole (See Sketch) Note:								
1 - KITCHEN- Install an 8" Duct in lieu of the builders standard 6" (See Sketch) Note:								
1 - SHARED BATH 2/3- Delete the buildesr standard Tib/shower and install a shower stall. To include 2x2 mosaic floor, 6" curb with white quartz top, shower pot light and "INCOGNITO" semi frameless sliding doors (See Sketch) Note: **Purchaser will have the option to further upgade the colour of the quartz on the curb at time of colour chart appointment**								
1 - SHARED BATH 1- Delete the buildesr standard Tib/shower and install a shower stall. To include 2x2 mosaic floor, 6" curb with white quartz top, shower pot light and "INCOGNITO" semi frameless sliding doors (See Sketch) Note: **Purchaser will have the option to further upgade the colour of the quartz on the curb at time of colour chart appointment**								
I - MASTER ENSUITE SHOWER STALL- Install a shower niche for the master ensuite shower stall. APPROX. 16"x24" (See Sketch) Note: **PLEASE NOTE** Dummy wall to be accommodated if required for the shower niche**								

Note:

1 - SECOND FLOOR- Install Smooth Ceilings thorughout the 2nd floor, where applicable. (See Sketch)



CONSTRUCTION SUMMARY

Forestside Estates Inc.

PURCHASERS: DALBIR SINGH OTAL and DALBIR, KAUR OTAL

TEL:

LOT NUMBER	PHASE	HOUSE TYPE	CLOSING DATE	
10	8	BLUE ELDER (38-03C) - ELEV C	20-Aug-24	

Date Added: 19-Sep-23

Invoice Number: 8515

1 - BASEMENT- Ina ddition to the laundry room on the first floor, Install an additional Laundry Rough In at teh basement. To include Electrical for washer & dryer and Laundry Tub Rough ONLY
Note:

1,1010.

1 - BACK EXTERIOR- Install the BBQ Gas line Rough In (See Sketch)

Note

1 - KITCHEN- Install a Gas line rough in for stove, inleudes applicable electrical (See Sketch)

Note: **Once appliance specs are received applicable additional electrical may eb required**

PLAESE NOTE standard stove electrical to remain**

1 - KITCHEN- Install a water line rough in for a future fridge (See Sketch)

Note:

1 - PURCHASER HAS ATTENDED A STRUCTURAL APPOINTMENT AT THE DESIGN STUDIO AND HAS DECLINED ANY ADDITIONAL UPGRADES

Note:


1 - PURCHASER AWARE AND ACCEPTS THAT ANY CHANGES MADE TO UPGRADES AFTER SIGNING THIS PURCHASERS EXTRA FORM ARE SUBJECT TO A MINIMUM ADMINISTRATION FEE OF \$1,000

Note:

1 - BONUS PACKAGE-PURCHASER TO RECEIVE \$20,000 (INCLUSIVE OF TAXES) WORTH OF UPGRADES AT THE DESIGN STUDIO AT TIME OF COLOUR CHART

Note:

This Document is Extremely Time Sensitive - Printed 20 Sep 23 at 11:02

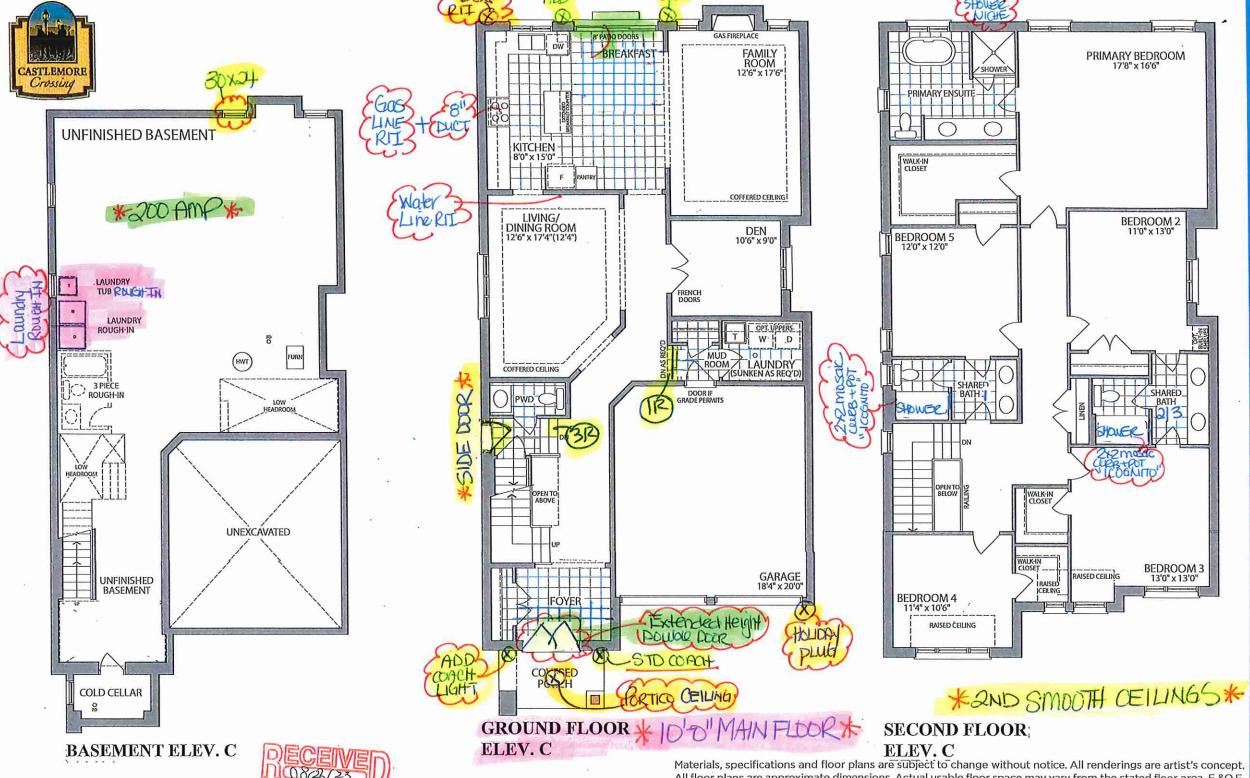

All floor plans are approximate dimensions. Actual usable floor space may vary from the stated floor area. E.&O.E.

LOTIO . Master Ensuite

