



SITE FILE COPY

STRUCTURAL

CONSTRUCTION SUMMARY

Forestside Estates Inc.

PURCHASERS: MUKHTAR SINGH RANDHAWA and JASPREET KAUR RANDHAWA

TEL:


LOT NUMBER	PHASE	HOUSE TYPE	CLOSING DATE
40	8	BLUE ELM (38-04B5) - ELEV B - 5 BEDRM	26-Jun-24

Offer	BONUS PACKAGE -PURCHASER TO RECEIVE \$20,000 (INCLUSIVE OF TAXES) WORTH OF UPGRADES AT DECOR CENTRE AT TIME OF COLOUR CHART
Worksheet	Note:


Date Added: 04-Oct-23      Invoice Number: 8557

1 - BASEMENT- Purchaser declined the extended height basement ceiling Note:
1 - SIDE EXTERIOR- Install the Optional side door, to include builders standrad applicable coach light. (See Sketch) Note:
1 - PURCHASER HAS ATTENDED A STRUCTURAL APPOINTMENT AT THE DESIGN STUDIO AND HAS DECLINED ANY ADDITIONAL UPGRADES Note:
1 - PURCHASER AWARE AND ACCEPTS THAT ANY CHANGES MADE TO UPGRADES AFTER SIGNING THIS PURCHASERS EXTRA FORM ARE SUBJECT TO A MINIMUM ADMINISTRATION FEE OF \$1,000 Note:
1 - BONUS PACKAGE-PURCHASER TO RECEIVE \$20,000 (INCLUSIVE OF TAXES) WORTH OF UPGRADES AT THE DESIGN STUDIO AT TIME OF COLOUR CHART Note: PURCHASER HAS A REMAINING BALANCE OF \$12,316.00 (INCLUSIVE OF TAXES) WORTH OF UPGRADES AT THE DESIGN STUDIO AT TIME OF COLOUR CHART


This Document is Extremely Time Sensitive - Printed 5 Oct 23 at 9:55

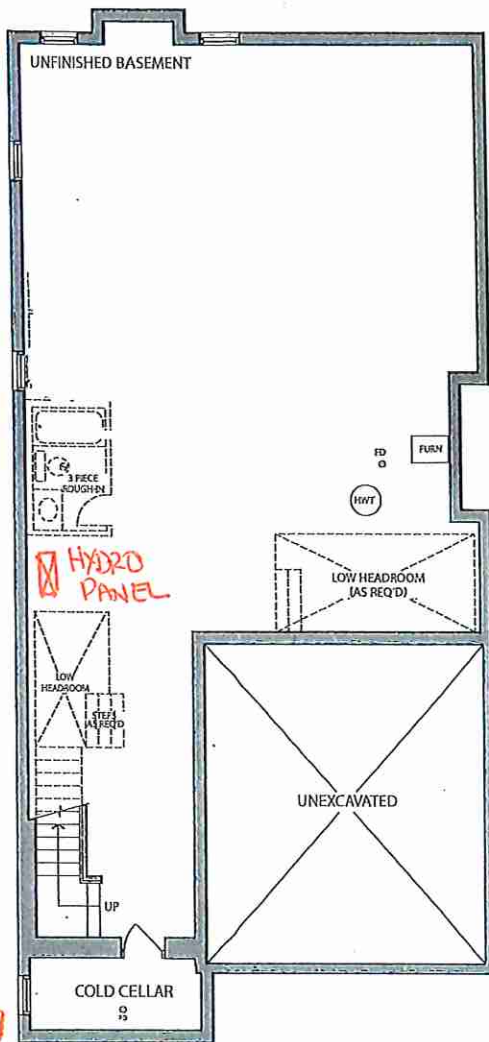

BASEMENT  
ELEV. B

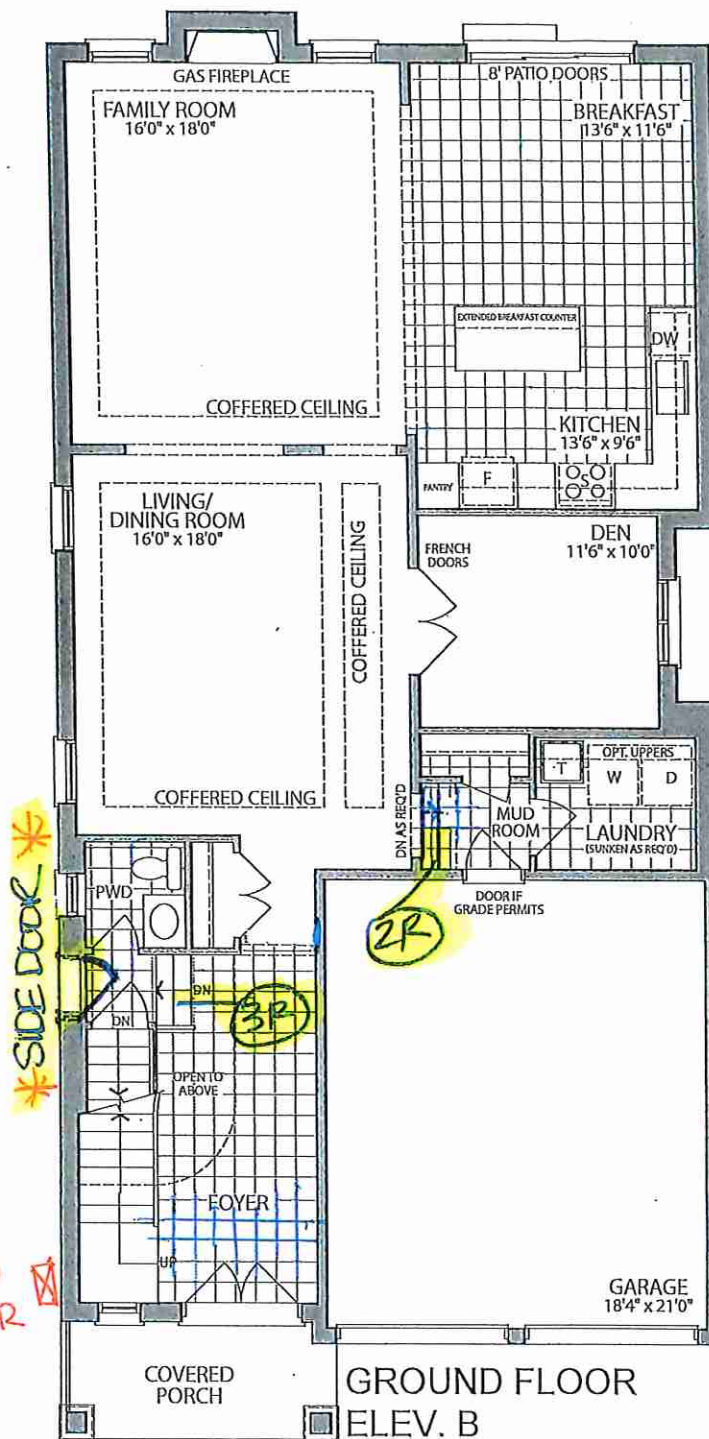

GROUND FLOOR  
ELEV. B

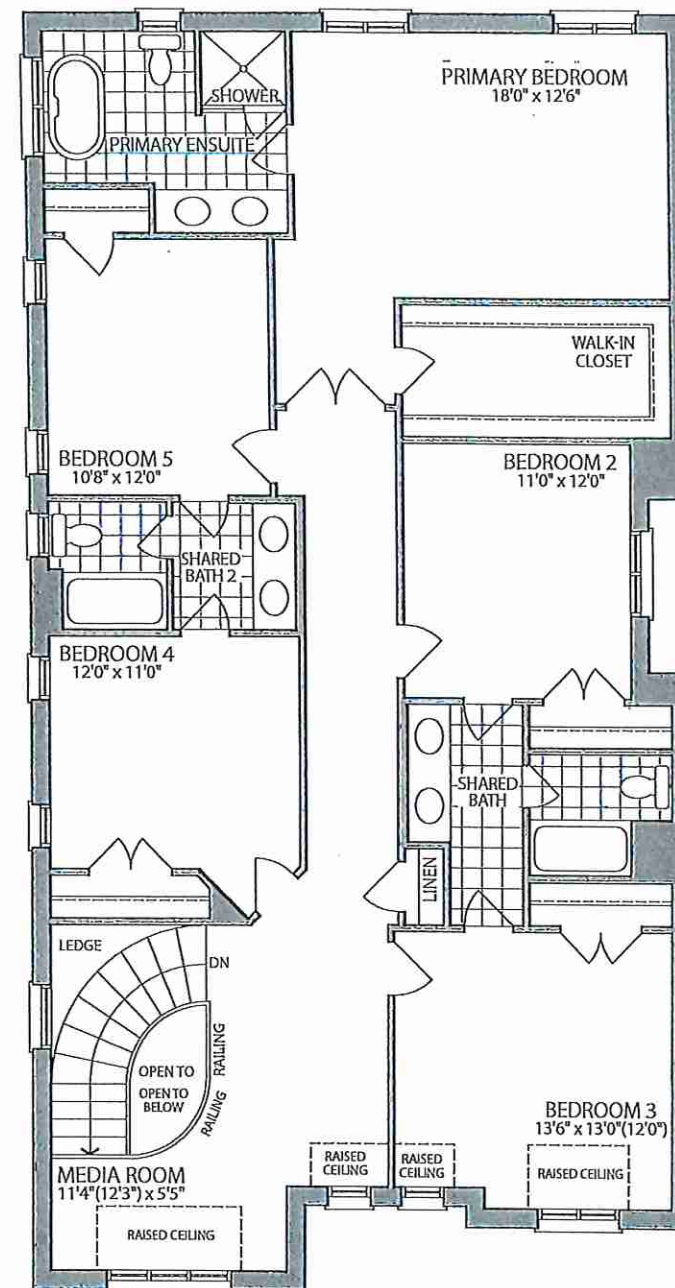

OPT. SECOND FLOOR  
W/5 BEDROOMS ELEV. B

Materials, specifications and floor plans are subject to change without notice. All renderings are artist's concept. All floor plans are approximate dimensions. Actual usable floor space may vary from the stated floor area. E.&O.E.

LOT 40 . 38-04 . The Blue Elm . El. B . 5 Bedroom . 3355 SQ. FT.