



CONSTRUCTION SUMMARY

Forestside Estates Inc.

PURCHASERS: SHAFEEK RAHAMAN and FARAH HAMID

TEL:

LOT NUMBER	PHASE	HOUSE TYPE	CLOSING DATE
23	8	WHITE FIR (45-02A4) - ELEV A - 4 BEDROOM	04-Jun-24

Date Added: 27-Nov-23 Invoice Number: 8604

1 - Install Standard Cable Rough-Ins (x2) and Install Standard Telephone Rough-Ins (x2) (See Sketch) Note:
1 - FAMILY ROOM - Install Standard Conduit Pipe at family room above fireplace mantle. To accommodate future installation of wall mount TV. Conduit installed beside electrical plug (See Sketch) Note:
1 - FAMILY ROOM - Install ONE (1) ADDITIONAL ELECTRICAL PLUG at family room. To be installed above fireplace, to accommodate wall mount TV. Plug to be installed Approx. 60" AFF (See Sketch) Note:
1 - FAMILY ROOM - Install SURROUND SOUND ROUGH-INS (5.1 Surround Sound PreWire {16 Gage}) - To Include; 2 Front Rough-In Speakers, 2 Rear Rough-In Speakers and 1 Sub (Coax) - To be installed at family room (See Sketch) Note:
1 - MAIN FLOOR & SECOND FLOOR - Install UPGRADE BASEBOARD & CASING - 3" COLONIAL BACKBEND CASING WITH 7 1/4" COLONIAL BASBOARD - To be installed throughout main floor and second floor, where applicable (See Sketch) Note:
1 - STAIRCASE - RAILING - Install UPGRADE PACKAGE #3 - To be installed throughout staircase from main floor to second floor, where applicable (See Sketch) Note: To Include; HANDRAIL - Tudor PICKETS - Steel 1/2" Square, Plain/Single Collar - Flat Black POST - 3 1/2" Square, IRP-1 w/ PC1 Cap
1 - KITCHEN - CABINETRY - Install FULL DEPTH FRIDGE ENCLOSURE (Includes Applicable Gables) (See Sketch) Note:
1 - KITCHEN - CABINETRY - Install ONE (x1) BASE BI-FOLD CORNER CABINET WITH SHELF at Kitchen (See Sketch) Note:
1 - KITCHEN - CABINETRY - Install ONE (x1) UPPER BI-FOLD CORNER CABINET WITH SHELF at Kitchen (See Sketch) Note:
1 - KITCHEN - CABINETRY - Install ONE (x1) SET OF POT AND PAN DRAWERS (Set of 3) - To be installed at kitchen island (See Sketch) Note:
16 - KITCHEN - CABINETRY - Install SOFT CLOSE DOOR HINGES - To be installed throughout all kitchen cabinetry doors, where applicable (See Sketch) Note:
7 - KITCHEN - CABINETRY - Install FULL EXT. UNDERMOUNT TRACKS W/SOFT CLOSE - To be installed throughout all kitchen drawers, where applicable (See Sketch) Note:
1 - KITCHEN - COUNTERTOP - Install Builders Standard Stone Countertop - EMMERSTONE GREY GALAXY - To be installed throughout kitchen, where applicable (does not include stone backsplash) (See Sketch) Note:
1 - KITCHEN - COUNTERTOP EDGING - Install UPGRADE " L " EDGE PROFILE - To be installed throughout kitchen countertop, where applicable. (See Sketch) Note:



CONSTRUCTION SUMMARY

Forestsides Estates Inc.

PURCHASERS: SHAPEEK RAHAMAN and FARAH HAMID

TEL:

LOT NUMBER	PHASE	HOUSE TYPE	CLOSING DATE
23	8	WHITE FIR (45-02A4) - ELEV A - 4 BEDROOM	04-Jun-24

Date Added: 27-Nov-23 Invoice Number: 8604

1 - DISCLAIMER - STONE COUNTERTOP: KITCHEN - Due to the many variables that can affect the pattern, colour and/or design and "pitting" of natural products, granite installed will not be identical to the samples displayed. Note: Every effort is made to provide granite countertops as close as possible but the vendor is not responsible for results which differ from the sample displayed. All countertop surfaces may have seams, and product pattern and shade can change in areas containing seams.
1 - DISCLAIMER - STONE COUNTERTOP: KITCHEN - Stone slabs vary in size & all seams are visible & the fabricator reserves the right to position the seams as necessary. Note:
1 - KITCHEN - KITCHEN SINK - Install UPGRADE Undermount Sink - BLANCO QUATRUS R15 U2 UNDERMOUNT SINK - MODEL #401519 (See Sketch) Note:
1 - KITCHEN - KITCHEN FAUCET - Install Builders Standard Faucet - MOEN Method Single Handle Pull-Out (Single Hole) Kitchen Faucet - Model # 7585 - Chrome Note:
1 - KITCHEN - BACKSPLASH - Install Builders Standard - 3x6 ARCTIC WHITE BRIGHT - To be installed throughout kitchen, where applicable. (does not include behind the fridge or stove) - To be installed STRAIGHT/ STACKED (See Sketch) Note:
1 - POWDER ROOM - COUNTERTOP - Install Builders Standard Stone Countertop - EMMERSTONE GREY GALAXY with STANDARD " A " EDGE PROFILE - To be installed throughout powder room vanity, where applicable (Includes Standard Splash) (See Sketch) Note:
1 - PRIMARY ENSUITE - COUNTERTOP - Install Builders Standard Stone Countertop - EMMERSTONE GREY GALAXY with STANDARD " A " EDGE PROFILE - To be installed throughout primary ensuite vanity, where applicable (Includes Standard Splash) (See Sketch) Note:
1 - SHARED BATH 3/4 - COUNTERTOP - Install Builders Standard Stone Countertop - EMMERSTONE GREY GALAXY with STANDARD " A " EDGE PROFILE - To be installed throughout shared bath 3/4 vanity, where applicable (Includes Standard Splash) (See Sketch) Note:
1 - ENSUITE #2 - COUNTERTOP - Install Builders Standard Stone Countertop - EMMERSTONE GREY GALAXY with STANDARD " A " EDGE PROFILE - To be installed throughout ensuite #2 vanity, where applicable (Includes Standard Splash) (See Sketch) Note:
1 - DISCLAIMER - STONE COUNTERTOP ALL BATHROOMS - Due to the many variables that can affect the pattern, colour and/or design and "pitting" of natural products, granite installed will not be identical to the samples displayed. Note: Every effort is made to provide granite countertops as close as possible but the vendor is not responsible for results which differ from the sample displayed. All countertop surfaces may have seams, and product pattern and shade can change in areas containing seams.
1 - POWDER ROOM - VANITY SINK - Install UPGRADE Undermount Sink - CONTRAC CATENA UNDERMOUNT SINK - MODEL #4210CIY WHITE - To be installed at powder room vanity (x1 Sink) (See Sketch) Note: **Includes Cut & Polish** **To be installed with Builders Standard Faucet**
2 - PRIMARY ENSUITE - VANITY SINK - Install UPGRADE Undermount Sink - CONTRAC CATENA UNDERMOUNT SINK - MODEL #4210CIY WHITE - To be installed at primary ensuite vanity (x2 Sinks) (See Sketch) Note: **Includes Cut & Polish** **To be installed with Builders Standard Faucet**
2 - SHARED BATH 3/4 - VANITY SINK - Install UPGRADE Undermount Sink - CONTRAC CATENA UNDERMOUNT SINK - MODEL #4210CIY WHITE - To be installed at shared bath 3/4 vanity (x2 Sinks) (See Sketch) Note: **Includes Cut & Polish** **To be installed with Builders Standard Faucet**



CONSTRUCTION SUMMARY

Forestside Estates Inc.

PURCHASERS: SHAFEEK RAHAMAN and FARAH HAMID

TEL:

LOT NUMBER	PHASE	HOUSE TYPE	CLOSING DATE
23	8	WHITE FIR (45-02A4) - ELEV A - 4 BEDROOM	04-Jun-24

Date Added: 27-Nov-23 Invoice Number: 8604

1 - ENSUITE #2 - VANITY SINK - Install UPGRADE Undermount Sink - CONTRAC CATENA UNDERMOUNT SINK - MODEL #4210CIY WHITE - To be installed at ensuite #2 vanity (x1 Sink) (See Sketch)
Note: **Includes Cut & Polish**

****To be installed with Builders Standard Faucet****

1 - PURCHASER HAS ATTENDED A DECOR APPOINTMENT AT THE DESIGN STUDIO AND HAS DECLINED ANY ADDITIONAL UPGRADES. Purchaser accepts and acknowledges that there will be no further changes/additions/deletions to be made upon signing on NOVEMBER 27, 2023
Note:

1 - PURCHASER AWARE AND ACCEPTS THAT ANY CHANGES MADE TO UPGRADES AFTER SIGNING THIS PURCHASERS EXTRA FORM ARE SUBJECT TO A MINIMUM ADMINISTRATION FEE OF \$1,000
Note:

Date Added: 28-Sep-23 Invoice Number: 8552

1 - MAIN FLOOR - Install EXTENDED HEIGHT 10'-0" CEILINGS (Includes Extended Height Archways and 8 Foot Standard Interior Doors) (See Sketch)
Note:

1 - FRONT EXTERIOR - Install EXTENDED HEIGHT DOUBLE DOORS (Delete Transom Window Above) in lieu of builders standard height double front doors (See Sketch)
Note:

1 - SIDE EXTERIOR - Install OPTIONAL SIDE DOOR ENTRANCE (Includes Applicable Exterior Coach Light) **If Grade Permits** (See Sketch)
Note:

1 - REAR EXTERIOR - BREAKFAST AREA - Install EXTENDED HEIGHT DOUBLE FRENCH DOORS (Plain Glass & NO Screen) to backyard, in lieu of builder standard sliding doors (See Sketch)
Note:

1 - BASEMENT - Install UPGRADE 200 AMP Service in lieu of builders standard 100 amp (See Sketch)
Note:

1 - FRONT EXTERIOR - In addition to builders standard exterior coach light, Install ONE (x1) EXTERIOR PORTICO CEILING LIGHT on Seperate Switch **Includes Basic Light Fixture** (See Sketch)
Note:

1 - GARAGE EXTERIOR - Install ONE (x1) FESTIVE SOFIT PLUG on a Single Pole Switch (See Sketch)

Note: PLEASE NOTE - Location of Switch Determined by Vendor

1 - GARAGE - Relocate Central Vac Trunk Rough-In to Garage in lieu of Basement (See Sketch)
Location Determined By Vendor
Note:

1 - KITCHEN - Install UPGRADE 8 INCH EXHAUST DUCT at kitchen in lieu of builders standard 6 inch exhaust (See Sketch)
Note:

1 - SECOND FLOOR - SMOOTH CEILINGS - Install SMOOTH CEILINGS Throughout Second Floor, where applicable. To Include; Upper Hall, Media Room, Primary Bedroom, Bedroom #2, Bedroom #3 and Bedroom #4 (See Sketch)
Note:

1 - MASTER ENSUITE - SHOWER STALL - Delete full wall between free standing tub & shower stall. Install Additional 6" curb & stonetop. Install FRAMELESS GLASS ENCLOSURE at front in lieu of builders standard framed glass panel & shower door.
Note: Frameless Glass to Continue on side of shower stall, beside free standing tub (See Sketch)



CONSTRUCTION SUMMARY
Forestsides Estates Inc.

PURCHASERS: SHAFEEK RAHAMAN and FARAH HAMID

TEL:

LOT NUMBER	PHASE	HOUSE TYPE	CLOSING DATE
23	8	WHITE FIR (45-02A4) - ELEV A - 4 BEDROOM	04-Jun-24

Date Added: 28-Sep-23 Invoice Number: 8552

1 - SHARED BATH 3/4 - Delete builders standard tub/shower enclosure. Install STANDING SHOWER STALL (To Include: 2x2 mosaic floor, 6" curb with stonetop & shower pot light) Front of shower stall to be LEFT OPEN - NO GLASS (See Sketch)
Note:

1 - MASTER ENSUITE - SHOWER STALL - Install SHOWER NICHE (Includes White Quartz Stone) Approx 10" x 14" at master ensuite shower stall (See Sketch)
Note: **Applicable Dummy Wall to be installed to accommodate shower niche**

1 - SHARED BATH 3/3- SHOWER STALL - Install SHOWER NICHE (Includes White Quartz Stone) Approx 10" x 14" at shared bath 3/4 shower stall (See Sketch)
Note: **Applicable Dummy Wall to be installed to accommodate shower niche**

1 - BONUS PACKAGE - PURCHASER HAS APPLIED \$20,000.00 (Includes Taxes) WORTH OF UPGRADE PROMOTIONAL PACKAGE TOWARDS THE PURCHASE OF STRUCTURAL UPGRADES COMPLETED AT THE DECOR CENTRE
Note:

1 - PURCHASER HAS ATTENDED A STRUCTURAL APPOINTMENT AT THE DESIGN STUDIO & HAS DECLINED ANY ADDITIONAL UPGRADES. Purchaser accepts & acknowledges that there will be no further structural changes/additions/deletions to be made upon signing on SEPTEMBER 26, 2023
Note:

1 - PURCHASER AWARE AND ACCEPTS THAT ANY CHANGES MADE TO UPGRADES AFTER SIGNING THIS PURCHASERS EXTRA FORM ARE SUBJECT TO A MINIMUM ADMINISTRATION FEE OF \$1,000
Note:

Date Added: 17-May-23 Invoice Number: 8468

1 - BASEMENT- Purchaser has declined to upgrade the basement ceilings to 9'-0" and will remain with the builders standard height.
Note:

1 - PURCHASER AWARE AND ACCEPTS THAT ANY CHANGES MADE TO UPGRADES AFTER SIGNING THIS PURCHASERS EXTRA FORM ARE SUBJECT TO A MINIMUM ADMINISTRATION FEE OF \$1,000
Note:

This Document is Extremely Time Sensitive - Printed 18 Dec 23 at 16:23



* INTERIOR COLOUR SCHEME *

Purchasers	SHAFEEK RAHAMAN & FARAH HAMID	Decor Consultant	Melissa Di Marino	Model and Elevation	WHITE FIR (45-02A4) - ELEV A - 4 BEDROOM	Telephone Res. / Bus	/	Project	Forestside Estates Inc.	Closing Date	04/06/2024	Property	23
------------	-------------------------------	------------------	-------------------	---------------------	--	----------------------	---	---------	-------------------------	--------------	------------	----------	----

Flooring		Wall Tile		Main		Accent/Insert		Border / Listello		Pattern		Plumbing	
13x13 KEATON CARBON (STD)		8x10 KEATON CARBON (STD)		8x10 KEATON CARBON (STD)		8x10 KEATON CARBON (STD)		8x10 KEATON CARBON (STD)		8x10 KEATON CARBON (STD)		8x10 KEATON CARBON (STD)	
13x13 NEW REEDS TAUPE (STD)		8x10 NEW REEDS TAUPE (STD)		8x10 NEW REEDS TAUPE (STD)		8x10 NEW REEDS TAUPE (STD)		8x10 NEW REEDS TAUPE (STD)		8x10 NEW REEDS TAUPE (STD)		8x10 NEW REEDS TAUPE (STD)	
13x13 NEW REEDS GREY (STD)		8x10 NEW REEDS GREY (STD)		8x10 NEW REEDS GREY (STD)		8x10 NEW REEDS GREY (STD)		8x10 NEW REEDS GREY (STD)		8x10 NEW REEDS GREY (STD)		8x10 NEW REEDS GREY (STD)	
18x18 LIVORNO GRIS (STD)		N/A		N/A		N/A		N/A		N/A		N/A	
18x18 LIVORNO GRIS (STD)		N/A		N/A		N/A		N/A		N/A		N/A	
18x18 LIVORNO GRIS													



* INTERIOR COLOUR SCHEME *

Purchasers	SHAFEEK RAHAMAN & FARAH HAMID	Decor Consultant	Melissa Di Marino	Model and Elevation	WHITE FIR (45-02A4) - ELEV A - 4 BEDROOM	Telephone Res. / Bus	/	Project	Forestside Estates Inc.	Closing Date	04/06/2024	Property	23
------------	-------------------------------	------------------	-------------------	---------------------	--	----------------------	---	---------	-------------------------	--------------	------------	----------	----

Page 2 of 3		Interior Paint	Description	
Primary Ensuite	STANDARD - SILVER BIRCH			
Shared Bath 3/4	STANDARD - SILVER BIRCH			
Ensuite #2	STANDARD - SILVER BIRCH			
Powder Room	STANDARD - SILVER BIRCH			
Mud Room	STANDARD - SILVER BIRCH			
Laundry Room	STANDARD - SILVER BIRCH			
Kitchen/Breakfast	STANDARD - SILVER BIRCH			
Foyer	STANDARD - SILVER BIRCH			
Main Hall	STANDARD - SILVER BIRCH			
Family Room	STANDARD - SILVER BIRCH			
Living Room	STANDARD - SILVER BIRCH			
Dining Room	STANDARD - SILVER BIRCH			
Upper Hall	STANDARD - SILVER BIRCH			
Media Room	STANDARD - SILVER BIRCH			
Primary Bedroom	STANDARD - SILVER BIRCH			
Bedroom 2	STANDARD - SILVER BIRCH			
Bedroom 3	STANDARD - SILVER BIRCH			
Bedroom 4	STANDARD - SILVER BIRCH			

Cabinet

Style	Countertop	Counter Edge	Handle / Knob
EURO MELAMINE - WILLOW VELVET SF256 VELVET FINISH (STD)	Emmerstone Grey Galaxy (STD)	A " EDGE (STD)	9357-37 BSN
EURO MELAMINE - WILLOW VELVET SF256 VELVET FINISH (STD)	Emmerstone Grey Galaxy (STD)	A " EDGE (STD)	9357-37 BSN
EURO MELAMINE - WILLOW VELVET SF256 VELVET FINISH (STD)	Emmerstone Grey Galaxy (STD)	A " EDGE (STD)	9357-37 BSN
EURO MELAMINE - FOG GREY SF213 VELVET FINISH (STD)	Emmerstone Grey Galaxy (STD)	A " EDGE (STD)	9357-37 BSN
N/A	N/A	N/A	N/A
EURO MELAMINE - WHITE W100 (STD)	949-58 WHITE (STD)	STANDARD	9531-BSN
EURO MELAMINE - FOG GREY SF213 VELVET FINISH (STD)	Emmerstone Grey Galaxy (STD)	L " EDGE (UPG)	9303-96BSN

Notes

**KITCHEN - INSTALL BUILDERS STANDARD STAINLESS STEEL EXHAUST FAN
**KITCHEN - INSTALL UPGRADE UNDERMOUNT SINK - BLANCO QUATRUS R15 U2
MODEL #401519 **KITCHEN - INSTALL STANDARD FAUCET - MOEN Method Single
Handle Pull-Out (Single Hole) Kitchen Faucet - Model # 7585 - Chrome

Appliance Opening/Dimension	
Fridge Size	SEE VILLA LAYOUT
Built-ins	None
Hood Fan	SEE VILLA LAYOUT
Dishwasher Cabinet	SEE VILLA LAYOUT
Range	SEE VILLA LAYOUT
Microwave	None
Exhaust Opening	6" ☐ 8" ☒

Fireplace	FAMILY ROOM
Location Flooring	3 1/4" HARDWOOD
Style	VILLA NOVA
Finish	STONE
Marble	N/A
Hearth	NONE




Cable - (x2)
Telephone - (x2)
Electrical - (x1)
Conduit (x1)


6 VAC RIN
GARAGE

6 Surround Sound
R-IN


HA SR

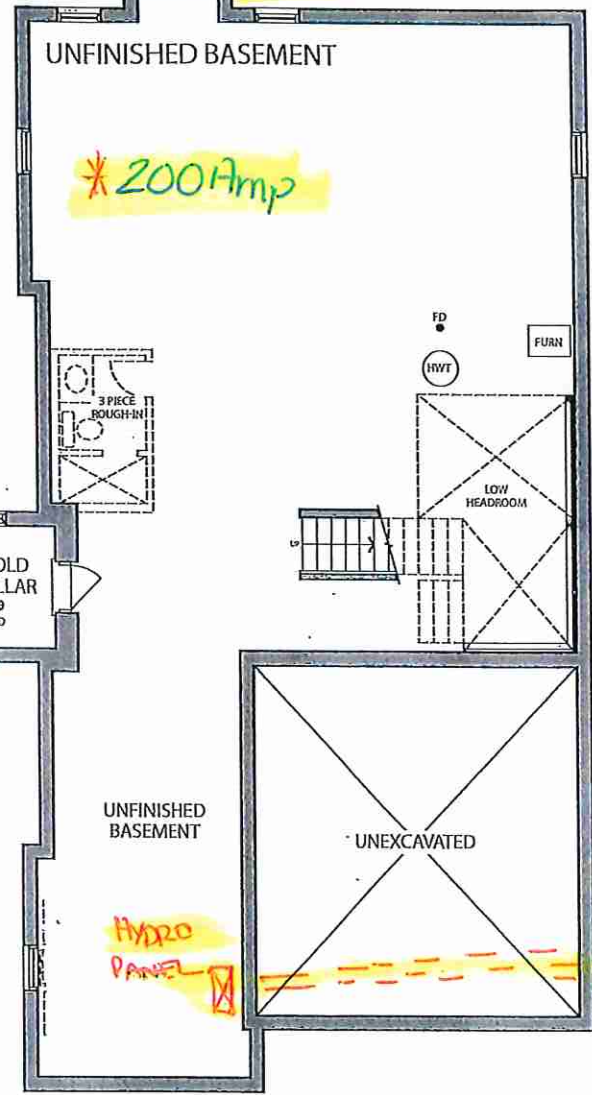

BASEMENT
ELEV. A
Sept. 26, 2023
HA SR

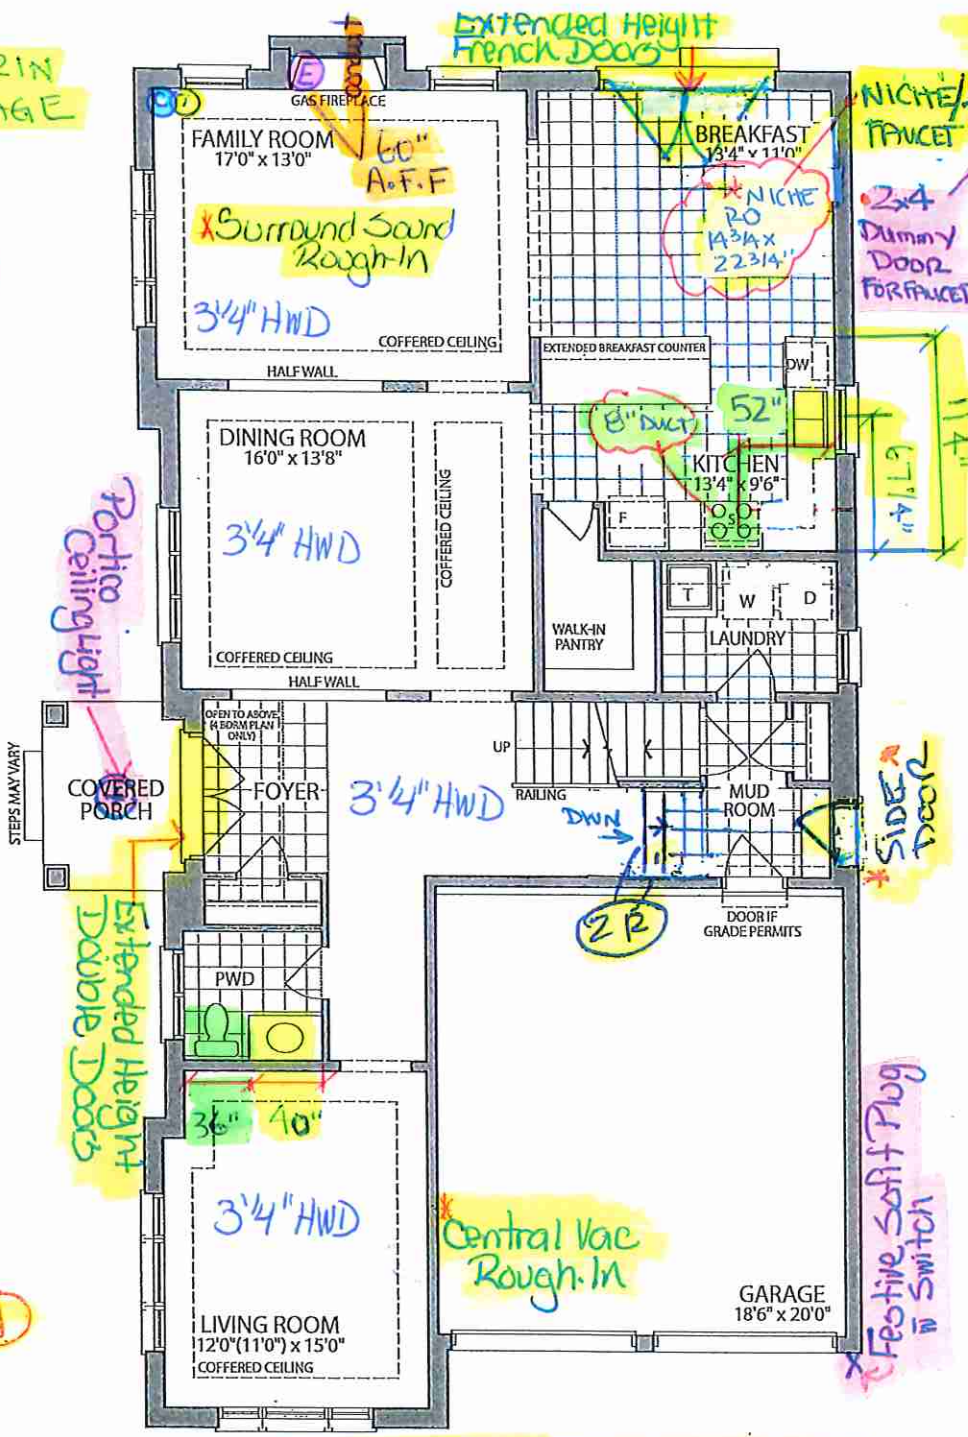

GROUND FLOOR
ELEV. A * 10'-0" Ceilings *

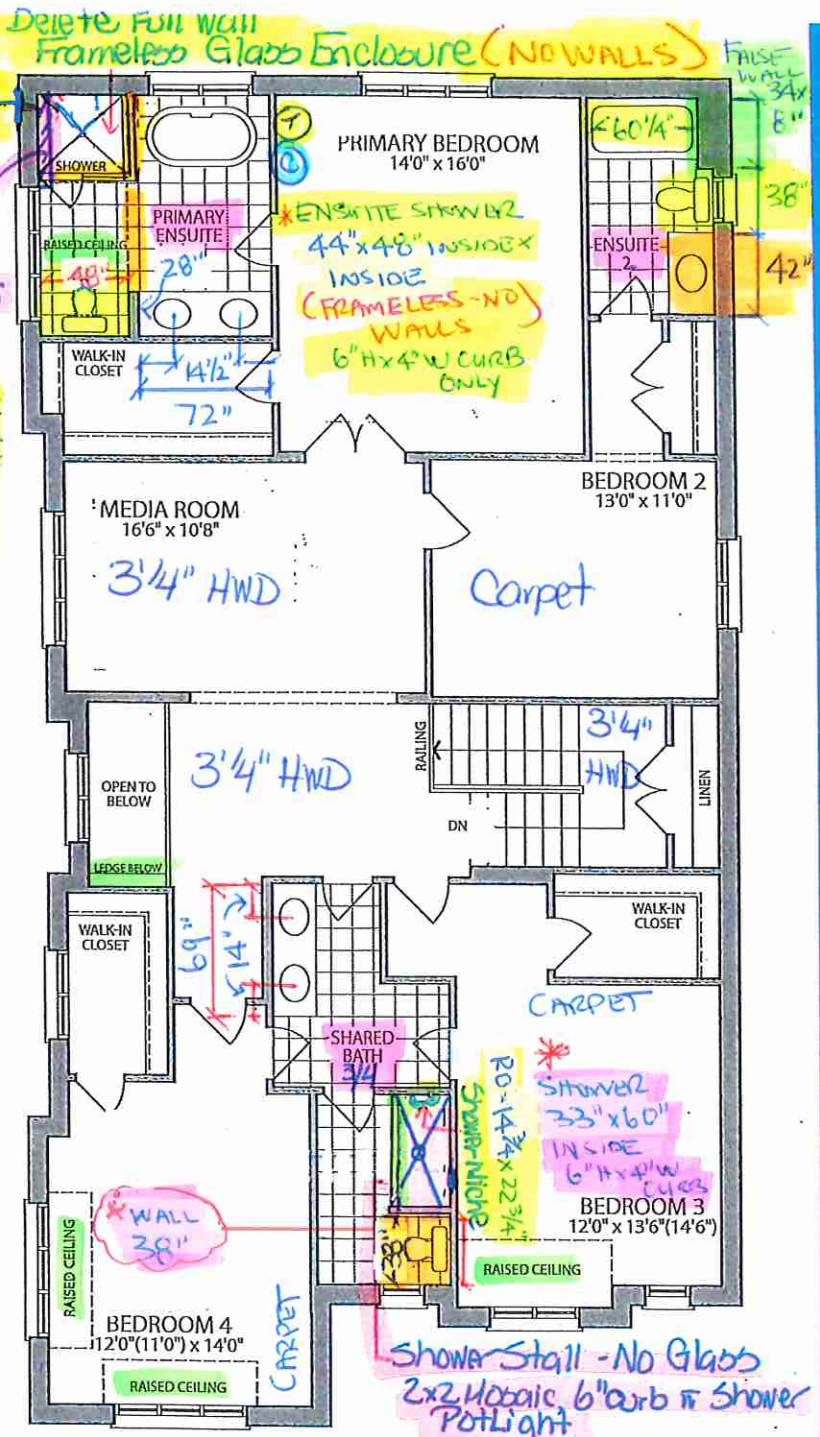

SECOND FLOOR
ELEV. A * Smooth Ceilings Throughout

Materials, specifications and floor plans are subject to change without notice. All renderings are artist's concept. All floor plans are approximate dimensions. Actual usable floor space may vary from the stated floor area. E.&O.E.

LOT 23. 45-02 . The White Fir . EL.A . 4 BEDROOMS . 3350 SQ.FT.

Villa

KITCHENS & FINE CABINETRY LTD

8111 Jane St. Unit 10
Concord, Ontario L4K 4L7
Tel. (905) 669- 7028
Fax. (905) 669 - 7903
email: designstudio@villakitchens.ca
www.villakitchens.ca

CLIENT: ROYAL PINE

PROJECT: FORESTSIDE PH8

ADDRESS: RP-FS(8)-LOT 23

MODEL: 45-02-CORNER-ELEV A B C

KITCHEN

DOOR STYLE: EURO

DOOR PROFILE: N/A

DOOR MATERIAL: MELAMINE

DOOR FINISH: FOG GREY SF213

INTERIOR: WHITE

INT HARDWARE: SOFT CLOSE
DOORS

SOFT CLOSE

DRAWERS

CROWN MOLD: EURO

LIGHT VALANCE: N/A

INSTALL HEIGHT: 95 5/8"H

HW:

COUNTERTOP


DRAWN BY: ELISA

DATE: JULY 06, 2023

REVISION: NOVEMBER 30, 2023

SCALE:

PAGE: 1 OF 4

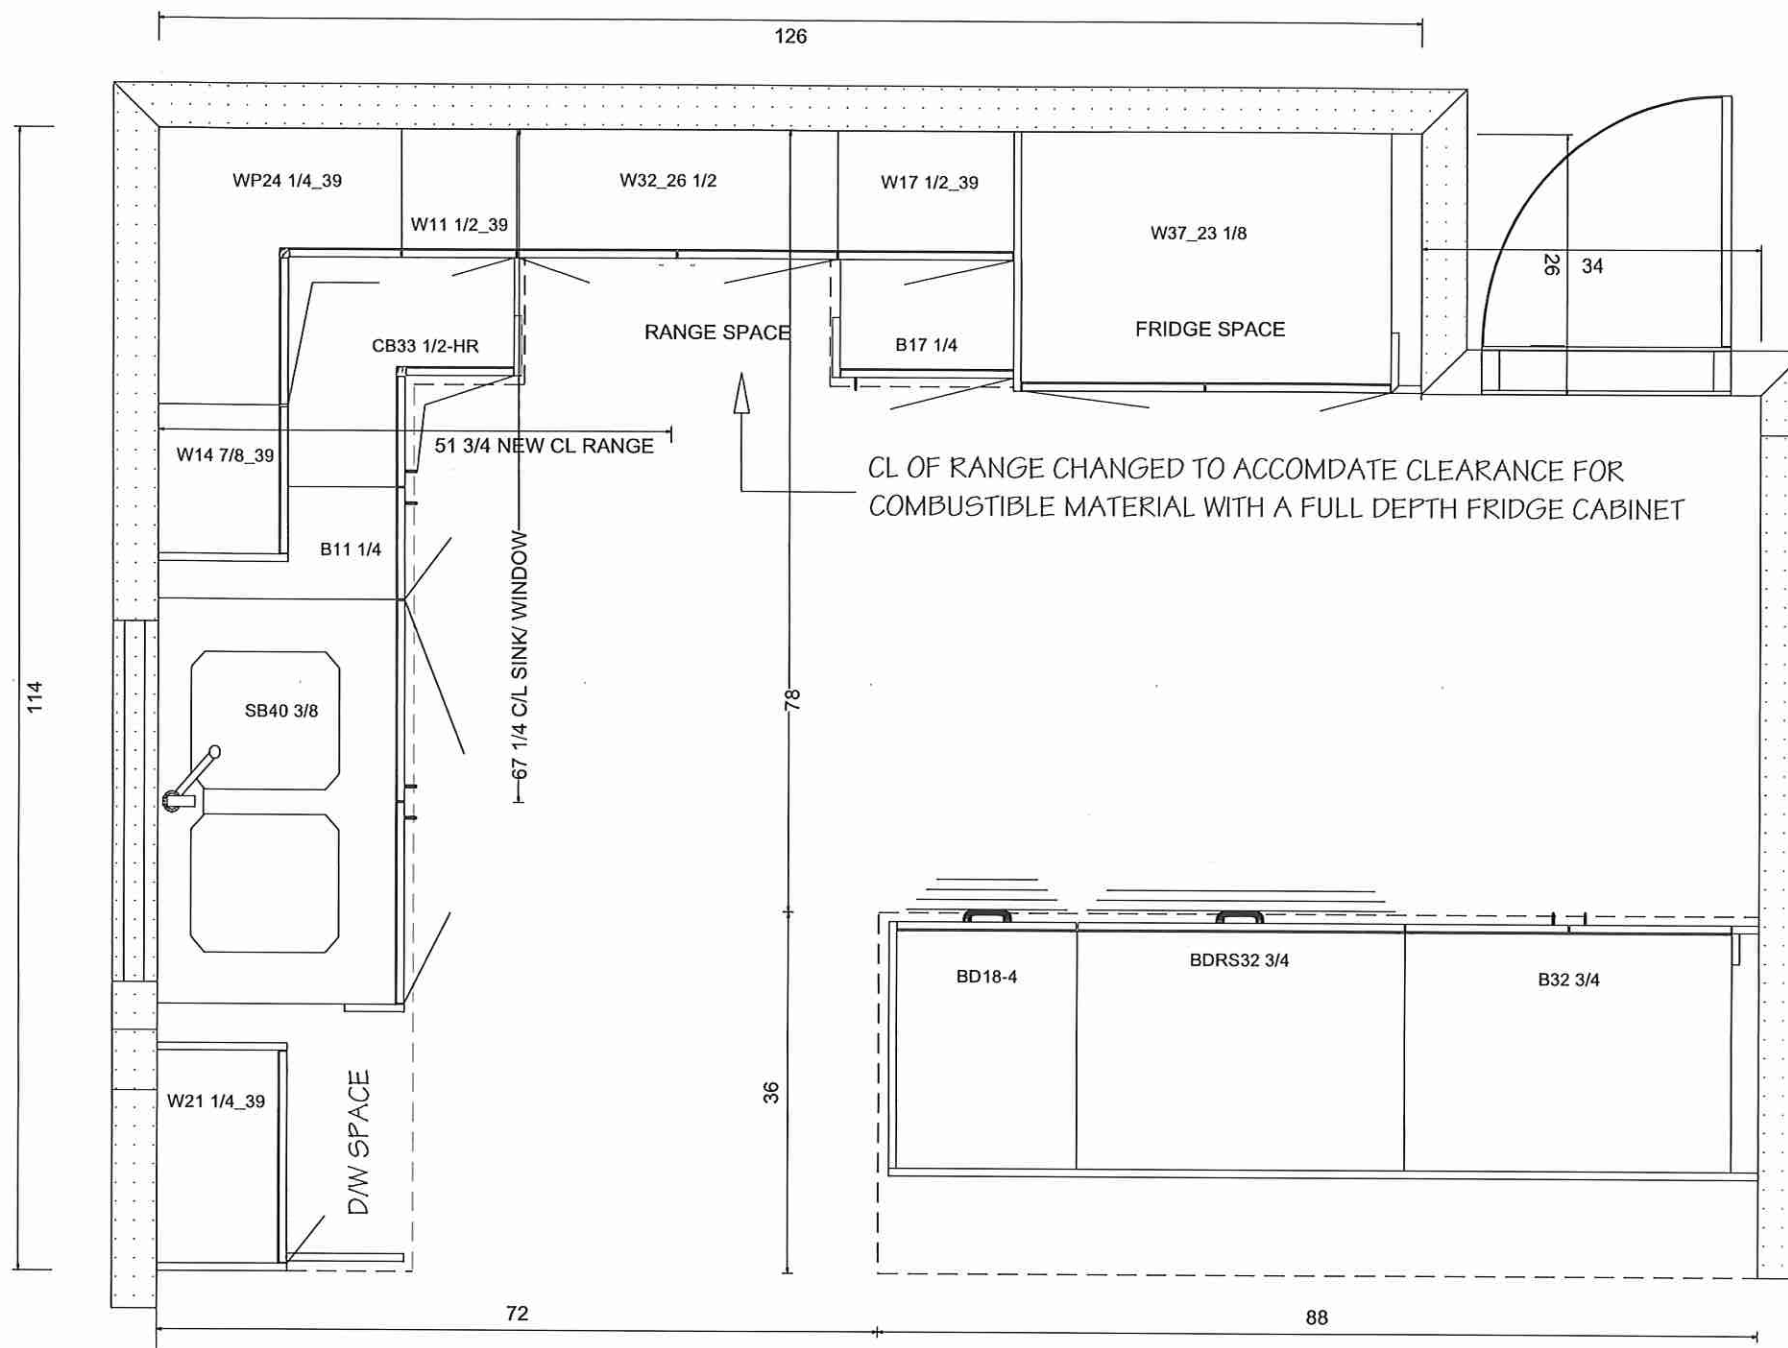

Lot 23 Forestside (Ph8)

Villa

KITCHENS & FINE CABINETRY LTD

8111 Jane St. Unit 10
Concord, Ontario L4K 4L7
Tel. (905) 669-7028
Fax. (905) 669-7903
email: designstudio@villakitchens.ca
www.villakitchens.ca

CLIENT: ROYAL PINE

PROJECT: FORESTSIDE PH8

ADDRESS: RP-FS(8)-LOT 23

MODEL: 45-02-CORNER-ELEV A B C

SINK WALL

DOOR STYLE: EURO

DOOR PROFILE: N/A

DOOR MATERIAL: MELAMINE

DOOR FINISH: FOG GREY SF213

INTERIOR: WHITE

INT HARDWARE: SOFT CLOSE
DOORS

SOFT CLOSE

DRAWERS

CROWN MOLD: EURO

LIGHT VALANCE: N/A

INSTALL HEIGHT: 95 5/8"H

HW:

COUNTERTOP


DRAWN BY: ELISA

DATE: JULY 06, 2023

REVISION: NOVEMBER 8, 2023

SCALE:

PAGE: 2 OF 4

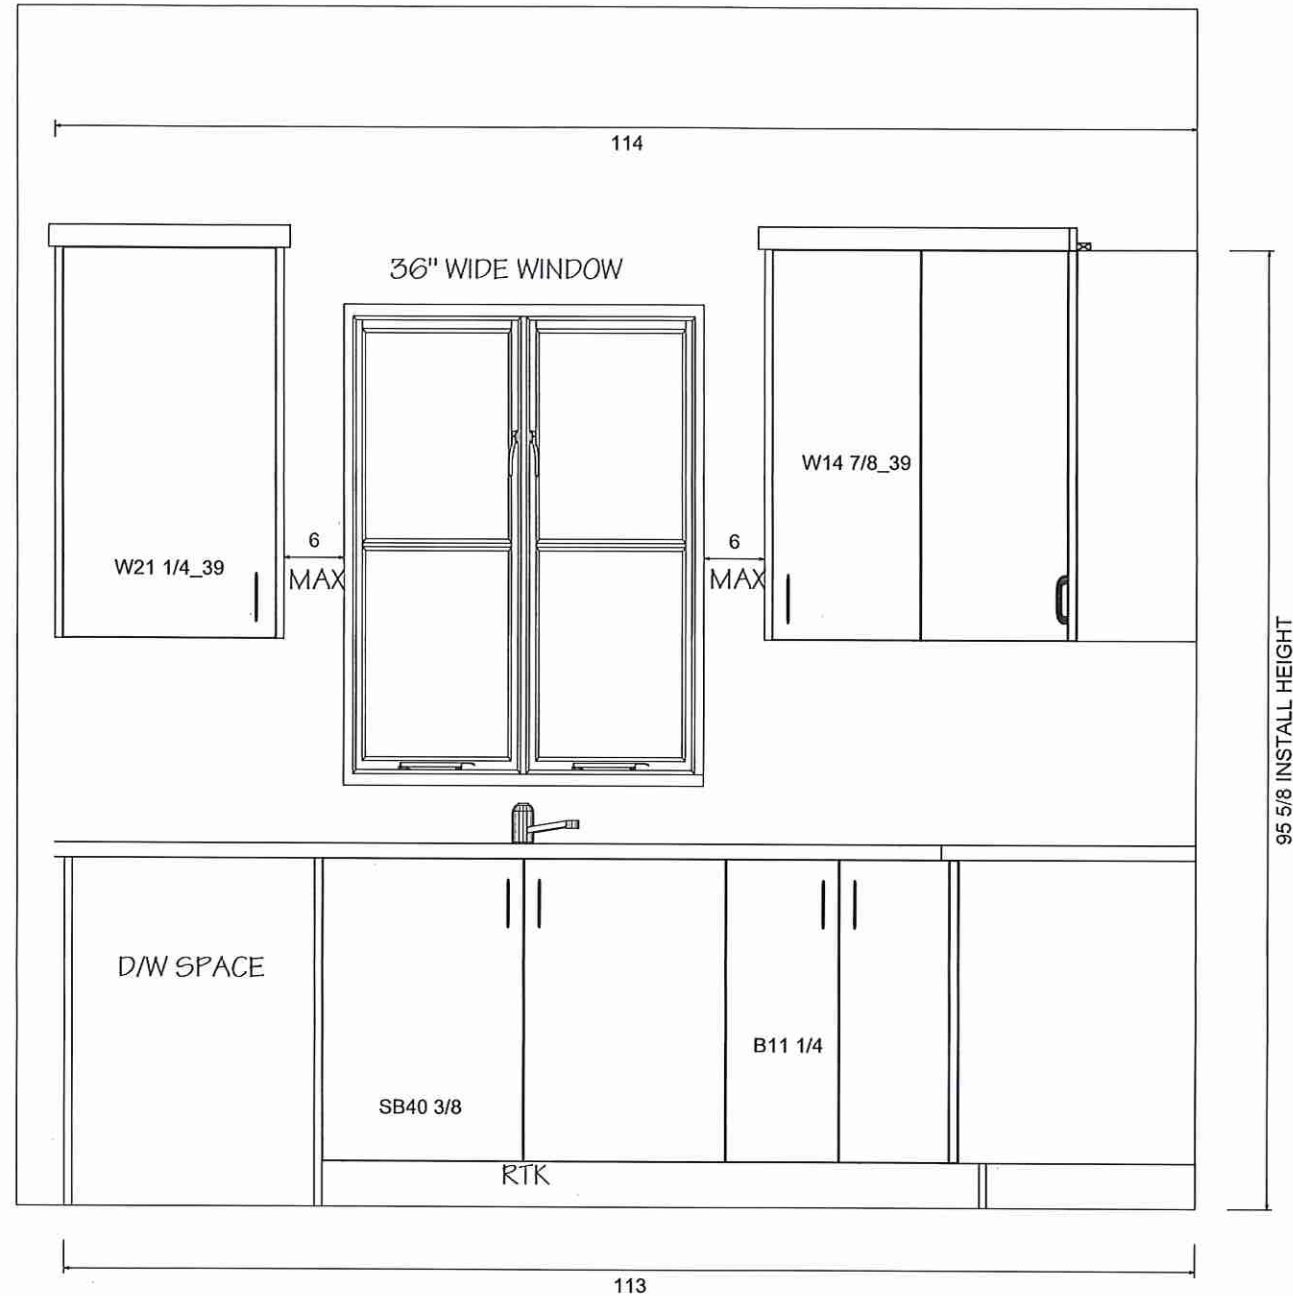

Lot 23 Forestside (Ph8)



KITCHENS & FINE CABINETS LTD

8111 Jane St. Unit 10
Concord, Ontario L4K 4L7
Tel. (905) 669- 7028
Fax. (905) 669 - 7903
email: designstudio@villakitchens.ca
www.villakitchens.ca

CLIENT: ROYAL PINE

PROJECT: FORESTSIDE PH8

ADDRESS: RP-FS(8)-LOT 23

MODEL: 45-02-CORNER-ELEV A B C

RANGE WALL

DOOR STYLE: EURO

DOOR PROFILE: N/A

DOOR MATERIAL: MELAMINE

DOOR FINISH: FOG GREY SF213

INTERIOR: WHITE

INT HARDWARE: SOFT CLOSE

DOORS

SOFT CLOSE

DRAWERS

CROWN MOLD: EURO

LIGHT VALANCE: N/A

INSTALL HEIGHT: 95 5/8"H

HW:

COUNTERTOP

DRAWN BY: ELISA

DATE: JULY 06, 2023

REVISION: NOVEMBER 30, 2023

SCALE:

PAGE: 3 OF 4

Lot 23 Forestside (Ph8)







KITCHENS & FINE CABINETRY LTD

8111 Jane St. Unit 10
Concord, Ontario L4K 4L7
Tel. (905) 669- 7028
Fax. (905) 669 - 7903
email: designstudio@villakitchens.ca
www.villakitchens.ca


CLIENT: ROYAL PINE
PROJECT: FORESTSIDE PH8
ADDRESS: RP-FS(8)-LOT 23
MODEL: 45-02-CORNER-ELEV A B C

ISLAND
DOOR STYLE: EURO
DOOR PROFILE: N/A
DOOR MATERIAL: MELAMINE
DOOR FINISH: FOG GREY SF213
INTERIOR: WHITE
INT HARDWARE: SOFT CLOSE
DOORS
SOFT CLOSE
DRAWERS
CROWN MOLD: EURO
LIGHT VALANCE: N/A
INSTALL HEIGHT: 95 5/8"H
HW:
COUNTERTOP

DRAWN BY: ELISA
DATE: JULY 06, 2023
REVISION: NOVEMBER 30, 2023
SCALE:
PAGE: 4 OF 4

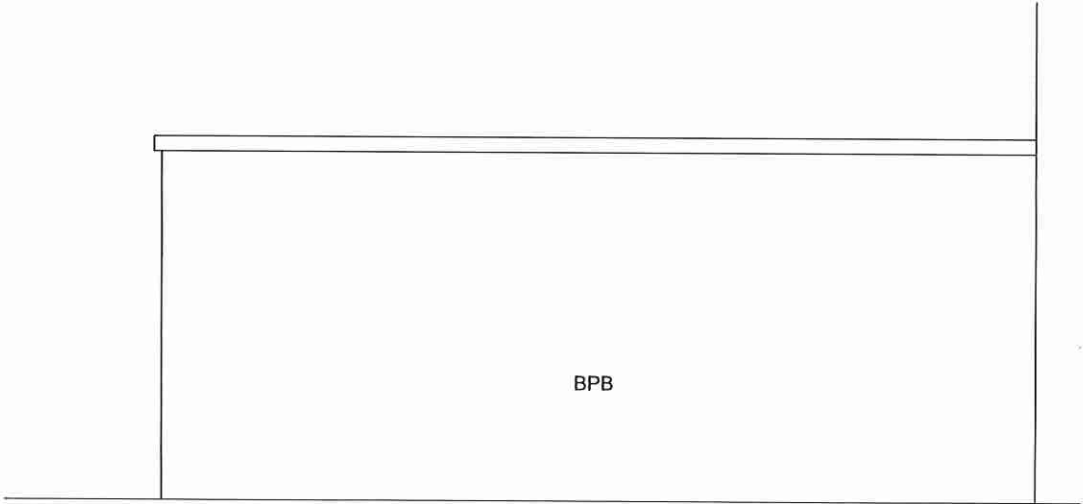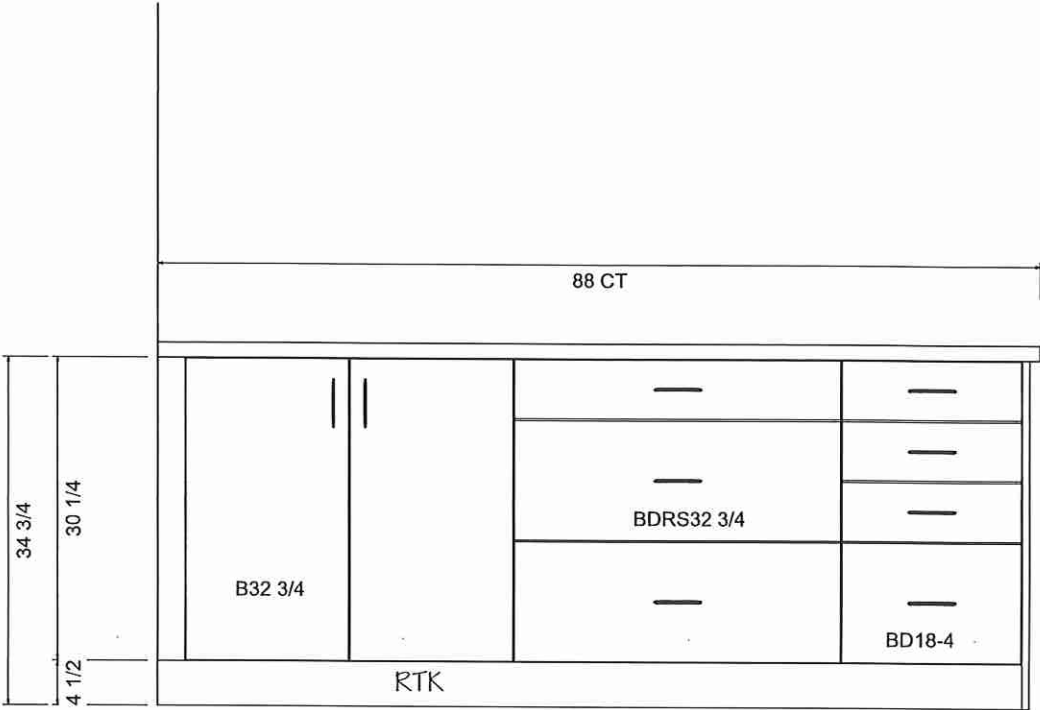

OUTLET LOCATION ON ISLAND TBD
FOR THE CLIENT PRIOR PRODUCTION

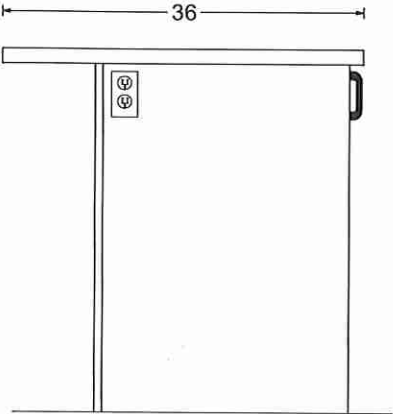

Lot 23 Forestside (Ph8)

Villa


KITCHENS & FINE CABINETRY LTD

8111 Jane St. Unit 10
Concord, Ontario L4K 4L7
Tel. (905) 669- 7028
Fax. (905) 669 - 7903
email: designstudio@villakitchens.ca
www.villakitchens.ca



CLIENT: ROYAL PINE
PROJECT: FORESTSIDE PH8
ADDRESS:
MODEL: 45-02-CORNER-ELEV A B C

VANITIES
STANDARD LAYOUT



DRAWN BY: LAI- YEE
DATE: JULY 06, 2023
REVISION: NOVEMBER 8, 2023
SCALE:
PAGE: 5 OF 10

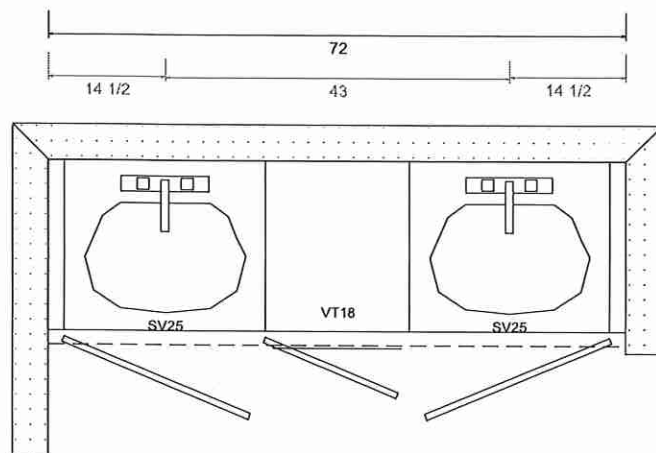


PRIMARY ENSUITE
ELEVATION A

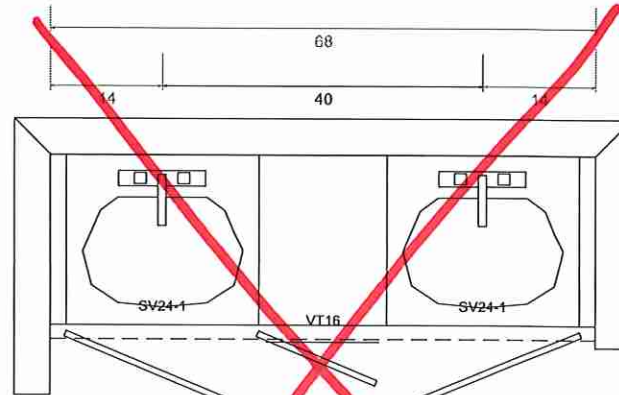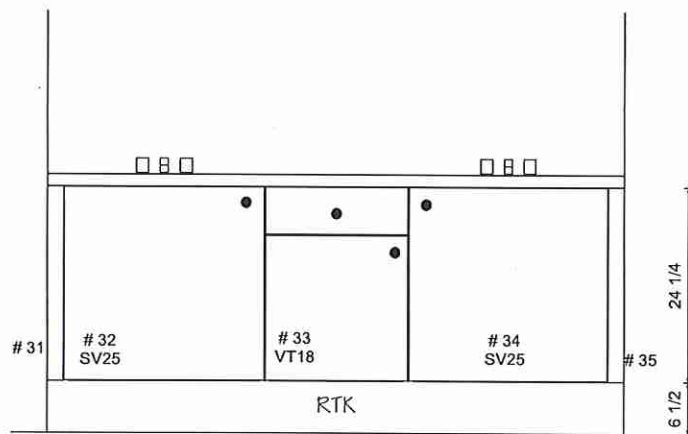

PRIMARY ENSUITE
ELEVATION B & C

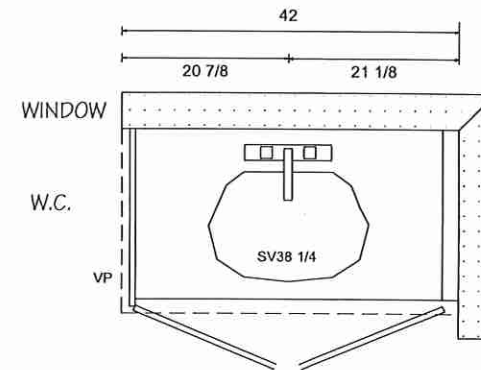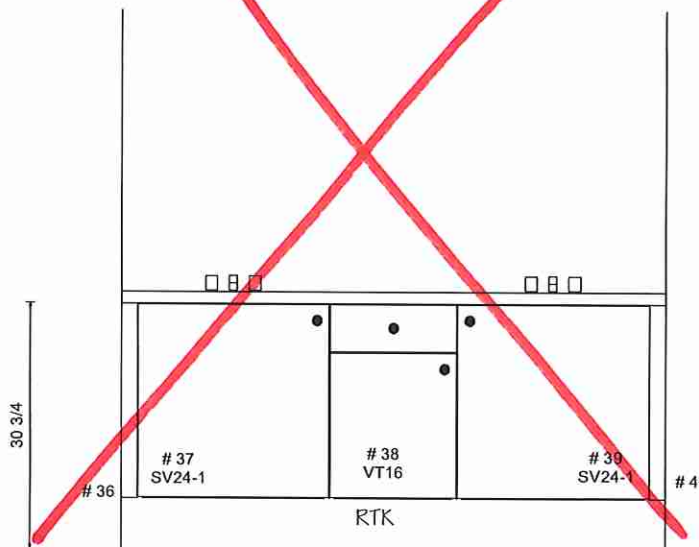

ENSUITE 2 (BEDROOM 2)
ELEVATION A, B & C

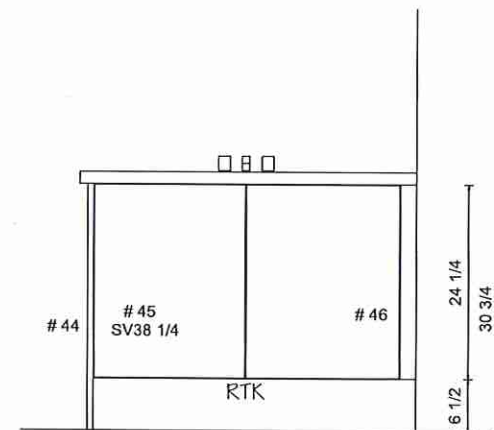

Lot 23 Forestside (Ph8)

Villa


KITCHENS & FINE CABINETRY LTD

8111 Jane St. Unit 10
Concord, Ontario L4K 4L7
Tel. (905) 669- 7028
Fax. (905) 669 - 7903
email: designstudio@villakitchens.ca
www.villakitchens.ca



CLIENT: ROYAL PINE
PROJECT: FORESTSIDE PH8
ADDRESS:
MODEL: 45-02-CORNER-ELEV A B C

VANITIES
STANDARD LAYOUT


DRAWN BY: LAI- YEE
DATE: JULY 06, 2023
REVISION: NOVEMBER 8, 2023
SCALE:
PAGE: 6 OF 10

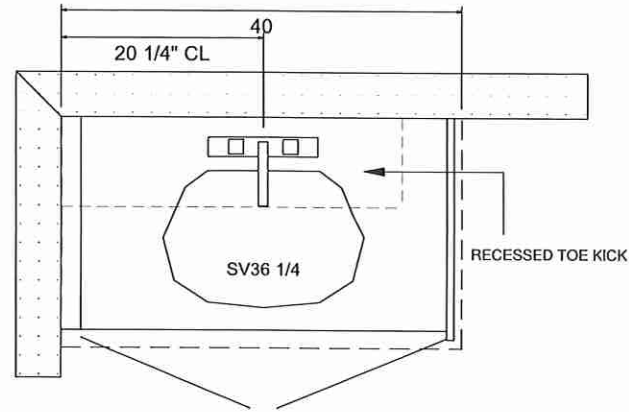

POWDER ROOM
ELEVATION A, B & C

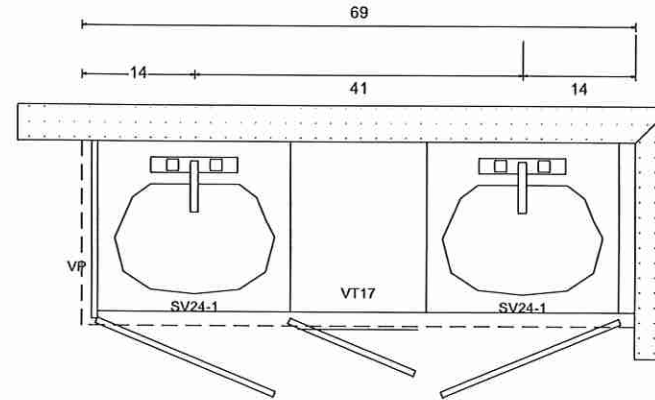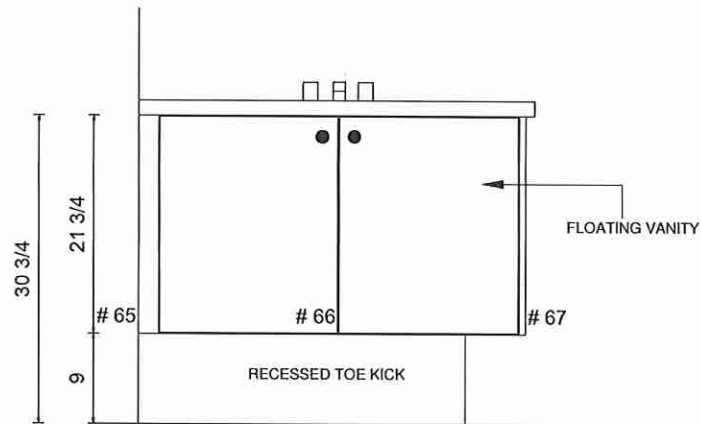

SHARED BATH (BEDROOM 3 & 4)
ELEVATION A, B & C

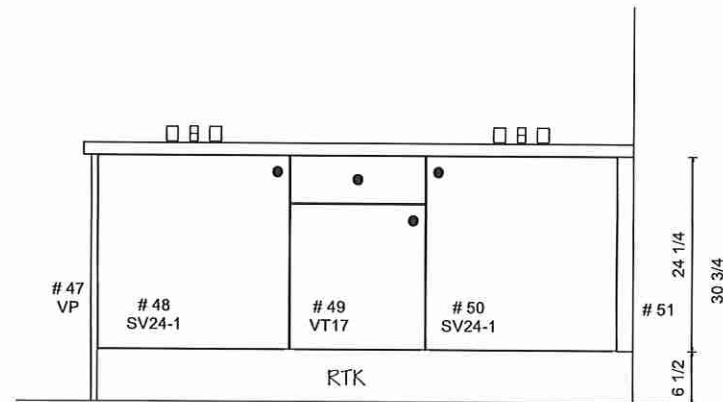

Lot 23 Forestside (Ph8)

Villa

KITCHENS & FINE CABINETRY LTD

8111 Jane St. Unit 10
Concord, Ontario L4K 4L7
Tel. (905) 669- 7028
Fax. (905) 669 - 7903
email: designstudio@villakitchens.ca
www.villakitchens.ca

CLIENT: ROYAL PINE
PROJECT: FORESTSIDE PH8
ADDRESS:
MODEL: 45-02-CORNER-ELEV A B C

LAUNDRY


DRAWN BY: LAI- YEE

DATE: JULY 06, 2023

REVISION: NOVEMBER 8, 2023

SCALE:

PAGE: 10 OF 10

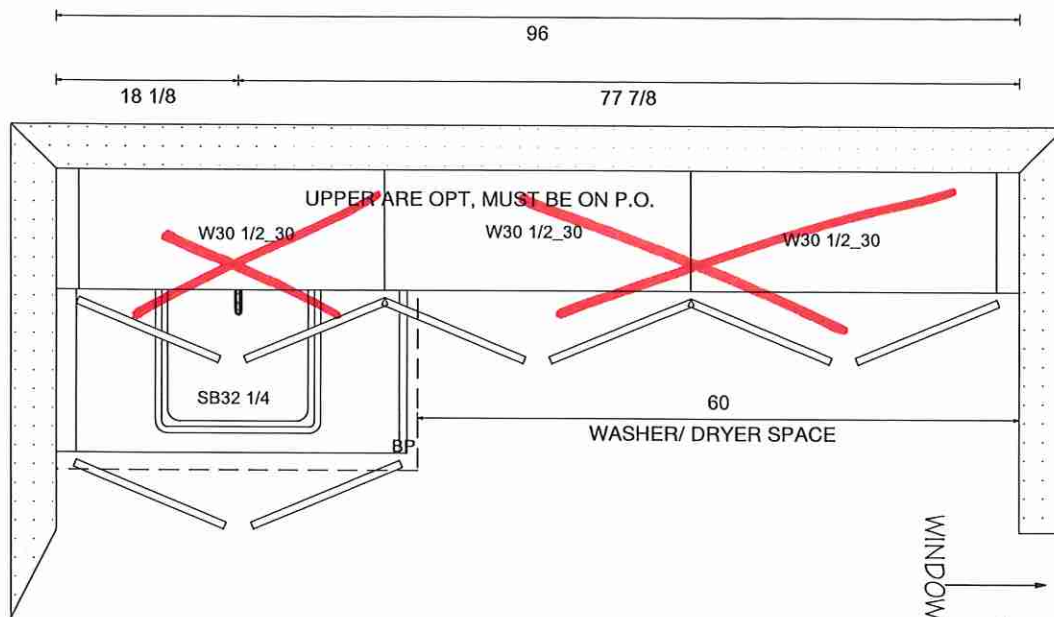

WINDOW

30

21 3/4

34 3/4

39

40
W30 1/2_30

41
W30 1/2_30

42
W30 1/2_30

43

36

37
SB32 1/4

38

60
WASHER/ DRYER SPACE

Lot 23 Forestside (Ph8)

QUATRUS R15 U 2

Stainless steel satin polish

* Installed w Standard Faucet

Sink Specifications


Colour SKU
satin polish 401519

Design and planning tips

- Min cabinet size: 36 in (915 mm)


Specifications:

3 ½" stainless steel strainer(s), Installation Instructions, Cut-out template, Undermount clips, Limited Lifetime Warranty

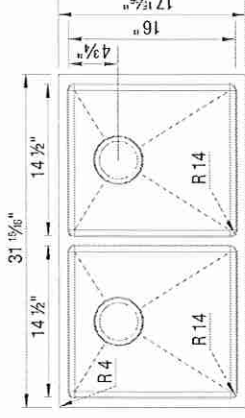


Codes & Standards

ASME A112.19.3-2017/CSA B45.4-17

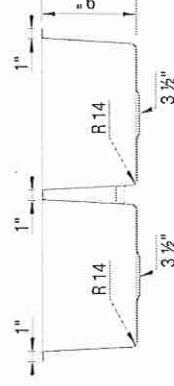

Optional Accessories

~~Ash Cutting Board 406345~~
~~CapFlow Strainer Cover 517666~~
~~Sink Grid 233080~~

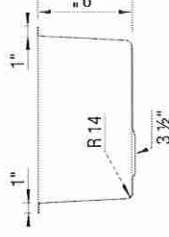

SR

Warranty

Limited lifetime warranty on all sinks and faucets. One-year warranty on all accessories and soap dispensers.

Code/Standards Compliance

BLANCO sinks and faucets are third-party tested and certified to CSA, cUPC, ANSI/ASME, IAPMO and NSF standards and listed by applicable certification bodies. For more information on individual product listings, contact our office or listing organization.



Need support? Learn more by watching our sink & faucet How-to videos:
<https://www.blanco.com/ca-en/support/how-to-videos/how-to-videos-for-sinks/>



BLANCO Canada Inc
100 Corporation Drive
Brampton ON L6S 6B5

Tel & Fax


Tel: 905-494-2400 Toll free: 1-877-425-2626
Fax: 905-494-2425 Toll free: 1-877-825-2626

While BLANCO strives to provide accurate information, all images and dimensions in this document are intended for reference only and are subject to change at any time without notice. This document is not intended for use as an installation guide. For technical installation details, refer to installation instructions provided with the product. BLANCO assumes no responsibility for the use of superseded or voided specifications.

Lot 23 Forestside (Ph 8)

Wk SE

CONTRAC CATENA

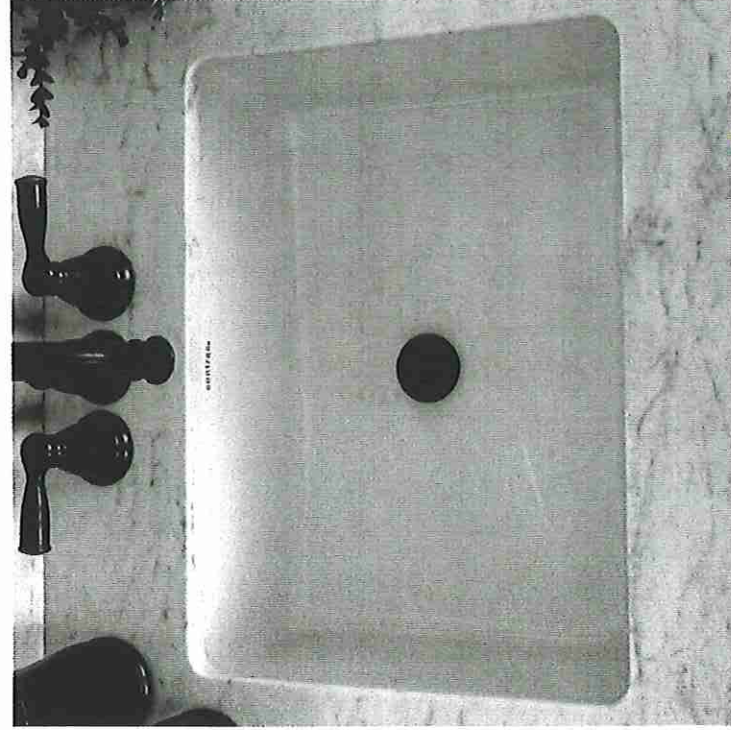

Rectangular Undermount Sink
4210CIY

Vitreous china
Front overflow hole
Template supplied
Faucet not included
Mounting clips not included
20" W x 15³/₈" D x 7¹/₂" H

* Powder Room (x1)✓

* Primary Ensuite (x2)✓

* To Be installed with

Standard Faucet

* Shared Both ³/₄ (x2)✓

* Ensuite #2 (x1)