



SITE FILE COPY

STRUCTURAL

CONSTRUCTION SUMMARY  
Forestside Estates Inc.

\* INVENTORY \*

\* INVENTORY \*

| LOT NUMBER | PHASE | HOUSE TYPE                                 | CLOSING DATE |
|------------|-------|--------------------------------------------|--------------|
| 33         | 8     | WHITE FIR (45-02C) - ELEV C OPT. 5 BEDROOM |              |

|           |       |
|-----------|-------|
| Offer     |       |
| Worksheet | Note: |

1 - SIDE EXTERIOR - Install OPTIONAL SIDE DOOR ENTRANCE (Includes Applicable Exterior Coach Light)  
\*\*If Grade Permits\*\* (See Sketch)  
Note:

\* 4 - BASEMENT - Increase THREE (x3) Basement Windows LARGER 30 IN (W) x 24 IN (H)  
(See Sketch) - Increase TWO (x2) Basement Windows LARGER 36 IN (W) x 24 IN (H) (See Sketch)  
Note:

\* 1 - FRONT EXTERIOR - FRONT DOOR - Install EXTENDED HEIGHT DOUBLE DOORS (Delete Transom Window Above and Side Lights)  
Note:

1 - BASEMENT - Install 200 AMP SERVICE in lieu of builders standard 100 Amp Service (See Sketch)  
Note:

\* 1 - MAIN FLOOR Extended height doors  
- Foyer Closet Door  
- Powder Room Door  
- Walk in Pantry Door

\* 1 - PRIMARY ENSUITE - Shower 40"x 48" (inside dimensions) - Delete wall - prep. for future frame-less glass (glass not included)

1 - BASEMENT- Increase basement height to APPROXIMATELY 9'-0" as per vendors specifications and architentural drawings.  
Note:




Materials, specifications and floor plans are subject to change without notice. All renderings are artist's concept. All floor plans are approximate dimensions. Actual usable floor space may vary from the stated floor area. E.&O.E.

LOT 33: 45-02 : The White Fir : EL.C. 5 BEDROOMS . 3350 SQ.FT.



THE **WHITE FIR** (45-02)

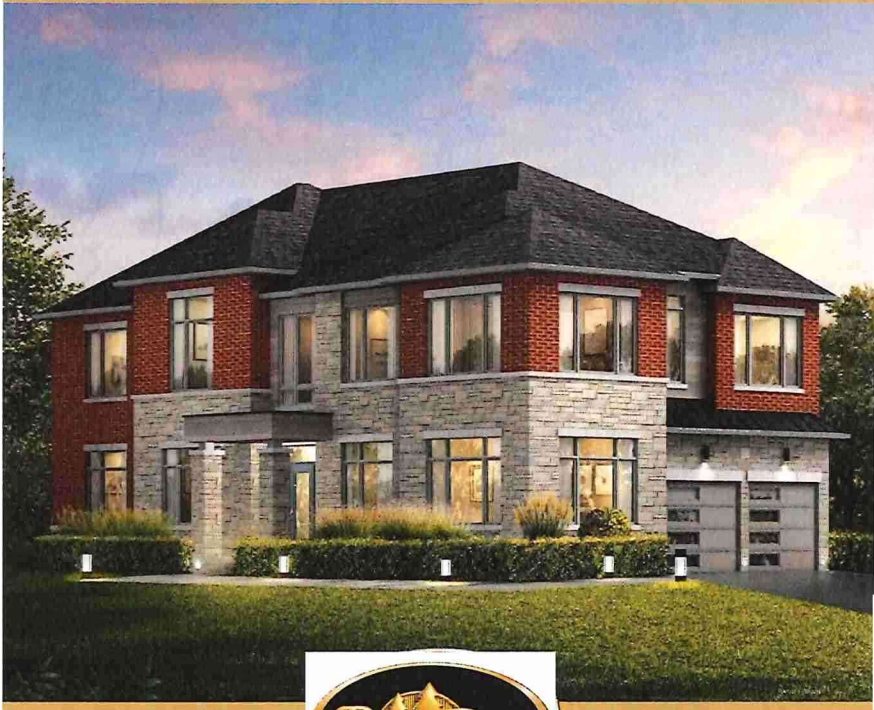

**LOT 33**

ELEVATION C  
**3350**  
SQUARE FEET



FRONT ELEVATION 'C'



REAR ELEVATION 'C'  
OPT. 5 BED. SEC. FLR. PLAN