

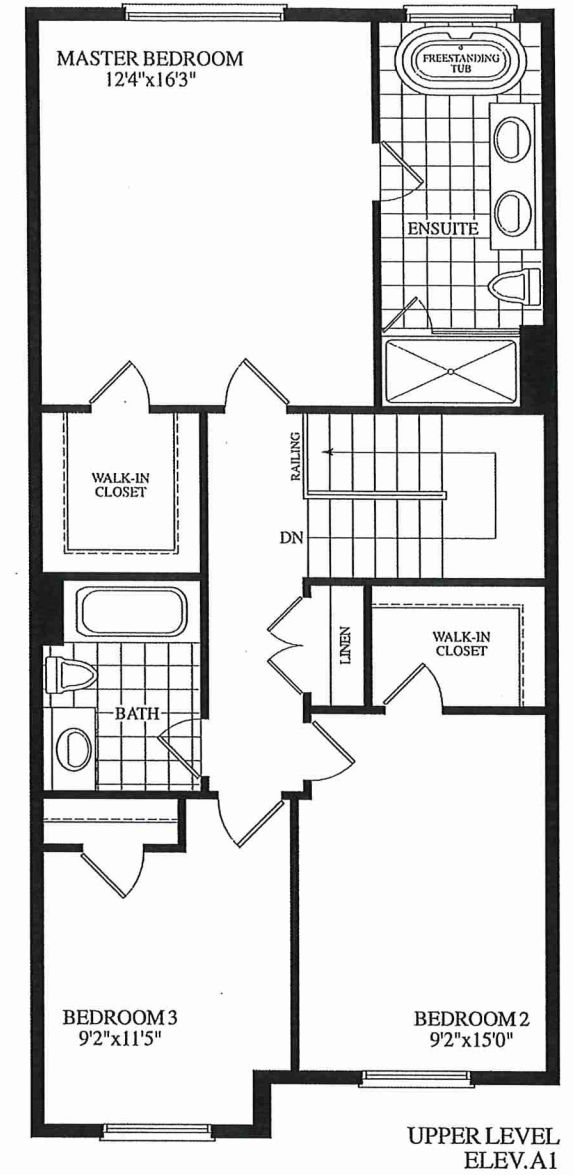


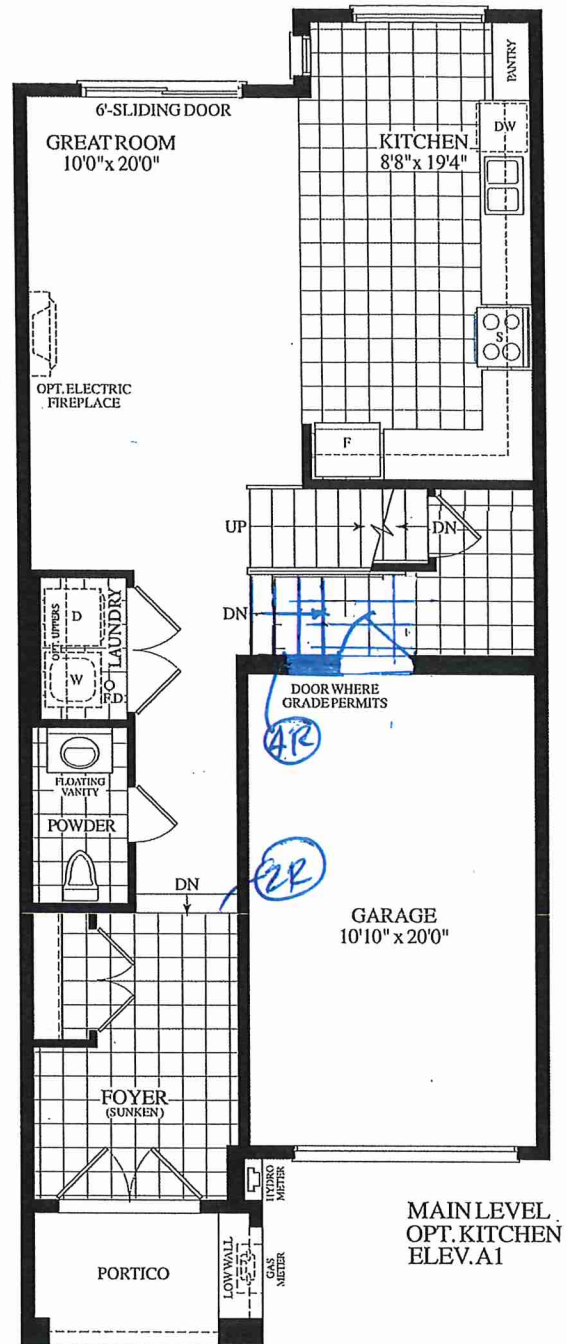

MODEL 20-07

BLK. 235 TH. 71 THE LAWRENCE EL. A1 1665 SQ. FT.

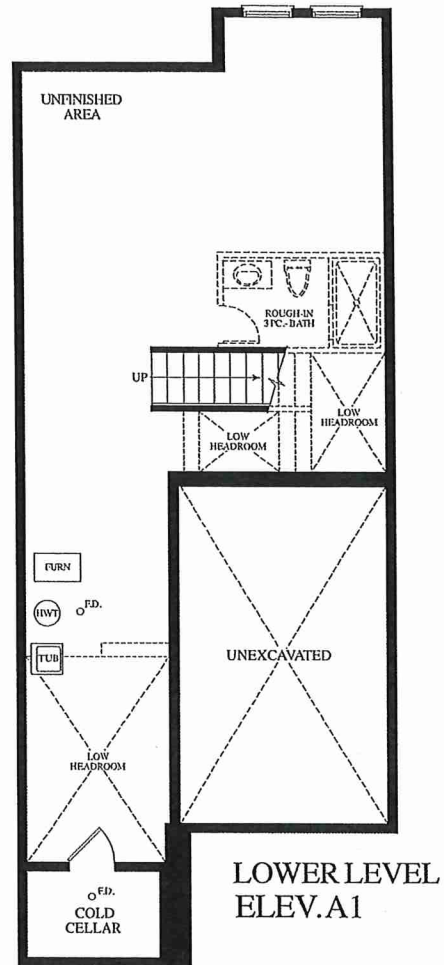

ELEV. A1/A2

OAKRIDGE
MEADOWS

SCHEDULE "B"

Purchaser

Purchaser

And

Vendor

Lot Number

Date of Offer

Dated Required:

Model:

TZE-MAN LEUNG

KATHARINE WONG

Grovetrail Developments Inc.

71 BLOCK 235 TIPP DRIVE, Phase 3, Plan PLAN 65M-4785
in the CITY of RICHMOND HILL

October 28, 2024

August 12, 2025

LAWRENCE-OPT Kitchen Layout Elev A1 (20-07A1-K)

Description - Vendor to Supply and Install the Following as Per Purchase Price
--

- BONUS PACKAGE FOR TOWNHOUSE: PURCHASER TO RECEIVE \$7,500.00 (INCLUSIVE OF TAXES) WORTH OF UPGRADES AT DECOR CENTRE AT TIME OF COLOUR CHART
- BONUS PACKAGE FOR TOWNHOUSE: 5 APPLIANCES TO INCLUDE FRIDGE, STOVE, DISHWASHER WITH STAINLESS STEEL FINISH AND WHITE WASHER AND DRYER AS PER VENDORS SAMPLES.