



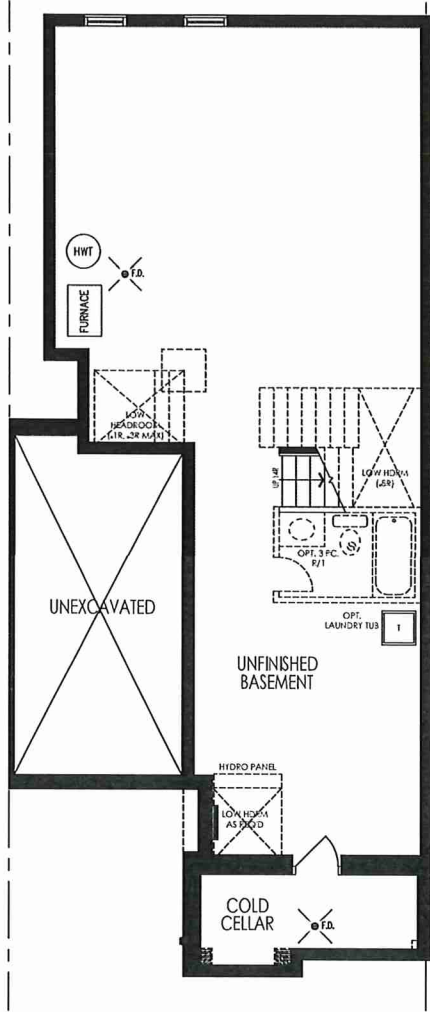


BASEMENT PLAN ELEV B1 rev.

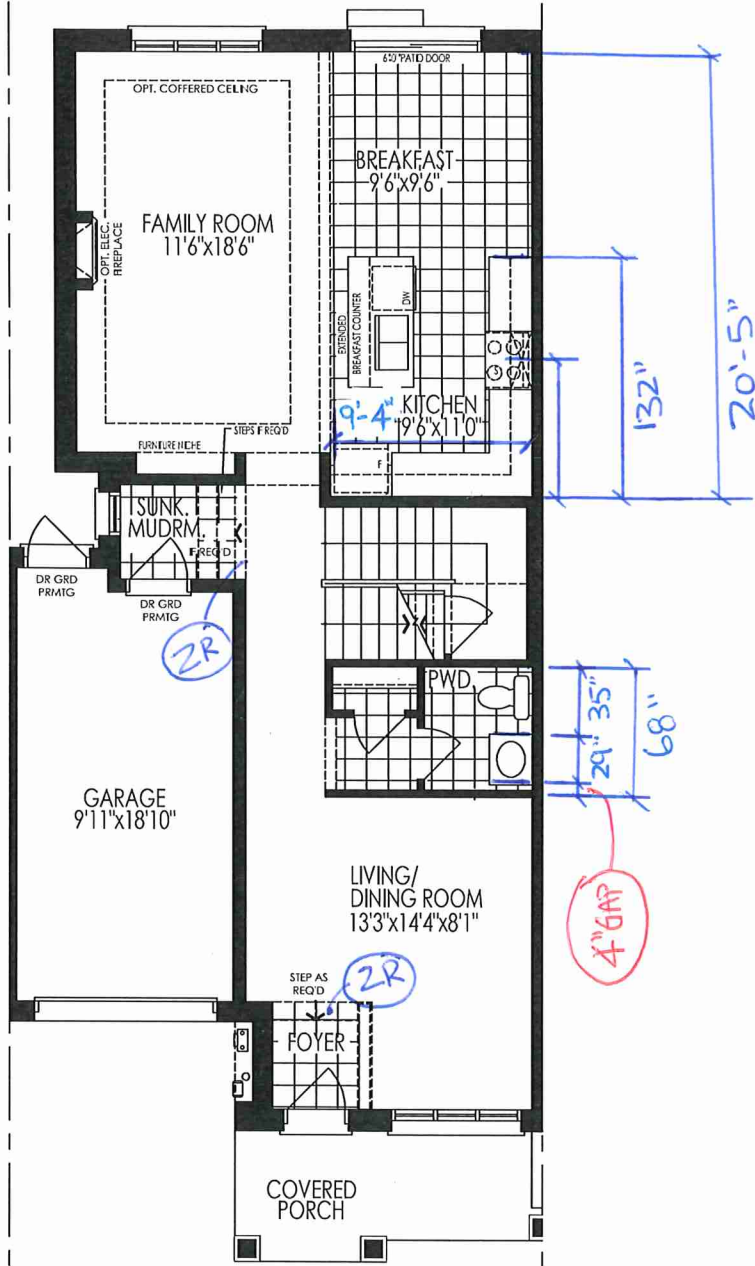

REVISED MAIN

GROUND FLOOR PLAN ELEV B1 rev.


Materials, specifications and floor plans are subject to change without notice. All renderings are artist's concept. All floor plans are approximate dimensions. Actual usable floor space may vary from the stated floor area. E.&O.E.

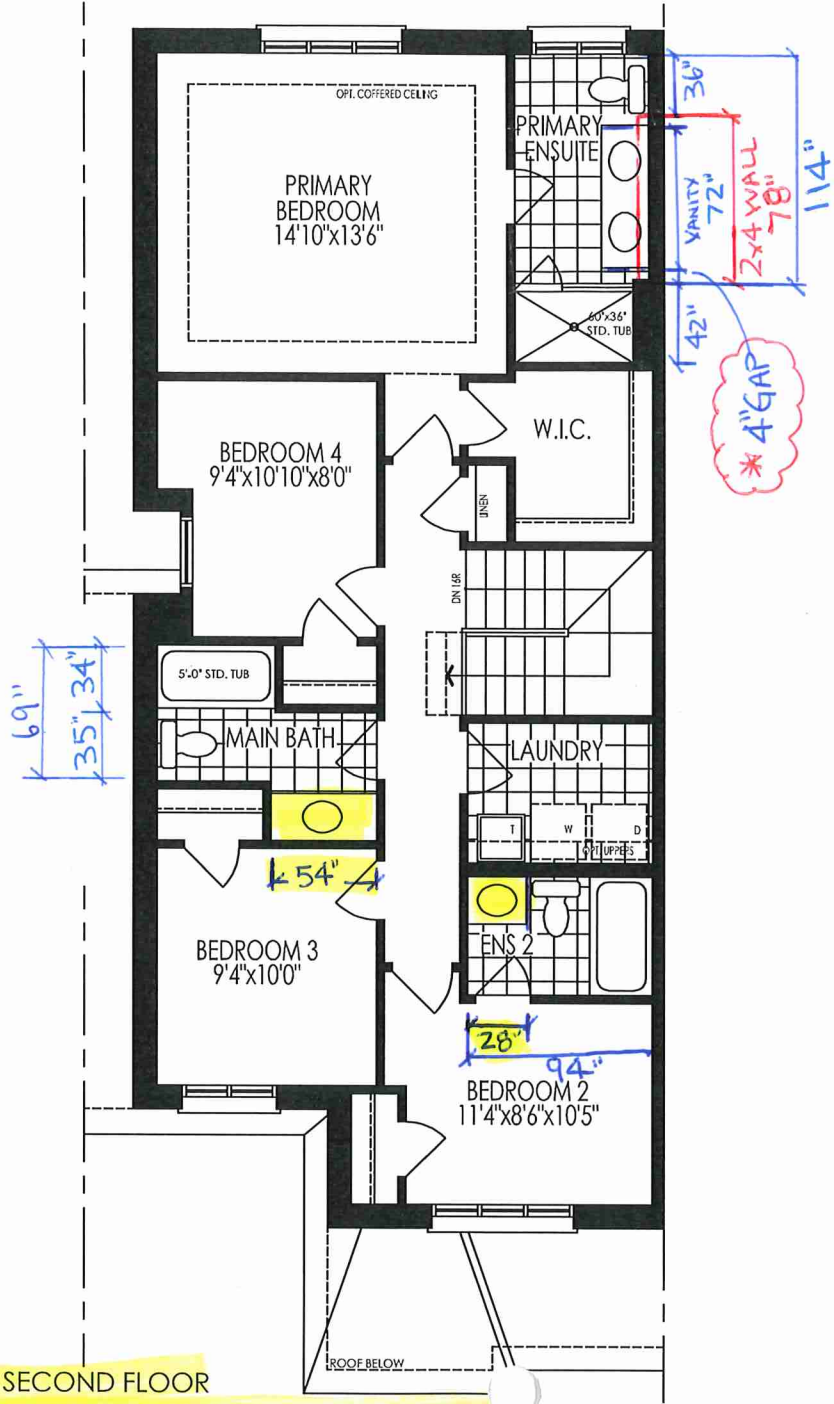

OPT. SECOND FLOOR
(W/OPT. 4 BEDROOM) PLAN, ELEV B1 rev.

INVENTORY LOT #24 - REVISED MAIN / OPT. 4 BEDRM 2ND FLOOR

BLOCK 290.TH.10 25-02 ROSE GARDEN EL.B1 rev. 4 BDR.1940 SQ.FT

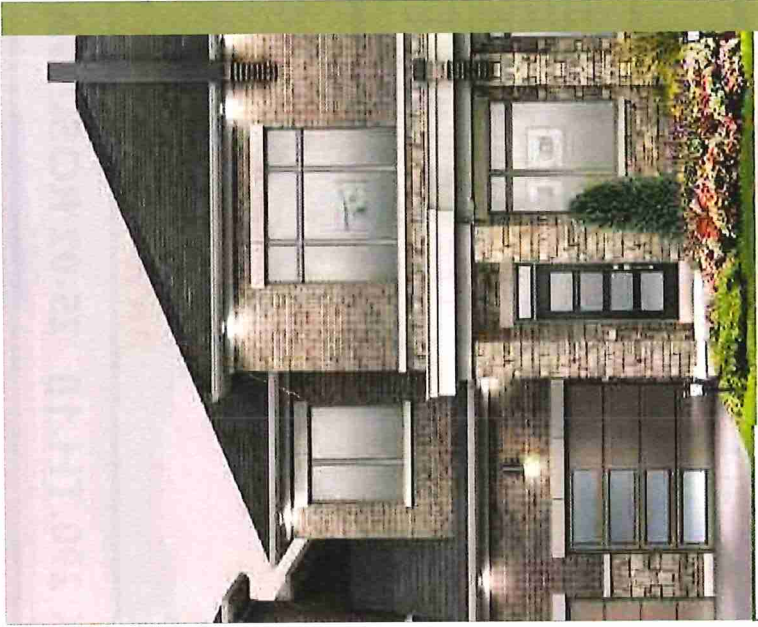

Artist concept

ELEV. B1 & B2



1940
SQUARE FEET