




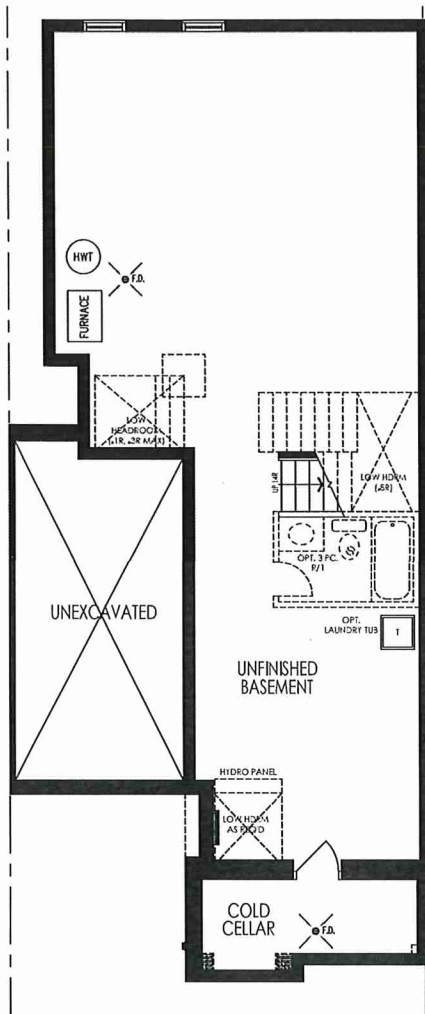

BASEMENT PLAN ELEV B2

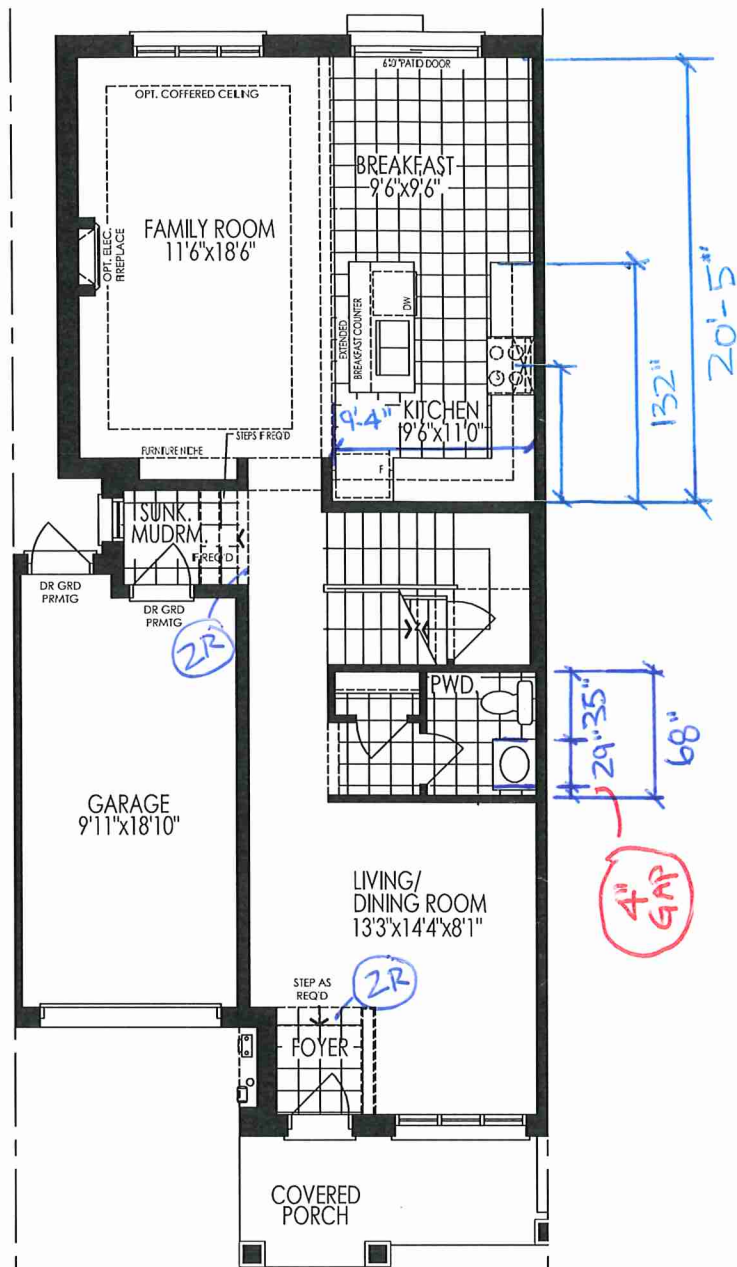


REVISED MAIN
GROUND FLOOR PLAN ELEV B2

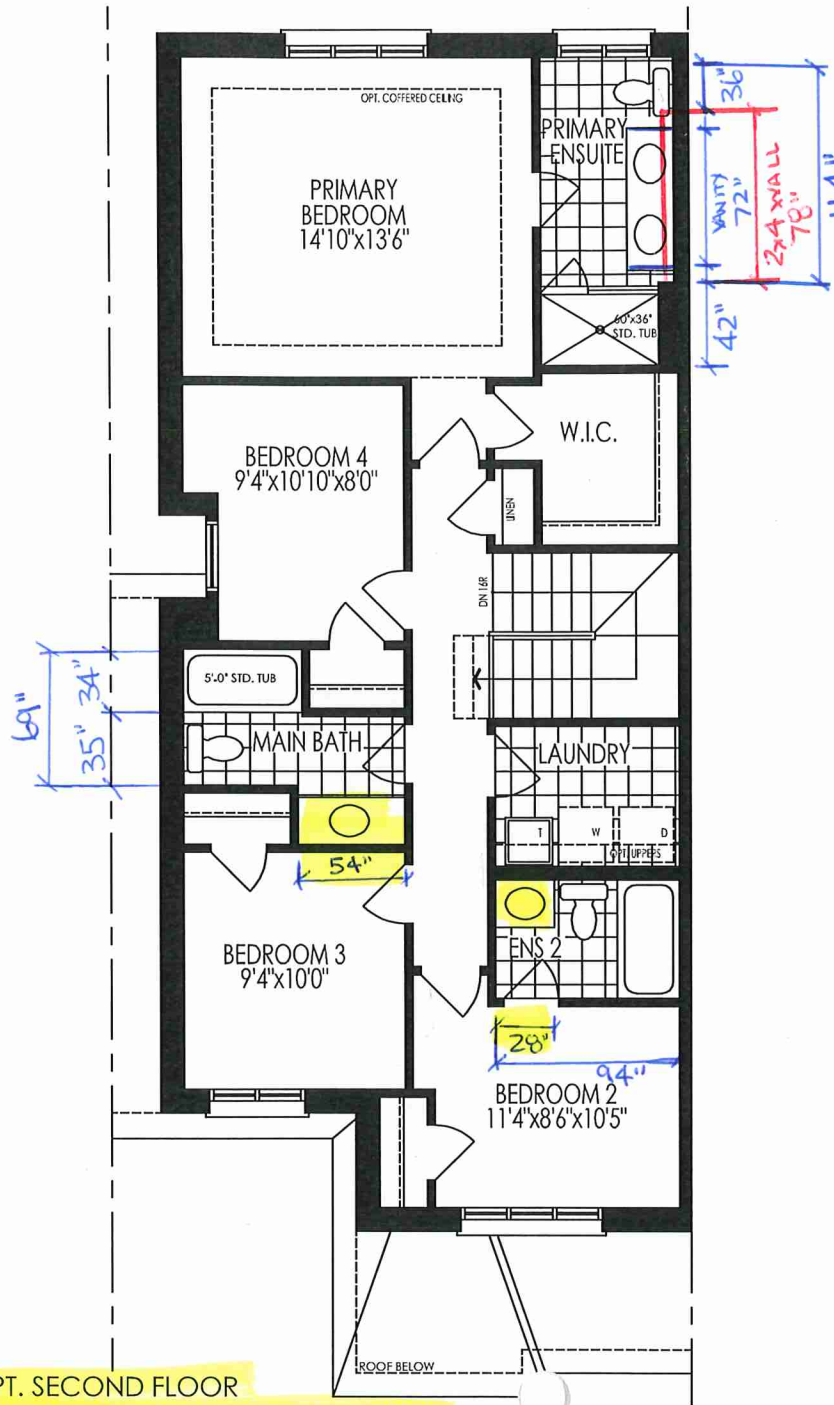

OPT. SECOND FLOOR
(W/OPT. 4 BEDROOM) PLAN, ELEV B2

INVENTORY TH#11 = REVISED MAIN / OPT 4 BEDRM 2ND FLOOR

BLOCK 290.TH.11 25-02 ROSE GARDEN EL.B2 4 BDR. 1940 SQ. FT.

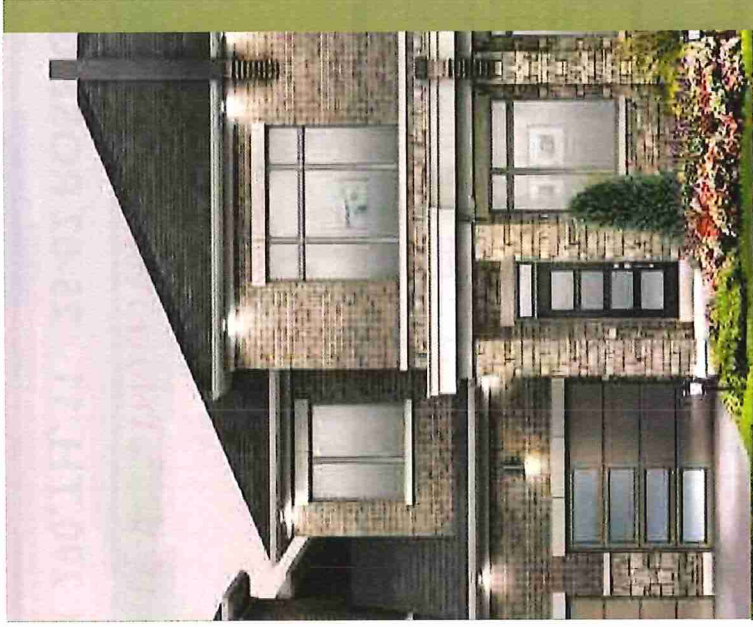

Artist concept

ELEV. B1 & B2

1940
SQUARE FEET