

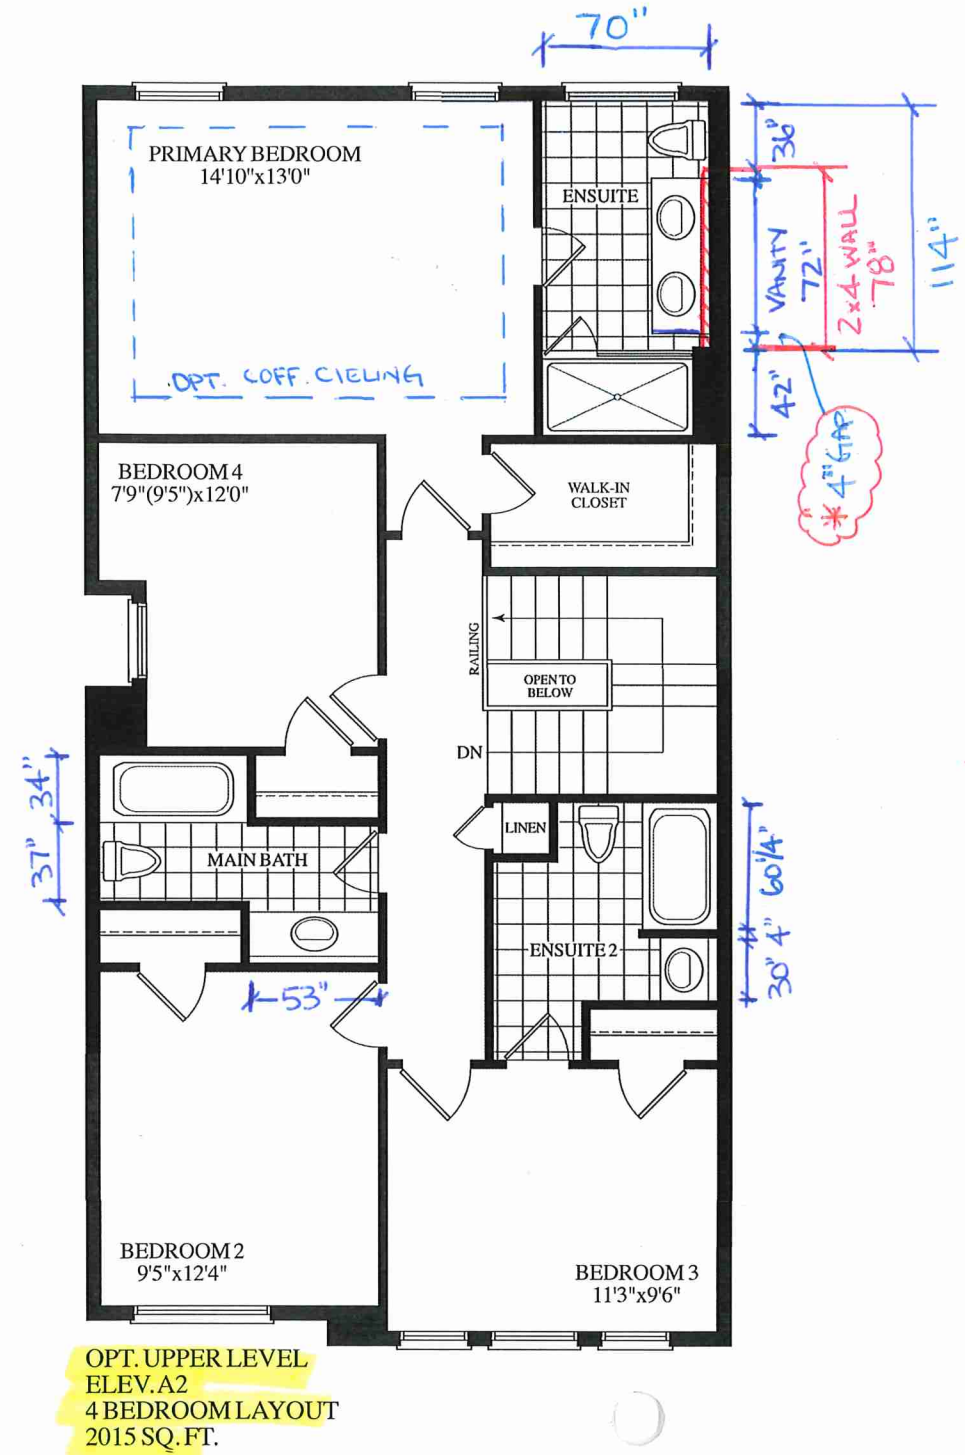


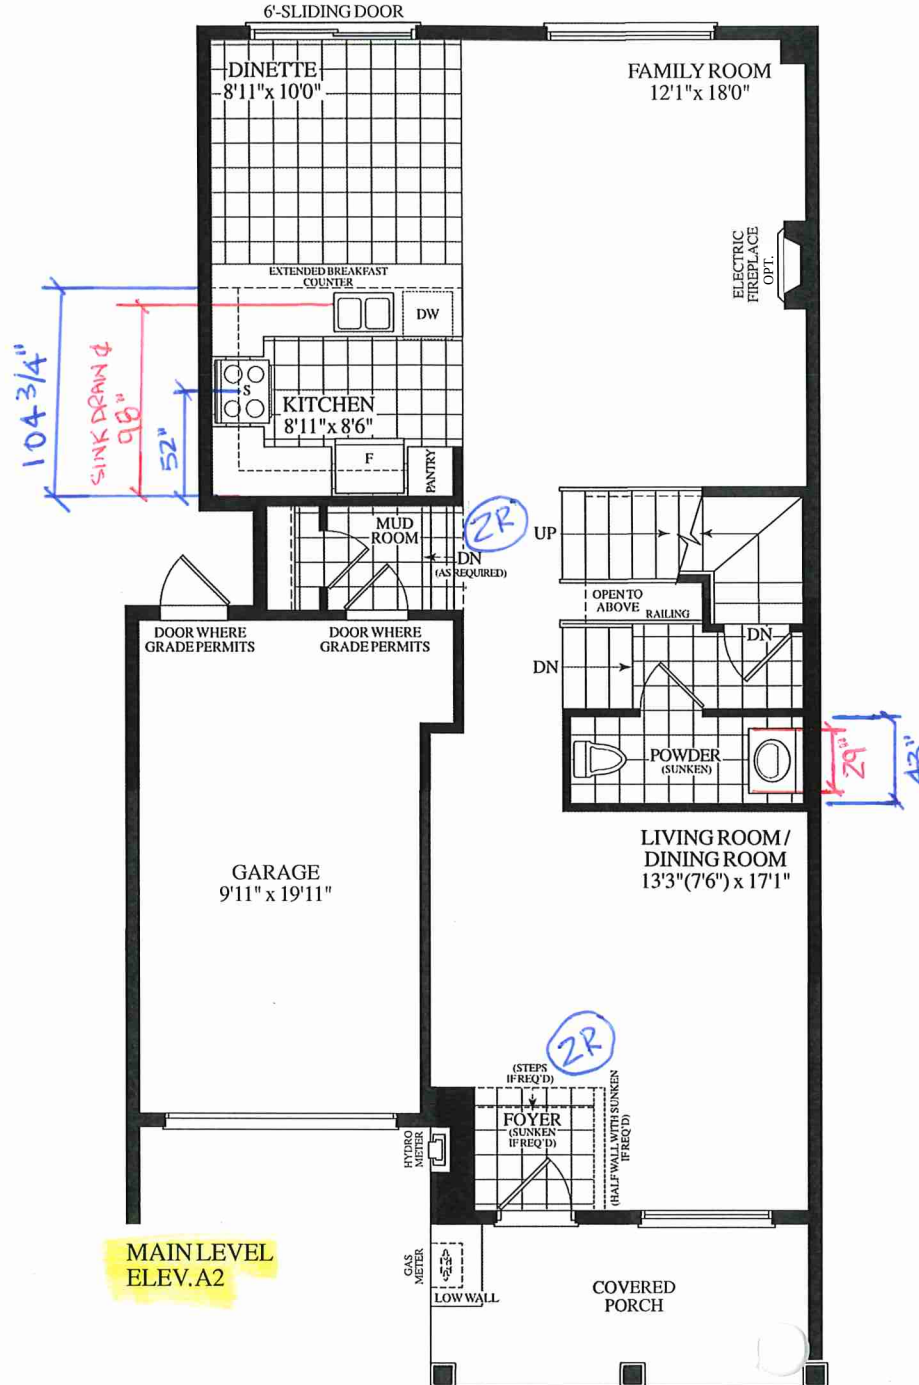

Materials, specifications and floor plans are subject to change without notice. All renderings are artist's concept. All floor plans are approximate dimensions. Actual usable floor space may vary from the stated floor area. E.&O.E.

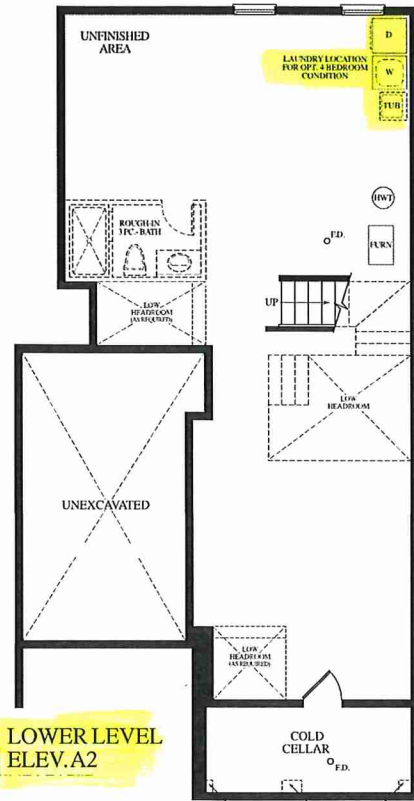

INVENTORY LOT #27 = STD MAIN / OPT UPPER LEVEL 4-BEDRM

BLOCK 292 - TH. 27 25-03 ROSE PETAL EL.A2 4 BEDROOM 2055 SQ. FT.



2020
SQUARE FEET

ELEV. A2

ARTIST CONCEPT