




Block 291

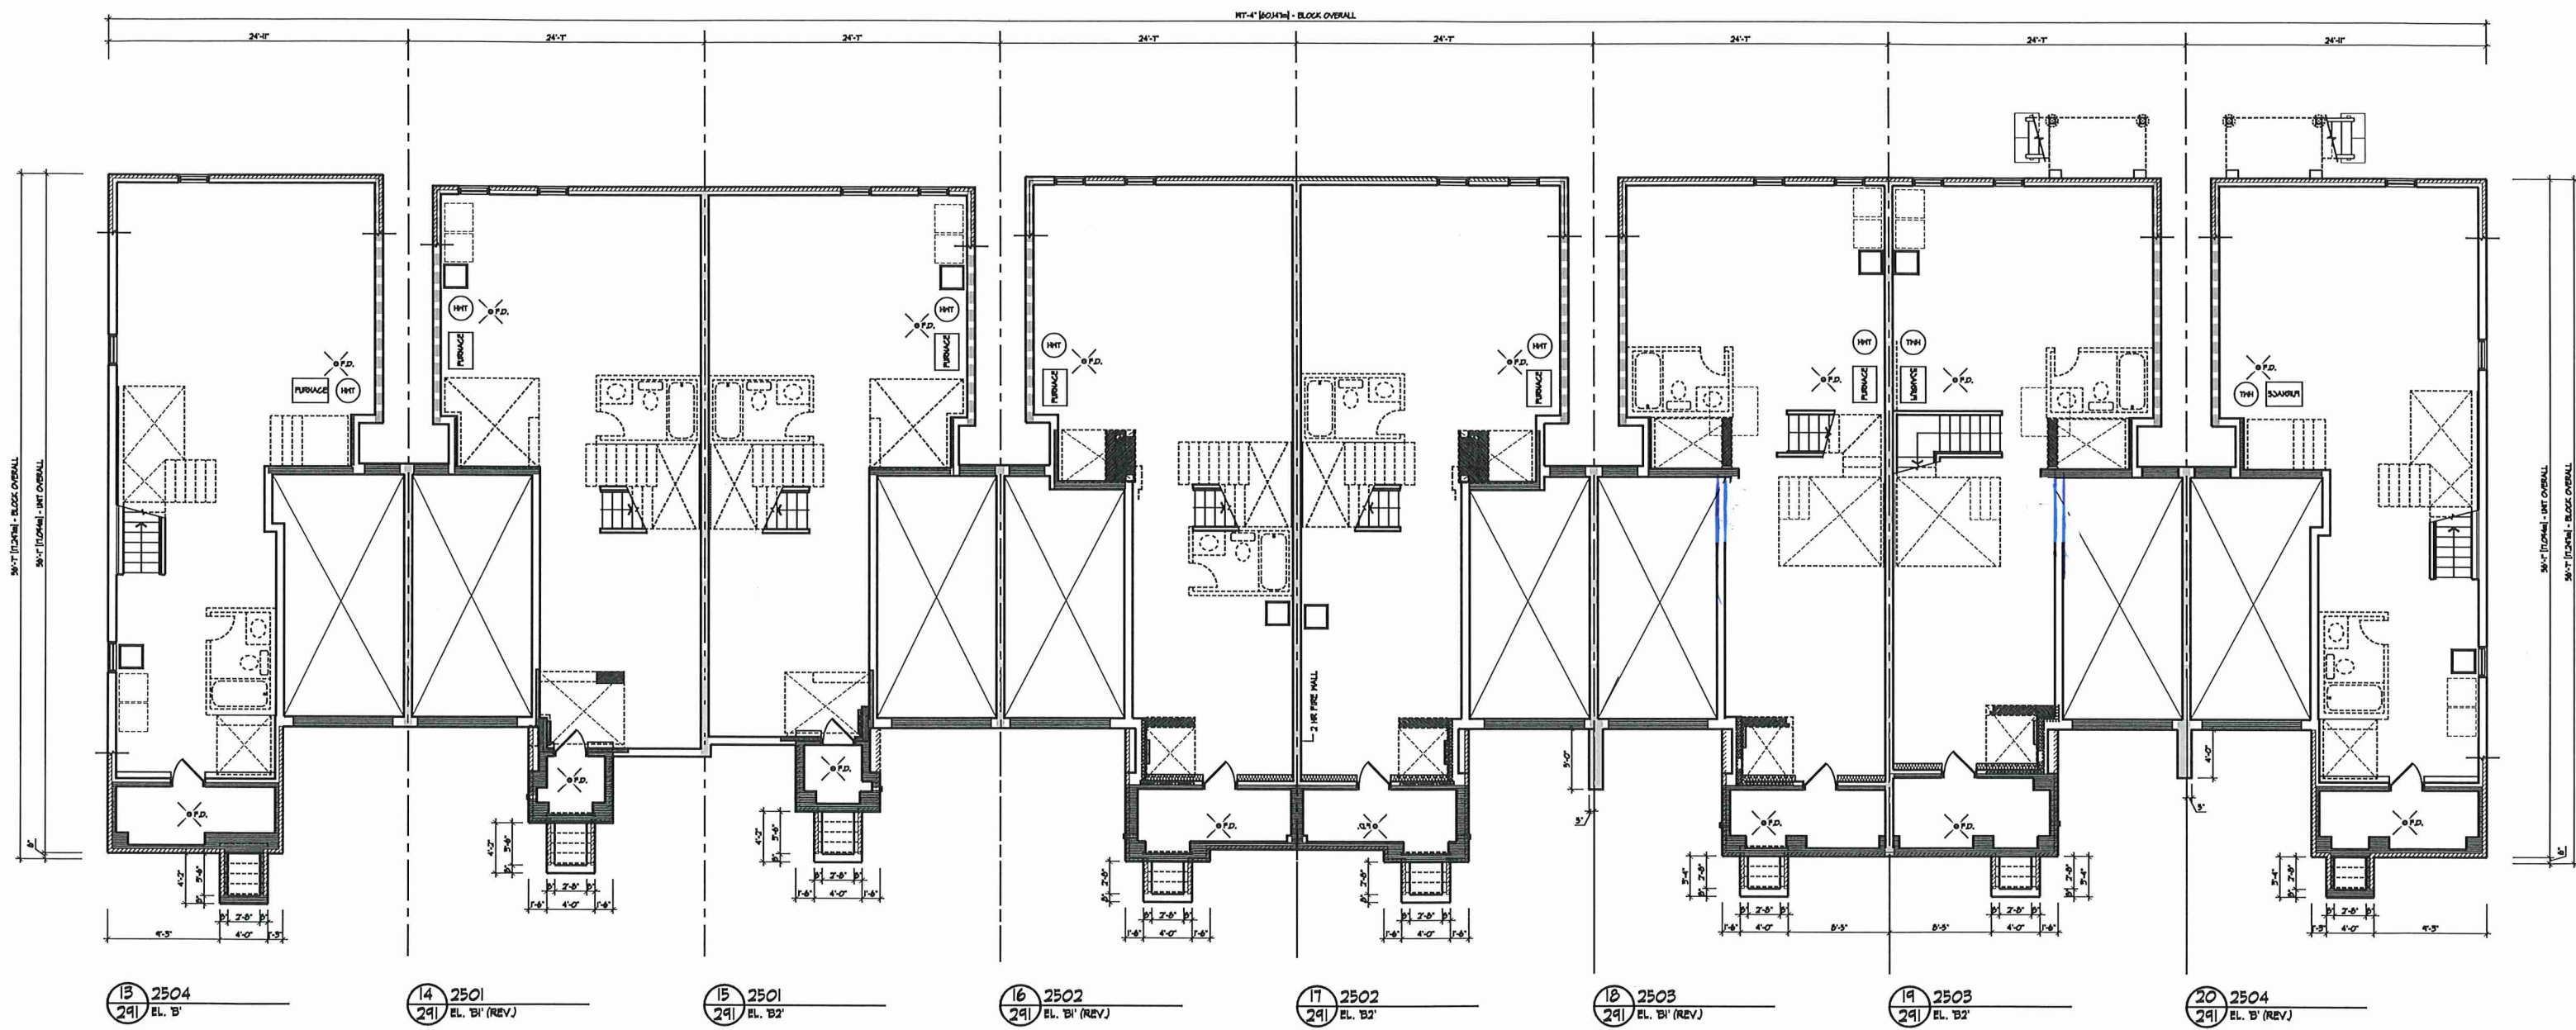

BASEMENT PLAN

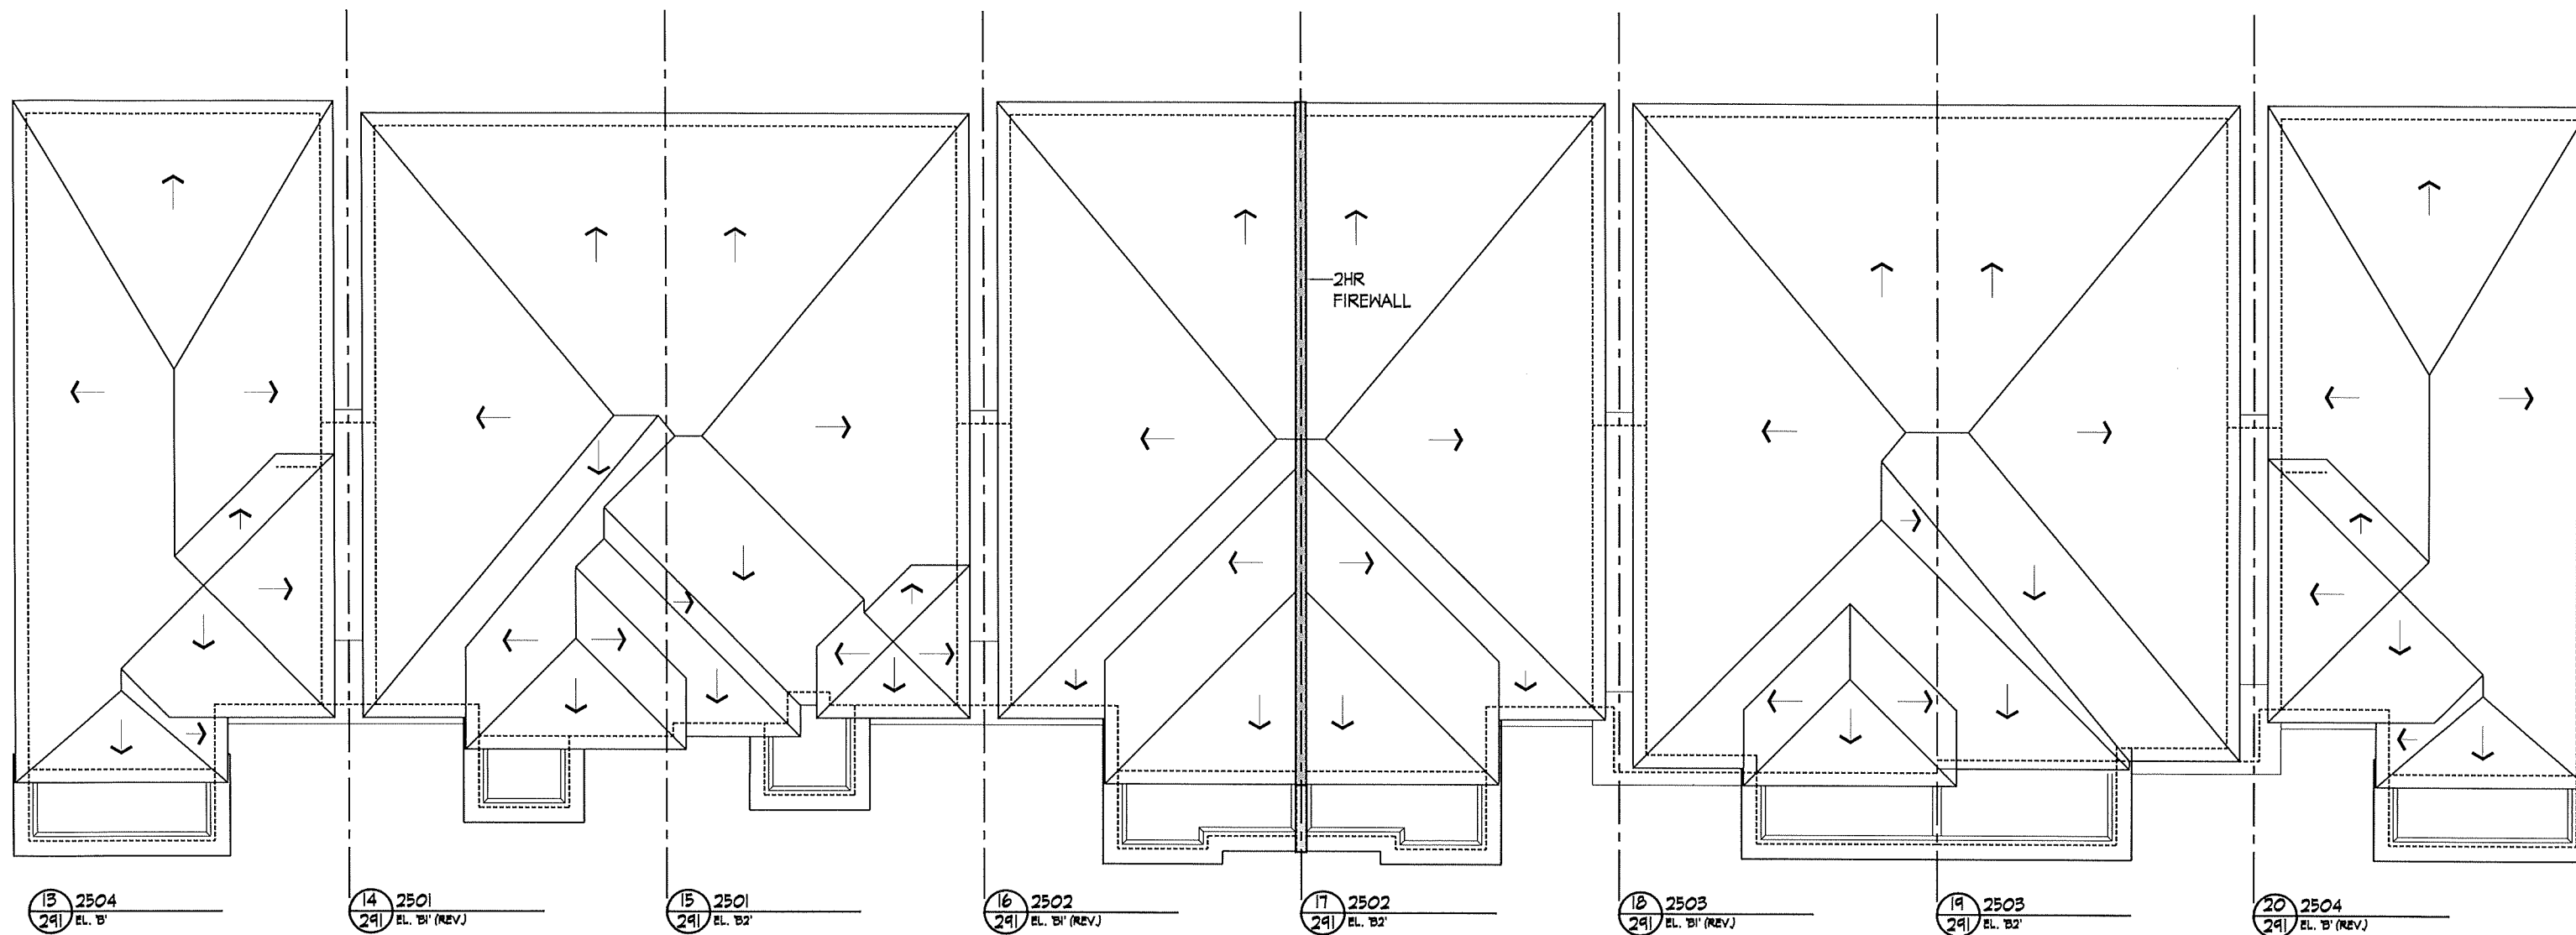

ROOF PLAN

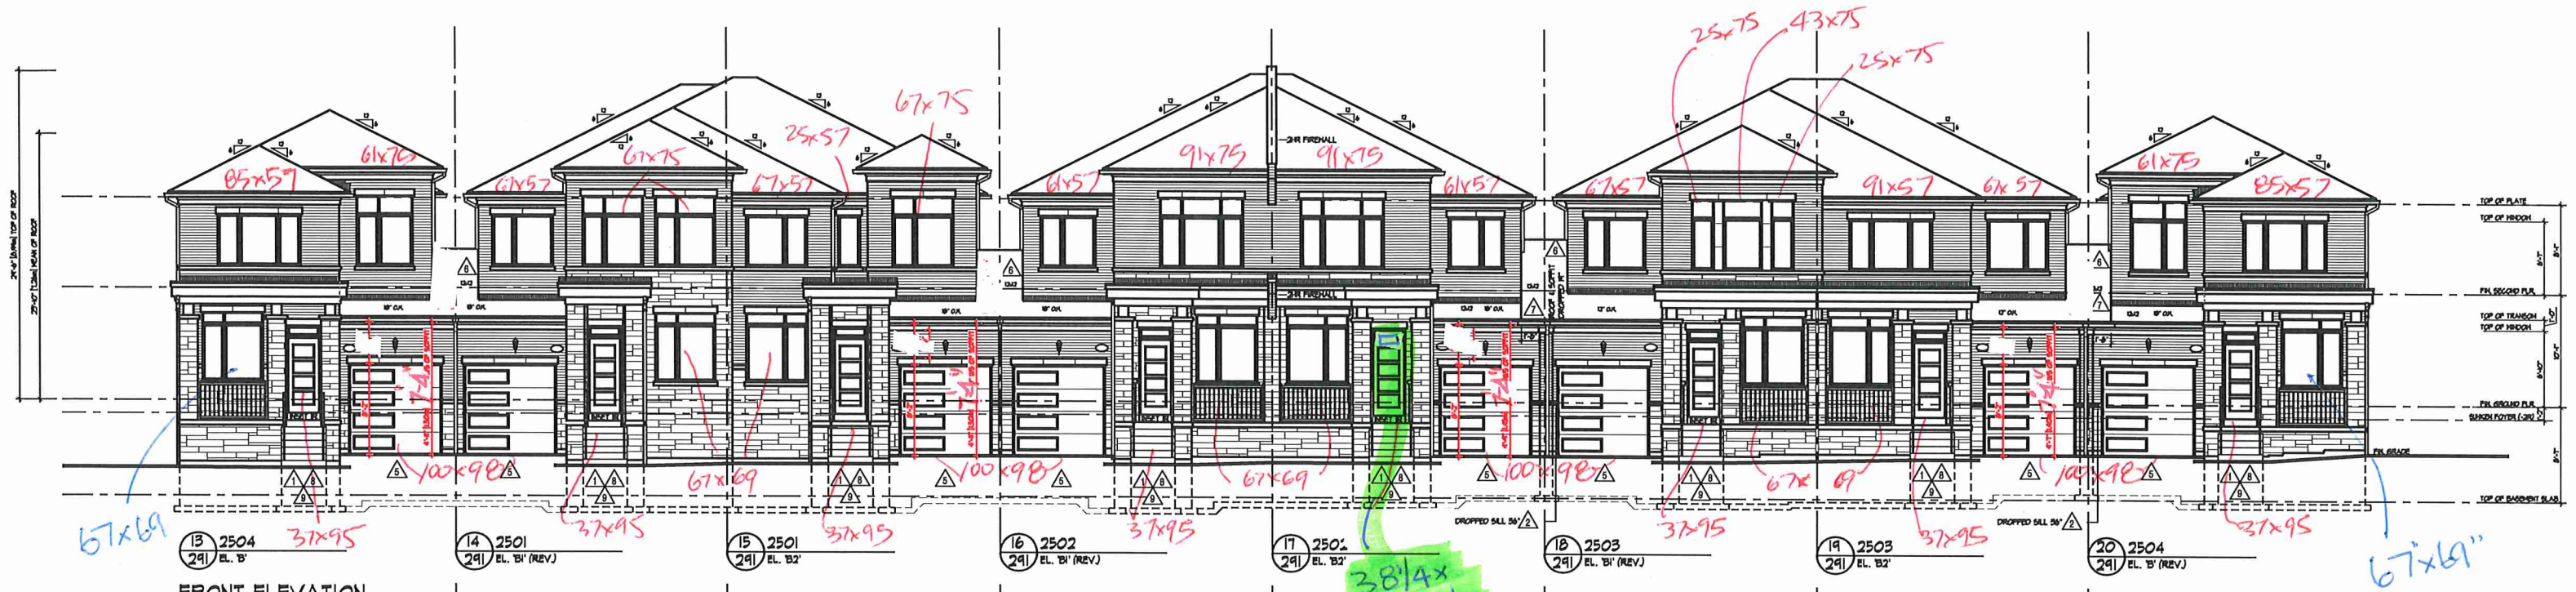

FRONT ELEVATION



REAR ELEVATION



13 2504
29 EL. 'B'

14 2501
29 EL. 'B1' (REV.)

15 2501
29 EL. 'B2'

16 2502
29 EL. 'B1' (REV.)

FRONT ELEVATION





13 2504
291 EL. 'B' (OPT. 4 BEDROOM PLAN)

LEFT SIDE ELEVATION



20 2504
29 EL. 'B' (REV.) (OPT. 4 BEDROOM PLAN)

RIGHT SIDE ELEVATION