



Block 292



BASEMENT PLAN

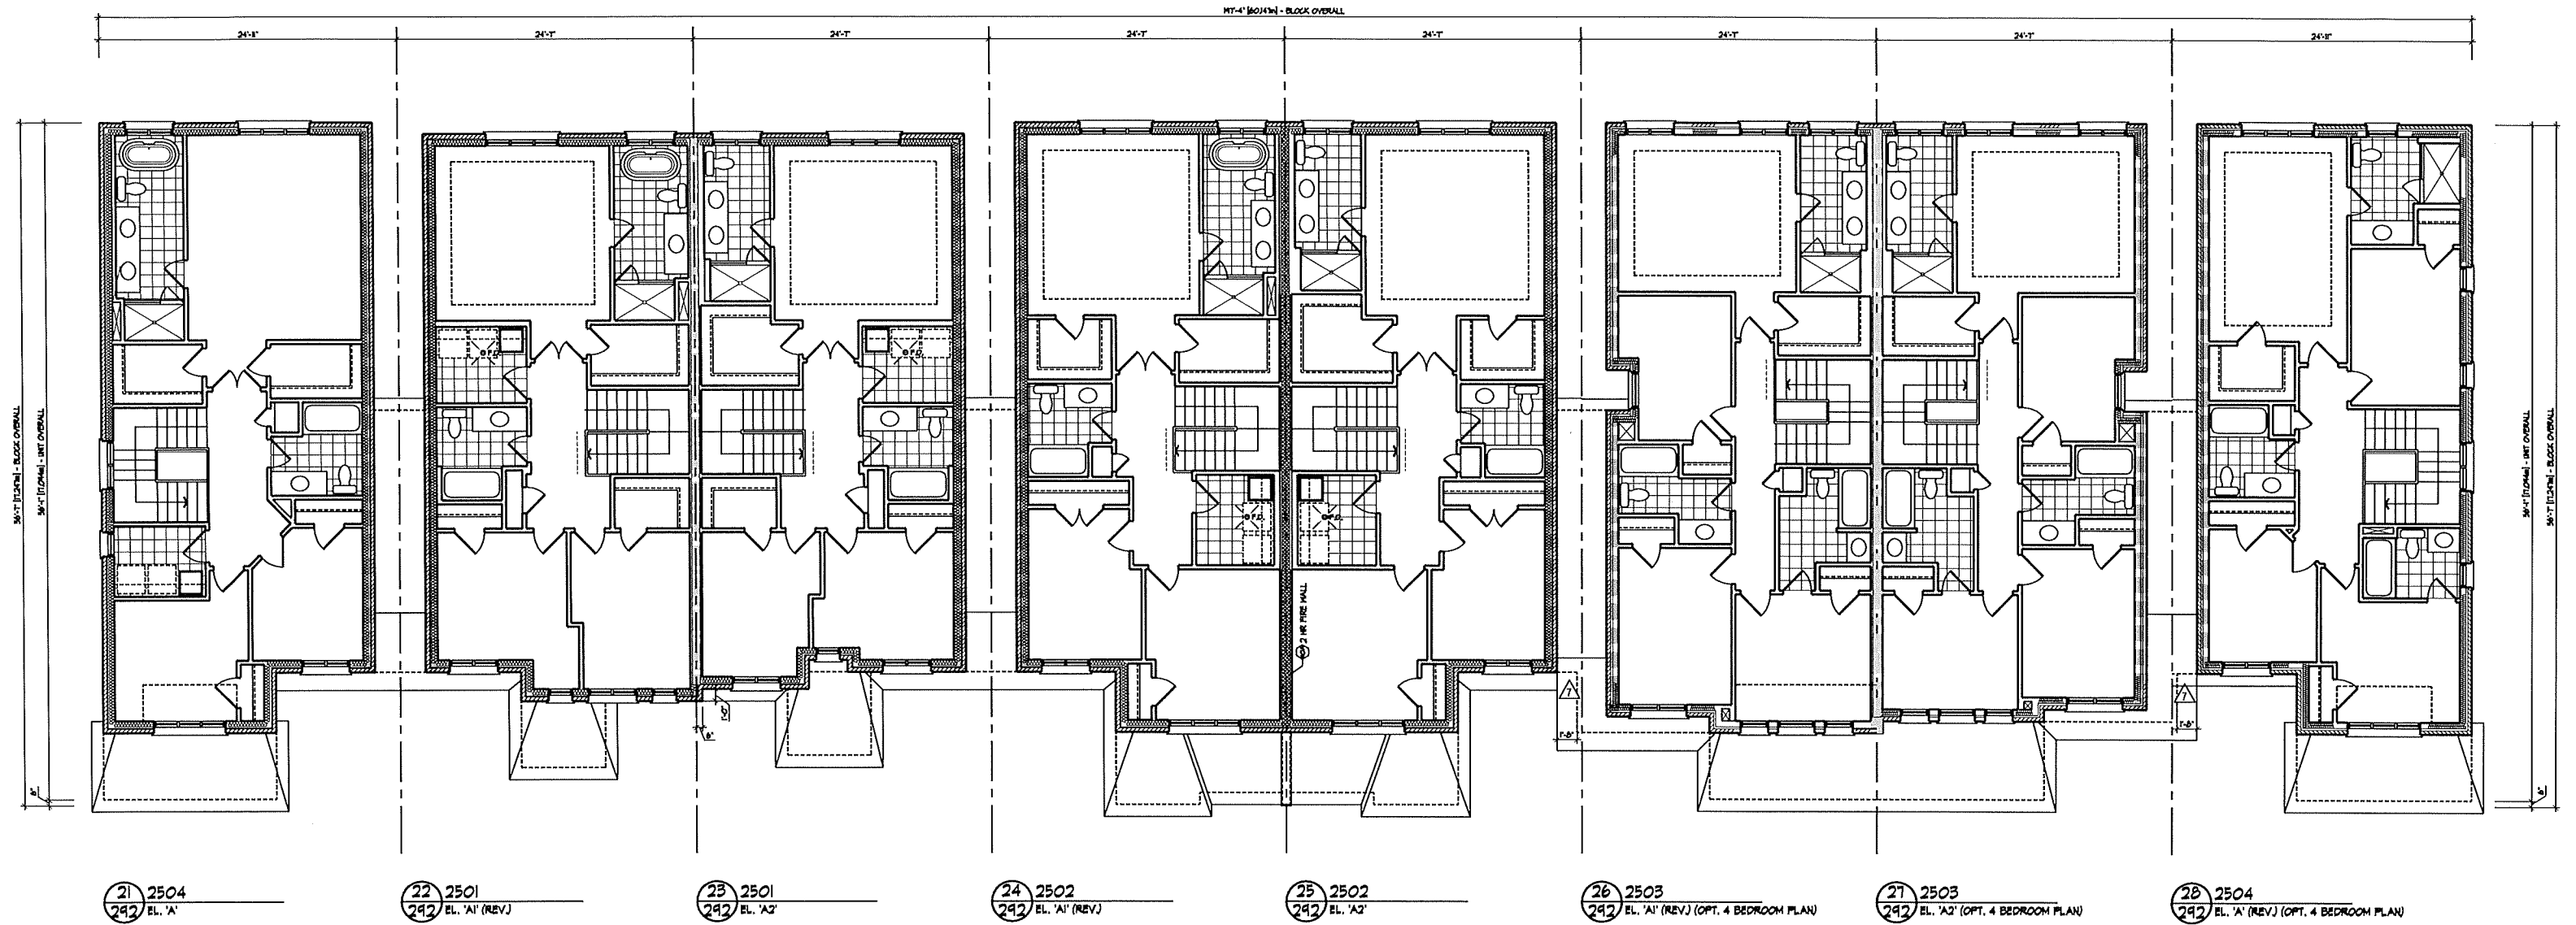

SECOND FLOOR PLAN

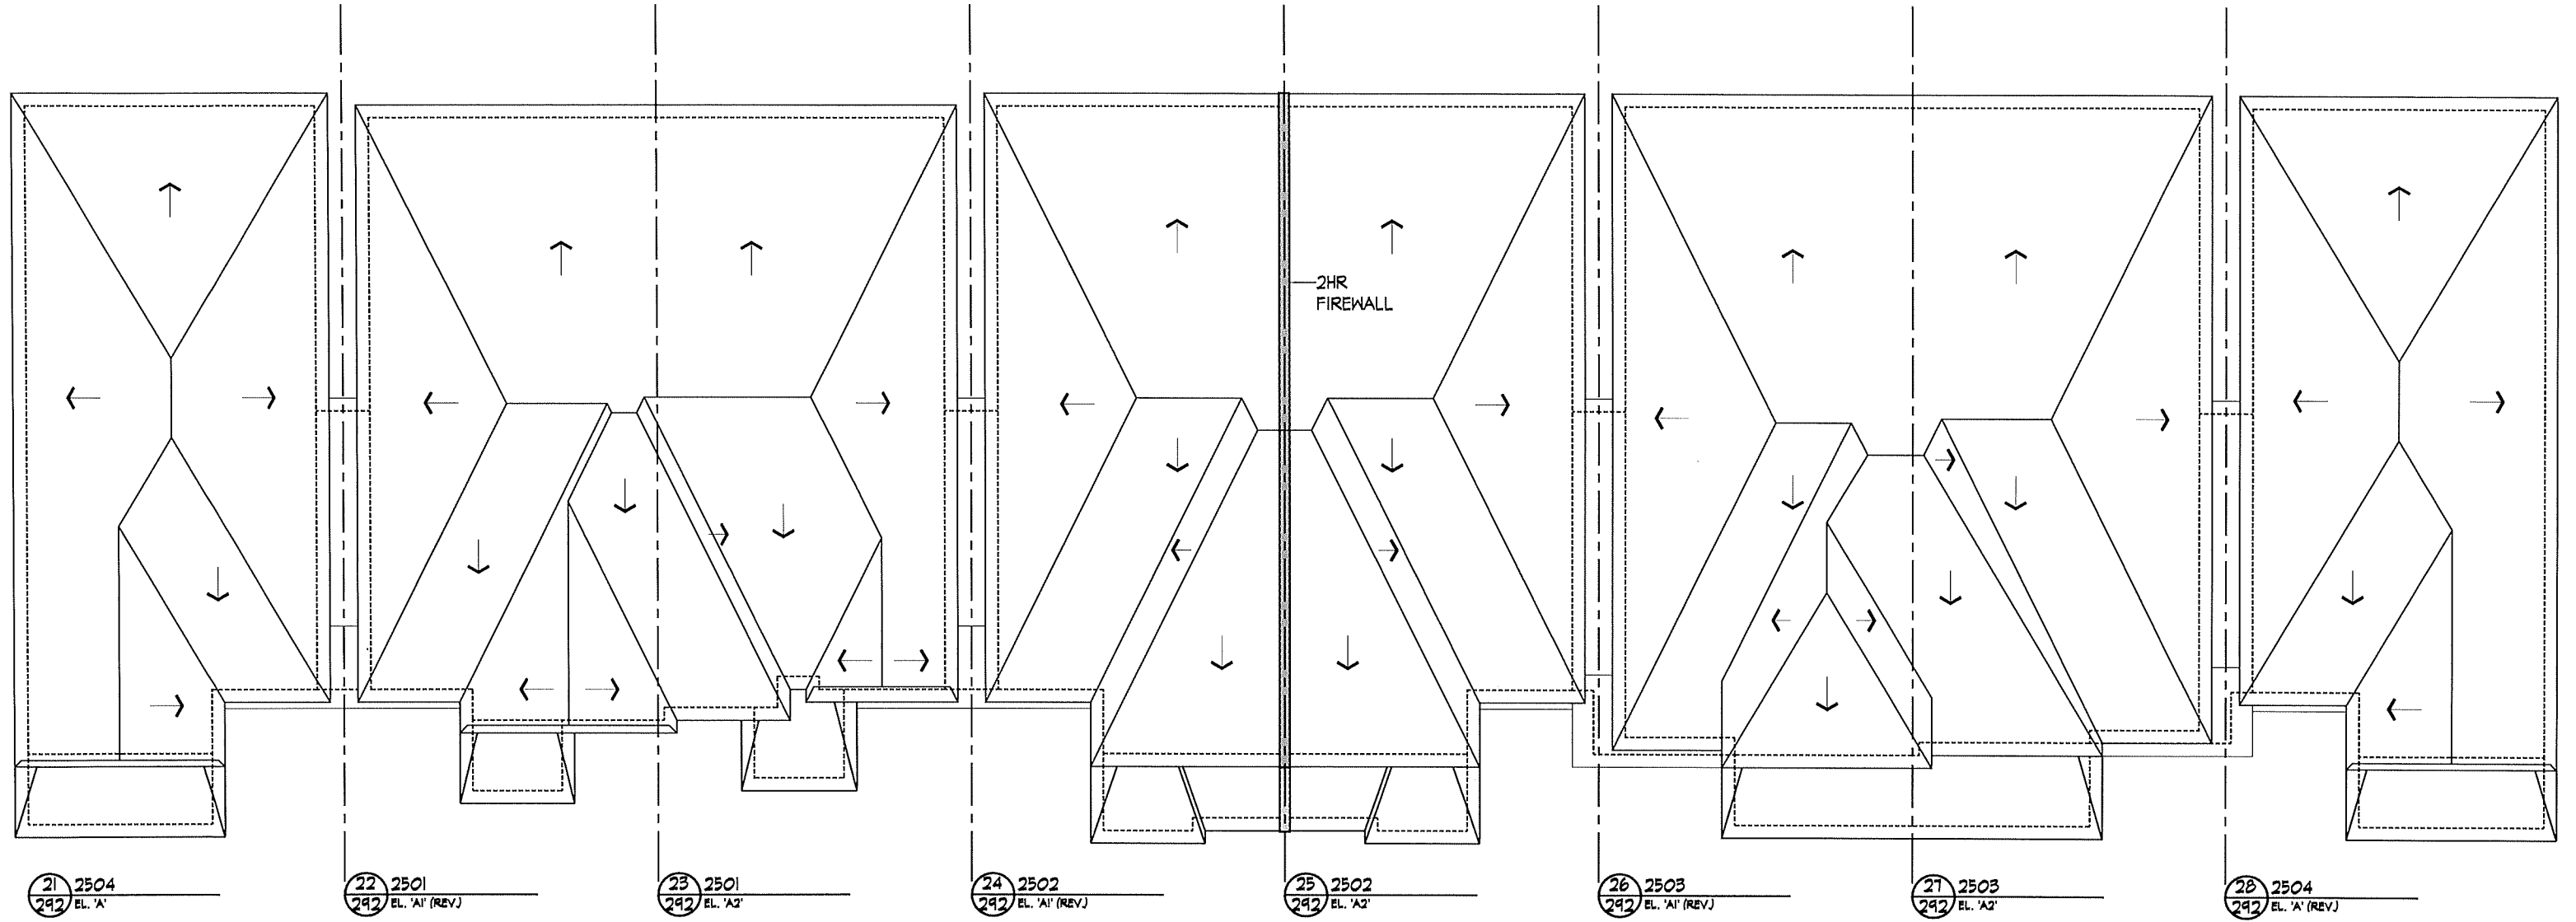

ROOF PLAN



FRONT ELEVATION




REAR ELEVATION



28 2504
 292 EL. 'A' (REV.) (OPT. 4 BEDROOM PLAN)

RIGHT SIDE ELEVATION

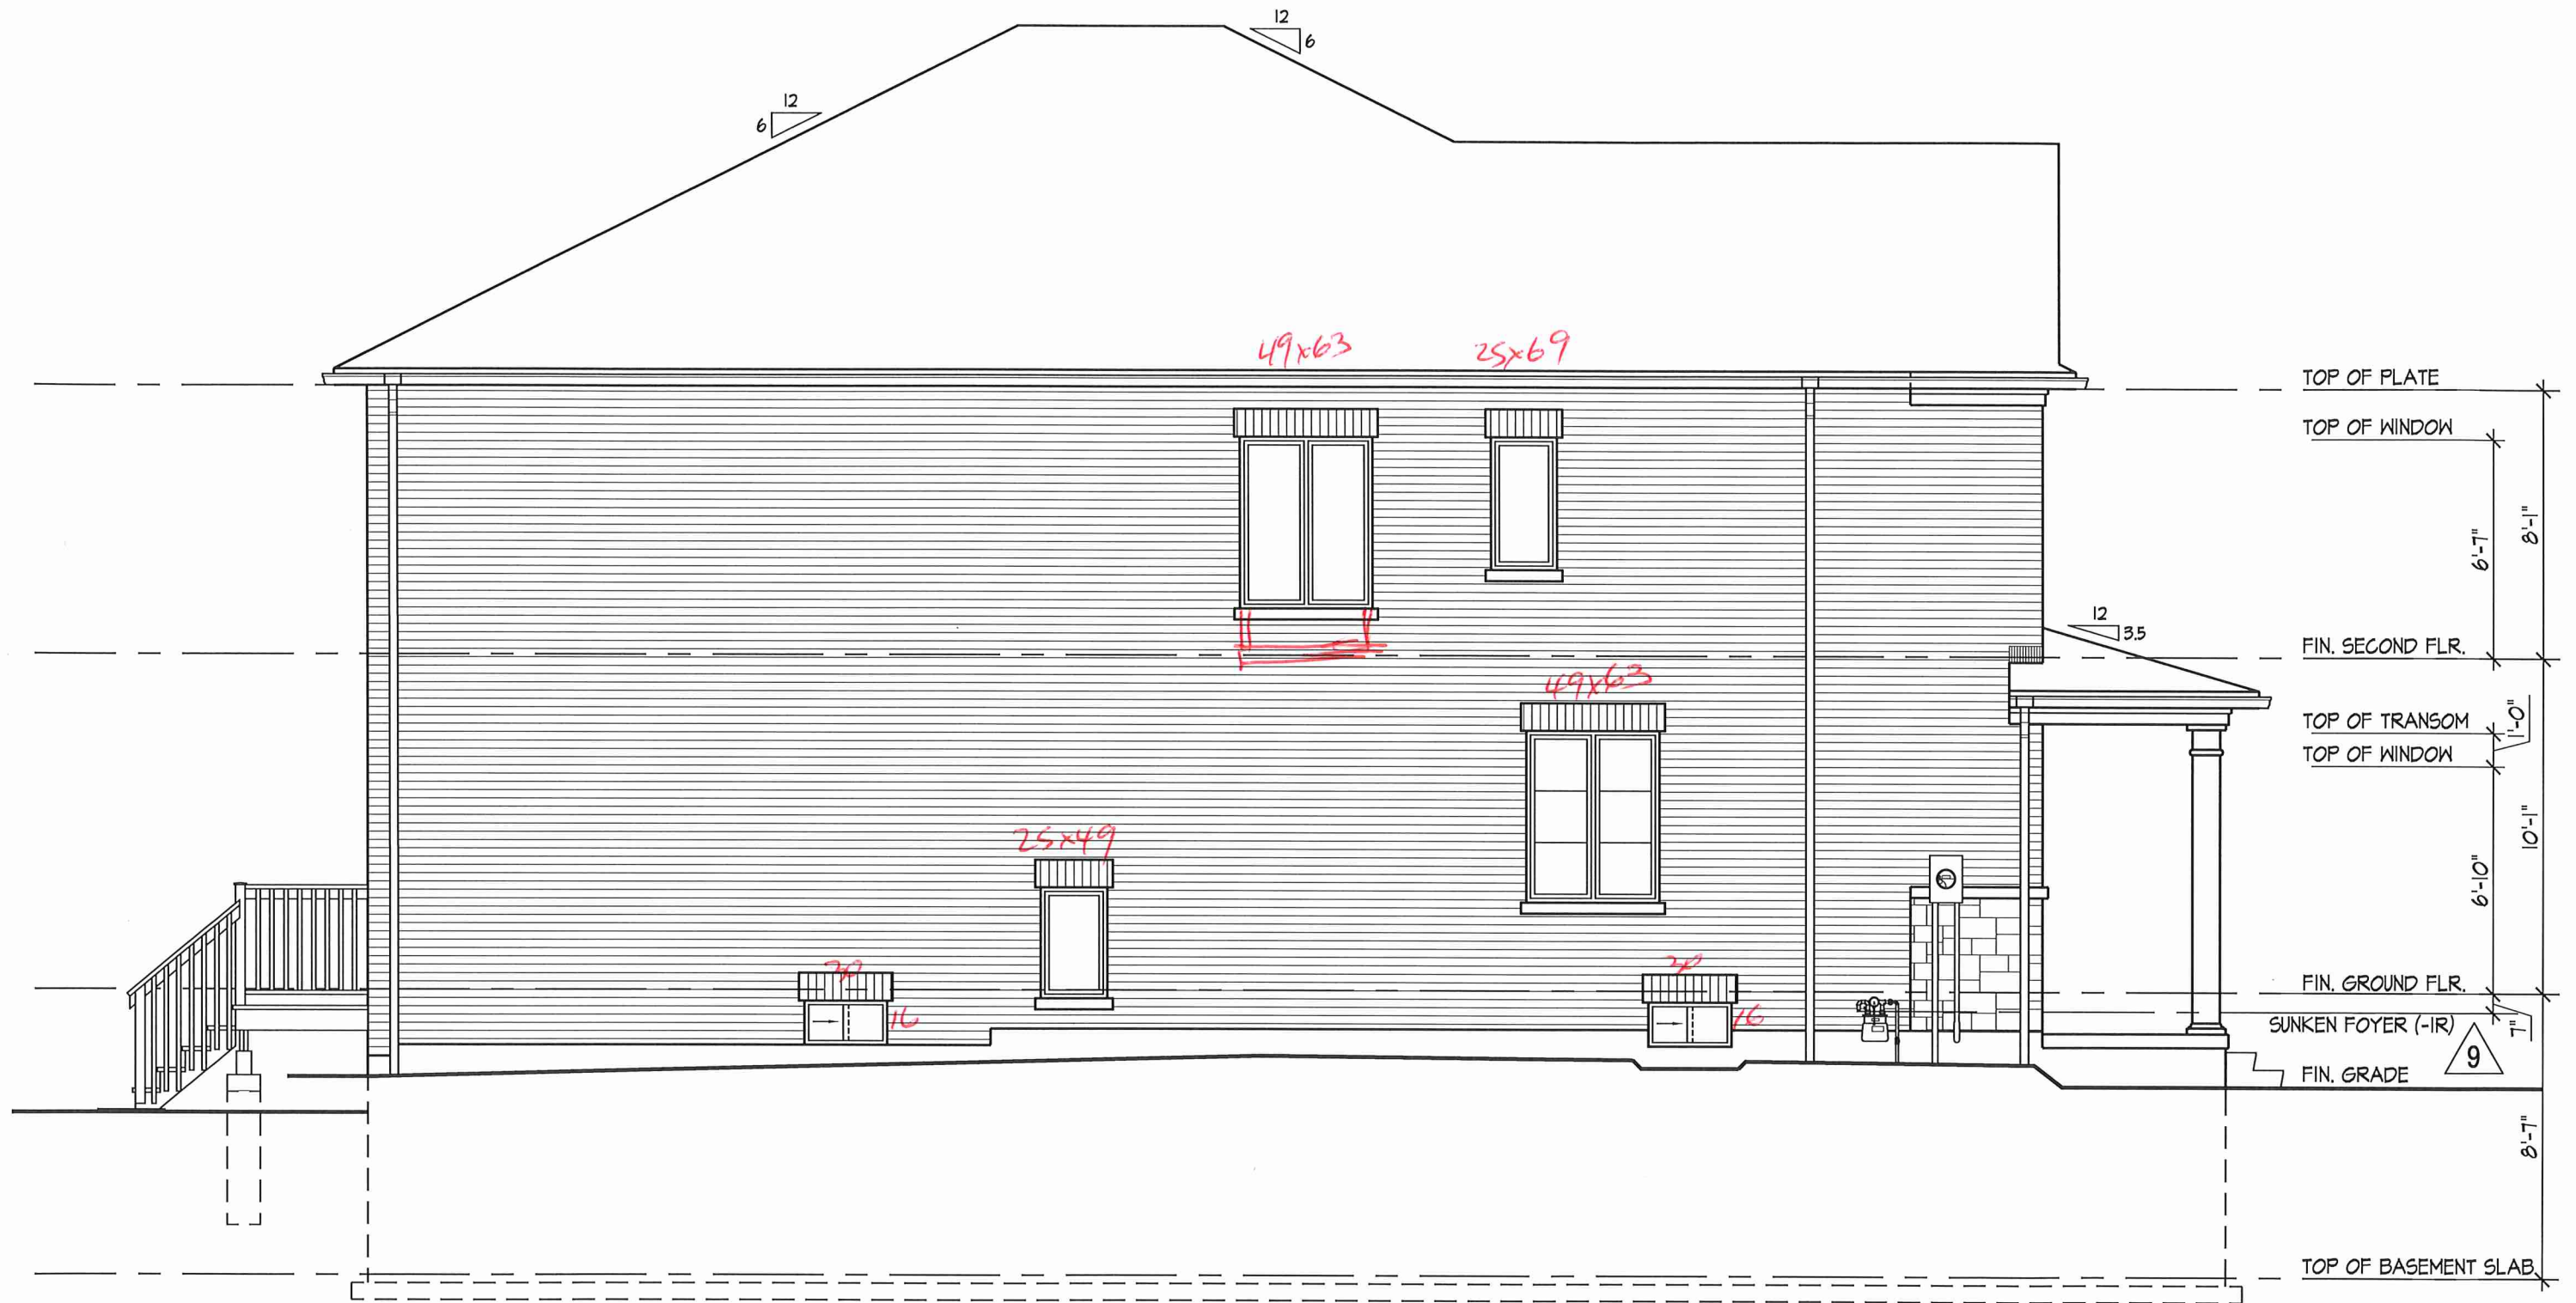

21/292 2504
EL. 'A'

LEFT SIDE ELEVATION

