



GROUND TO SECOND
122' HT 11-7/8" JOIST

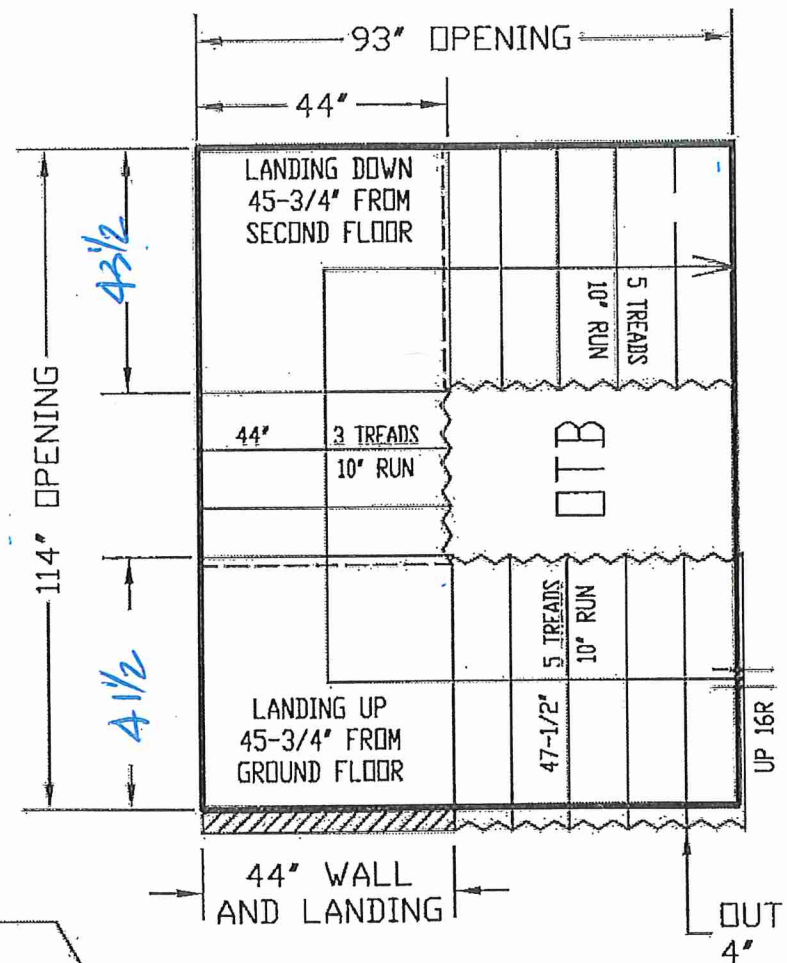

NO WALLS UNTIL
STAIRS INSTALLED

BASEMENT TO GROUND
BSMT 11-7/8" JOIST

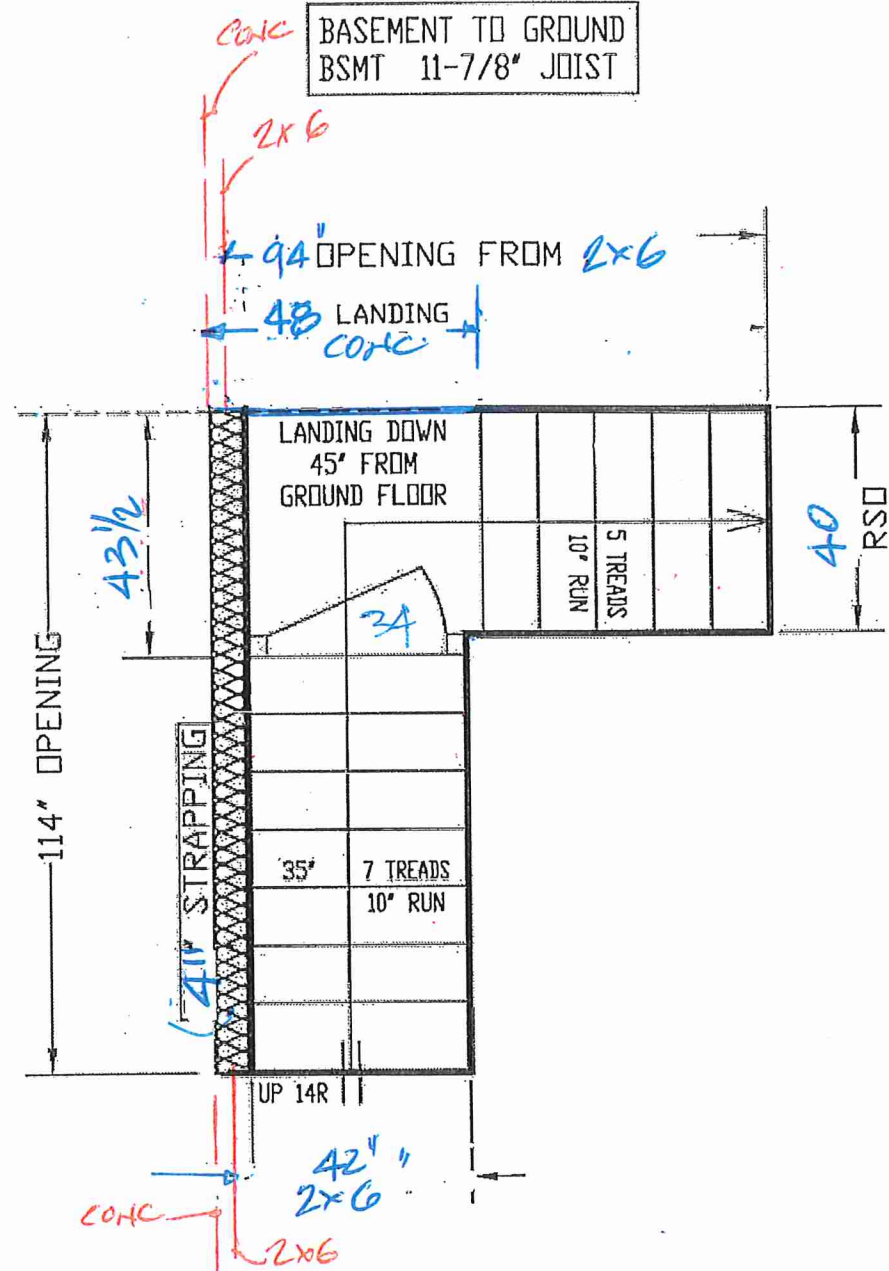


ALL OPENINGS ARE ALLOWED FOR 1 LAYER OF DRY WALL
ANY ADDITIONAL LAYERS MUST BE ALLOWED BY CARPENTERS

GARAGE RIGHT >



ALL LANDINGS TO BE SUPPLIED AND SUPPORTED BY OTHERS UNLESS SPECIFIED ABOVE
ANY STRAPPING ALLOWANCES TO BE COMPENSATED BY CARPENTERS
ALL STAIR DIMENSIONS MAY BE MODIFIED FROM ORIGINAL BLUE PRINTS OR SPECS AS SUPPLIED TO ALPA STAIRS AND RAILINGS INC. MEASUREMENTS SHOWN ON LAYOUTS ARE REQUIRED TO INSTALL OUR STAIRS. ANY PROBLEM WITH HEADROOM OR STRAPPING ALLOWANCES, ALPA STAIRS AND RAILINGS INC. WILL NOT BE RESPONSIBLE. STAIR LAYOUTS SHOULD BE CHECKED BY CARPENTERS OR SITE SUPERS TO MAKE SURE THERE ARE NO DISCREPANCIES BEFORE PROCEEDING WITH CONSTRUCTION.


ALPA STAIRS AND RAILINGS INC.
3770 NASHUA DRIVE, UNIT 3 MISSISSAUGA, ONTARIO L4V 1M6
TEL: (905) 694-9556 | www.alpastairs.com

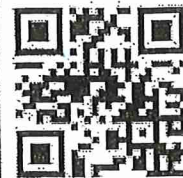

SITE	MAYFIELD VILLAGE		DRAWN BY	NAME	DATE
	LDT #		PARAMJEET JULY 10, 2024		
Model	2504 END		CLIENT SUMMER RIDGE EST. INC		
	LAYOUT #		SCALE: 1/35		

BK 292-28

- S.D. WINDOWS 96"
- INT. DOORS 83"
- ARCHES 96"
- FRONT DOOR 95"

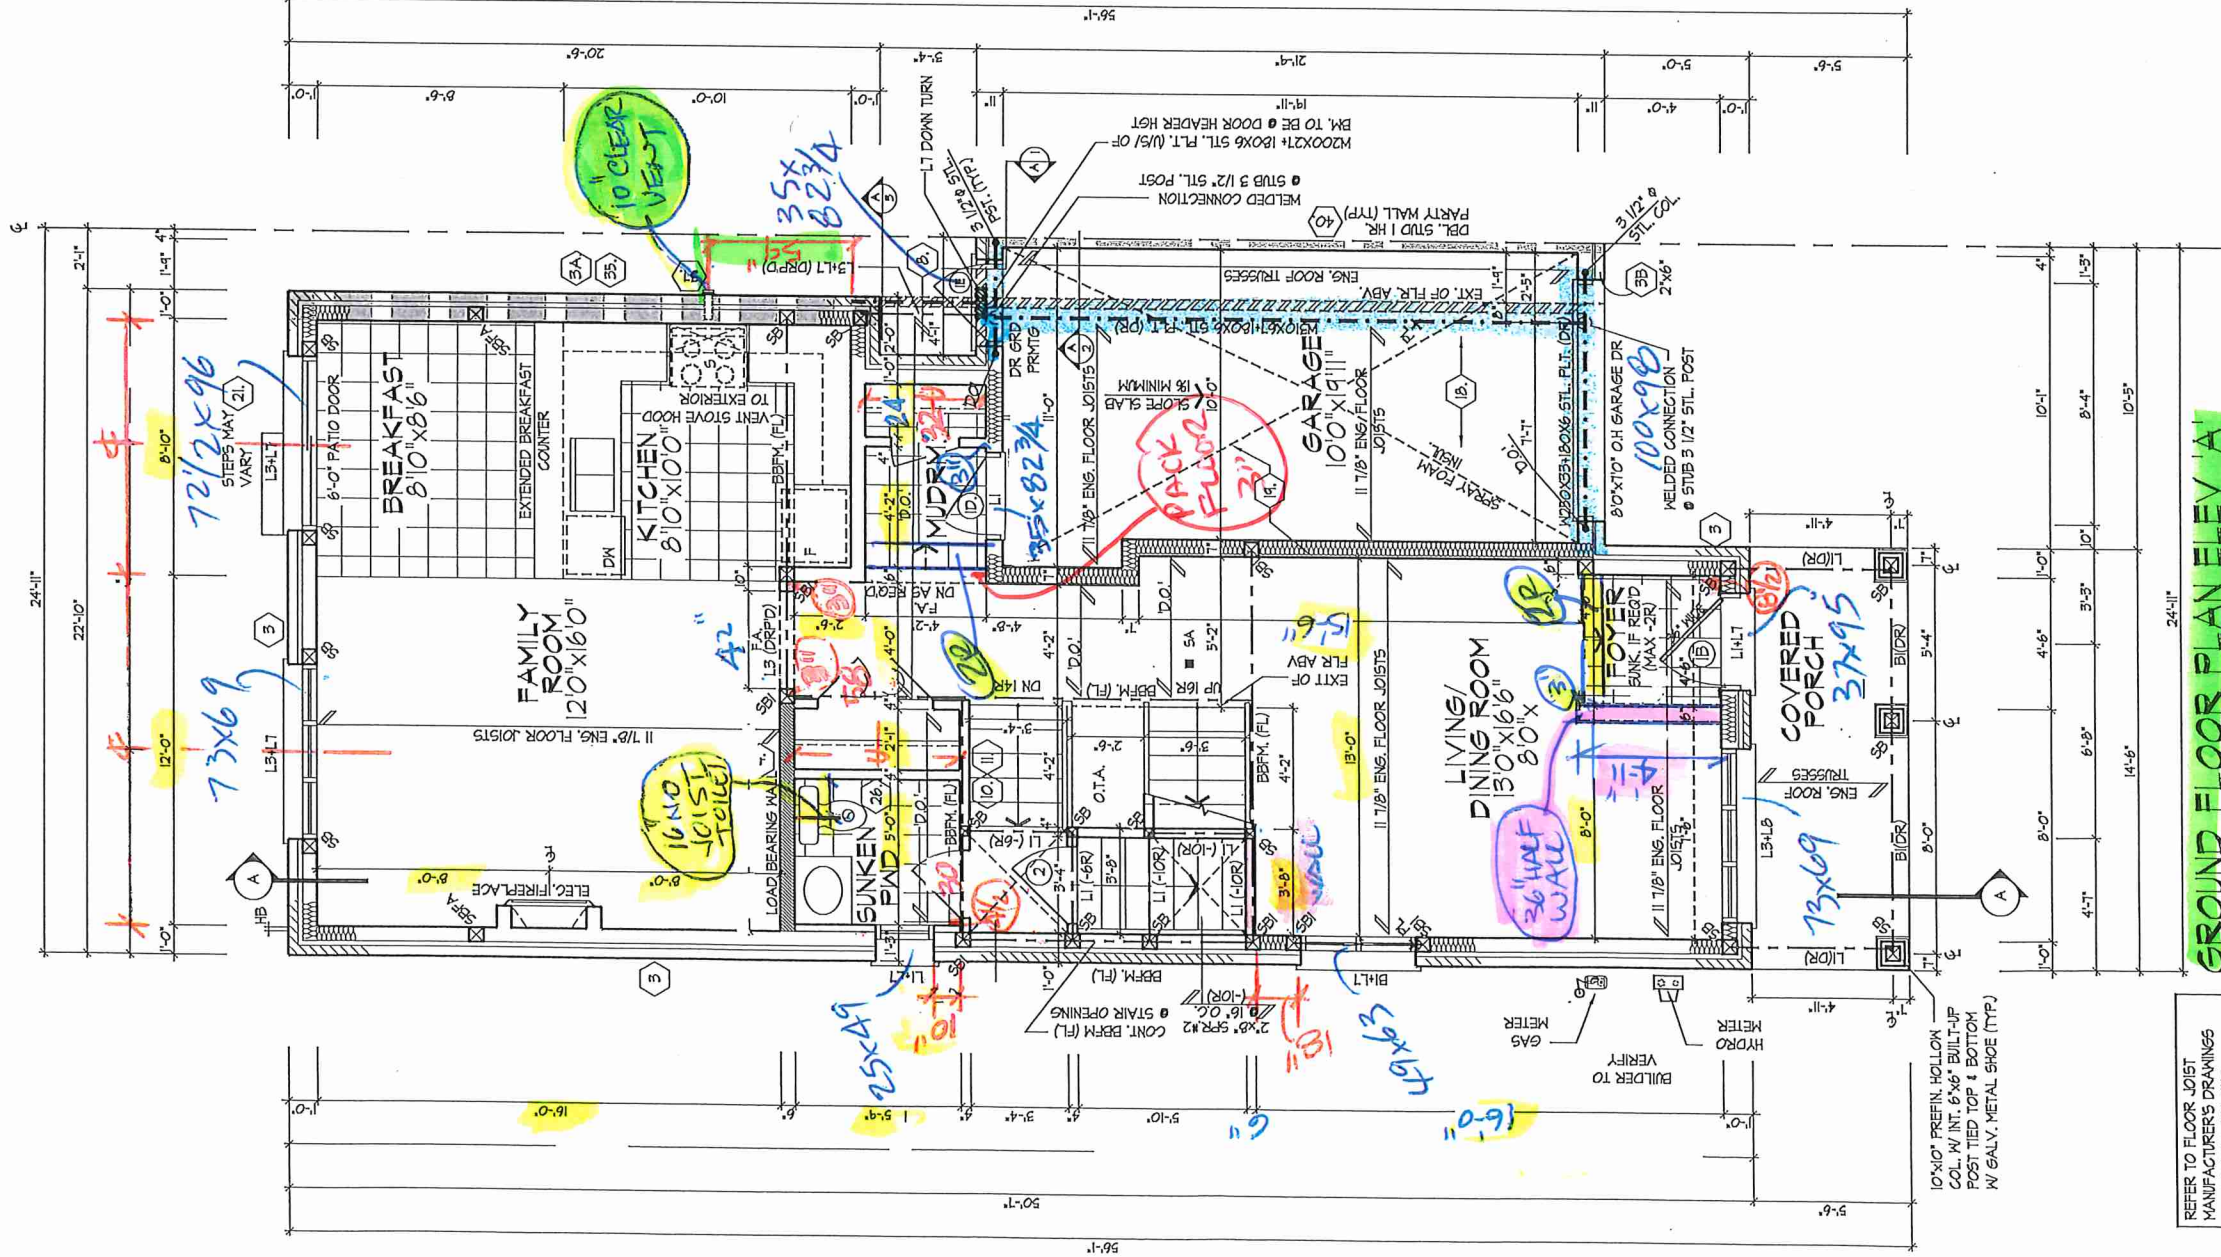


REFER TO FLOOR JOIST MANUFACTURER'S DRAWINGS FOR LAYOUT, BRACING, BLOCKING & STRAPPING REQUIREMENTS, INSTALLATION DETAILS AND HANGER SIZES, & SUBFLOOR THICKNESS

PROVIDE SOLID WOOD BLOCKING @ 24" O.C. FOR FIRST JOIST SPAN WHEN PARALLEL W/ EXTERIOR WALL


SPACE ALL FLOOR JOISTS @ 12" O.C. UNDER ALL CERAMIC TILE AREAS.

SB: MIN. 2/ 2"x6" SFF OR 3/ 2"x4" SFF
SBI: MIN. 3/ 2"x6" SFF OR 4/ 2"x4" SFF
SB2: MIN. 4/ 2"x6" SFF OR 5/ 2"x4" SFF


GROUND FLOOR PLAN ELEV 'A'

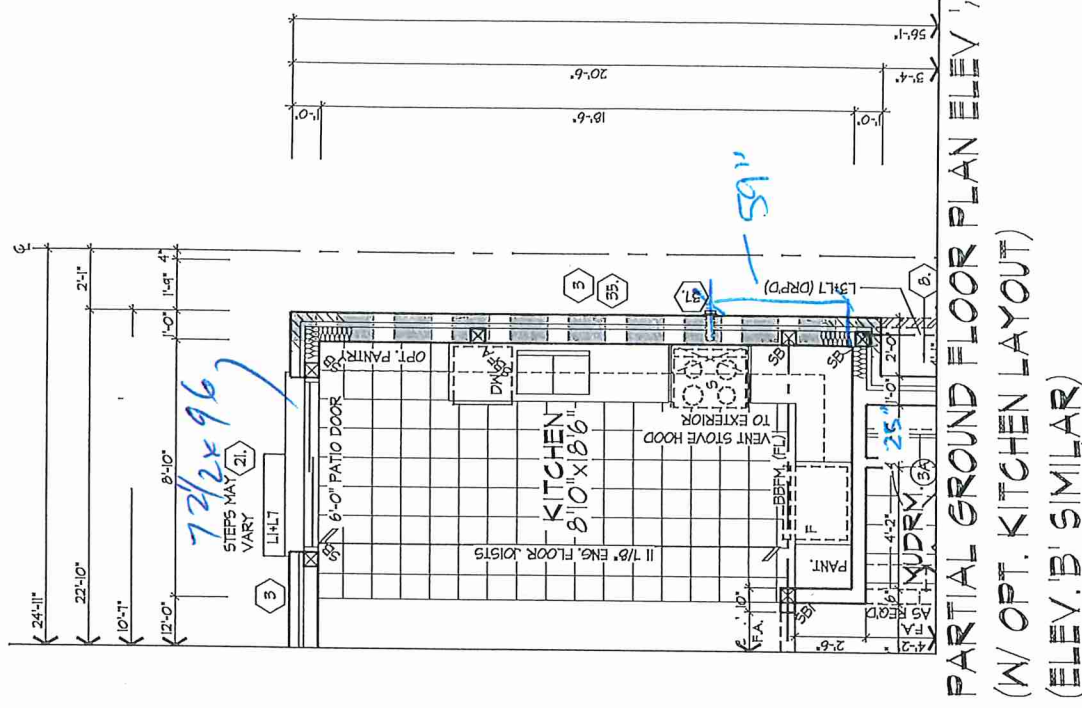


PARTIAL GROUND FLOOR PLAN ELEV 'A'
(W/ OPT. KITCHEN LAYOUT)
(ELEV. 'B' SIMILAR)

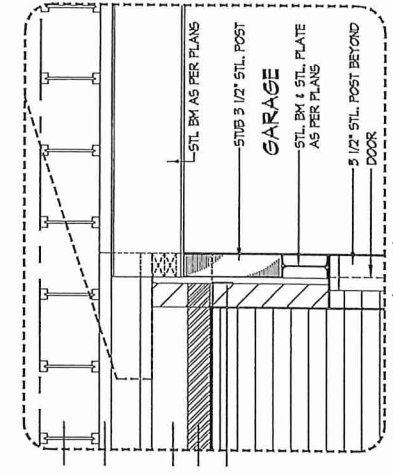

SECTION 'A-1'
N.T.S.

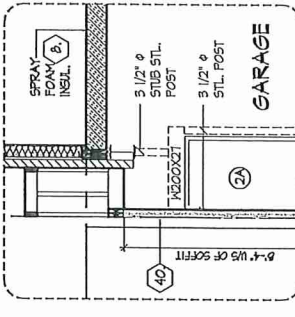

SECTION 'A-2'
N.T.S.

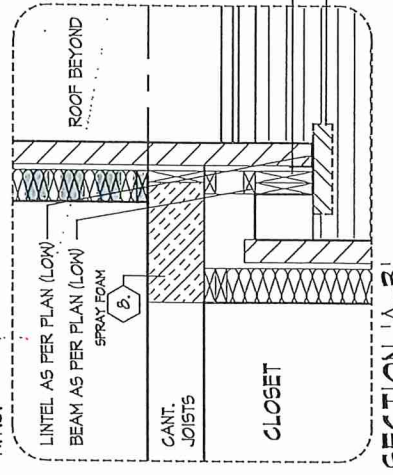


SECTION 'A-3'
N.T.S.

GROUND FLOOR PLAN ELEV 'A' WITH PARTIAL GROUND FLOOR PLAN OPT. KITCHEN LAYOUT

BK 292-28



All drawings specifications related documents and design are the copyright property of Royal Pine Homes. Reproduction of this property in whole or in part is strictly prohibited without R.P.H. written permission (R.P.H. assumes no responsibility or liability for this property unless it bears the appropriate BCIN number and original signature).

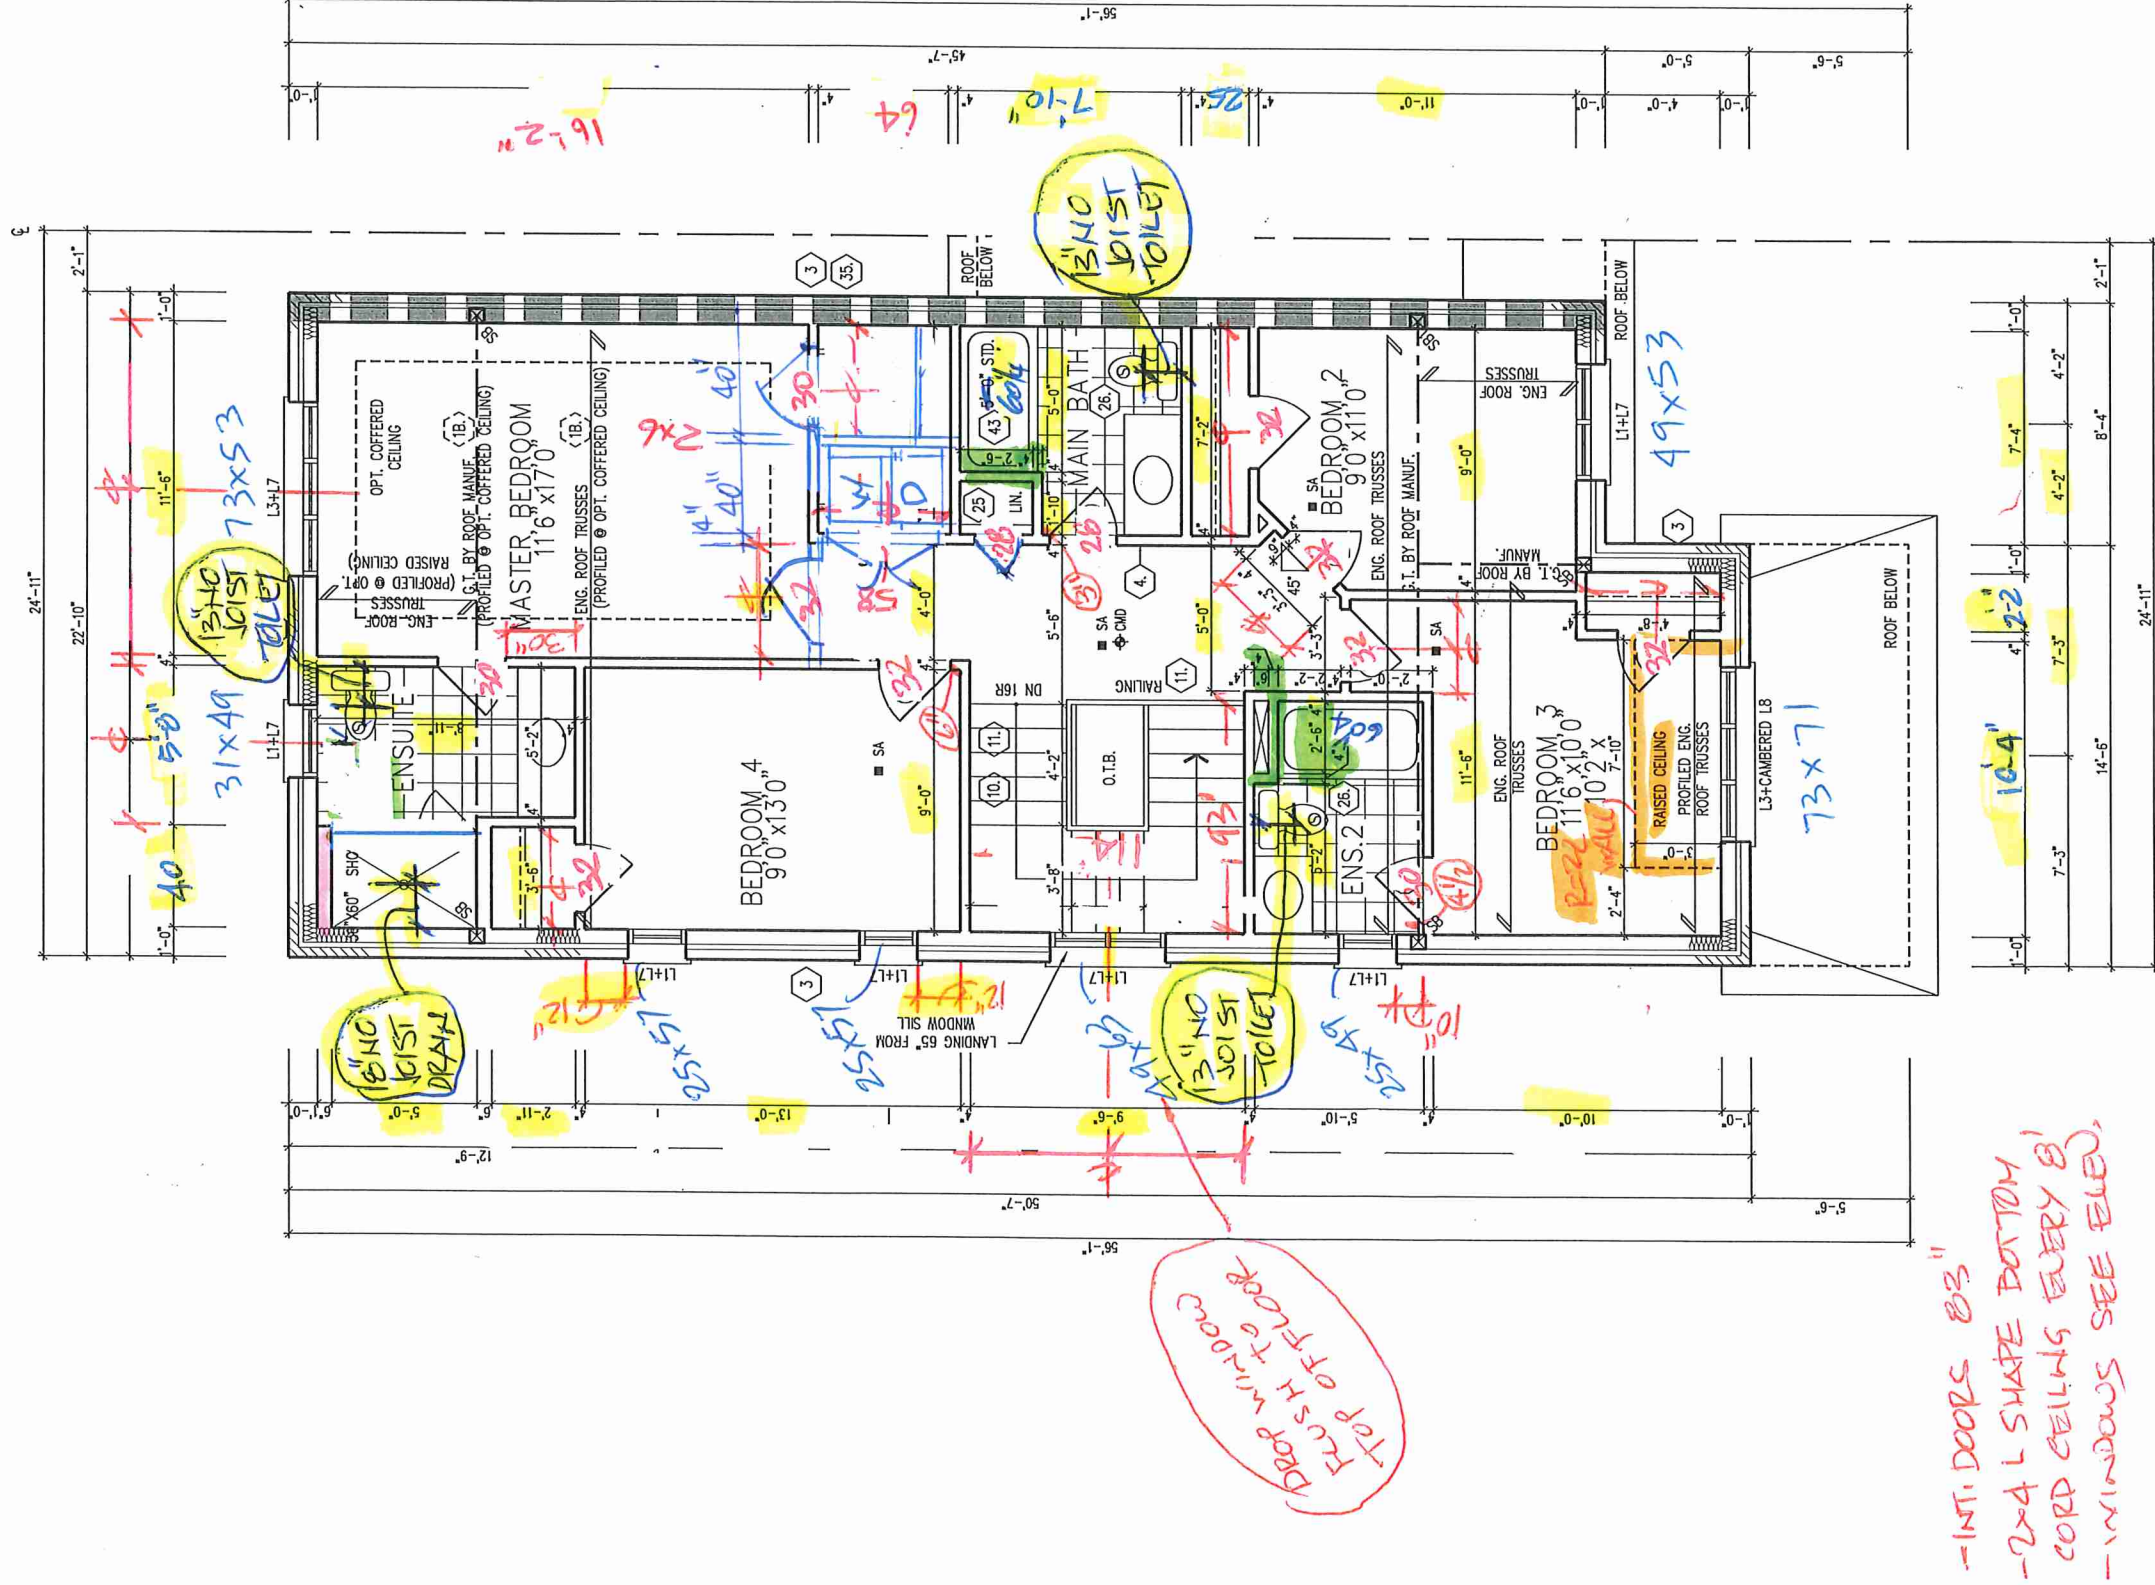

-INT. DOORS 83"
-2x4 L SHAPE BOTTOM
-CORP CEILINGS EVERY 8'
-WINDOWS SEE ELEV.

SR: MIN. 2/ 2"x6" SPF OR 3/ 2"x4" SPF
SP1: MIN. 3/ 2"x6" SPF OR 4/ 2"x4" SPF
SP2: MIN. 4/ 2"x6" SPF OR 5/ 2"x4" SPF

Plc 292- 28




OPT. SECOND FLR PLAN ELEV 'A' (REV) (W/ 4 BEDROOM PLAN)

Royal Pine Homes/Summer Ridge Estates Inc.-216051 UNIT-2504
"MAYFIELD VILLAGE", BRAMPTON, ON. REV.2024.03.14

Drawn By: WD
Checked By: DS
Scale: 3/16"=1'-0"
File Number: 216051WS2504
Page Number: 6


3550 Langstaff Road, Suite 200 Woodbridge, Ontario, L4L 9G3
All drawings specifications related documents and design are the copyright property of Royal Pine Homes. Reproduction of this property in whole or in part is strictly prohibited without R.P.H. written permission. R.P.H. assumes no responsibility or liability for this property unless it bears the appropriate BCN number and order.

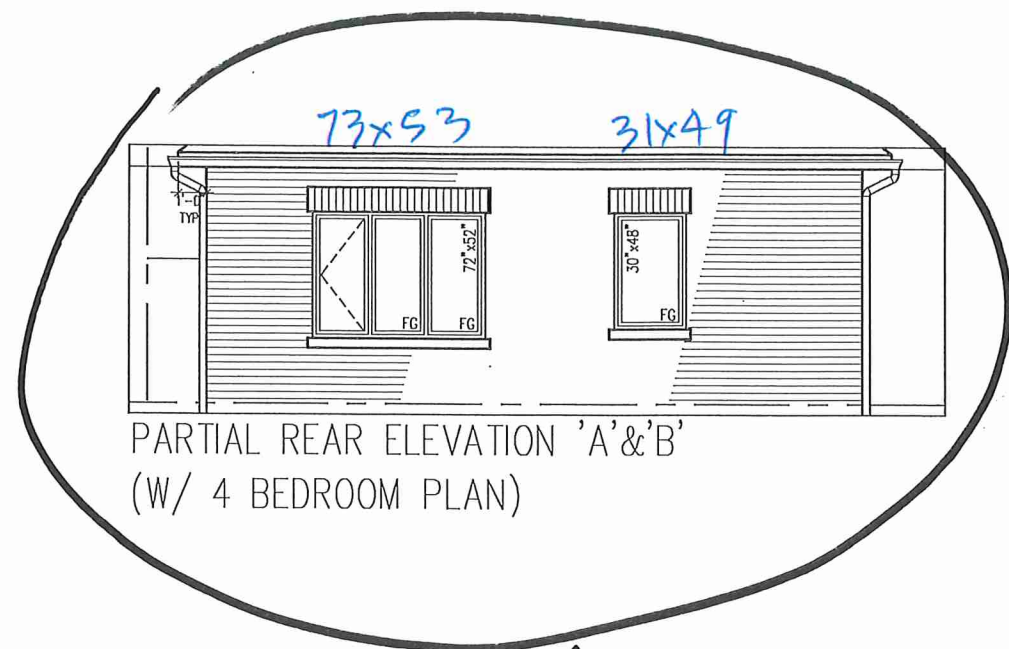

PARTIAL REAR ELEVATION 'A' & 'B'
(W/ 4 BEDROOM PLAN)


GARAGE ROOF
18'0" H

ROOF PLAN
ELEV. 'A'
N.T.S.

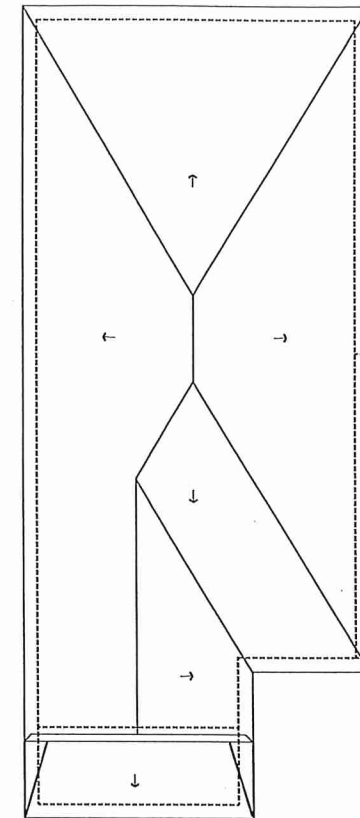

6" OVERHANGS

ROOF OVERHANGS TO BE 12"
UNLESS NOTED OTHERWISE

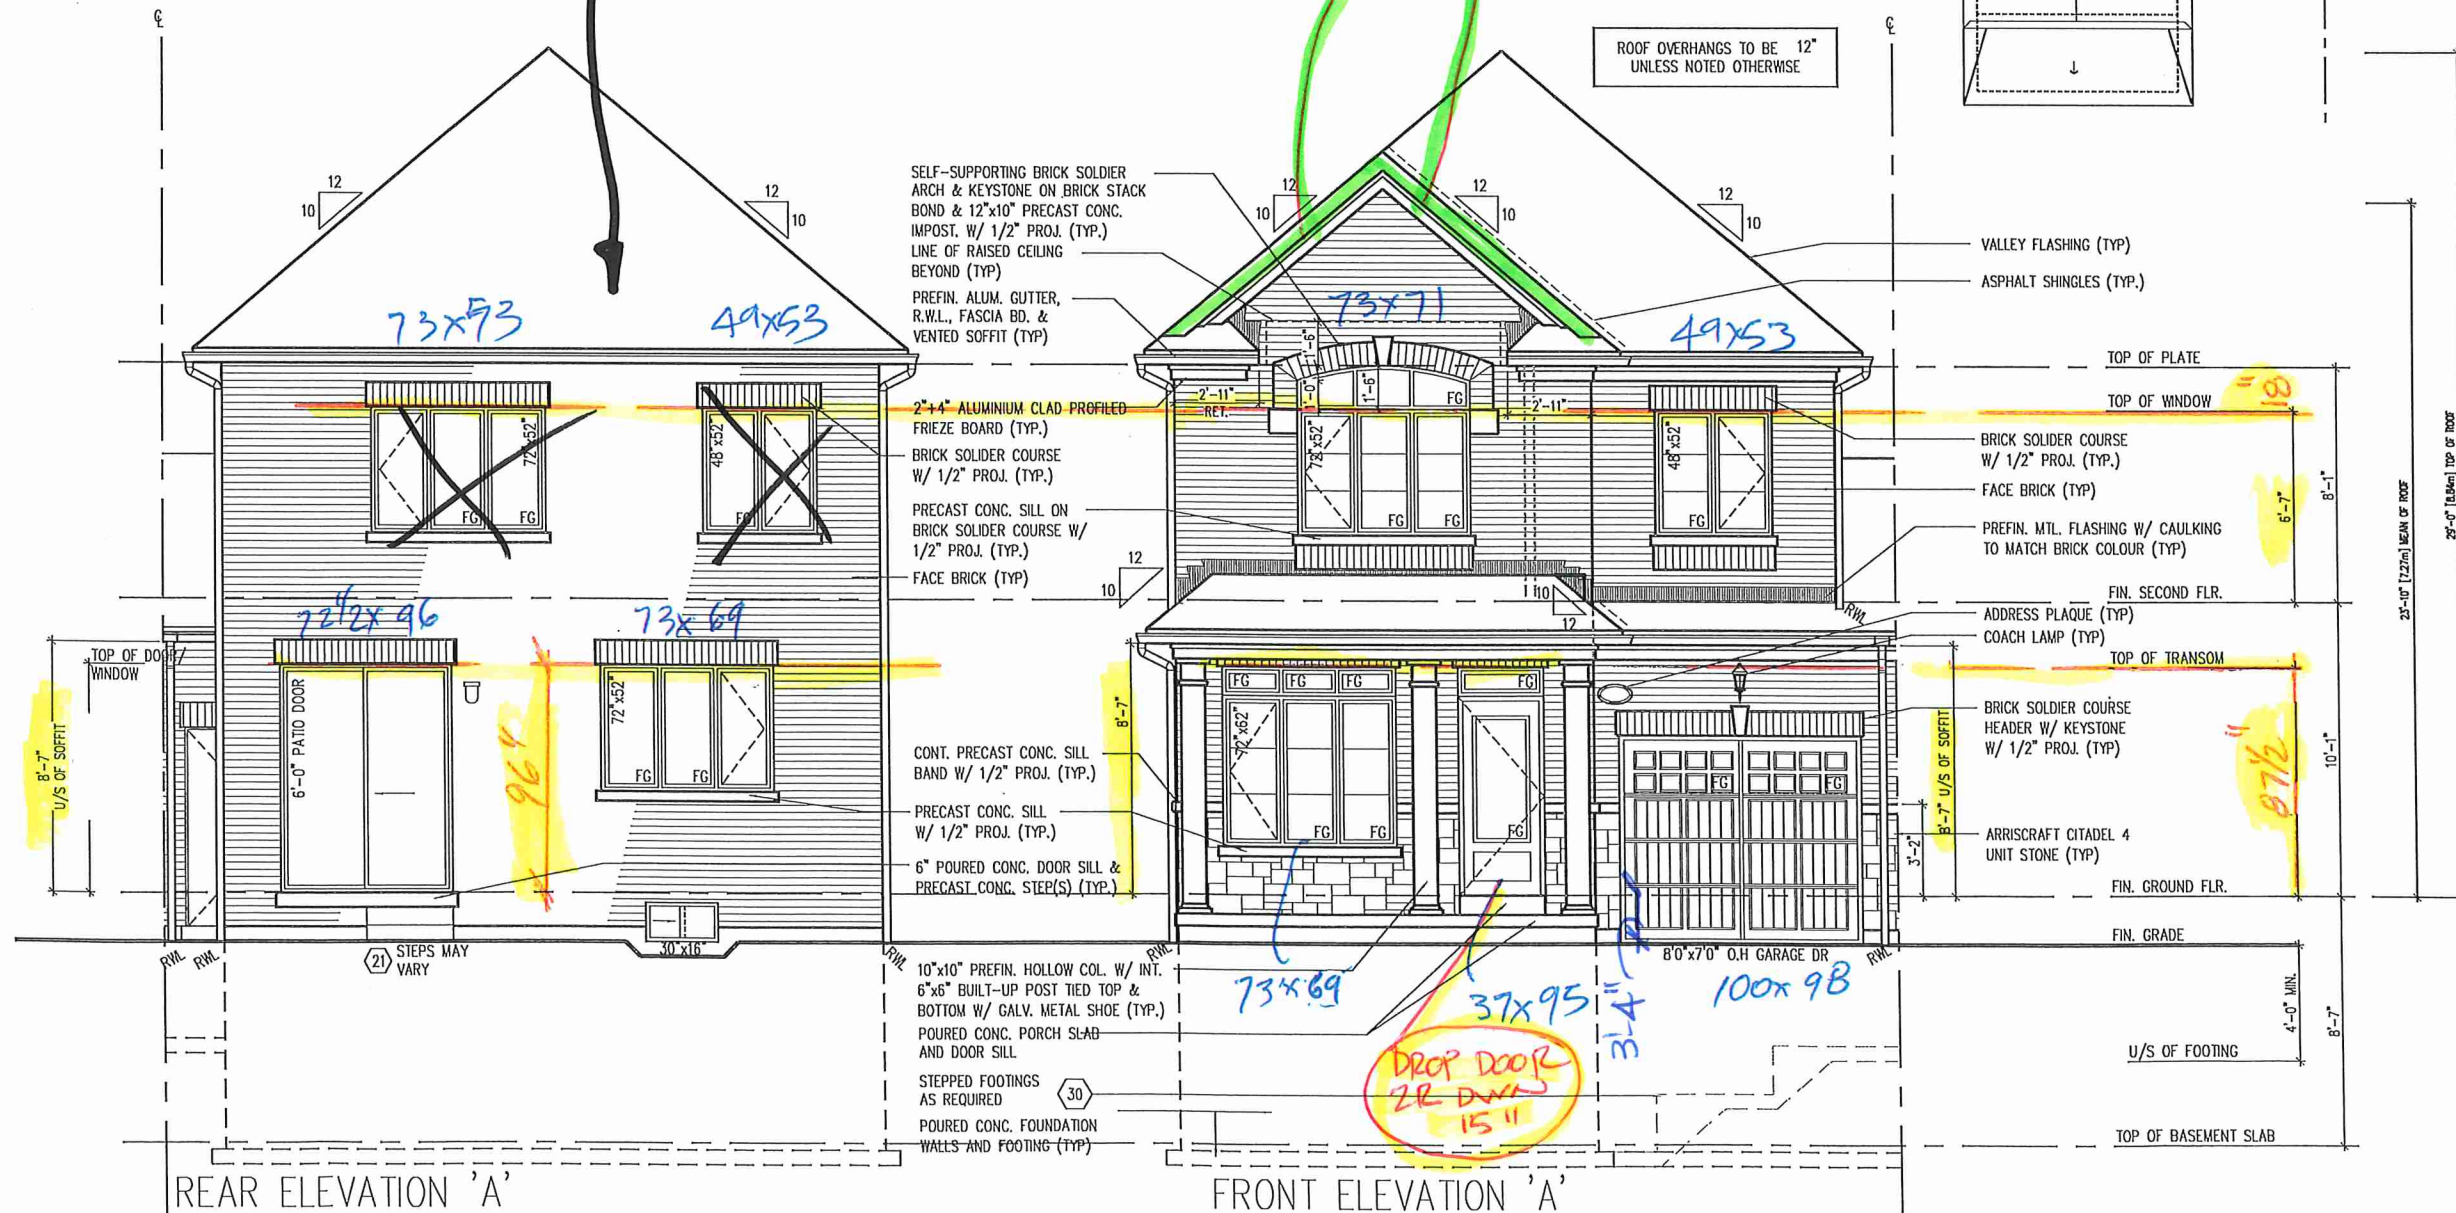

REAR ELEVATION 'A'

FRONT ELEVATION 'A'

FRONT AND REAR ELEVATION A

Royal Pine Homes/Summer Ridge Estates Inc.-216051 UNIT-2504
"MAYFIELD VILLAGE", BRAMPTON, ON. REV.2024.03.14




BLK 292-20


Drawn By: WD
Checked By: DS
Scale: 3/16"=1'-0"
File Number: 216051WS2504
Page Number: 9 of 14

3550 Langstaff Road, Suite 200 Woodbridge, Ontario, L4L 9G8
All drawings specifications related documents and design are the copyright property of Royal Pine Homes. Reproduction of this property in whole or in part is strictly prohibited without R.P.H. written permission. (R.P.H. assumes no responsibility or liability for this property unless it bears the appropriate ECIN number and original signature.)

WINDOW SUMMARY	
PER O.B.C. TABLE 4.10.15.4	
LEFT SIDE ELEVATION A	
QUANTITY	UNIT
1	24" x 48"
2	24" x 48"
3	36" x 48"
4	36" x 48"
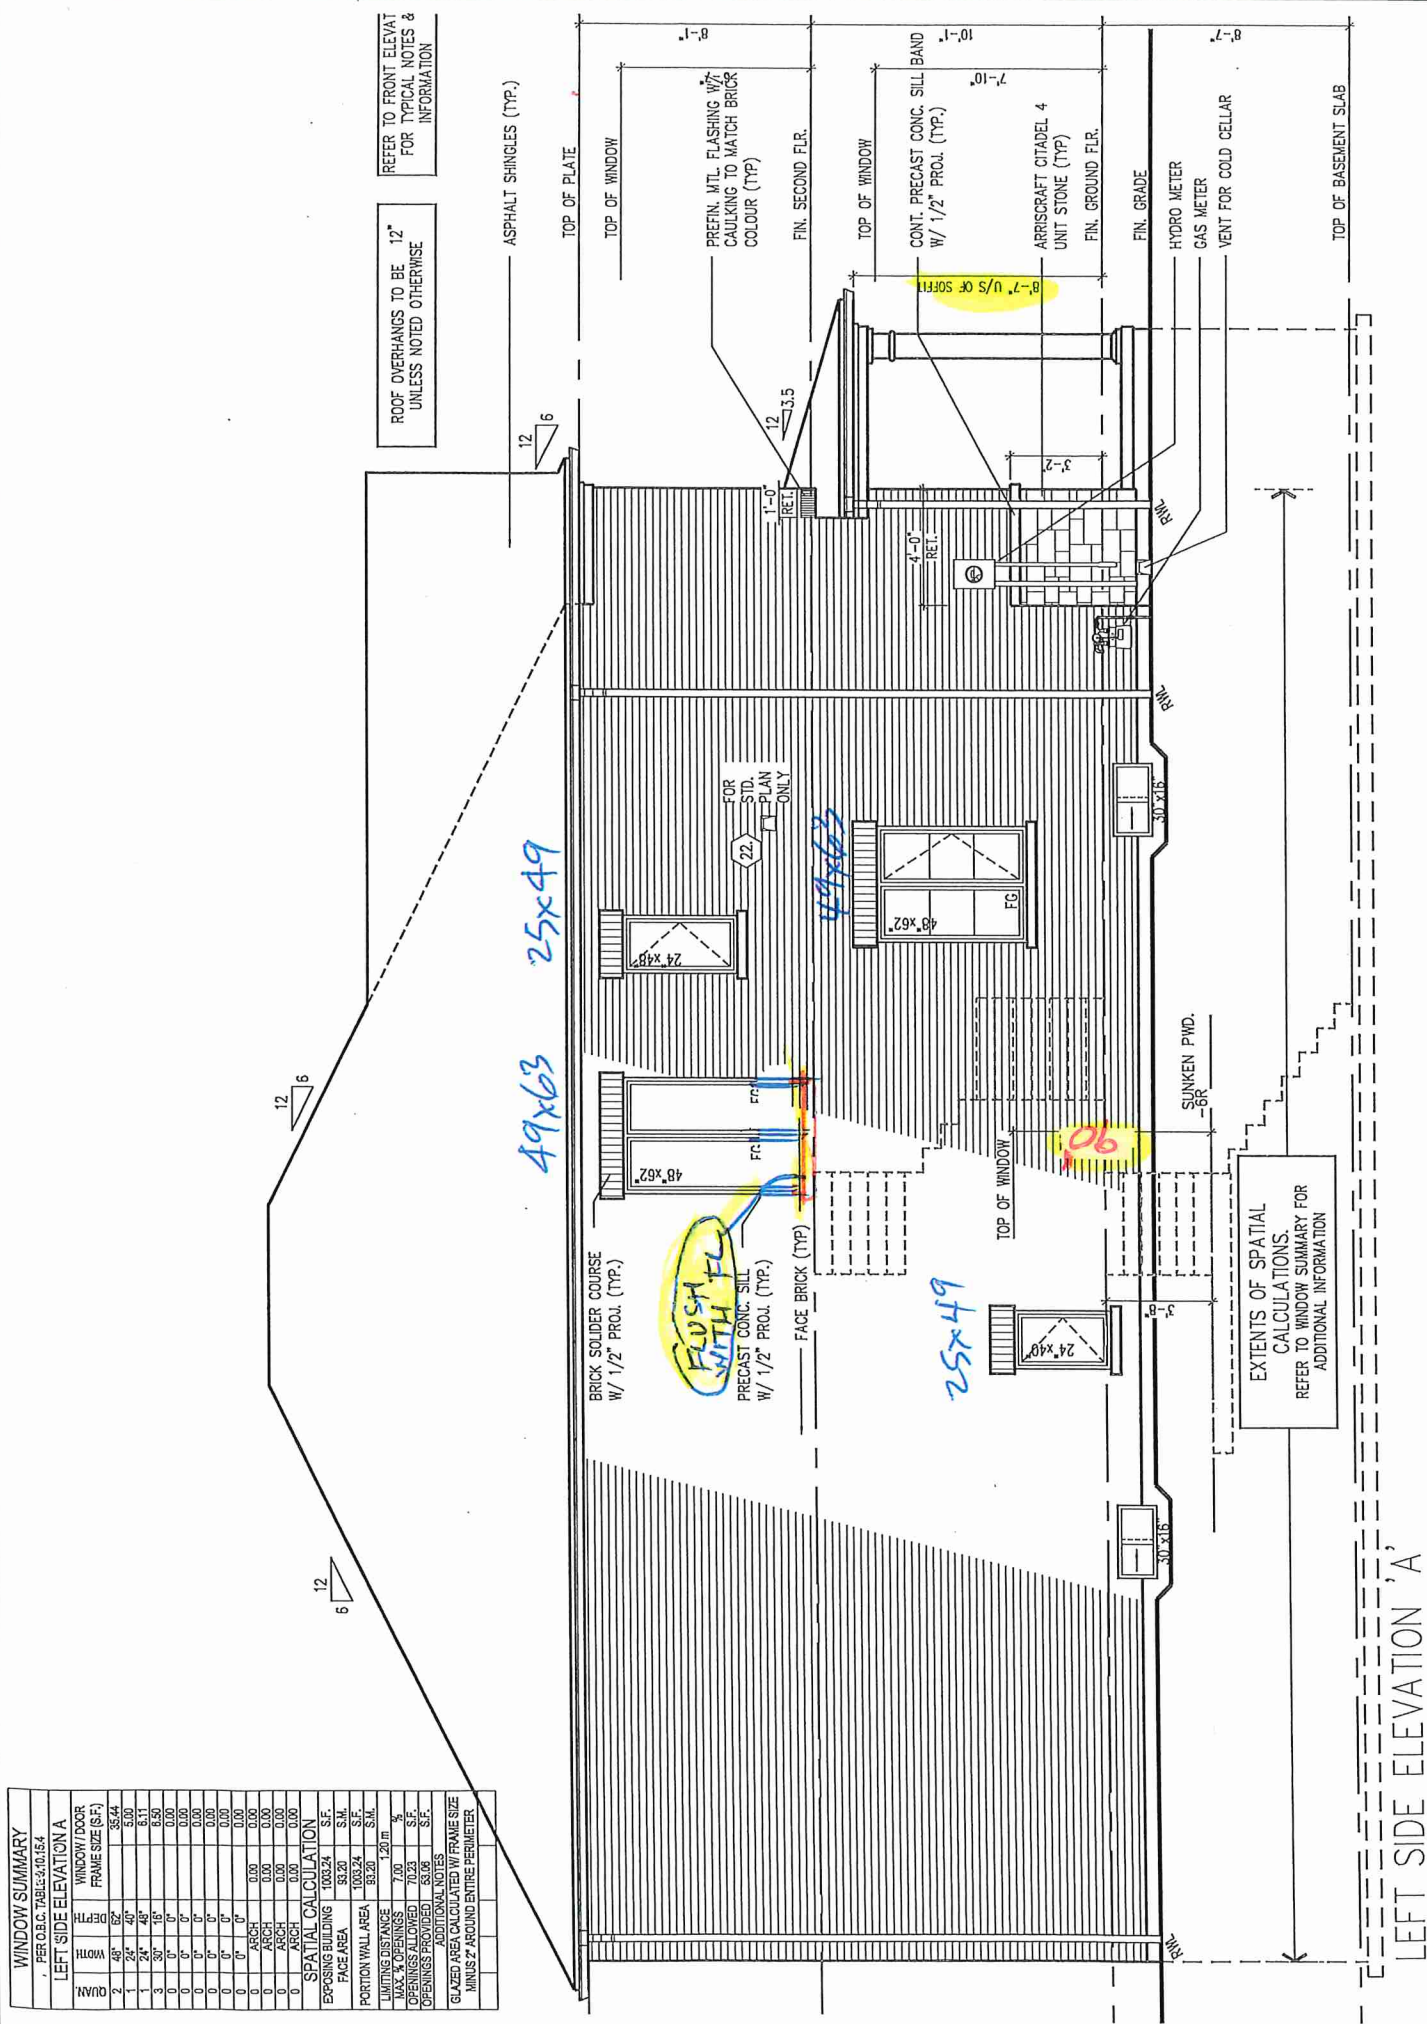

LEFT SIDE ELEVATION 'A'

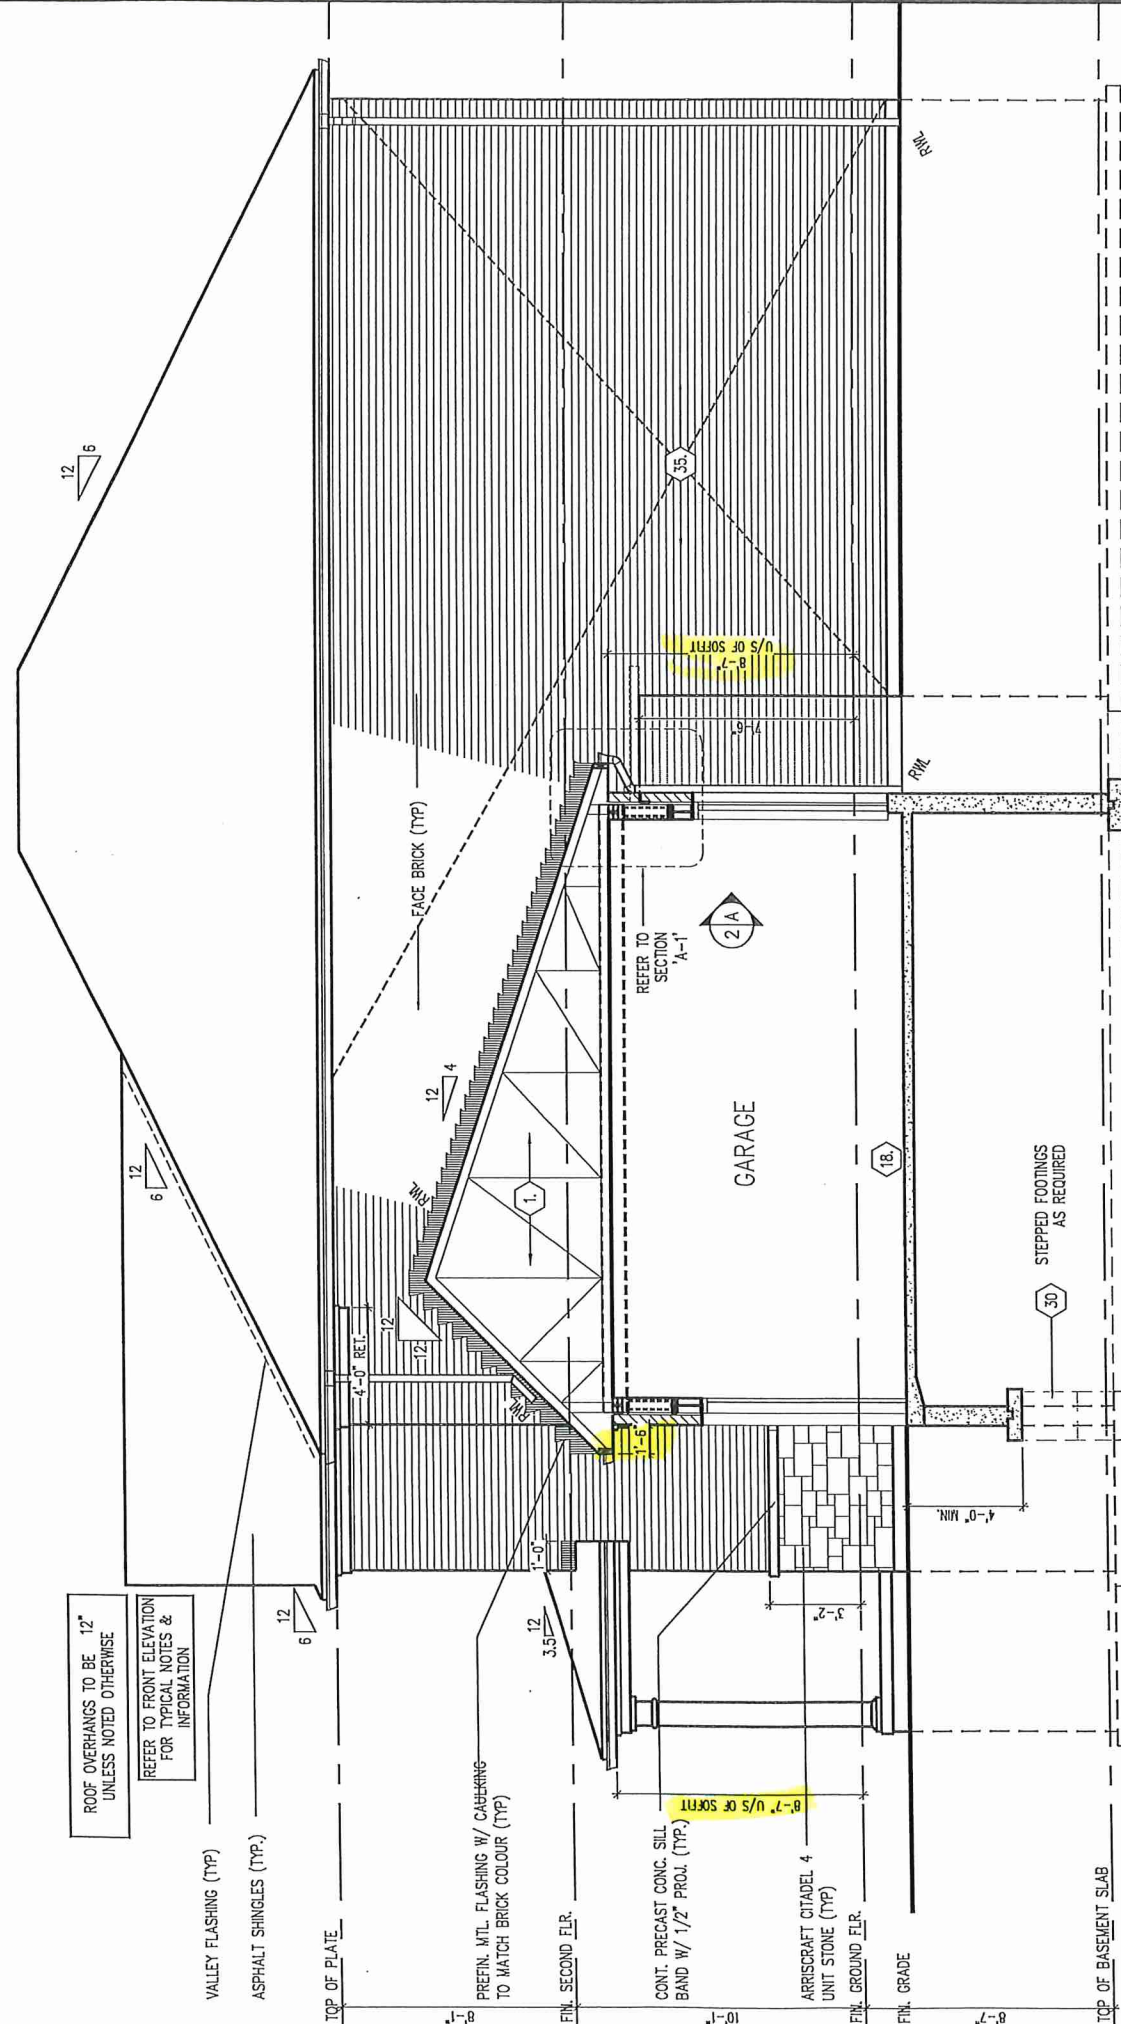

RIGHT SIDE ELEVATION 'A'

LEFT AND RIGHT ELEVATION A


Royal Pine Homes/Summer Ridge Estates Inc.-216051 UNIT-2504
"MAYFIELD VILLAGE", BRAMPTON, ON. REV.2024.03.14



BK 292-28

Drawn By: WD
Checked By: DS
Scale: 3/16"=1'-0"
File Number: 216051WS2504
Page Number: 11 of 14

3550 Langstaff Road, Suite 200 Woodbridge, Ontario, L4L 9G8
All drawings specifications related documents and design are the copyright property of Royal Pine Homes. Reproduction of this property in whole or in part is strictly prohibited without R.P.H. written permission. R.P.H. assumes no responsibility or liability for this property unless it bears the appropriate BCIN number and original signature.

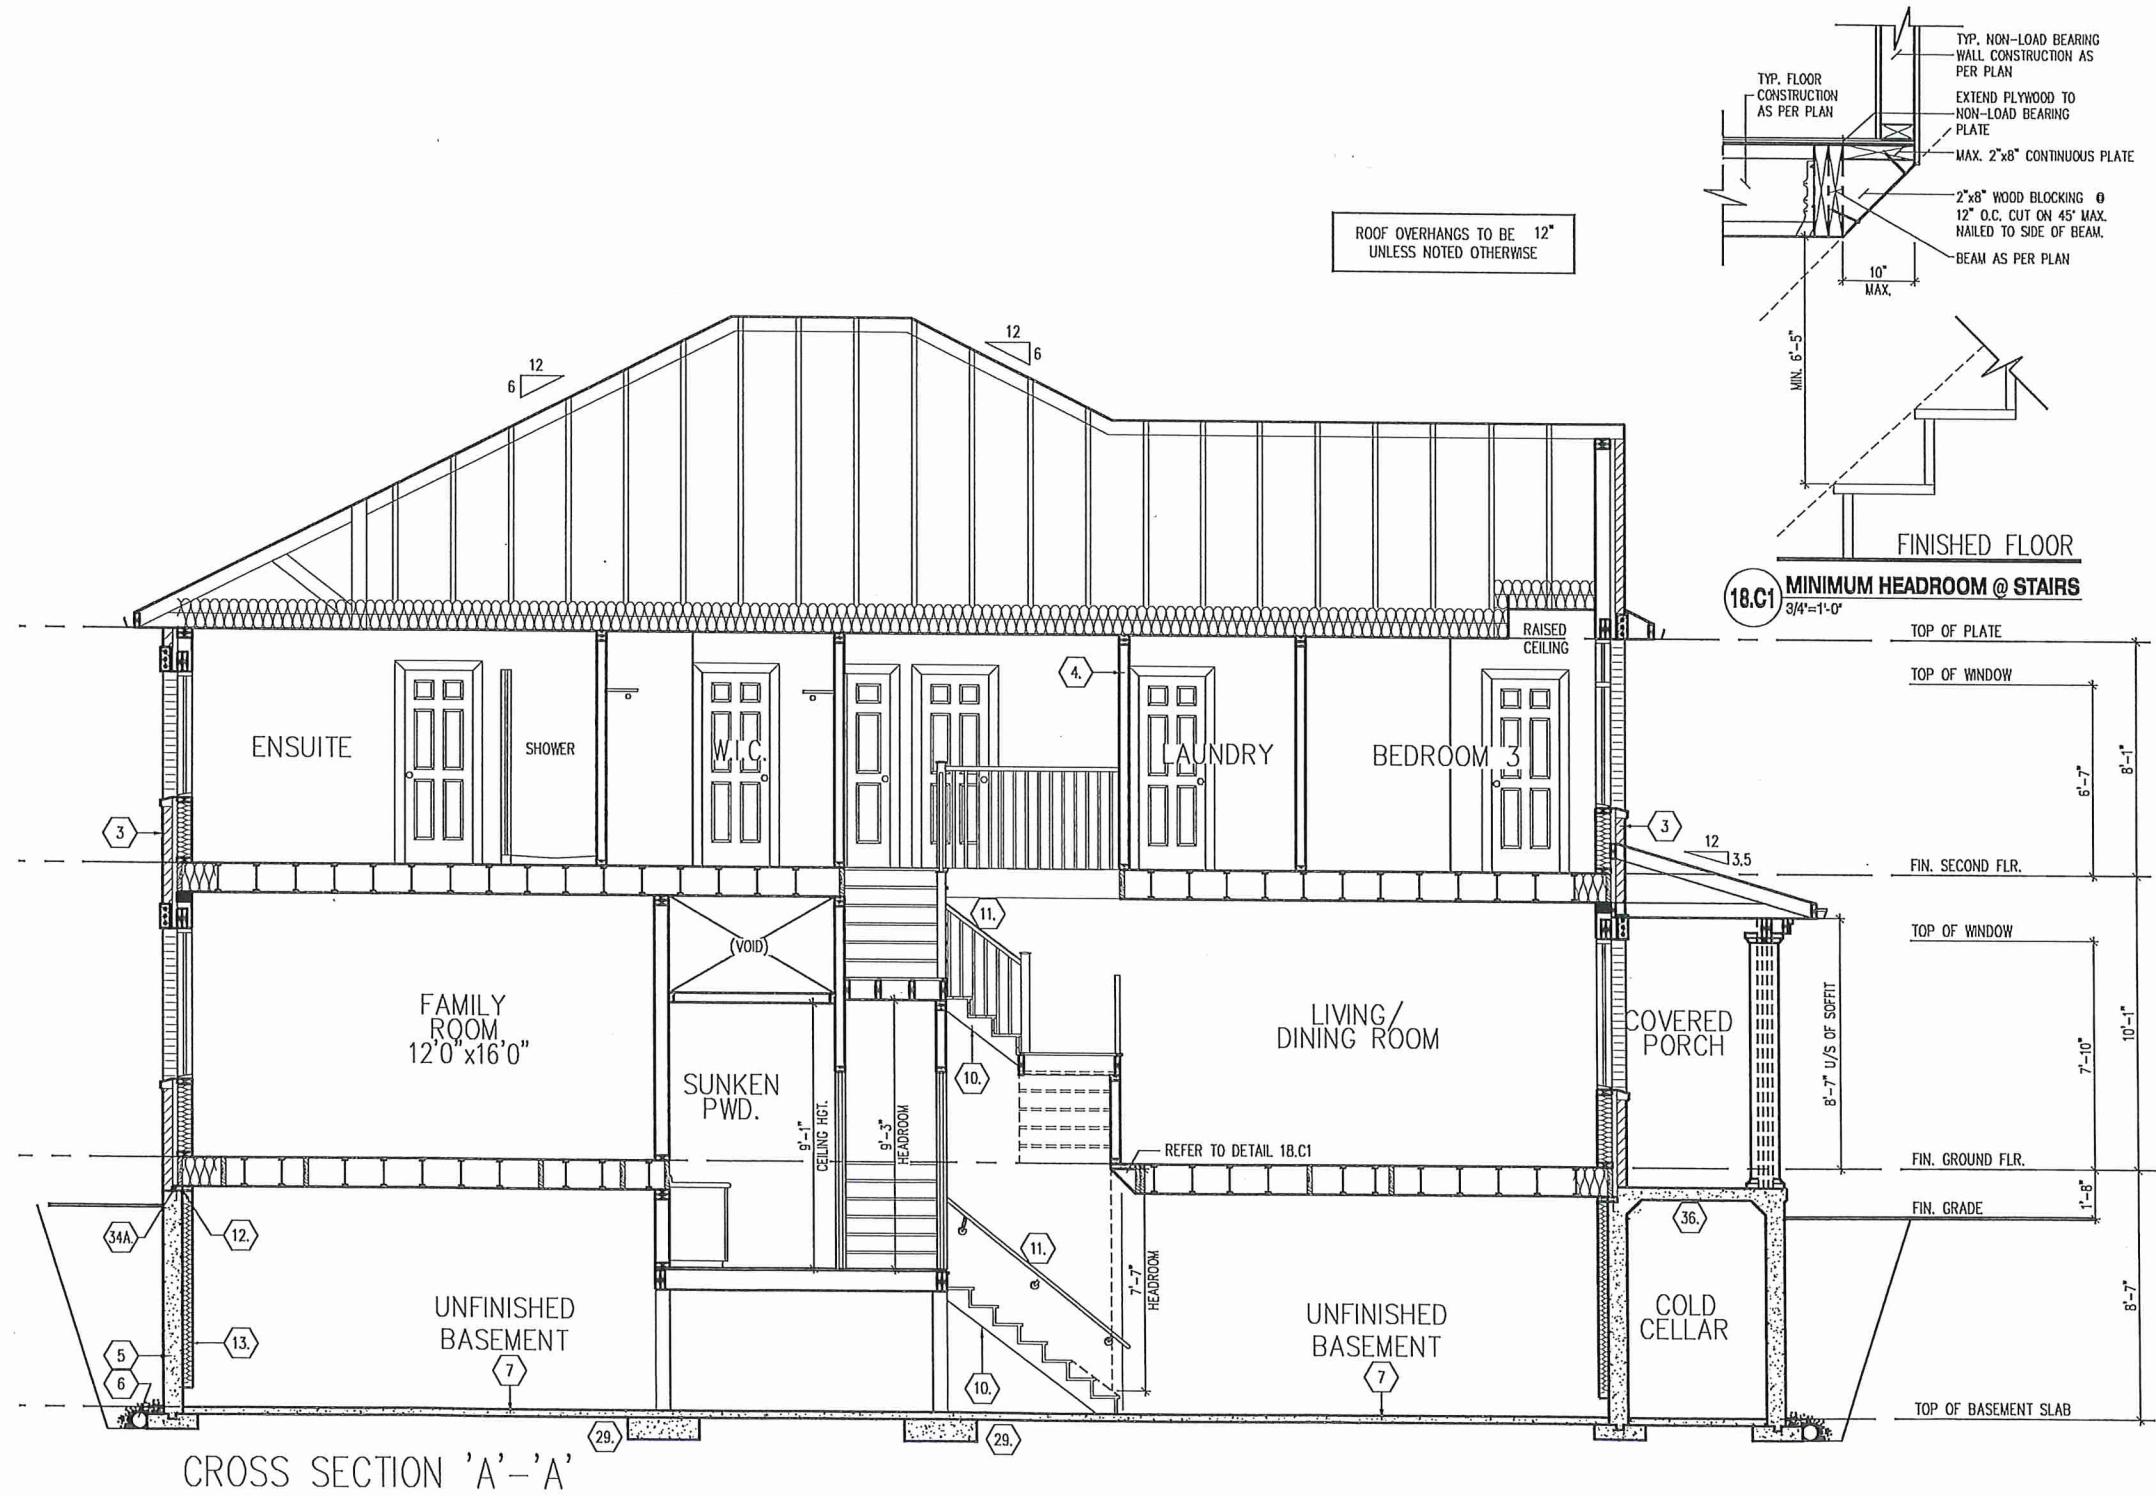

BLK 292-20

