



Block 290

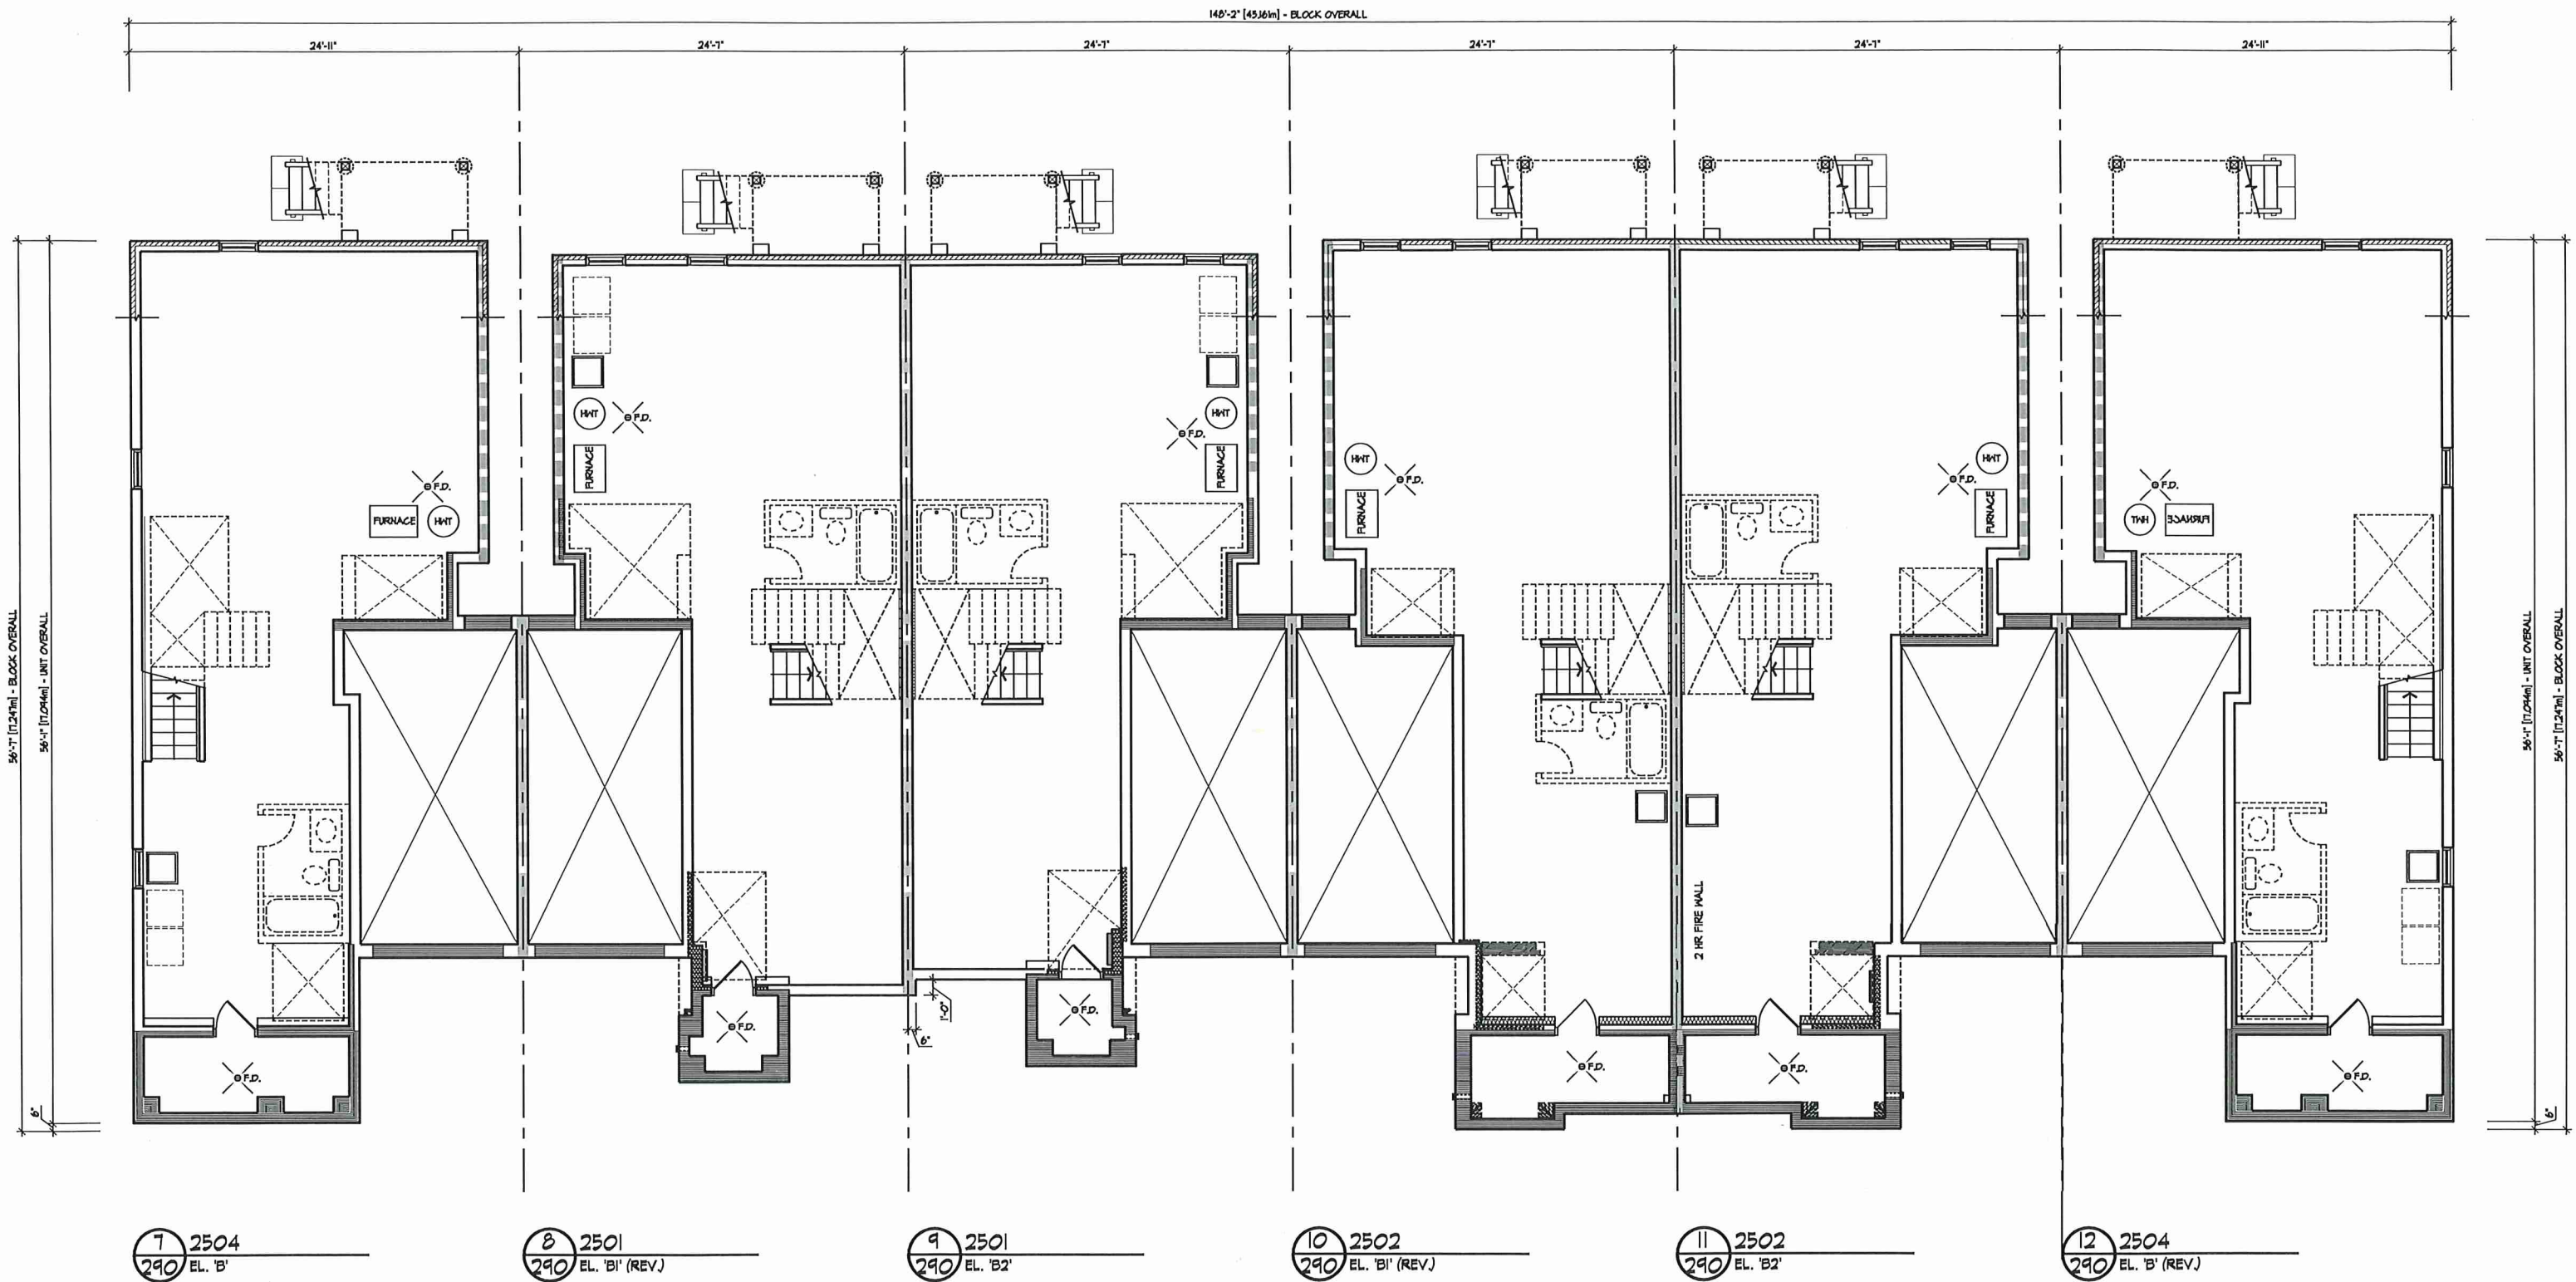

BASEMENT PLAN

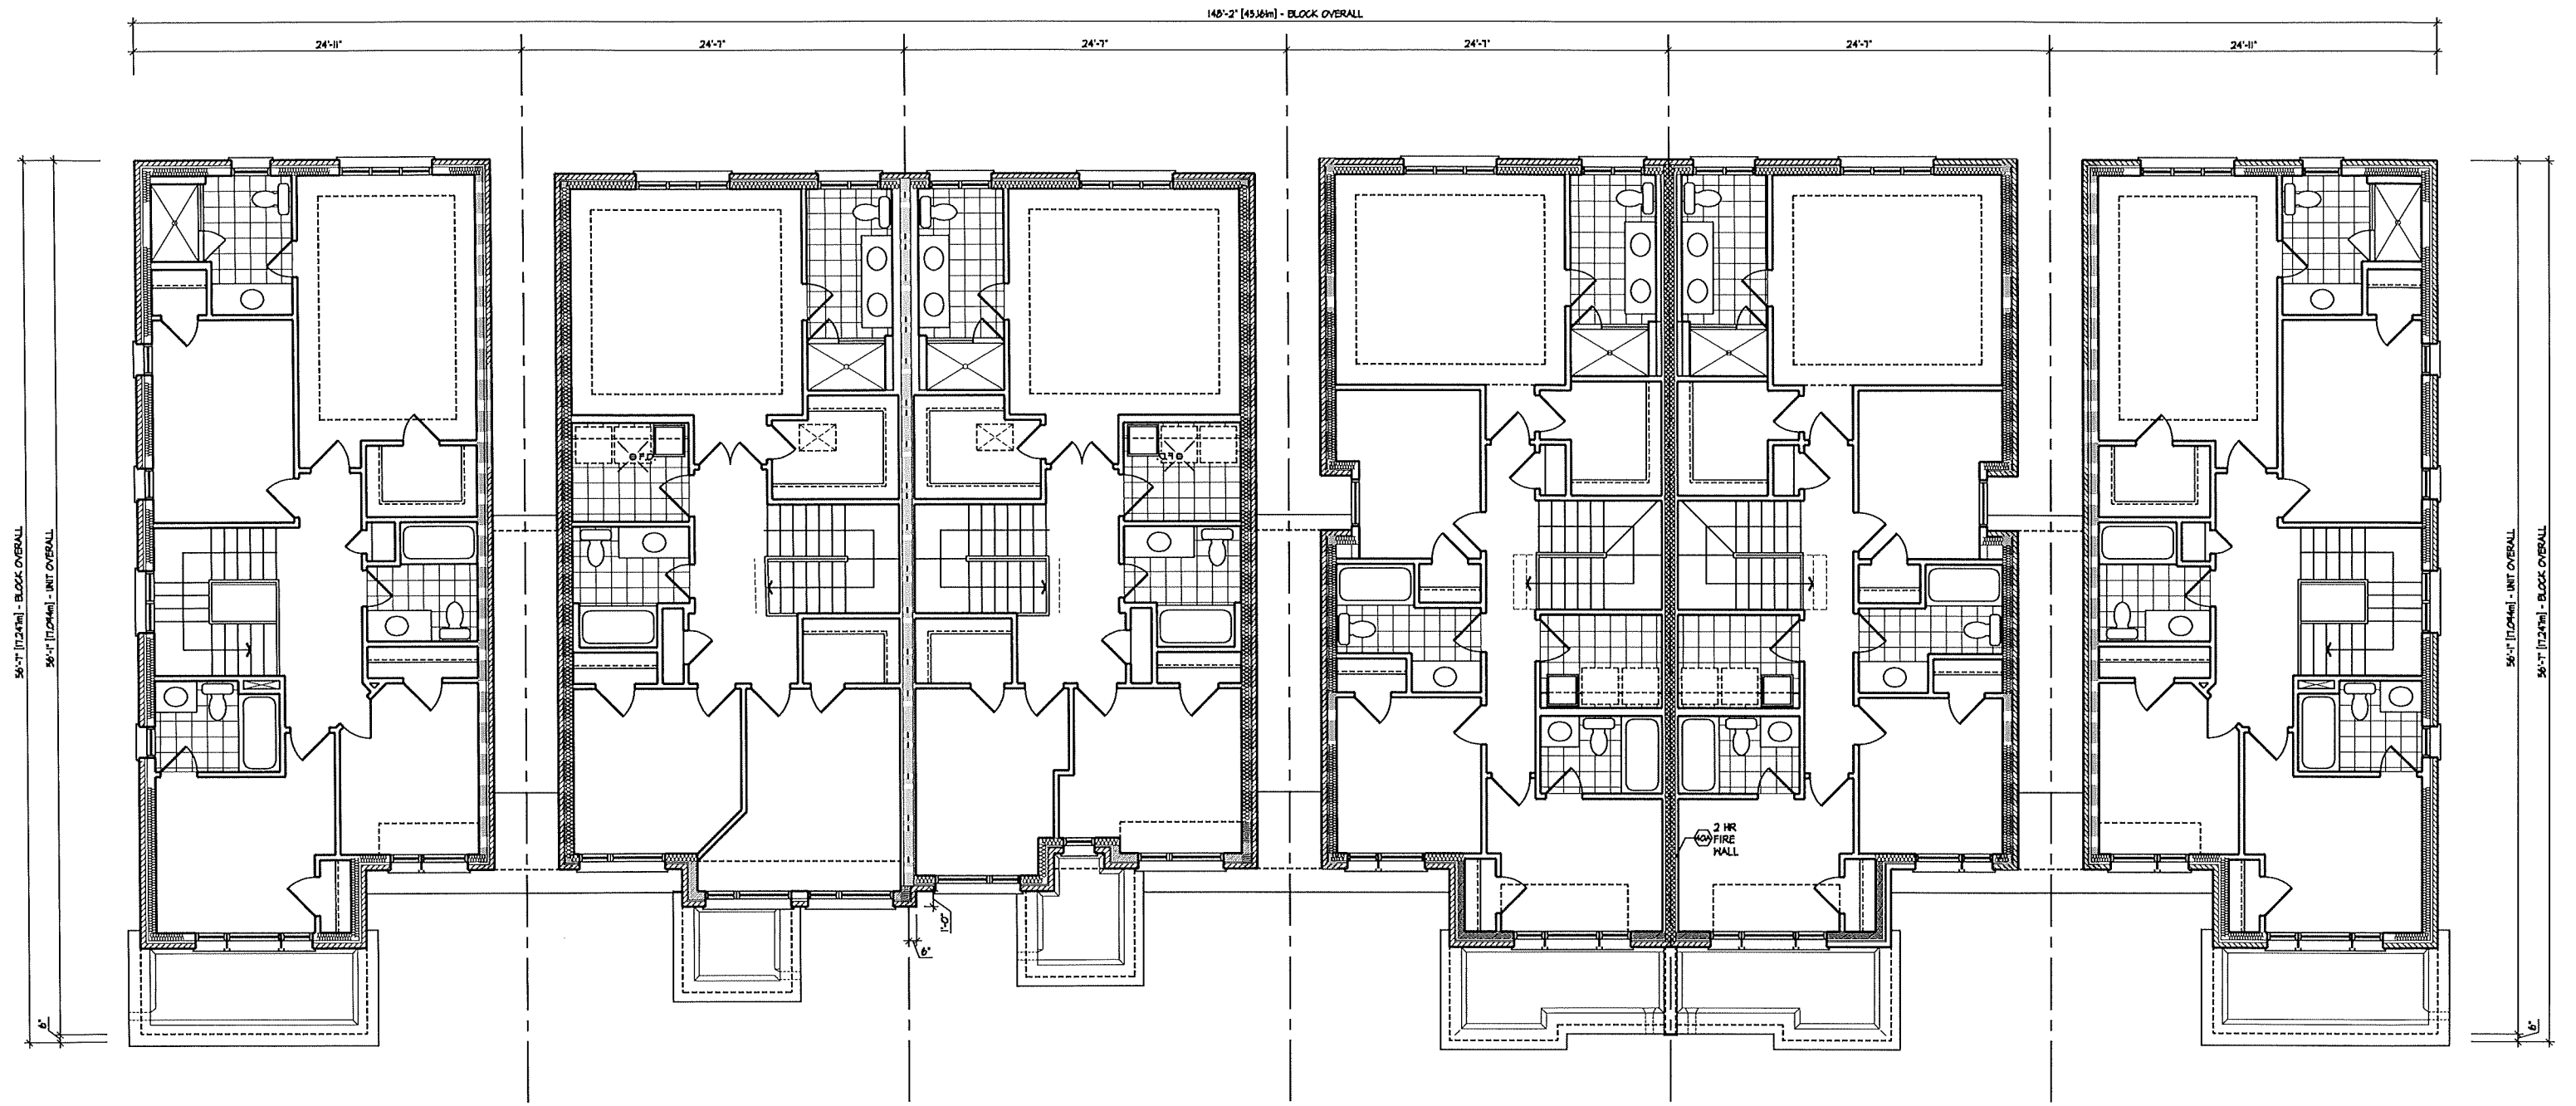

7 2504
290 EL. 'B' (OPT. 4 BEDROOM PLAN)

8 2501
290 EL. 'B1' (REV.)


9 2501
290 EL. 'B2'

10 2502
290 EL. 'B1' (REV.) (OPT. 4 BEDROOM PLAN)


11 2502
290 EL. 'B2' (OPT. 4 BEDROOM PLAN)

12 2504
290 EL. 'B' (REV.) (OPT. 4 BEDROOM PLAN)

SECOND FLOOR PLAN

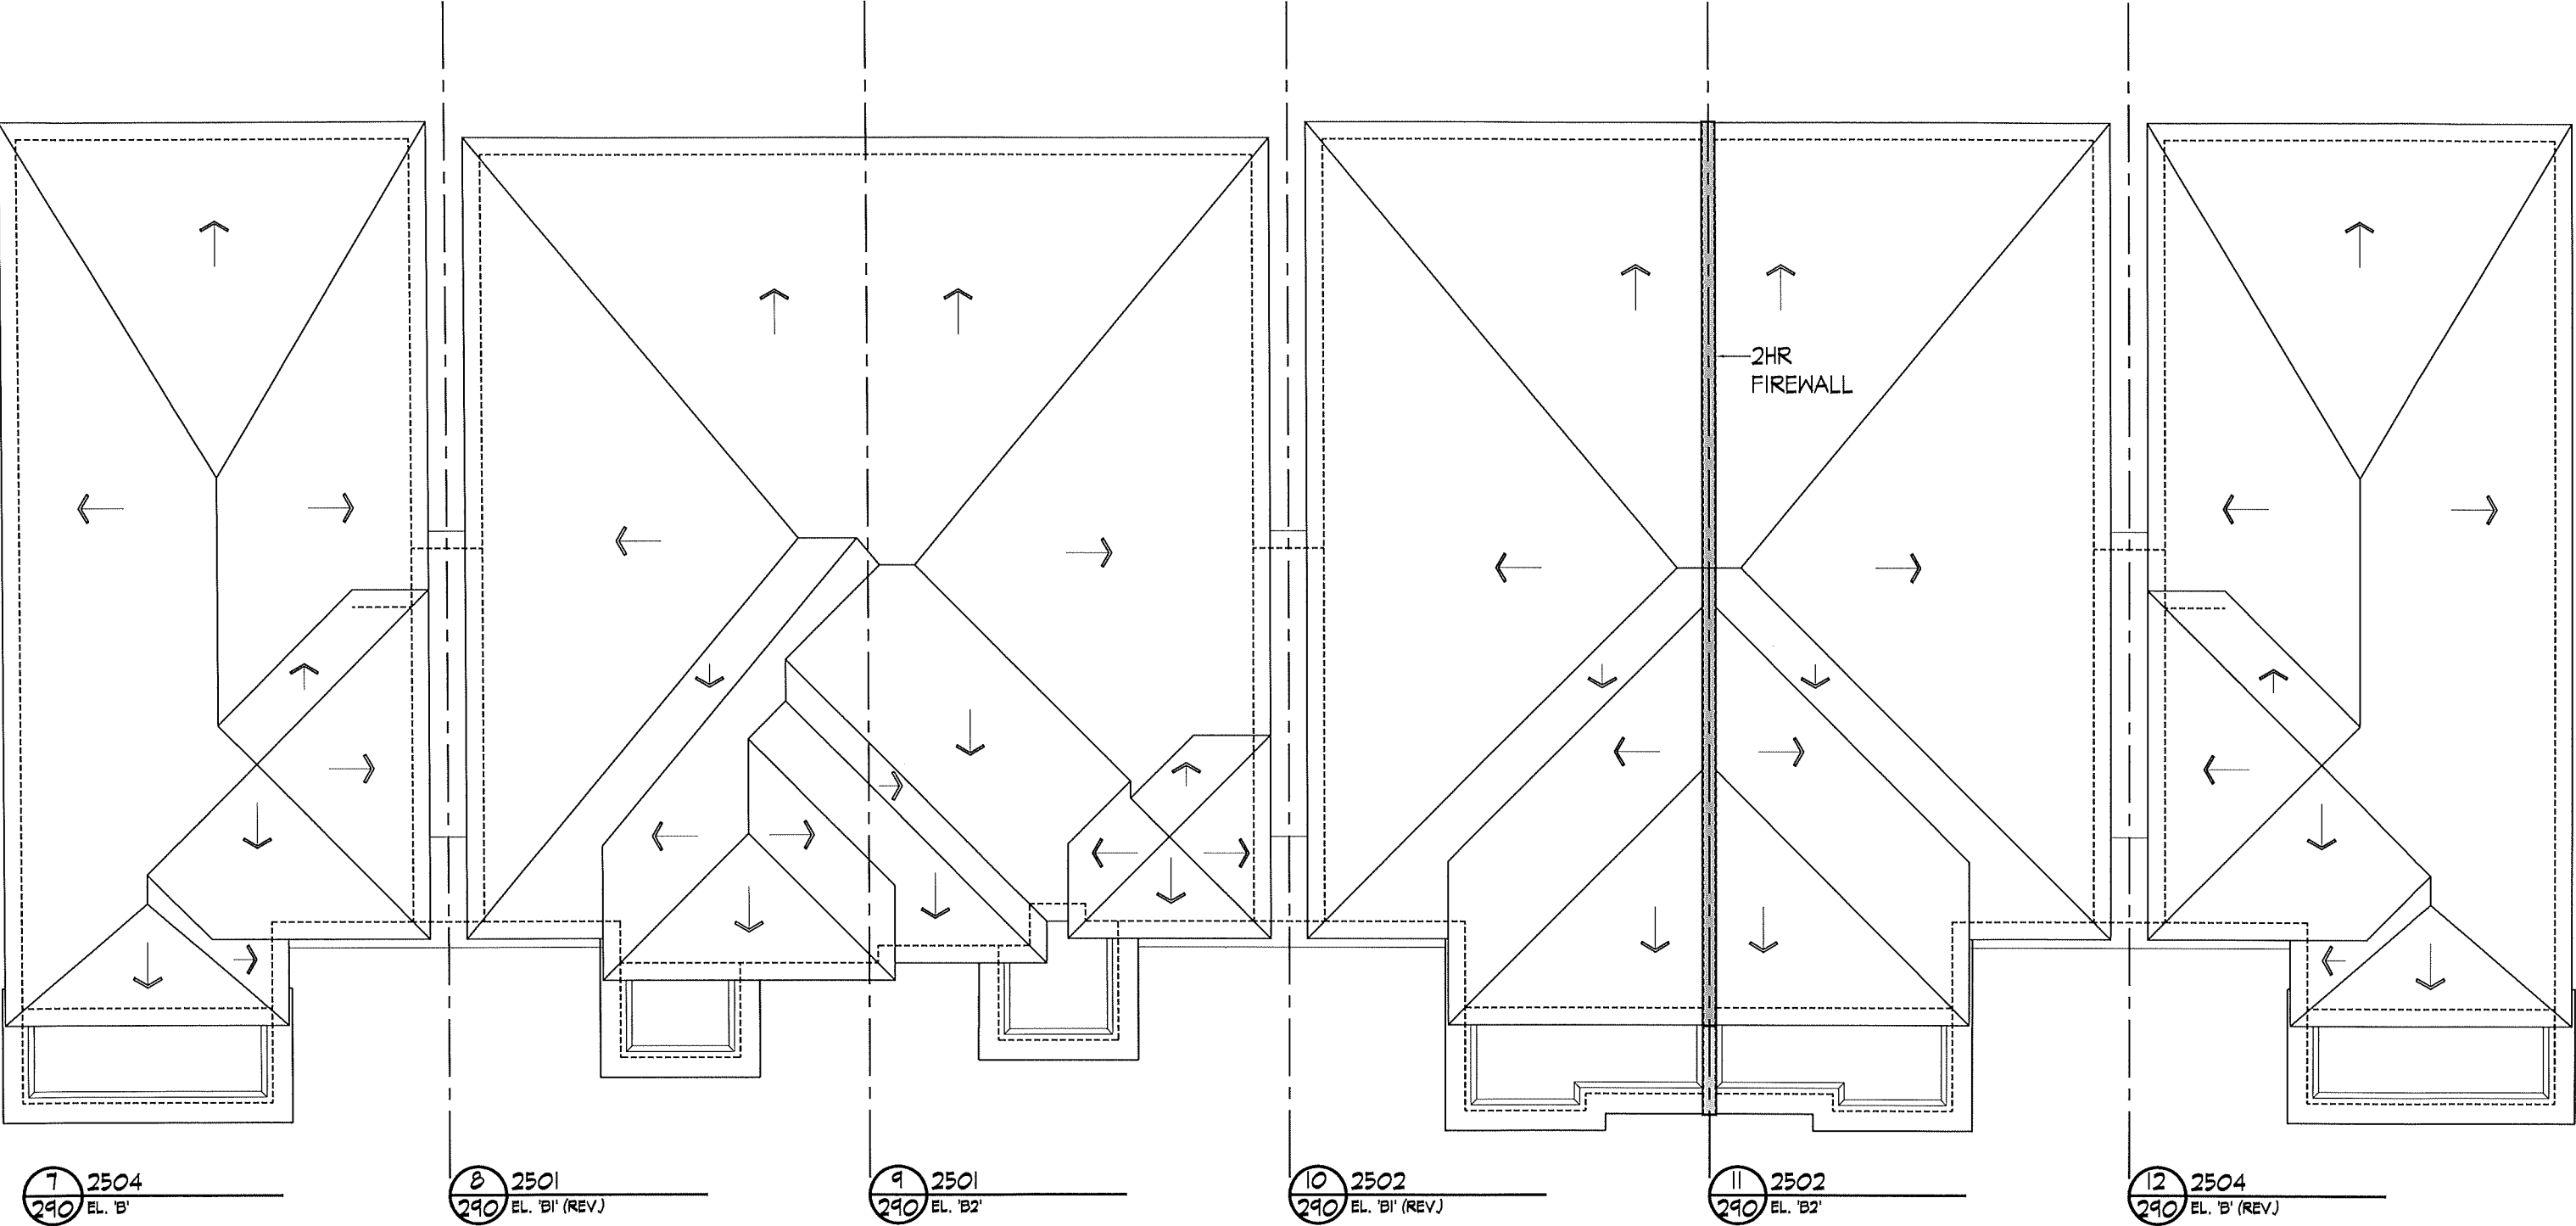

ROOF PLAN

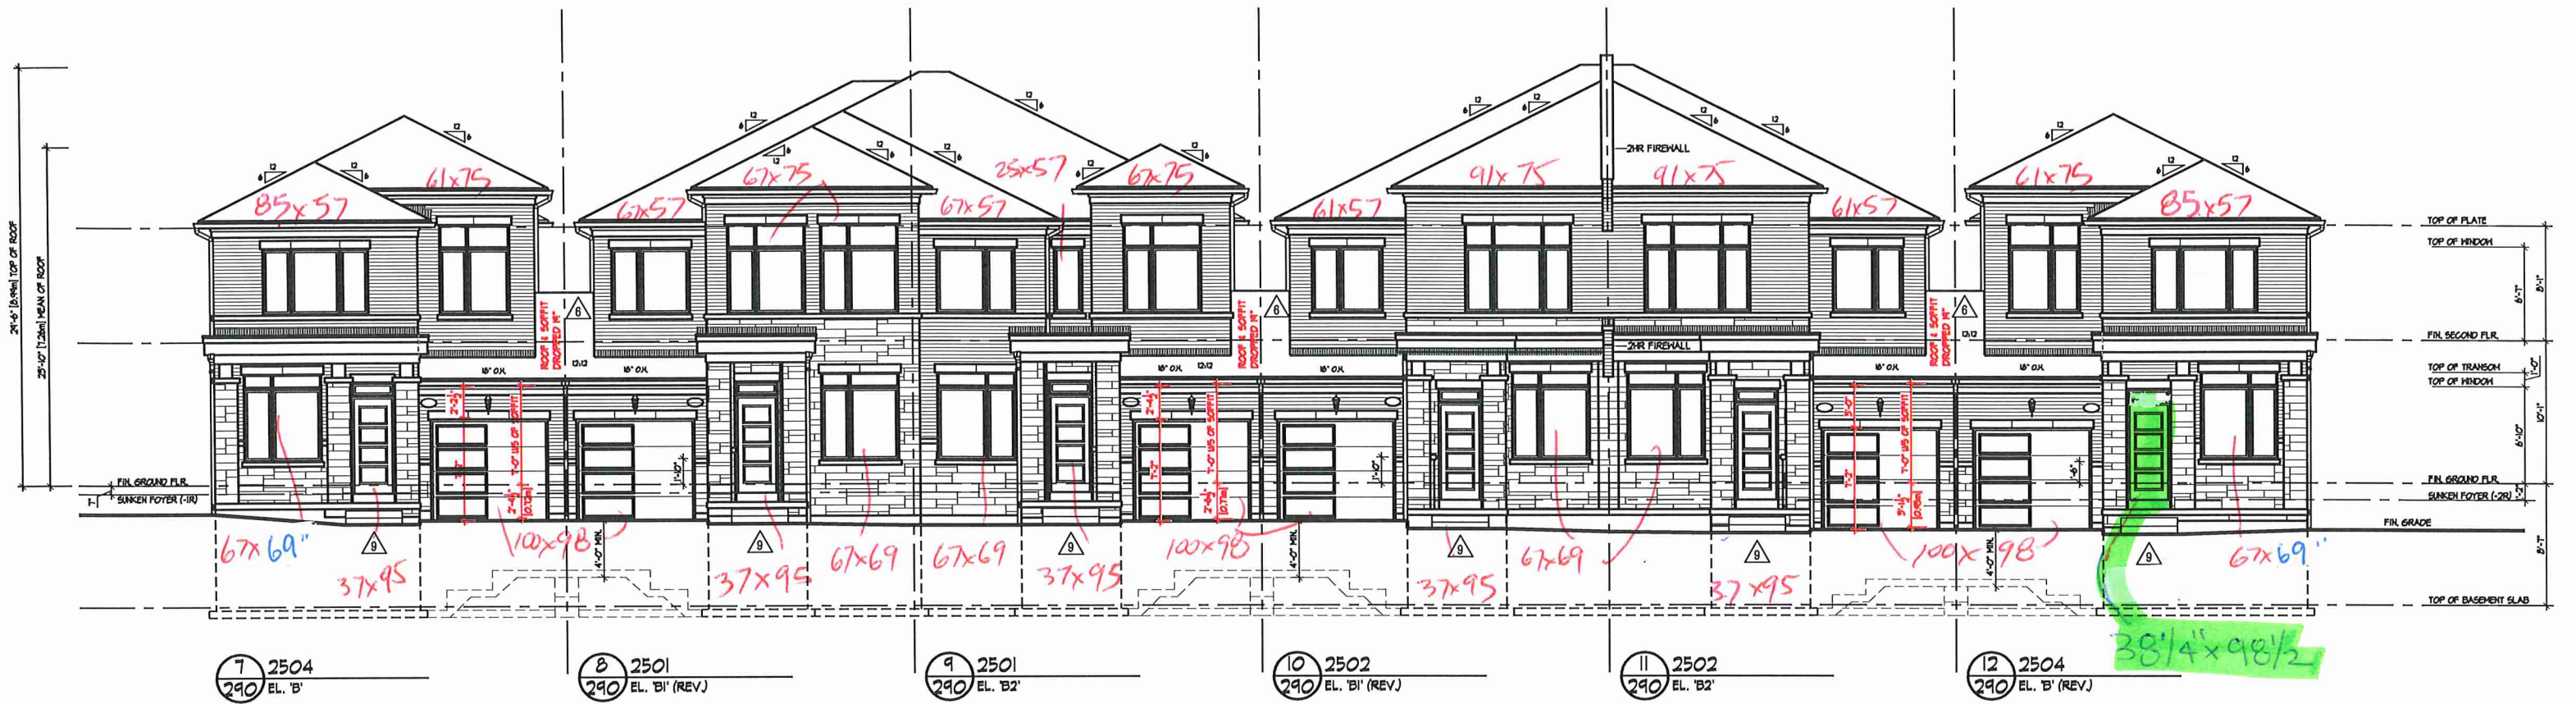

FRONT ELEVATION



REAR ELEVATION




7 2504
 290 EL. 'B' (OPT. 4 BEDROOM PLAN)

LEFT SIDE ELEVATION



12 2504
 290 EL. 'B' (REV.) (OPT. 4 BEDROOM PLAN)

RIGHT SIDE ELEVATION

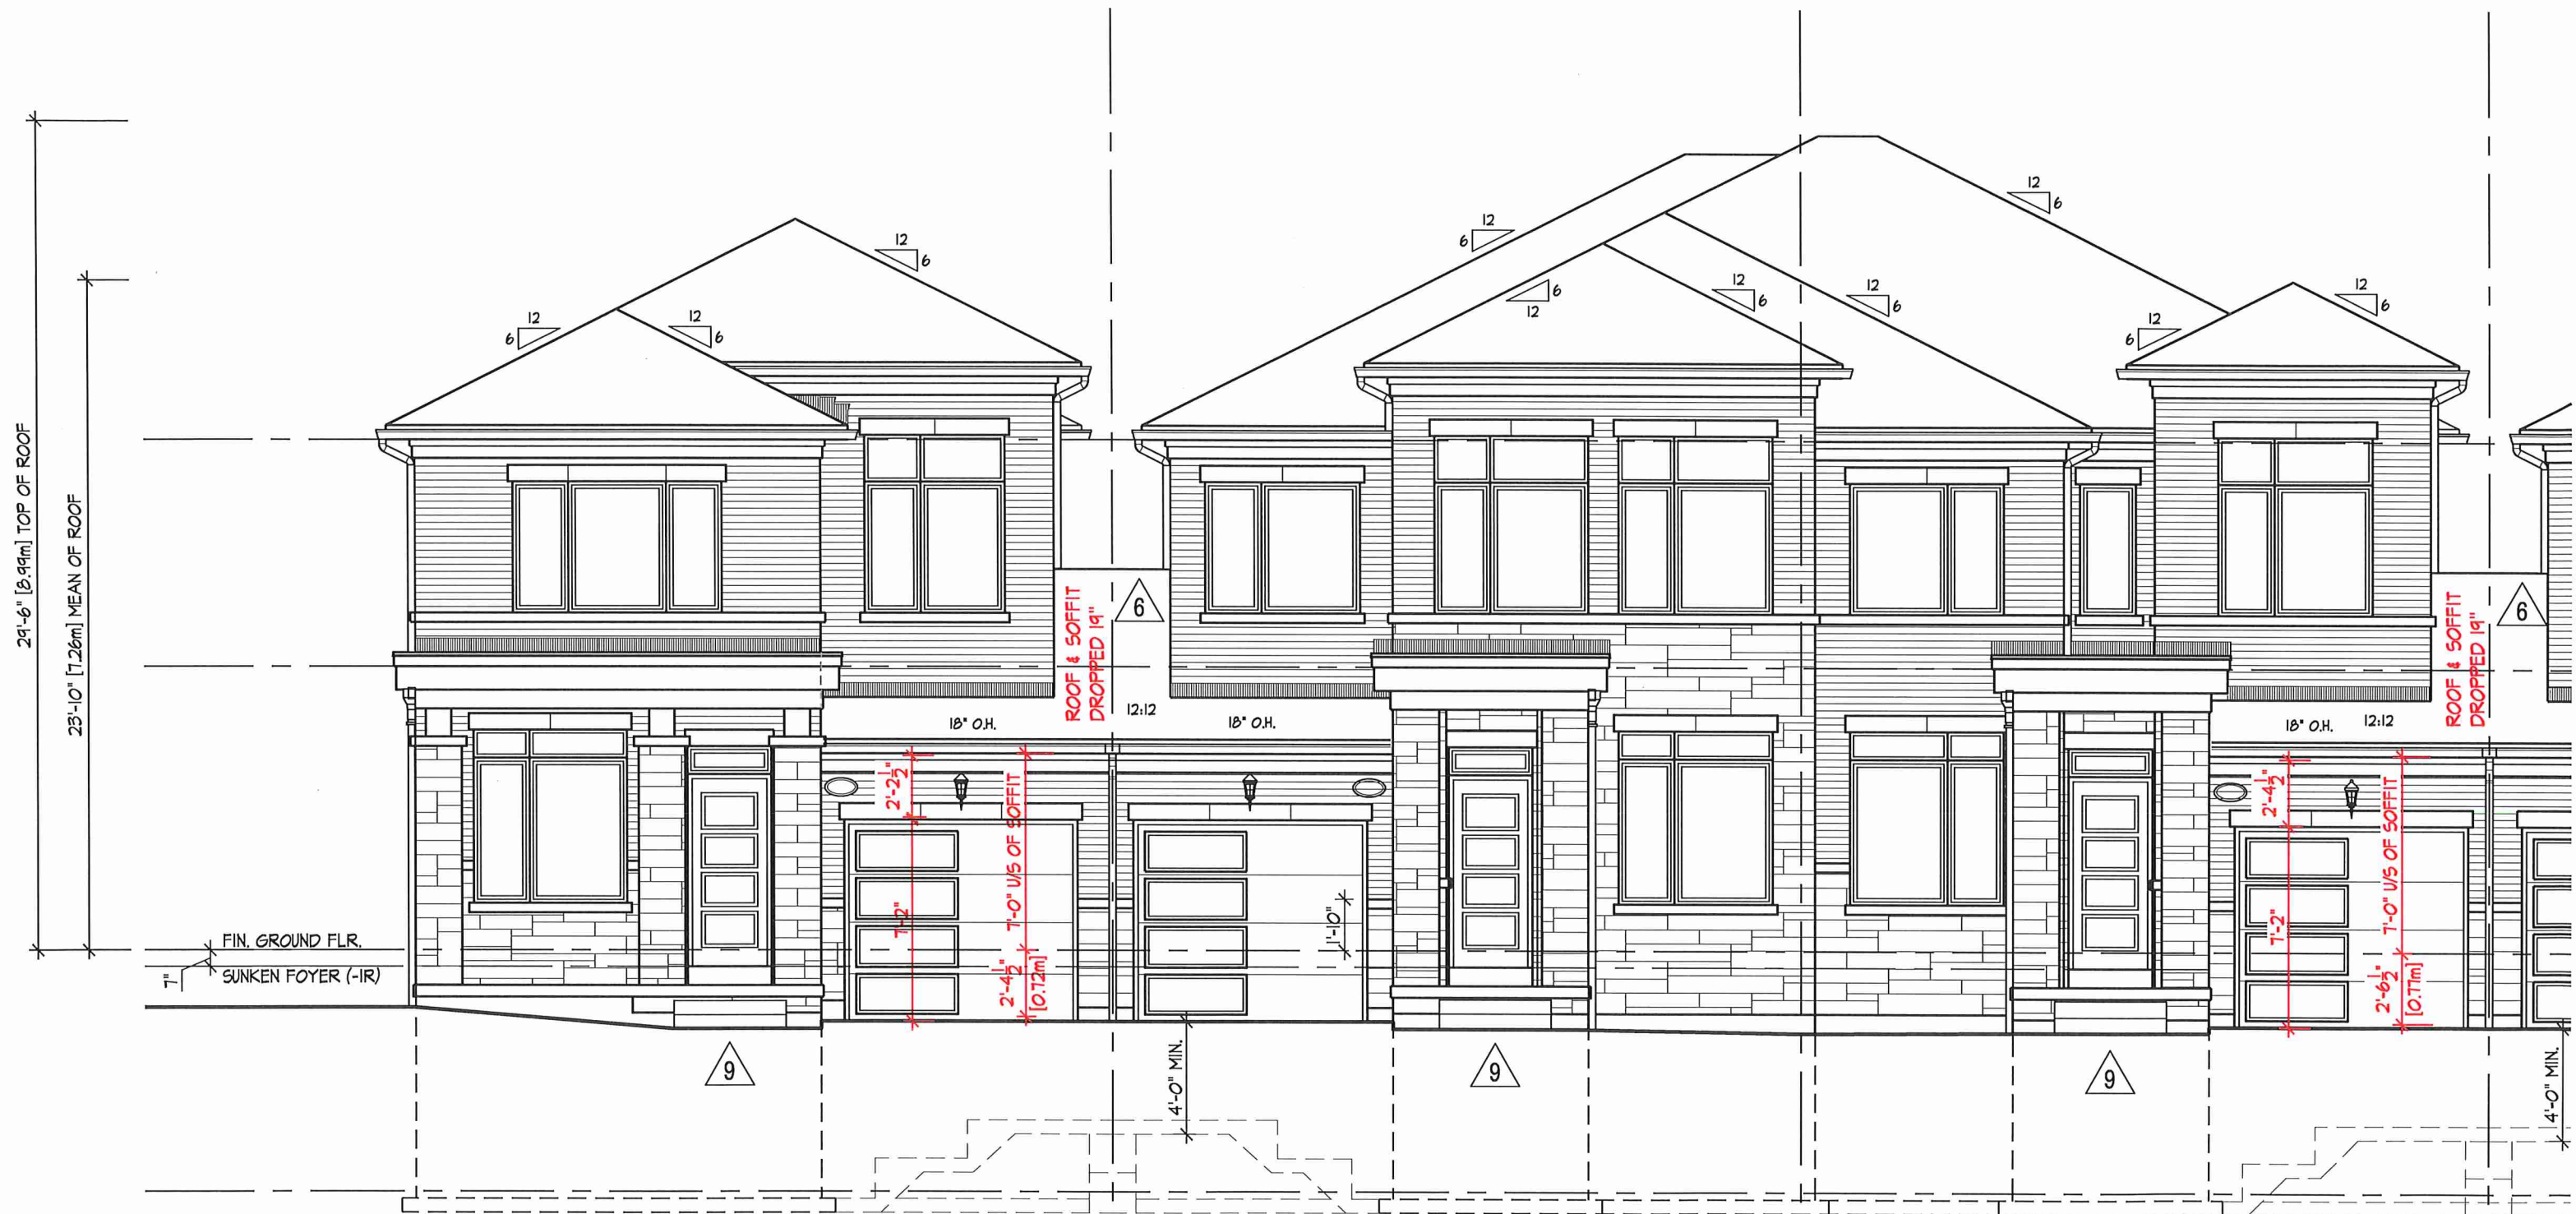

7 2504
290 EL. 'B'

8 2501
290 EL. 'B1' (REV.)

9 2501
290 EL. 'B2'

10 2501
290 EL. 'B3'

FRONT ELEVATION

