



[illegible]

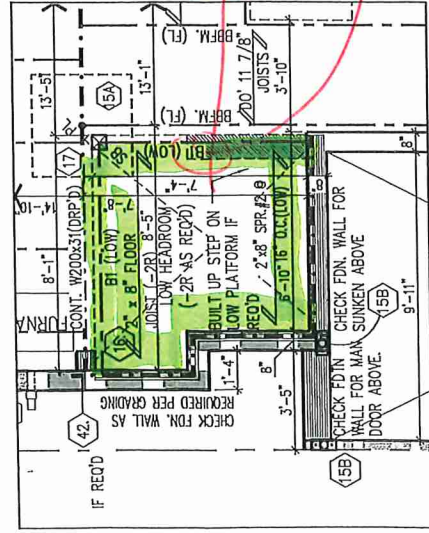

PART. BASEMENT PLAN -
SUNKEN COND. EL. 'A1' (REV)
(EL 'A2', 'B1' & 'B2' SIMILAR)

SEE 1ST FLOOR

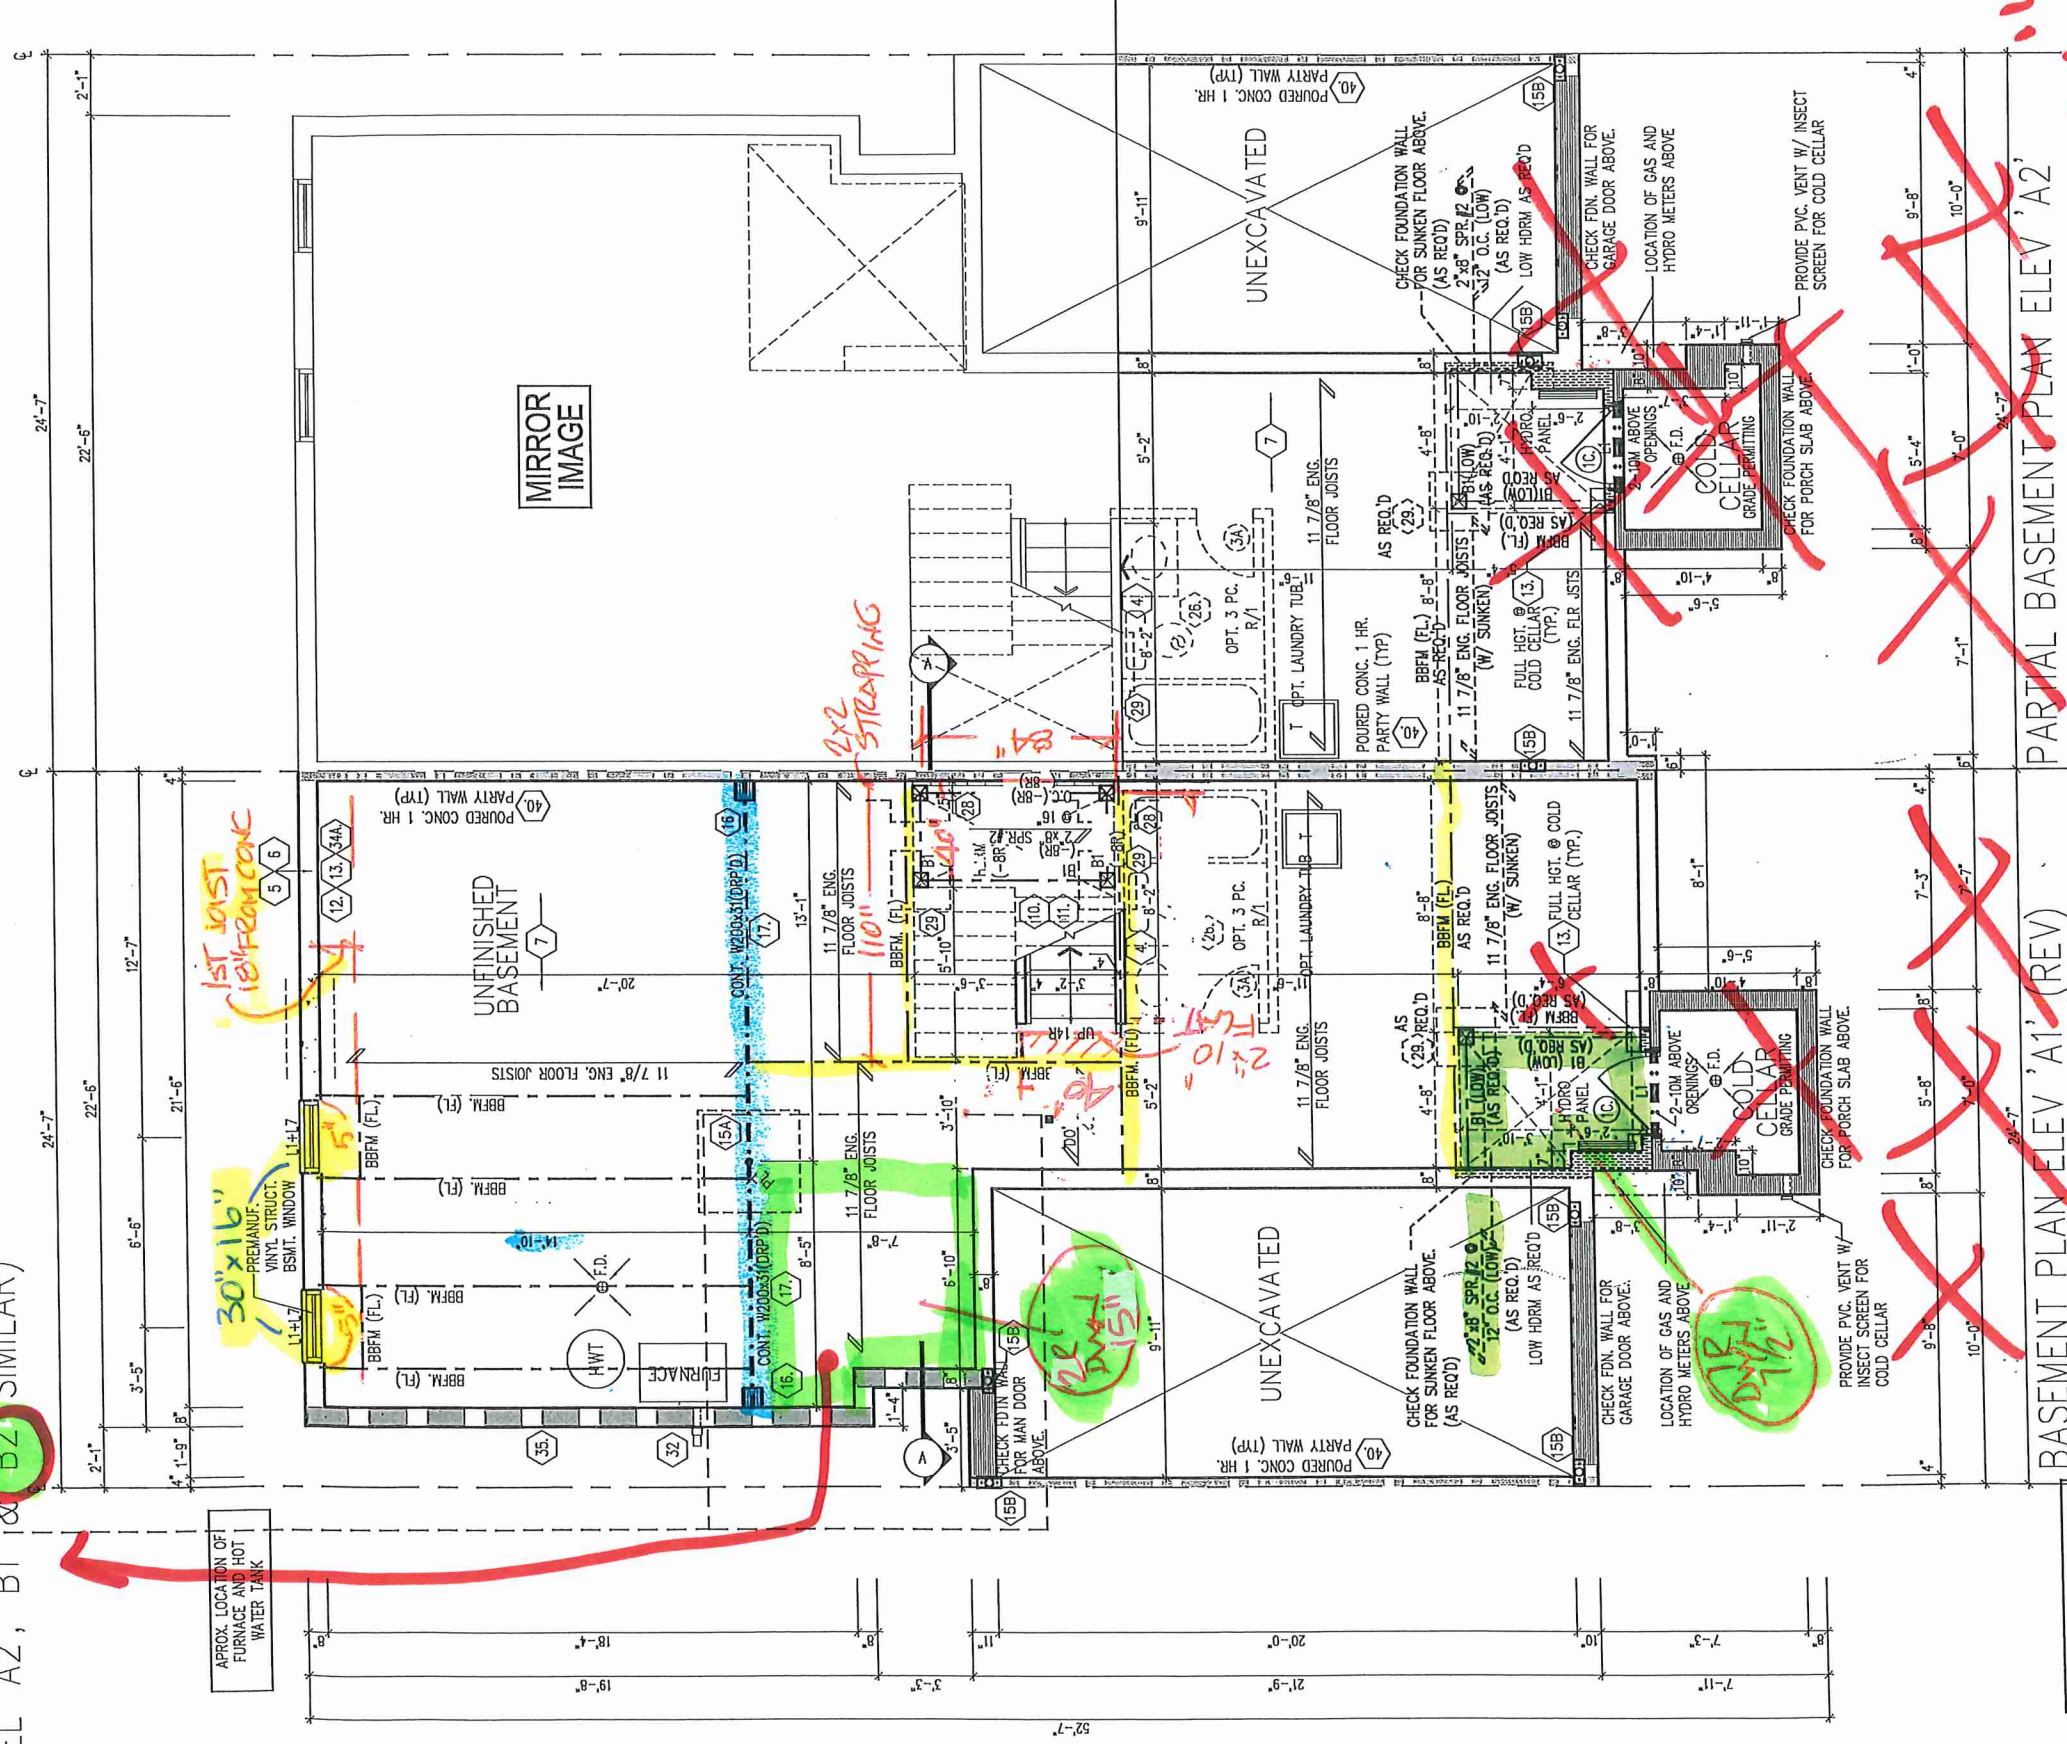

PROVIDE SOLID WOOD BLOCKING @
24" O.C. FOR FIRST JOIST SPAN
WHEN PARALLEL W/ EXTERIOR
WALL

REFER TO FLOOR JOIST
MANUFACTURER'S DRAWINGS FOR
LAYOUT, SPACING, BLOCKING &
STRAPPING REQUIREMENTS, &
INSTALLATION DETAILS AND
HANGER SIZES, & SUB-FLOOR
THICKNESS

SPACE ALL FLOOR JOISTS @
12" O.C. UNDER ALL CERAMIC
TILE AREAS.

BASEMENT PLAN ELEV 'A1' (REV)

PARTIAL BASEMENT PLAN ELEV 'A2'


* 2X6 PLATE RAMSET TOP
OF BEAM.
* CONFIRM BSMT WINDOWS
CORRECT LOCATION

SEE ELEV 'B2'

SB: MIN. 2/ 2"x6" SPF OR 3/ 2"x4" SPF
SB1: MIN. 3/ 2"x6" SPF OR 4/ 2"x4" SPF
SB2: MIN. 4/ 2"x6" SPF OR 5/ 2"x4" SPF

PJK 290-9



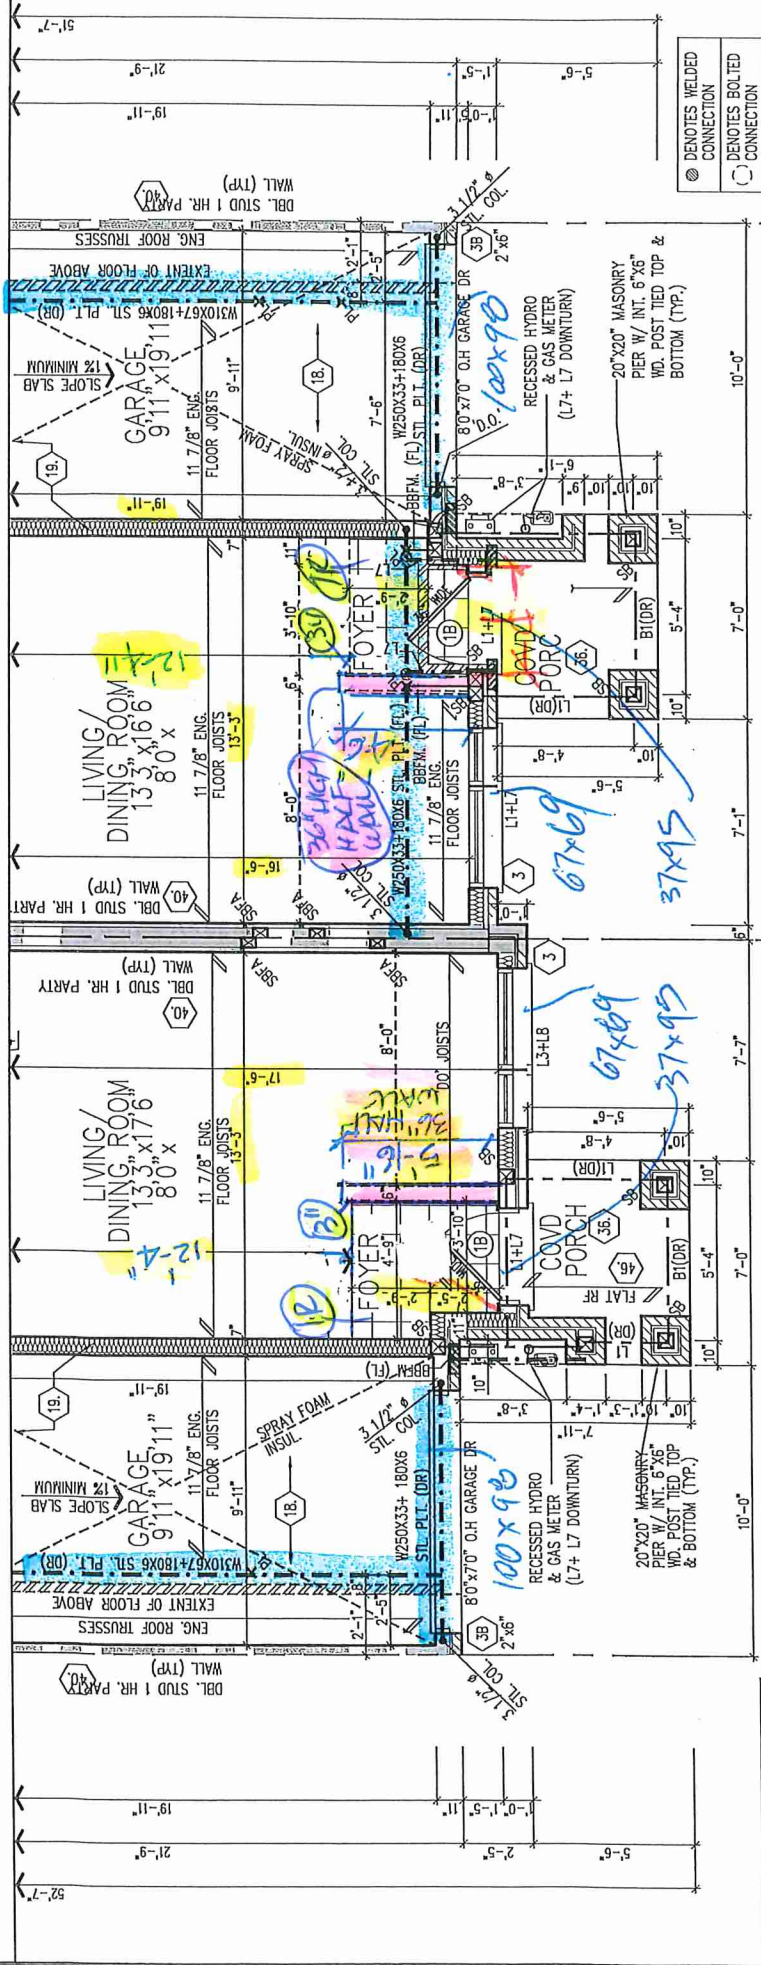

SPACE ALL FLOOR JOISTS @ 12" O.C. UNDER ALL CERAMIC TILE AREAS.

PROVIDE SOLID WOOD BLOCKING @ 24" O.C. FOR FIRST JOIST SPAN WHEN PARALLEL W/ EXTERIOR WALL


REFER TO FLOOR JOIST MANUFACTURER'S DRAWINGS FOR LAYOUT, SPACING, BLOCKING & STRAPPING REQUIREMENTS. INSTALLATION DETAILS AND HANGER SIZES, & SUBFLOOR THICKNESS

REFER TO STANDARD FLOOR PLAN FOR COMPLETE CONSTRUCTION NOTES & DIMENSIONS

PART. GRND FLR PLAN ELEV 'B1' (REV)

PART. GROUND FLOOR PLAN ELEV 'B2'

TH-#9

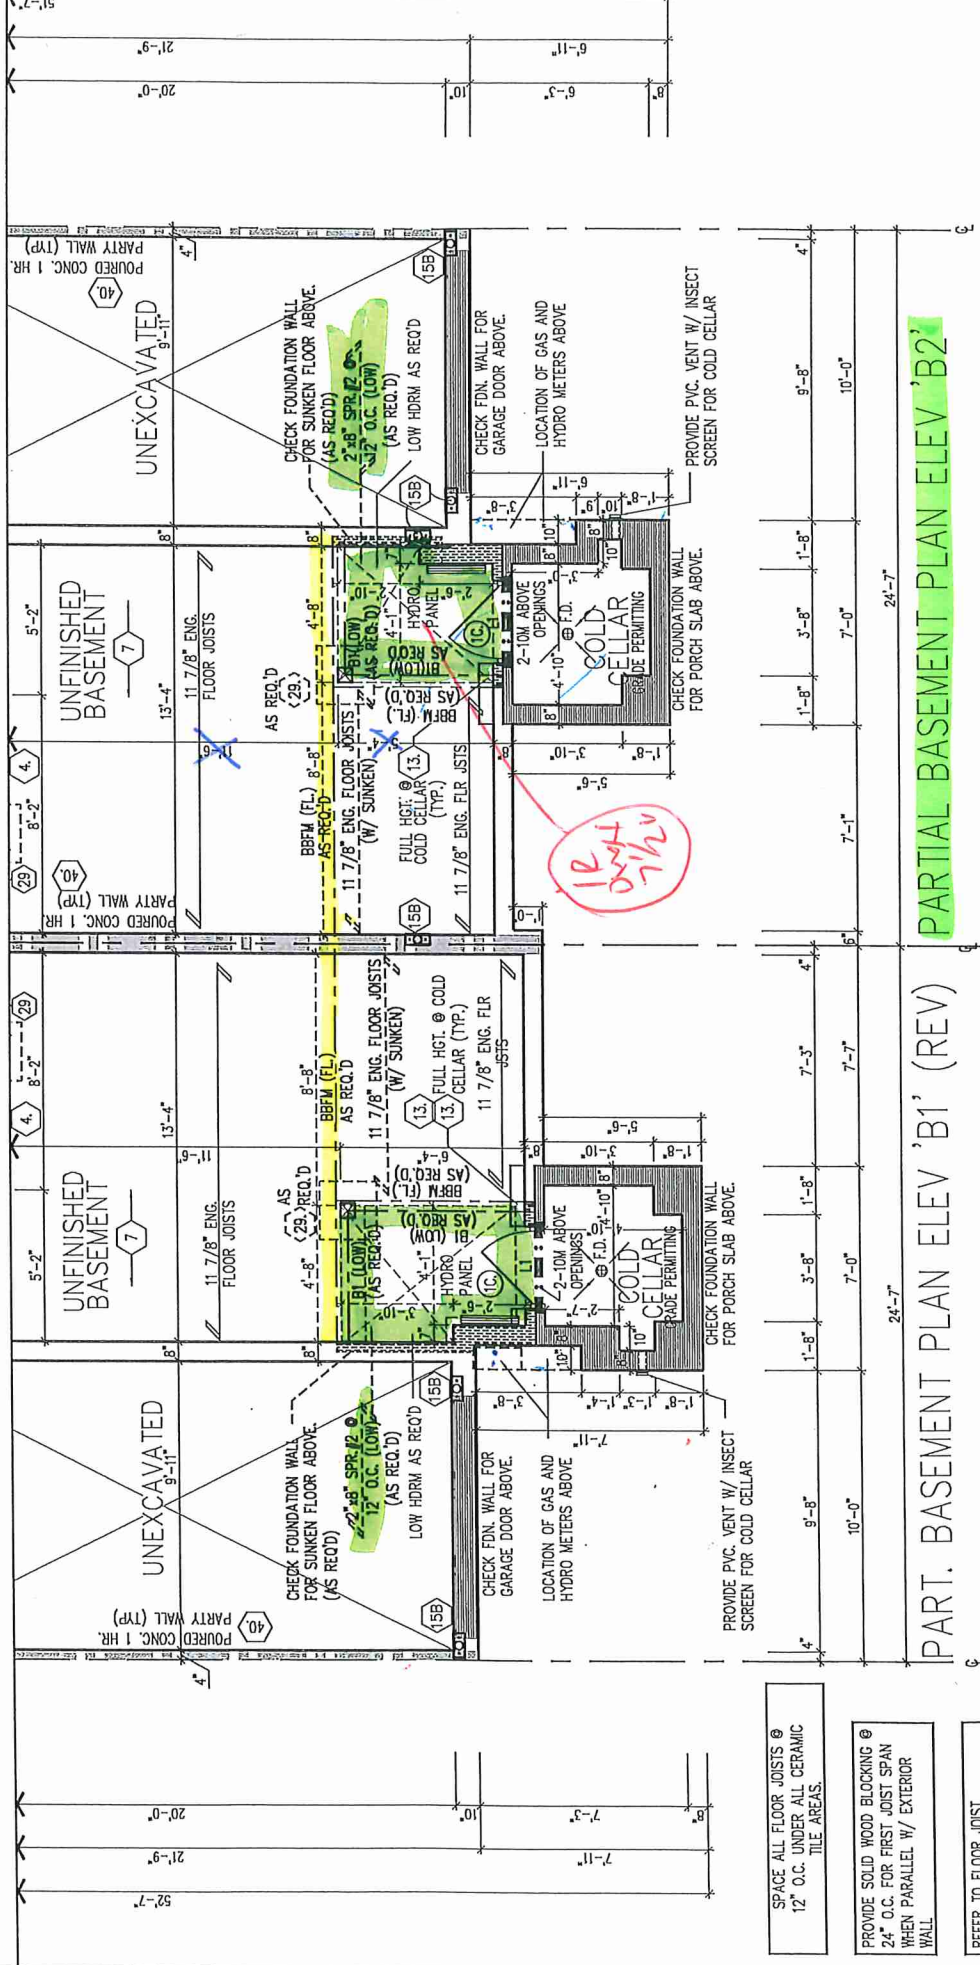

SPACE ALL FLOOR JOISTS @ 12" O.C. UNDER ALL CERAMIC TILE AREAS.

PROVIDE SOLID WOOD BLOCKING @ 24" O.C. FOR FIRST JOIST SPAN WHEN PARALLEL W/ EXTERIOR WALL

REFER TO FLOOR JOIST MANUFACTURER'S DRAWINGS FOR LAYOUT, SPACING, BLOCKING & STRAPPING REQUIREMENTS. INSTALLATION DETAILS AND HANGER SIZES, & SUBFLOOR THICKNESS

REFER TO STANDARD FLOOR PLAN FOR COMPLETE CONSTRUCTION NOTES & DIMENSIONS

PART. BASEMENT PLAN ELEV 'B1' (REV)

PARTIAL BASEMENT PLAN ELEV 'B2'

TH-#9

SB: MIN. 2/2"x6" SPF OR 3/2"x4" SPF
SB1: MIN. 3/2"x6" SPF OR 4/2"x4" SPF
SB2: MIN. 4/2"x6" SPF OR 5/2"x4" SPF

RUC 290-9


PART. GRND. FLR. PLAN ELEV. B1 REV.ELEV. B2 / PART. SECOND FLR. PLAN ELEV 'B1' (REV)/ 'B2'

Royal Pine Homes/Summer Ridge Estates Inc.-216051 UNIT-2501
"MAYFIELD VILLAGE", BRAMPTON, ON. REV.2024.03.14



Drawn By WD DS 3/16"=1'-0"
Checked By DS
Scale
File Number 216051WS2501
Page Number 6 of 16

S.D. WINDOWS 96"
- BT DOORS 83"
- ARCHES 96"
- FRONT DOOR 95"

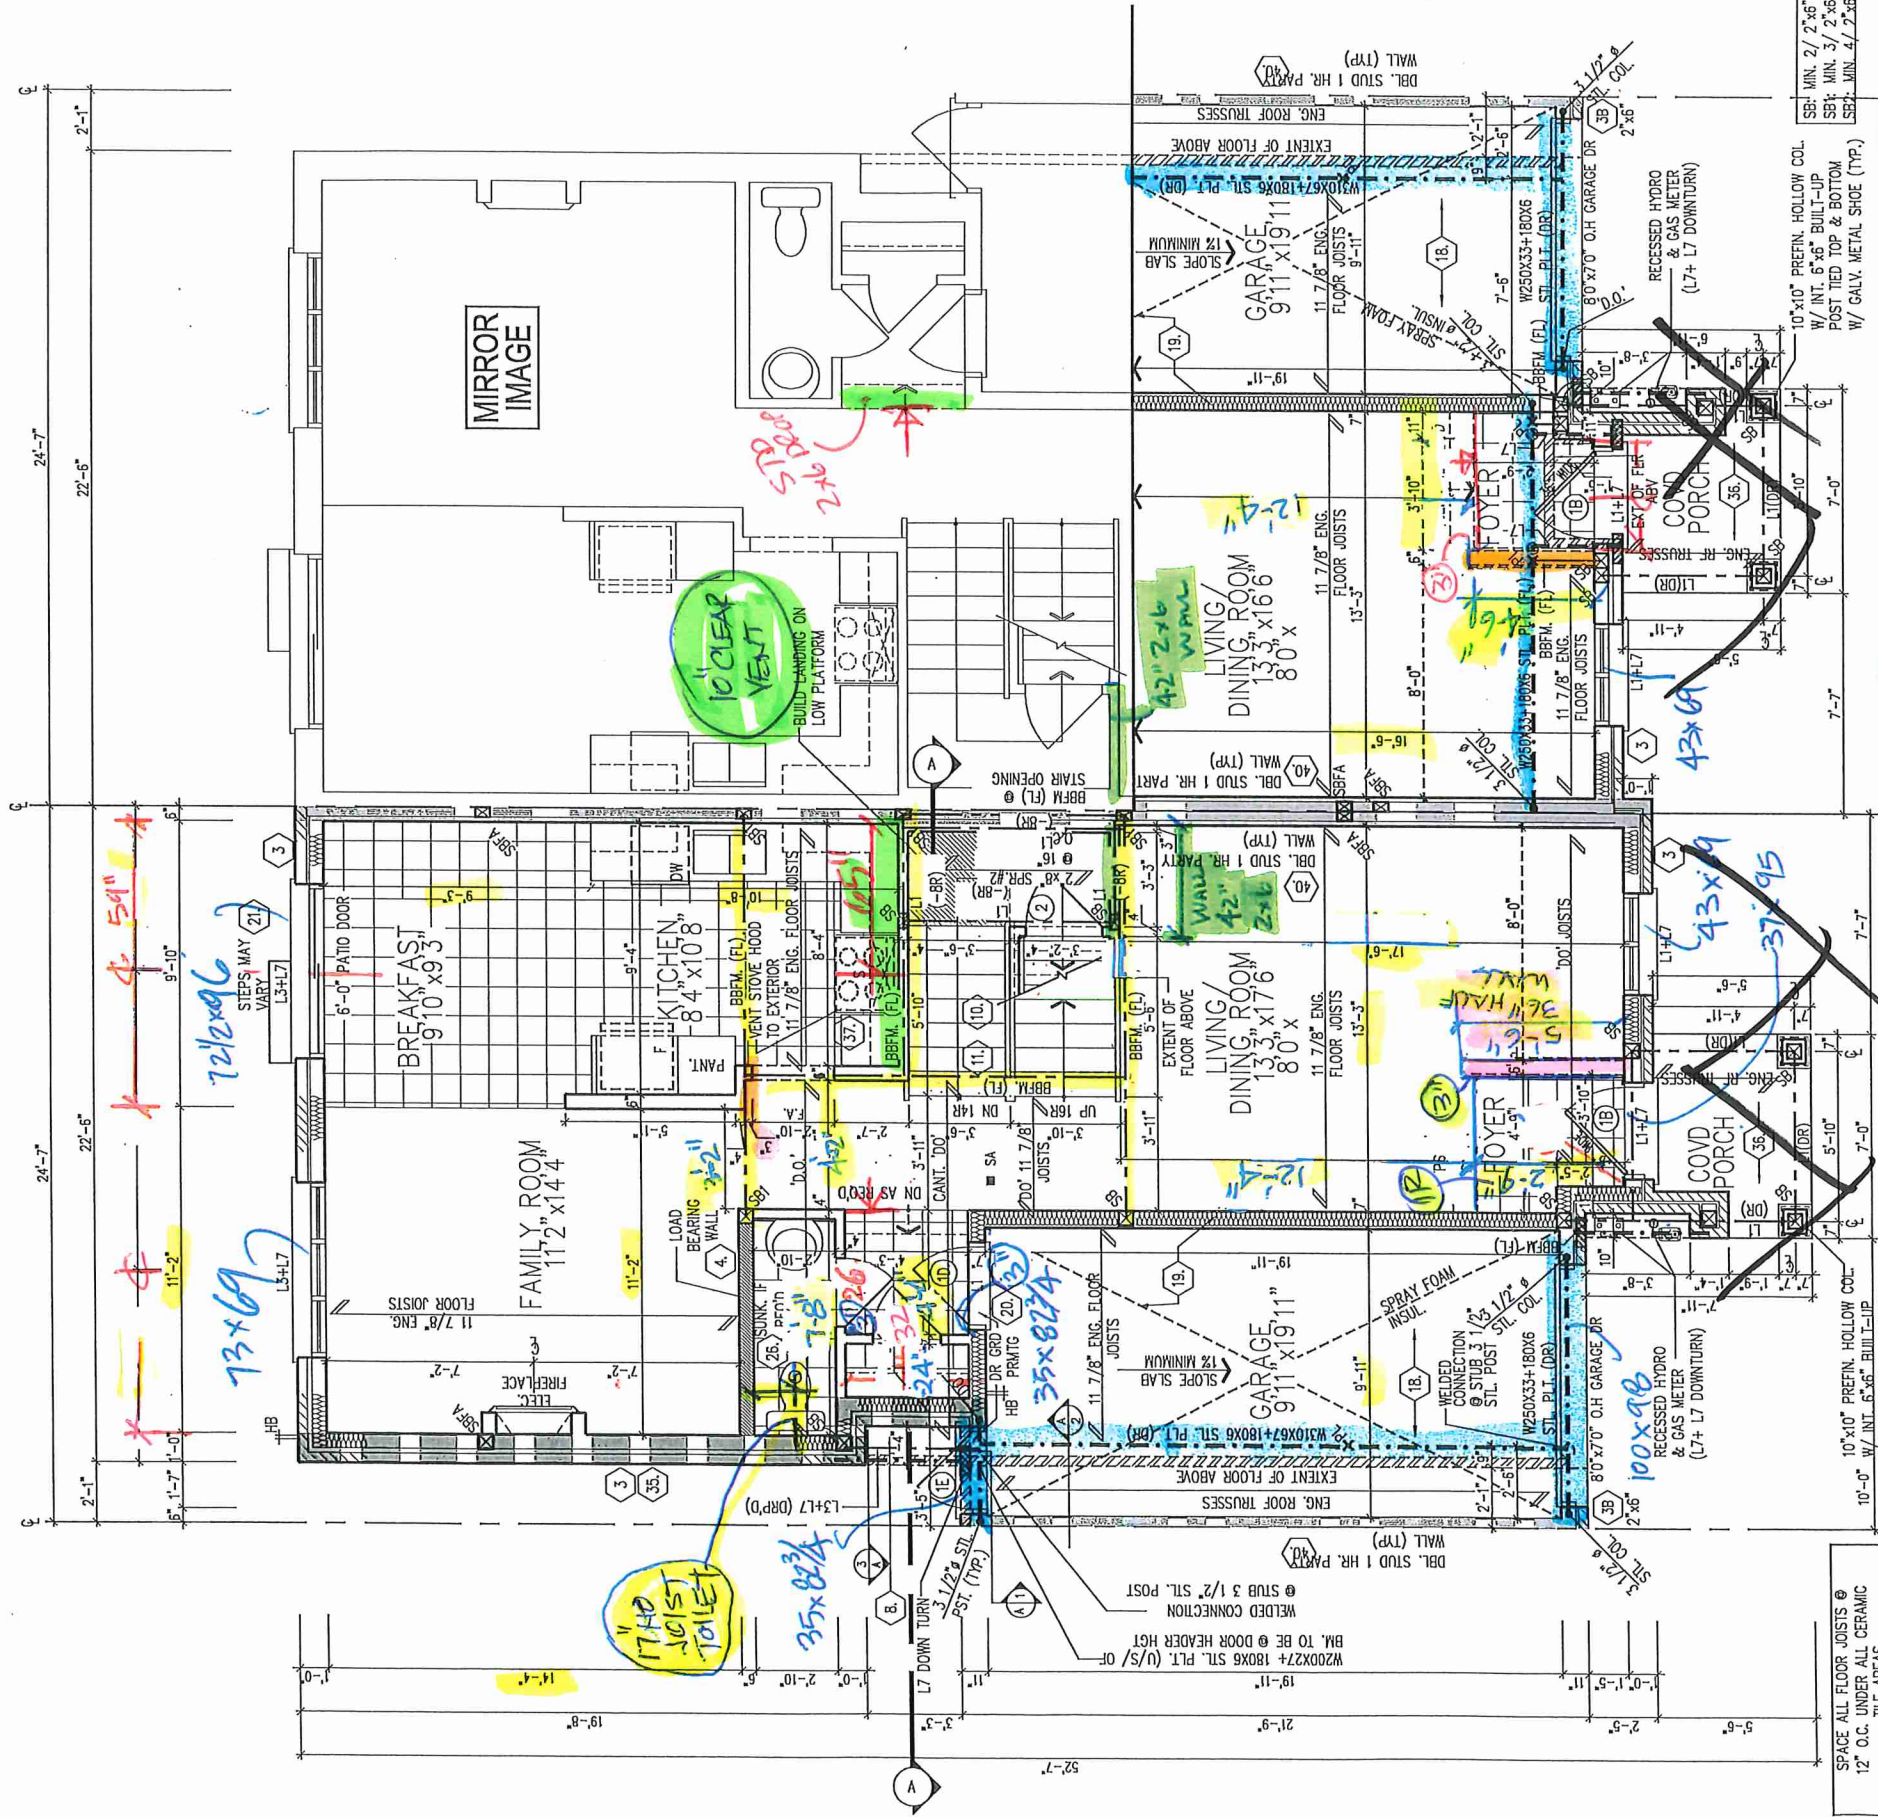

***See Elev. B2**



GROUND FLOOR PLAN ELEV 'A1' (REV)

PART. GROUND FLOOR PLAN ELEV 'A2'

GROUND FLOOR PLAN ELEV 'A1' (REV) / 'A2'



BUL 290 - 9

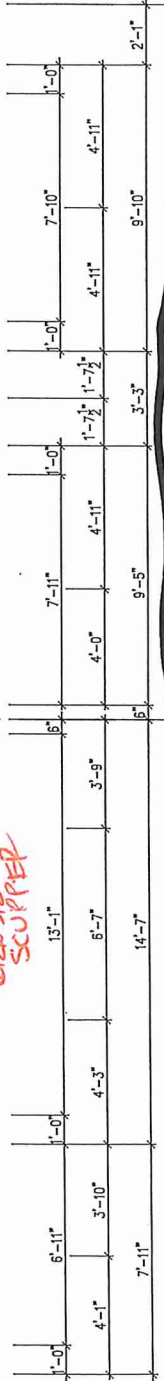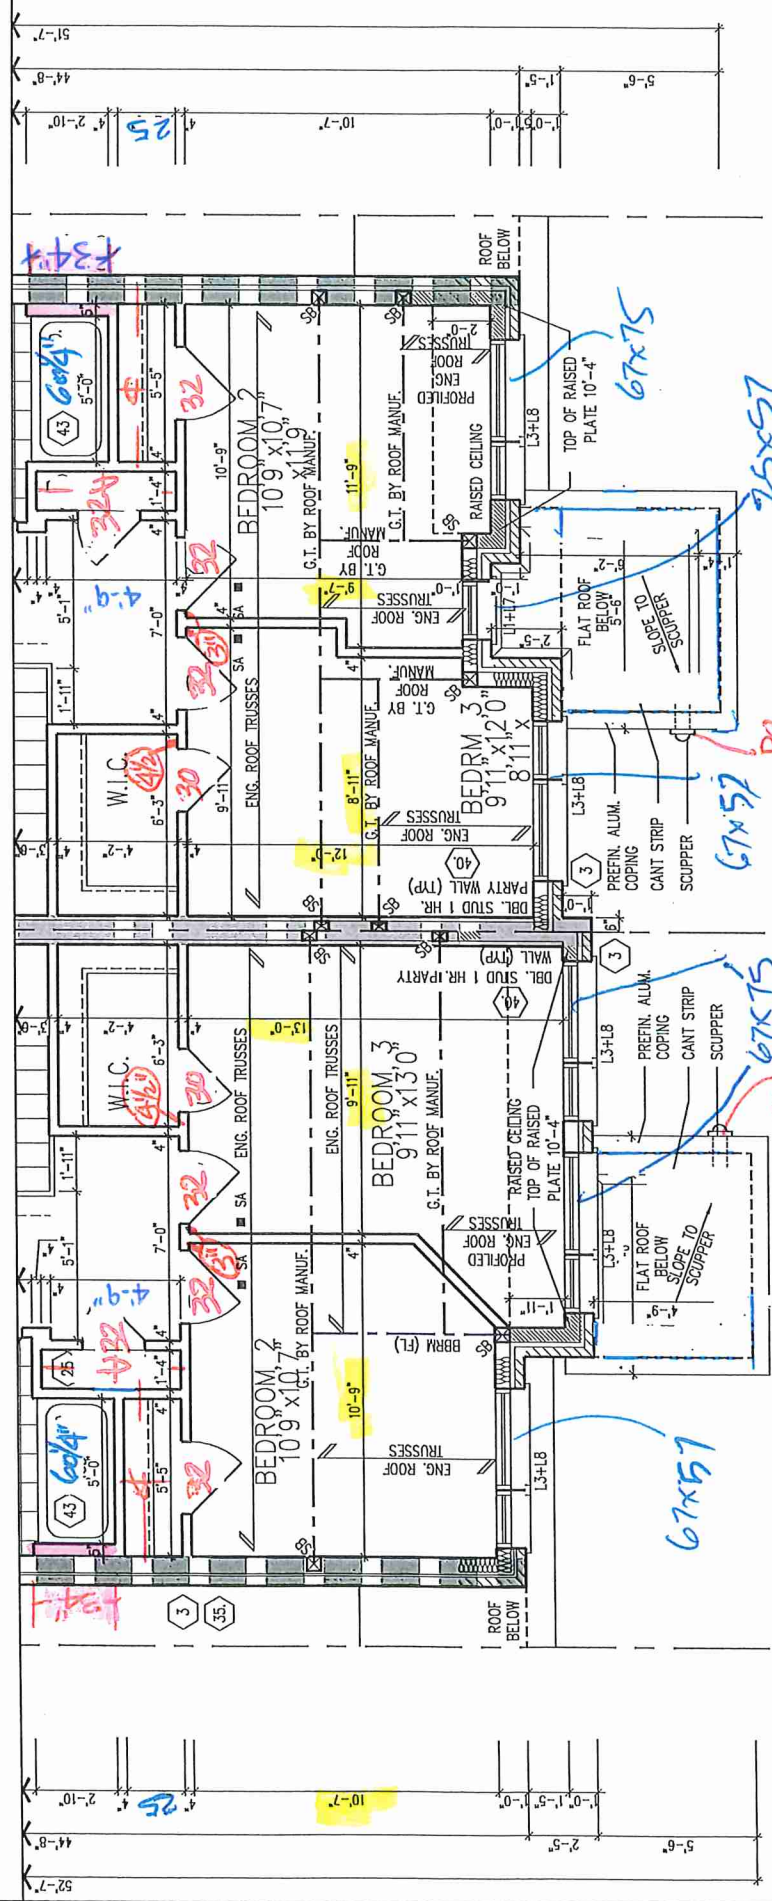

PARTIAL SECOND FLR PLAN ELEV
'B1' (REV)

PART. SCND. FLR PLAN ELEV 'B2'
FLIPPED

REFER TO ROOF TRUSS
MANUFACTURER'S DRAWINGS FOR
LAYOUT, SPACING, INSTALLATION
DETAILS AND HANGER SIZES.

REFER TO STANDARD FLOOR PLAN FOR
COMPLETE CONSTRUCTION NOTES &
DIMENSIONS

SB: MIN. 2/ 2"x6" SPF OR 3/ 2"x4" SPF
SBI: MIN. 3/ 2"x6" SPF OR 4/ 2"x4" SPF
SBD: MIN. 4/ 2"x6" SPF OR 5/ 2"x4" SPF

TH #9




BK 290 - 9

PARTIAL SECOND FLR PLAN ELEV 'B1' (REV)/ B2

Royal Pine Homes/Summer Ridge Estates Inc.-216051 UNIT-2501
"MAYFIELD VILLAGE", BRAMPTON, ON. REV.2024.03.14

Drawn By WD Checked By DS Scale 3/16"=1'-0" File Number 216051WS2501 Page Number 7 of 16

All drawings specifications related documents and design are the copyright property of Royal Pine Homes. Reproduction of this property in whole or in part is strictly prohibited without R.P.H. written permission (R.P.H. assumes no responsibility or liability for this property unless it bears the appropriate BCIN number and official signature.

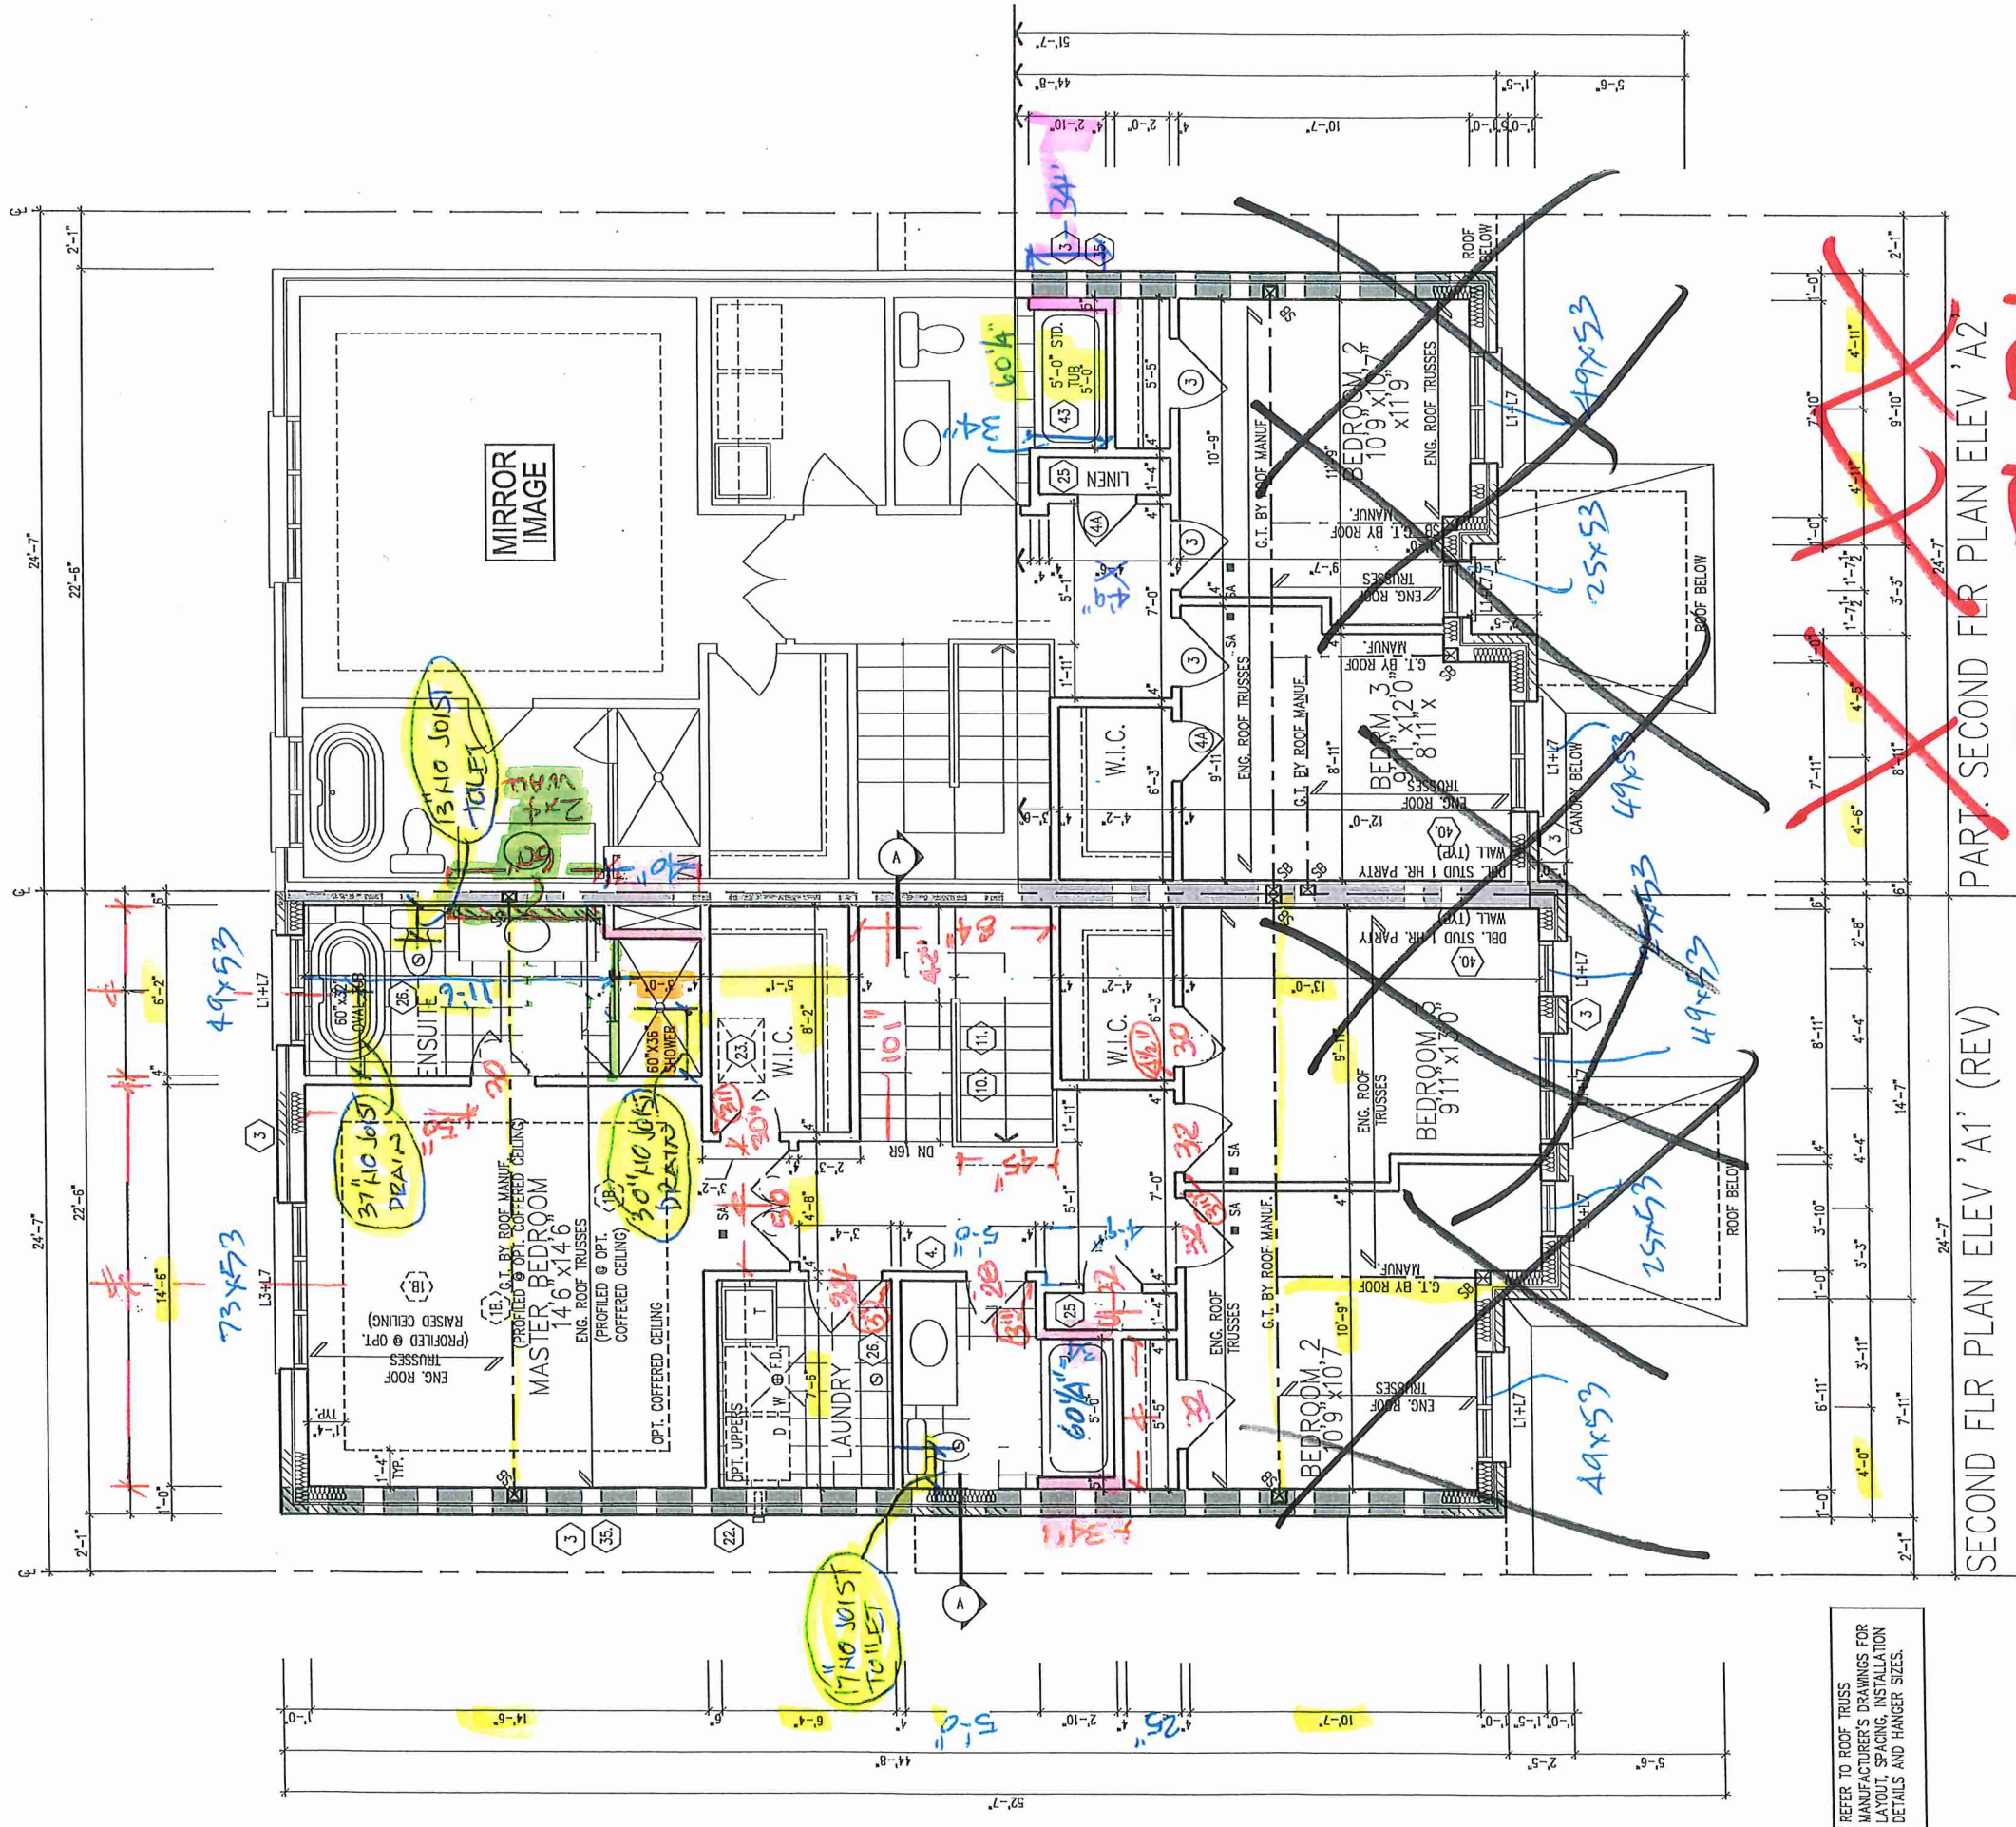

REFER TO ROOF TRUSSES MANUFACTURER'S DRAWINGS FOR LAYOUT, SPACING, INSTALLATION DETAILS AND HANGER SIZES.

* 1 1/2" DOORS 83
* 2x4L SHAPE BOTTOM
* 2x4L SHAPE EVERY 8
* WINDOWS SEE ELEV.

See Elev.
"B2"

SB: MIN. 2/ 2"x8" SPF OR 3/ 2"x4" SPF
SB1: MIN. 3/ 2"x6" SPF OR 4/ 2"x4" SPF
SB2: MIN. 4/ 2"x6" SPF OR 5/ 2"x4" SPF



SECOND FLR PLAN ELEV 'A1' (REV) / 'A2'

Royal Pine Homes/Summer Ridge Estates Inc.-216051 UNIT-2501
"MAYFIELD VILLAGE", BRAMPTON, ON. REV.2024.03.14



BK 290-9

Drawn By: WD
Checked By: DS
Scale: 3/16"=1'-0"
File Number: 216051WS2501
Page Number: 5 of 16

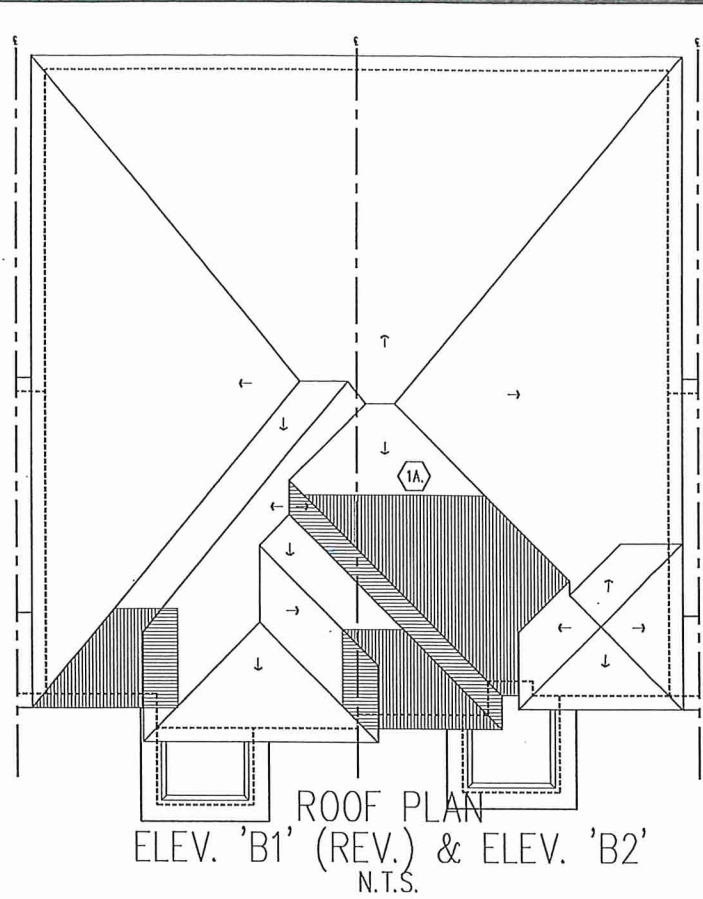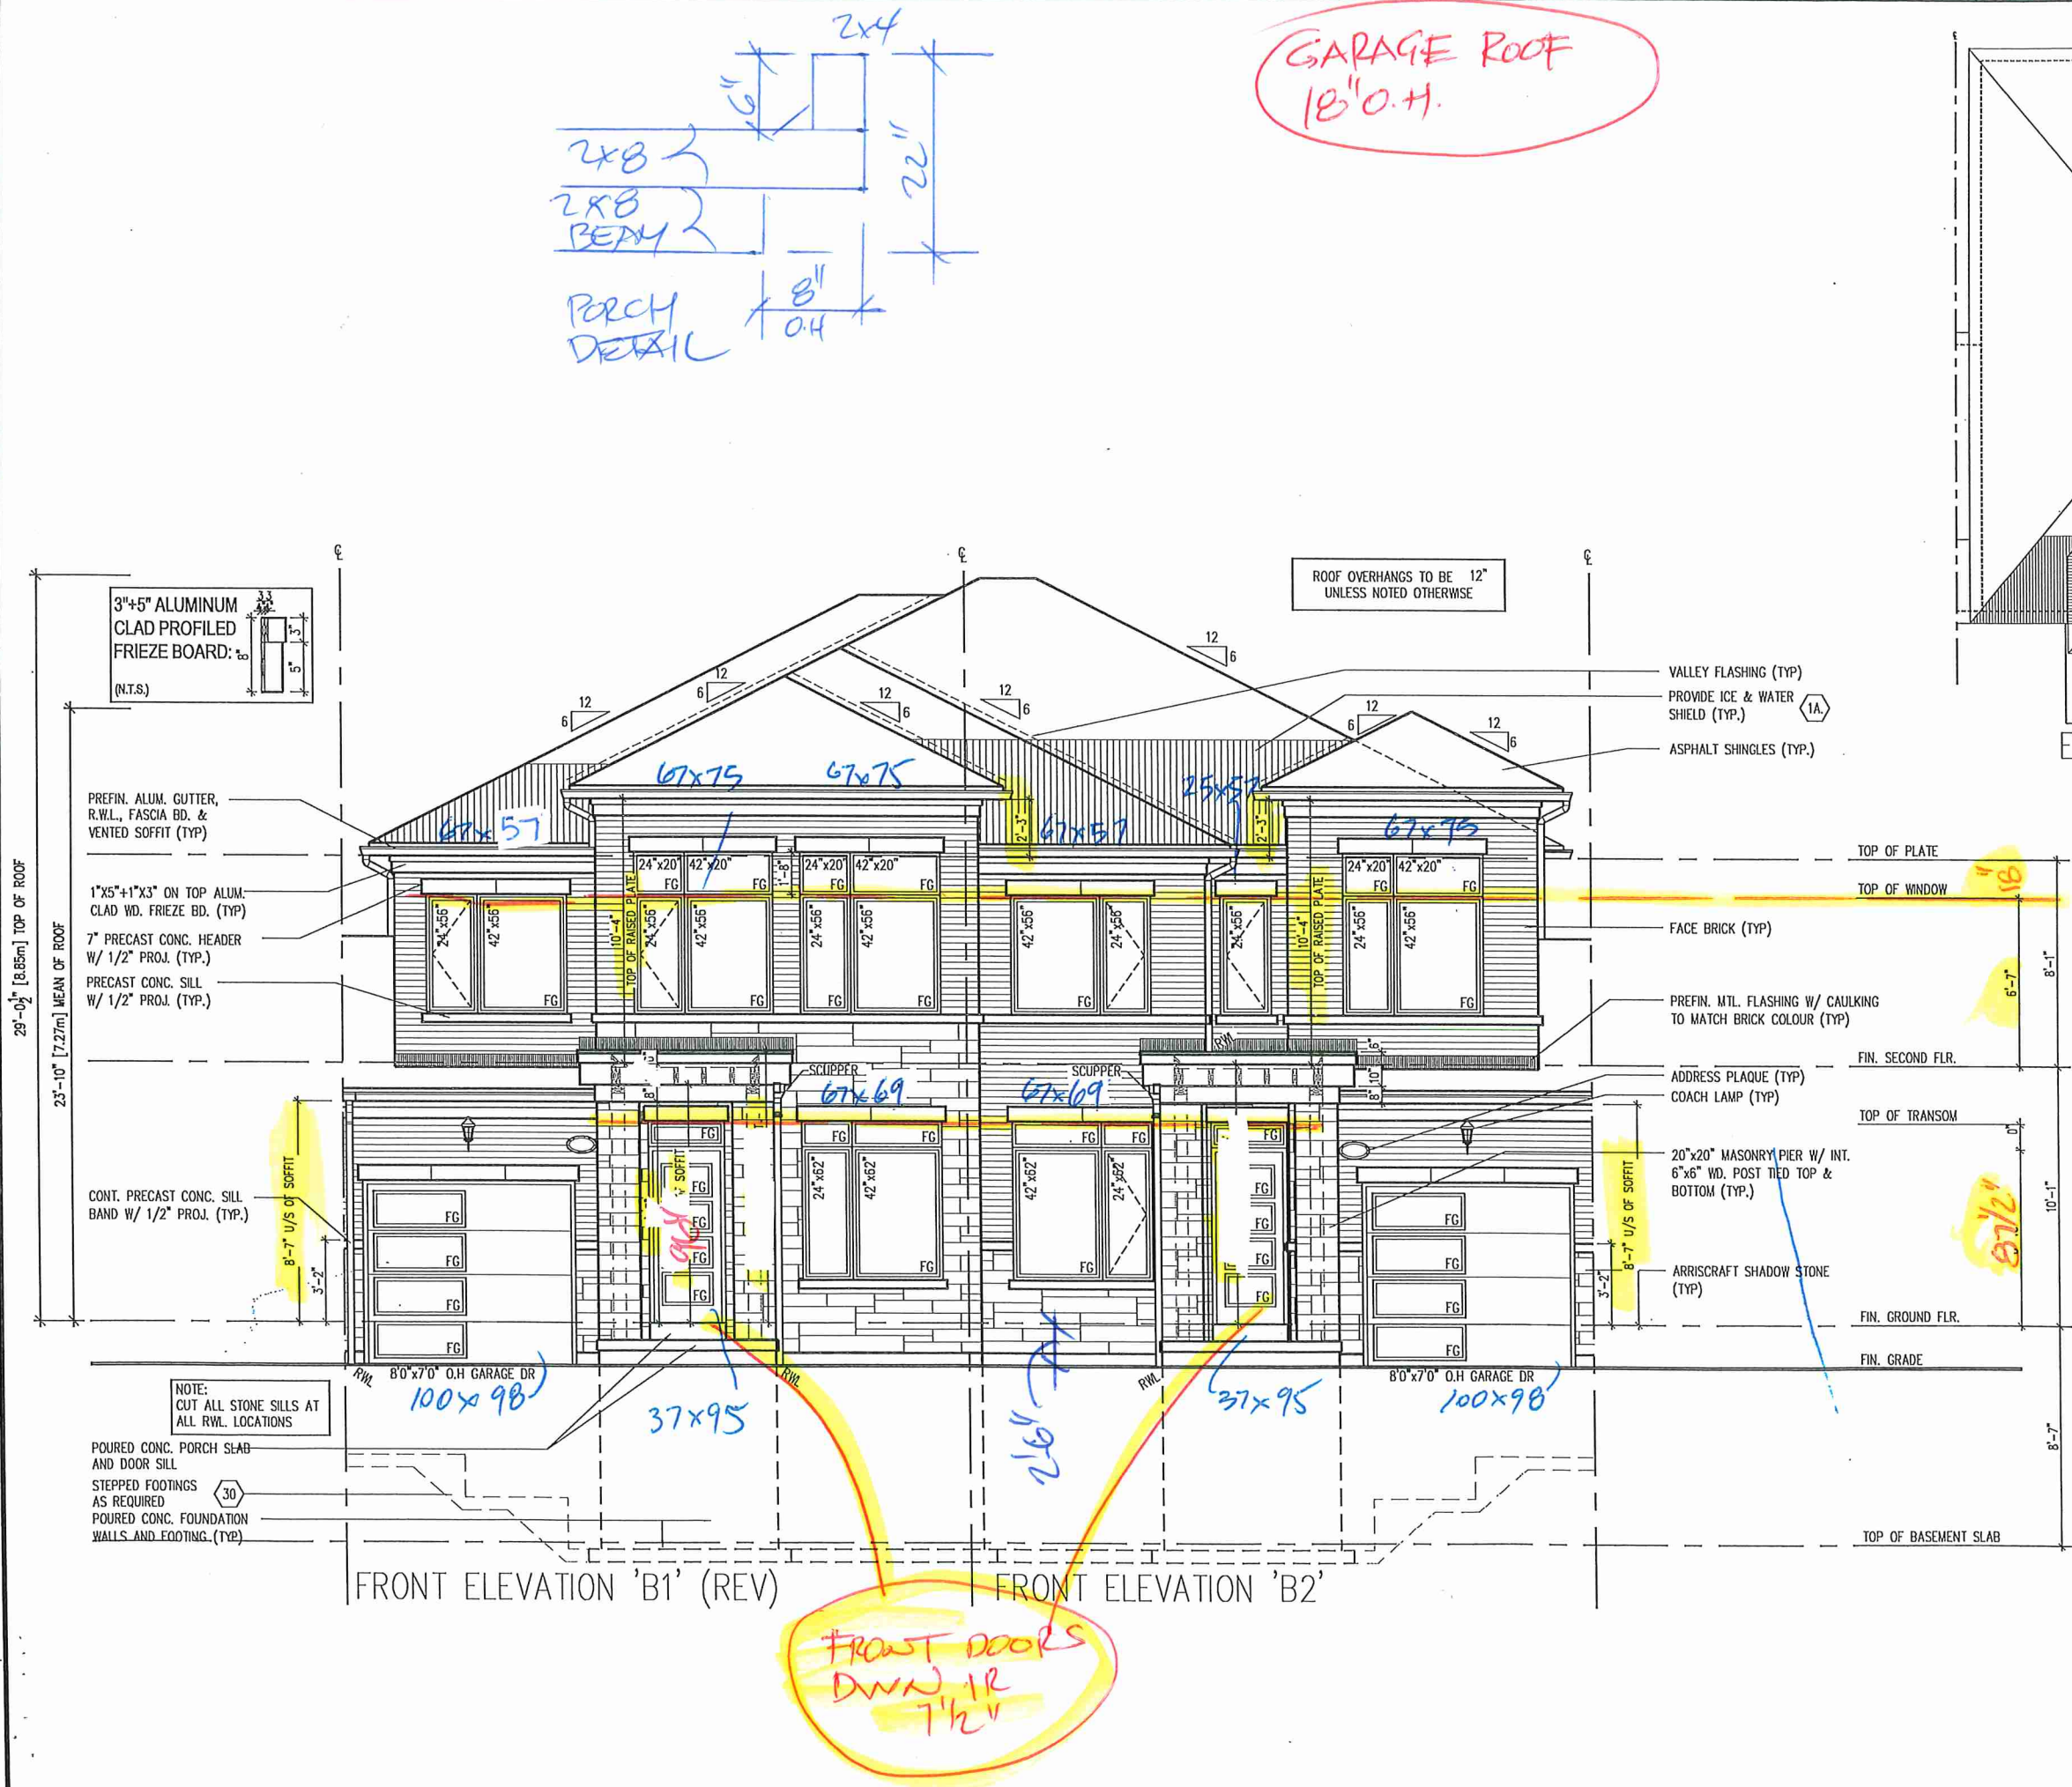


FRONT ELEVATION EL. B1 (REV) AND EL. B2/ ROOF PLAN

Royal Pine Homes/Summer Ridge Estates Inc.-216051 UNIT-2501
"MAYFIELD VILLAGE", BRAMPTON, ON.
REV.2024.03.14



BK 290 - 9

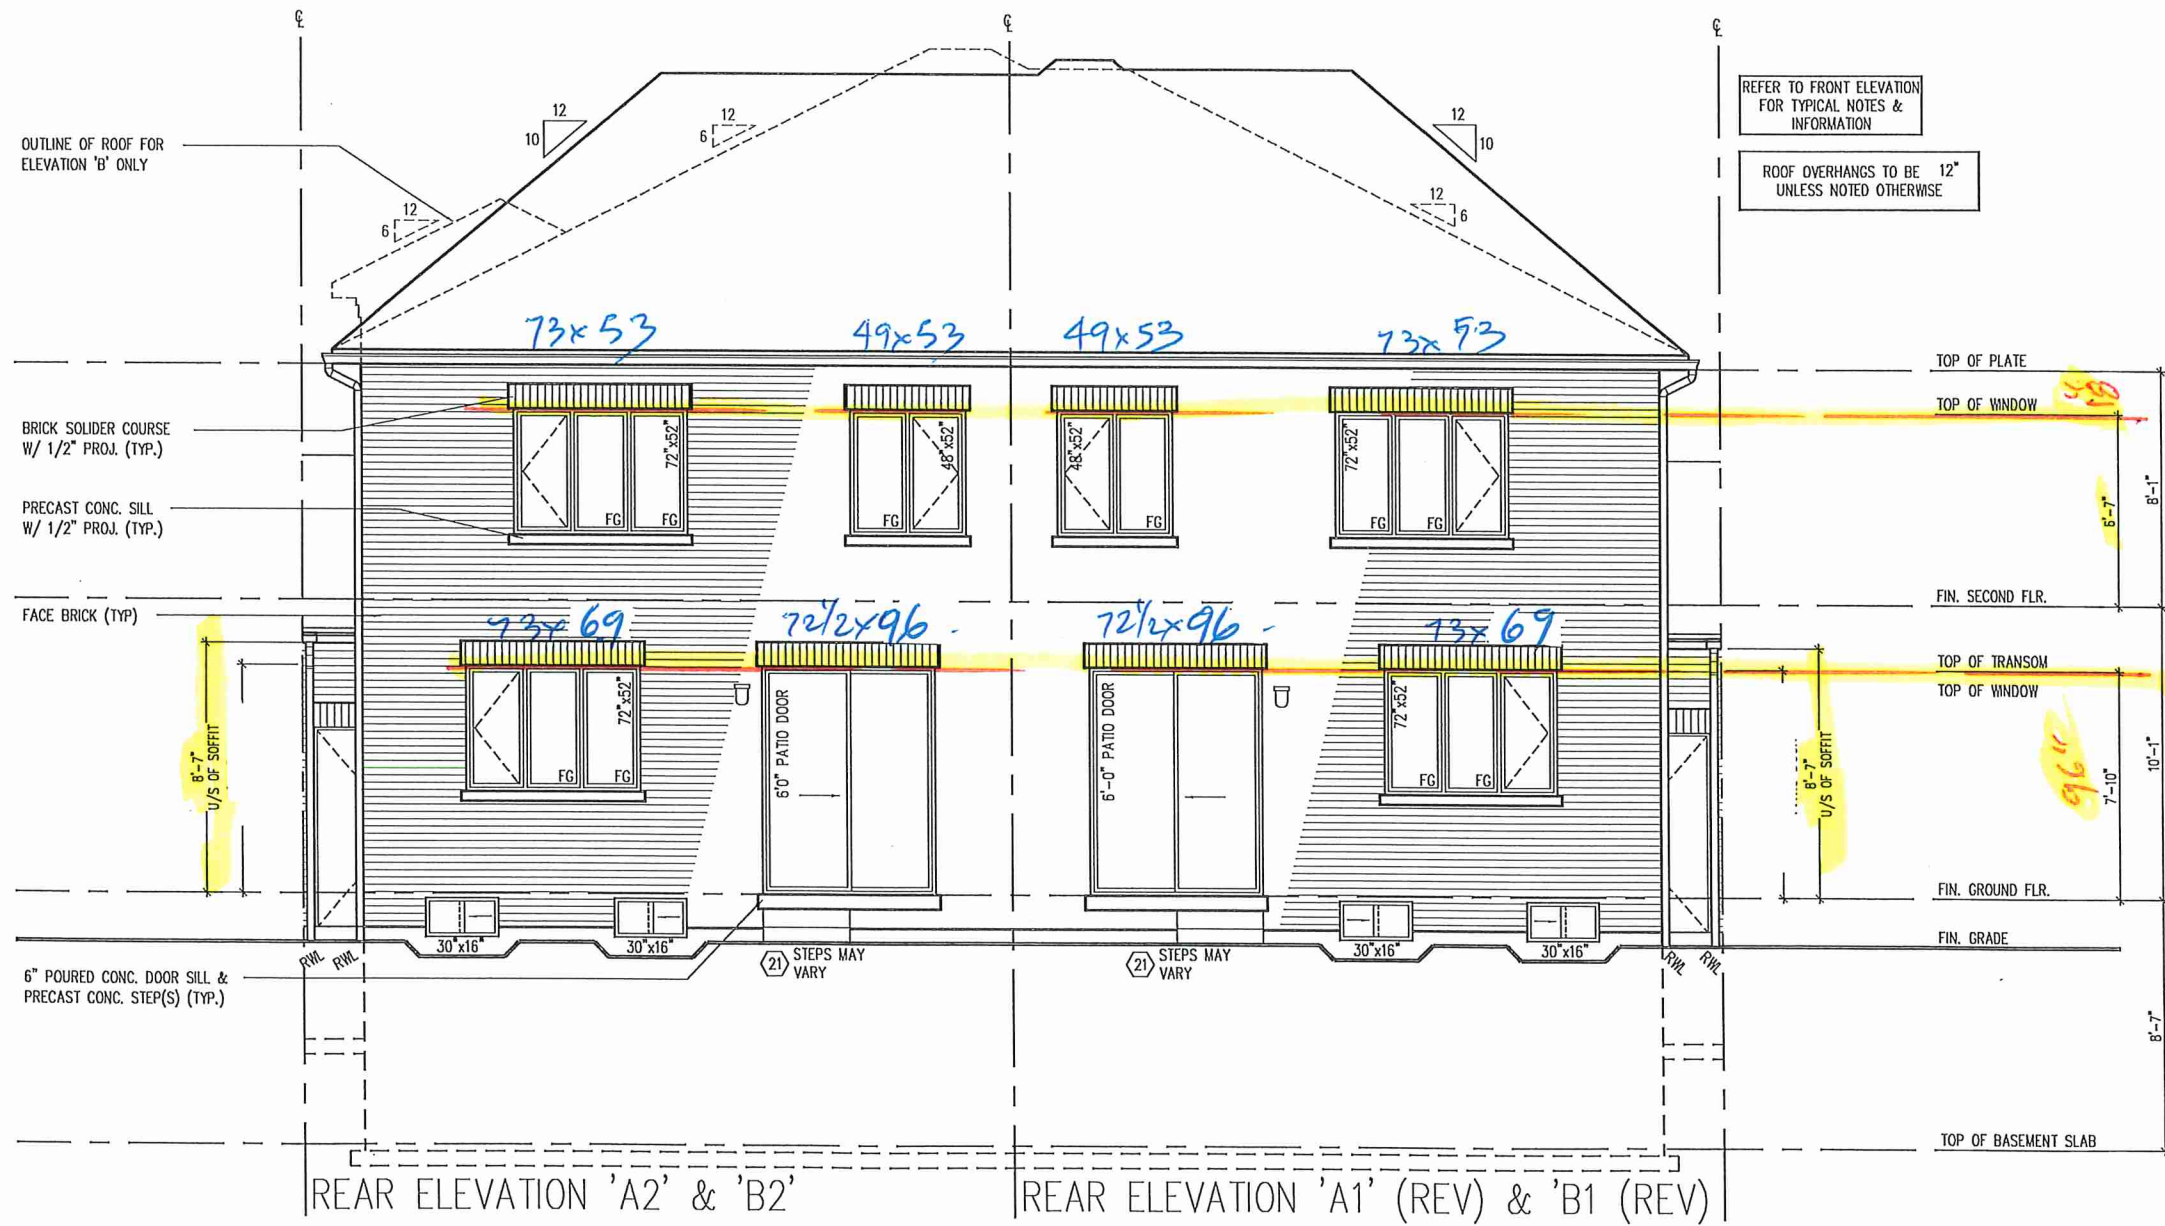

REAR ELEVATION EL. 'A2', 'B2' & 'A1' REV, 'B1' REV


Royal Pine Homes/Summer Ridge Estates Inc.-216051 UNIT-2501
"MAYFIELD VILLAGE", BRAMPTON, ON. REV.2024.03.14




BK 290-9

Drawn By: WD
Checked By: DS
Scale: 3/16"=1'-0"
File Number: 216051WS2501
Page Number: 11 of 14

3550 Langstaff Road, Suite 200 Woodbridge, Ontario, L4L 9G8
All drawings specifications related documents and design are the copyright property of Royal Pine Homes. Reproduction of this property in whole or in part is strictly prohibited without R.P.H. written permission (R.P.H. assumes no responsibility or liability for this property unless it bears the appropriate BCIN number and original signature).

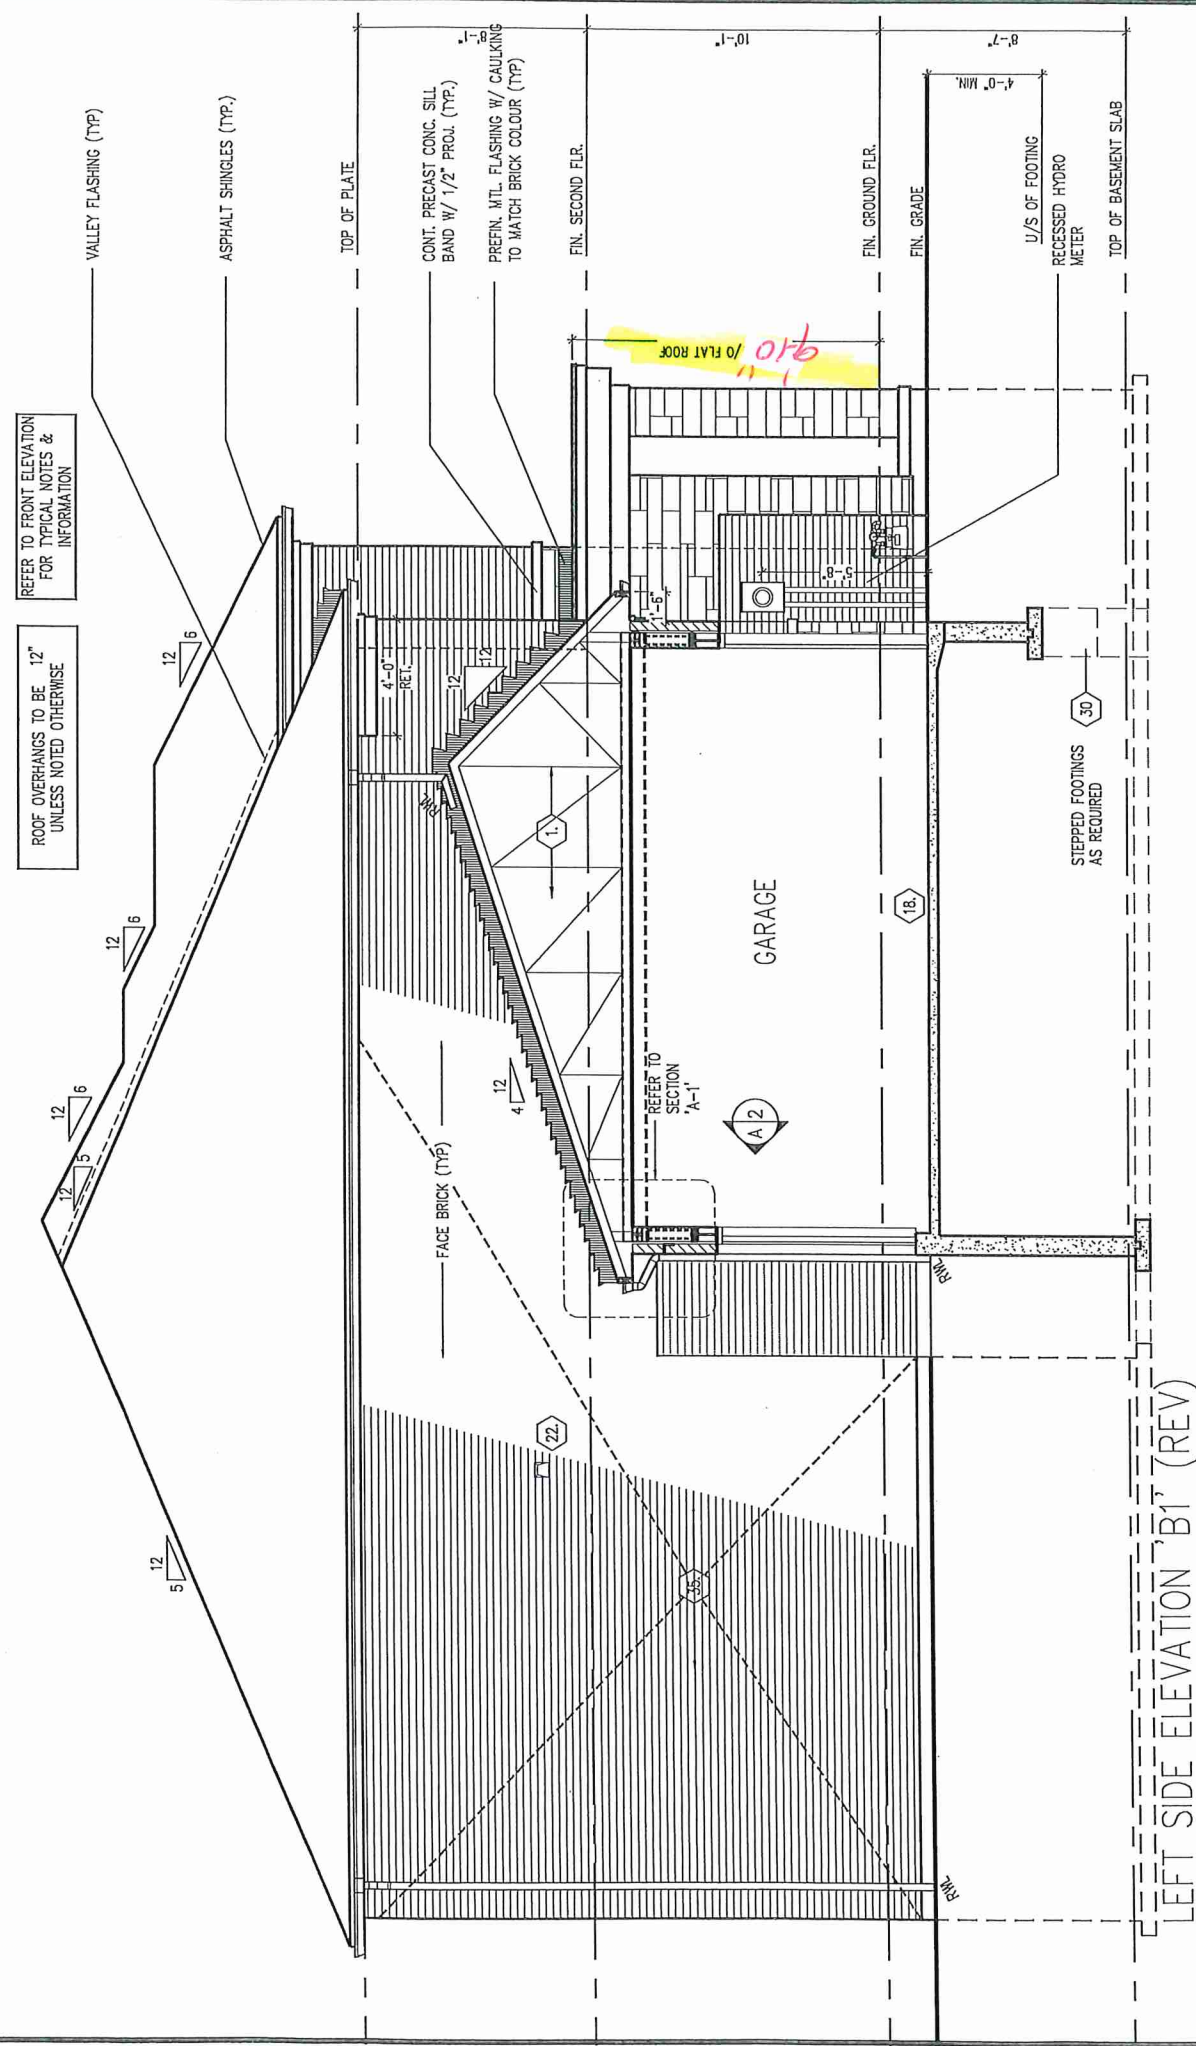

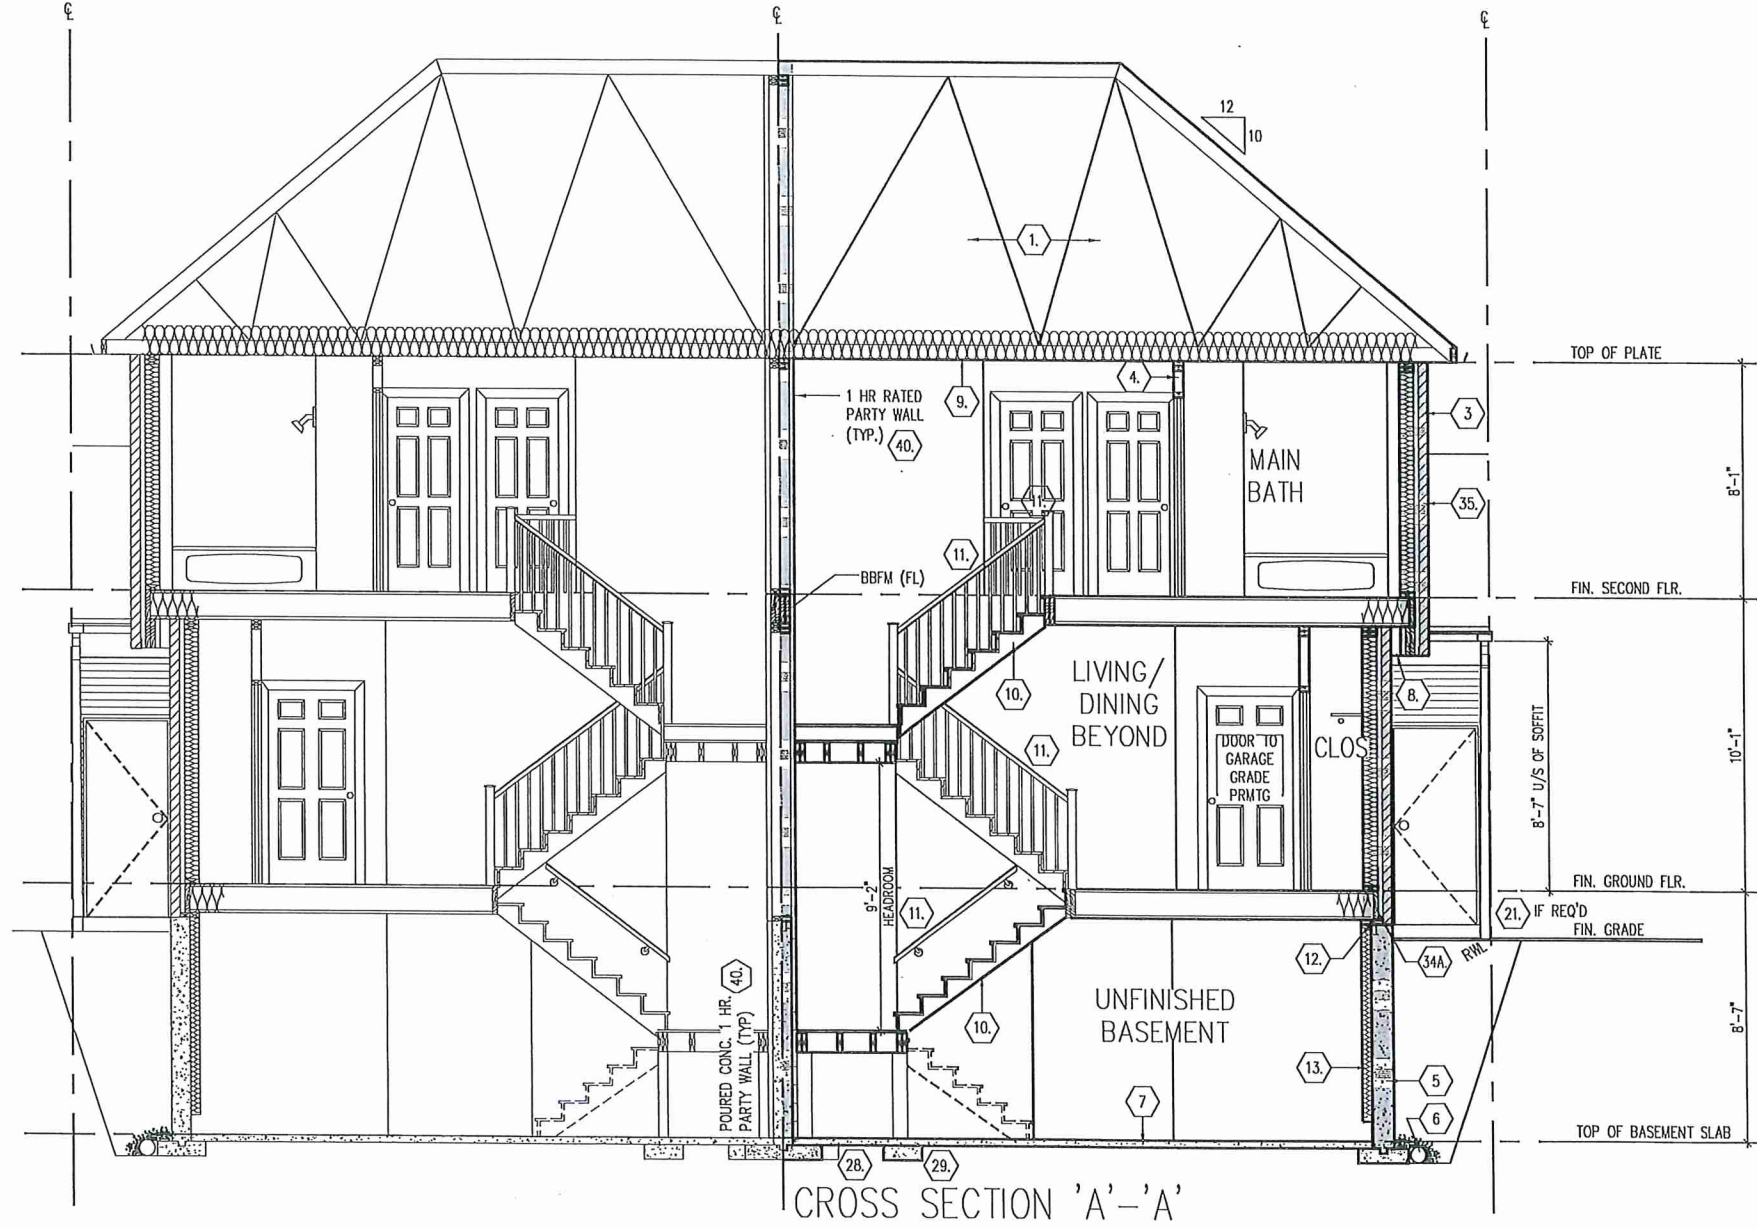

CROSS SECTION 'A'-A'

Royal Pine Homes/Summer Ridge Estates Inc.-216051 UNIT-2501
"MAYFIELD VILLAGE", BRAMPTON, ON. REV.2024.03.14



BLK 290-9

Drawn By: WD
Checked By: DS
Scale: 3/16"=1'-0"
File Number: 216051WS2501
Page Number: 14 of 14

