



BK 290-10

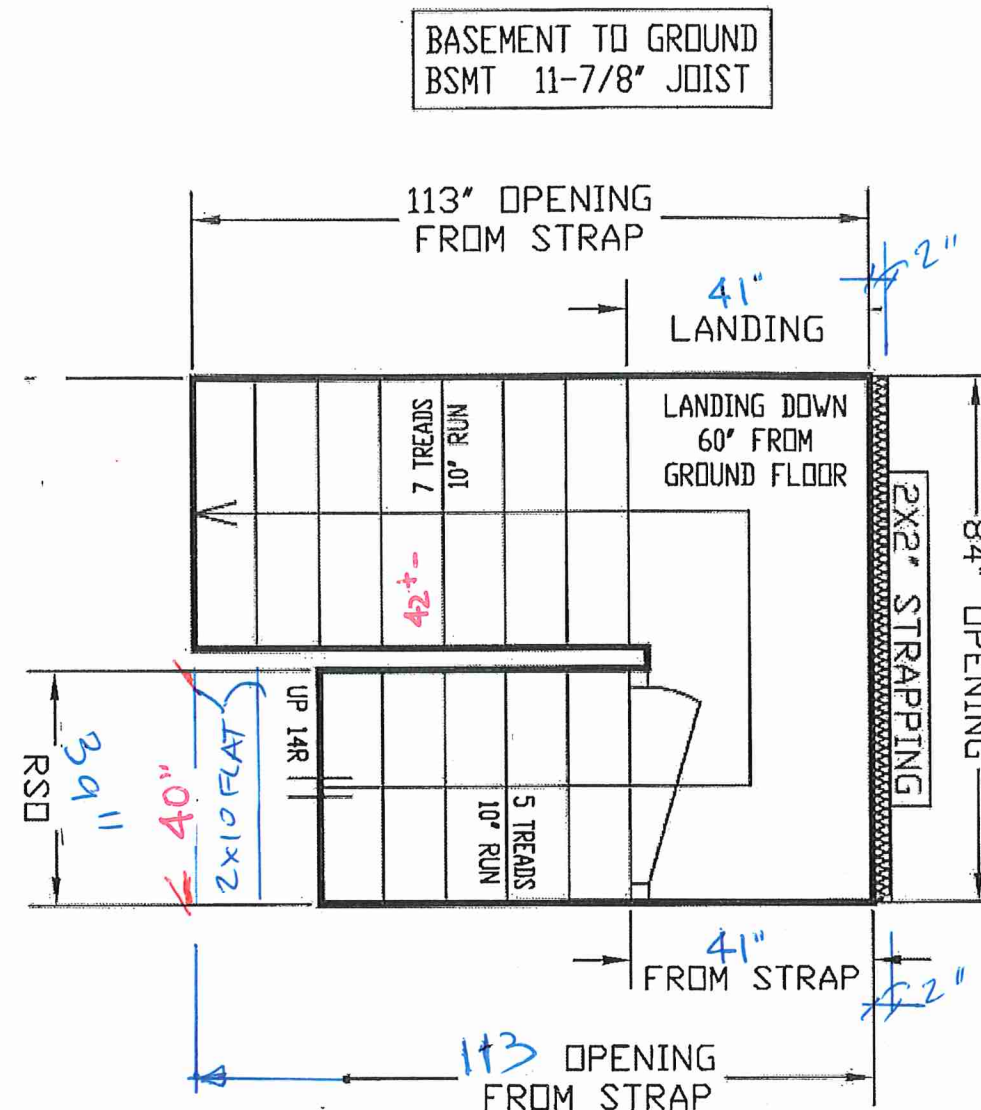

< GARAGE LEFT

ALL OPENINGS ARE ALLOWED FOR 1 LAYER OF DRY WALL
ANY ADDITIONAL LAYERS MUST BE ALLOWED BY CARPENTERS

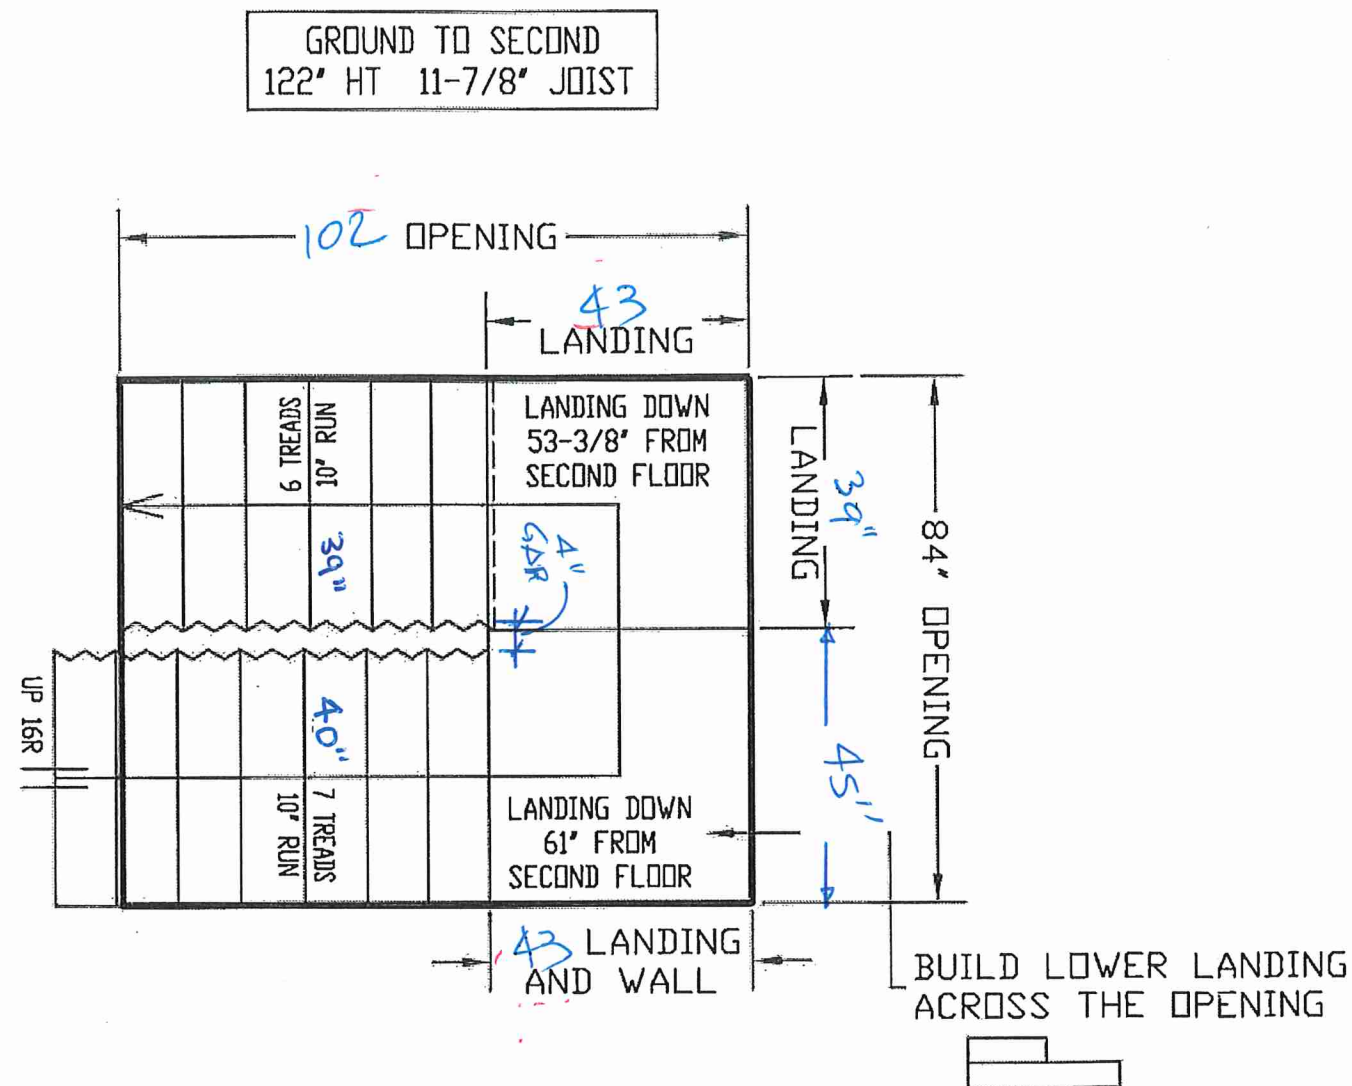

ALL LANDINGS TO BE SUPPLIED AND SUPPORTED BY OTHERS UNLESS SPECIFIED ABOVE

ANY STRAPPING ALLOWANCES TO BE COMPENSATED BY CARPENTERS


ALL STAIR DIMENSIONS MAY BE MODIFIED FROM ORIGINAL BLUE PRINTS OR SPECS AS SUPPLIED TO ALPA STAIRS AND RAILINGS INC. MEASUREMENTS SHOWN ON LAYOUTS ARE REQUIRED TO INSTALL OUR STAIRS. ANY PROBLEM WITH HEADROOM OR STRAPPING ALLOWANCES, ALPA STAIRS AND RAILINGS INC. WILL NOT BE RESPONSIBLE. STAIR LAYOUTS SHOULD BE CHECKED BY CARPENTERS OR SITE SUPERS TO MAKE SURE THERE ARE NO DISCREPANCIES BEFORE PROCEEDING WITH CONSTRUCTION

ALPA STAIRS AND RAILINGS INC.
3770 NASHUA DRIVE, UNIT 3 MISSISSAUGA, ONTARIO L4V 1M6
TEL: (905) 694-9556 | www.alpastairs.com



SITE		NAME	DATE
MAYFIELD VILLAGE		PARAMJEET	JULY 11, 2024
LOT #		CLIENT	
Model	2502	SUMMER RIDGE EST. INC	
		LAYOUT #	
		SCALE: 1/35	

PART BASEMENT
PLAN ELEV 'A1' & 'B1'
(REV) N/FIREMALL
(EL. 'A2' & 'B2'
SIMILAR)

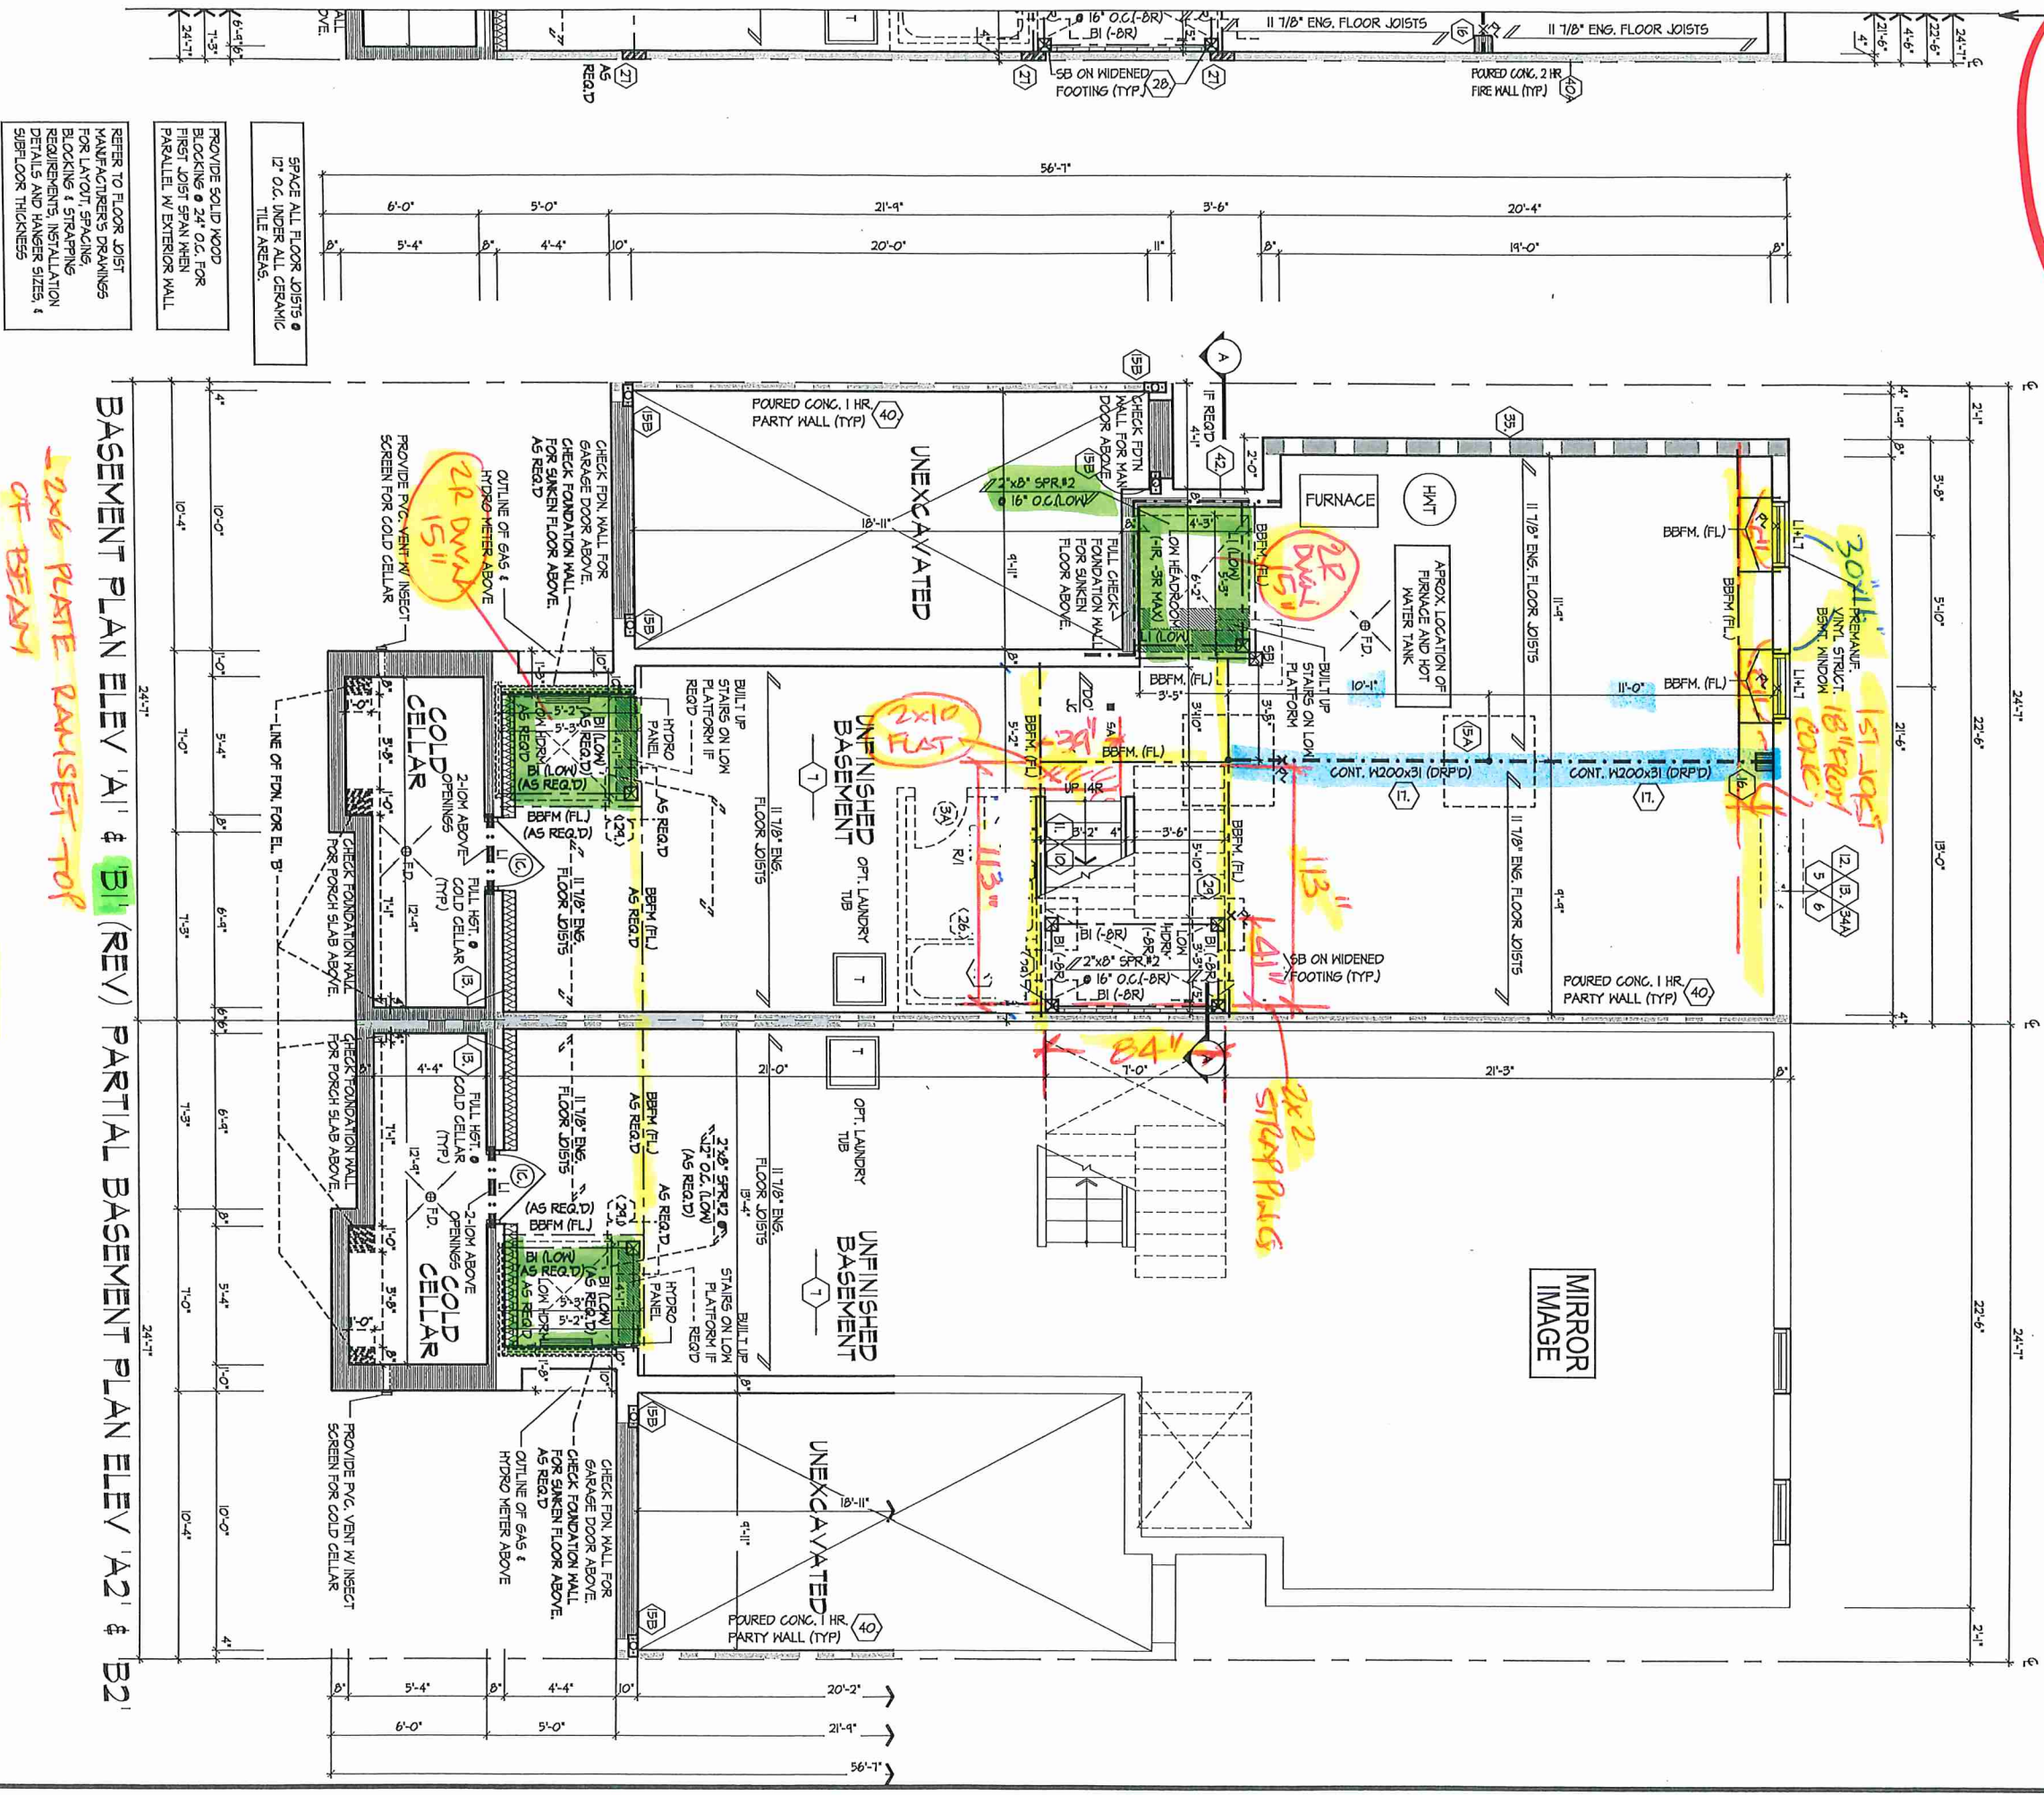

PLK 290-10



BASEMENT PLAN ELEV 'A1' & 'B1' (REV) / 'A2' & 'B2'
Royal Pine Homes/Summer Ridge Estates Inc.-216051 UNIT-2502
'MAYFIELD VILLAGE', BRAMPTON, ON.
REV.2024.03.14


Drawn By: WD
Checked By: DS
Scale: 3/4"=1'-0"
File Number: 216051WS2502
Page Number: 2 of 13

3550 Langstaff Road, Suite 200 Woodbridge, Ontario, L4L 9G3

All drawings specifications related documents and design are the copyright property of Royal Pine Homes. Reproduction of this property in whole or in part is strictly prohibited without R.P.H. written permission (R.P.H. assumes no responsibility or liability for this property unless it bears the appropriate BCIN number and original signature).

PART. GROUND FLOOR
PLAN EL. 'A1' (REV)
W/ FIREWALL
(EL. 'A2' SIMILAR)

-SID. + WINDOWS 96"
-INT. DOORS 83"
-ARCHES 96"
-FRONT DOOR 95"

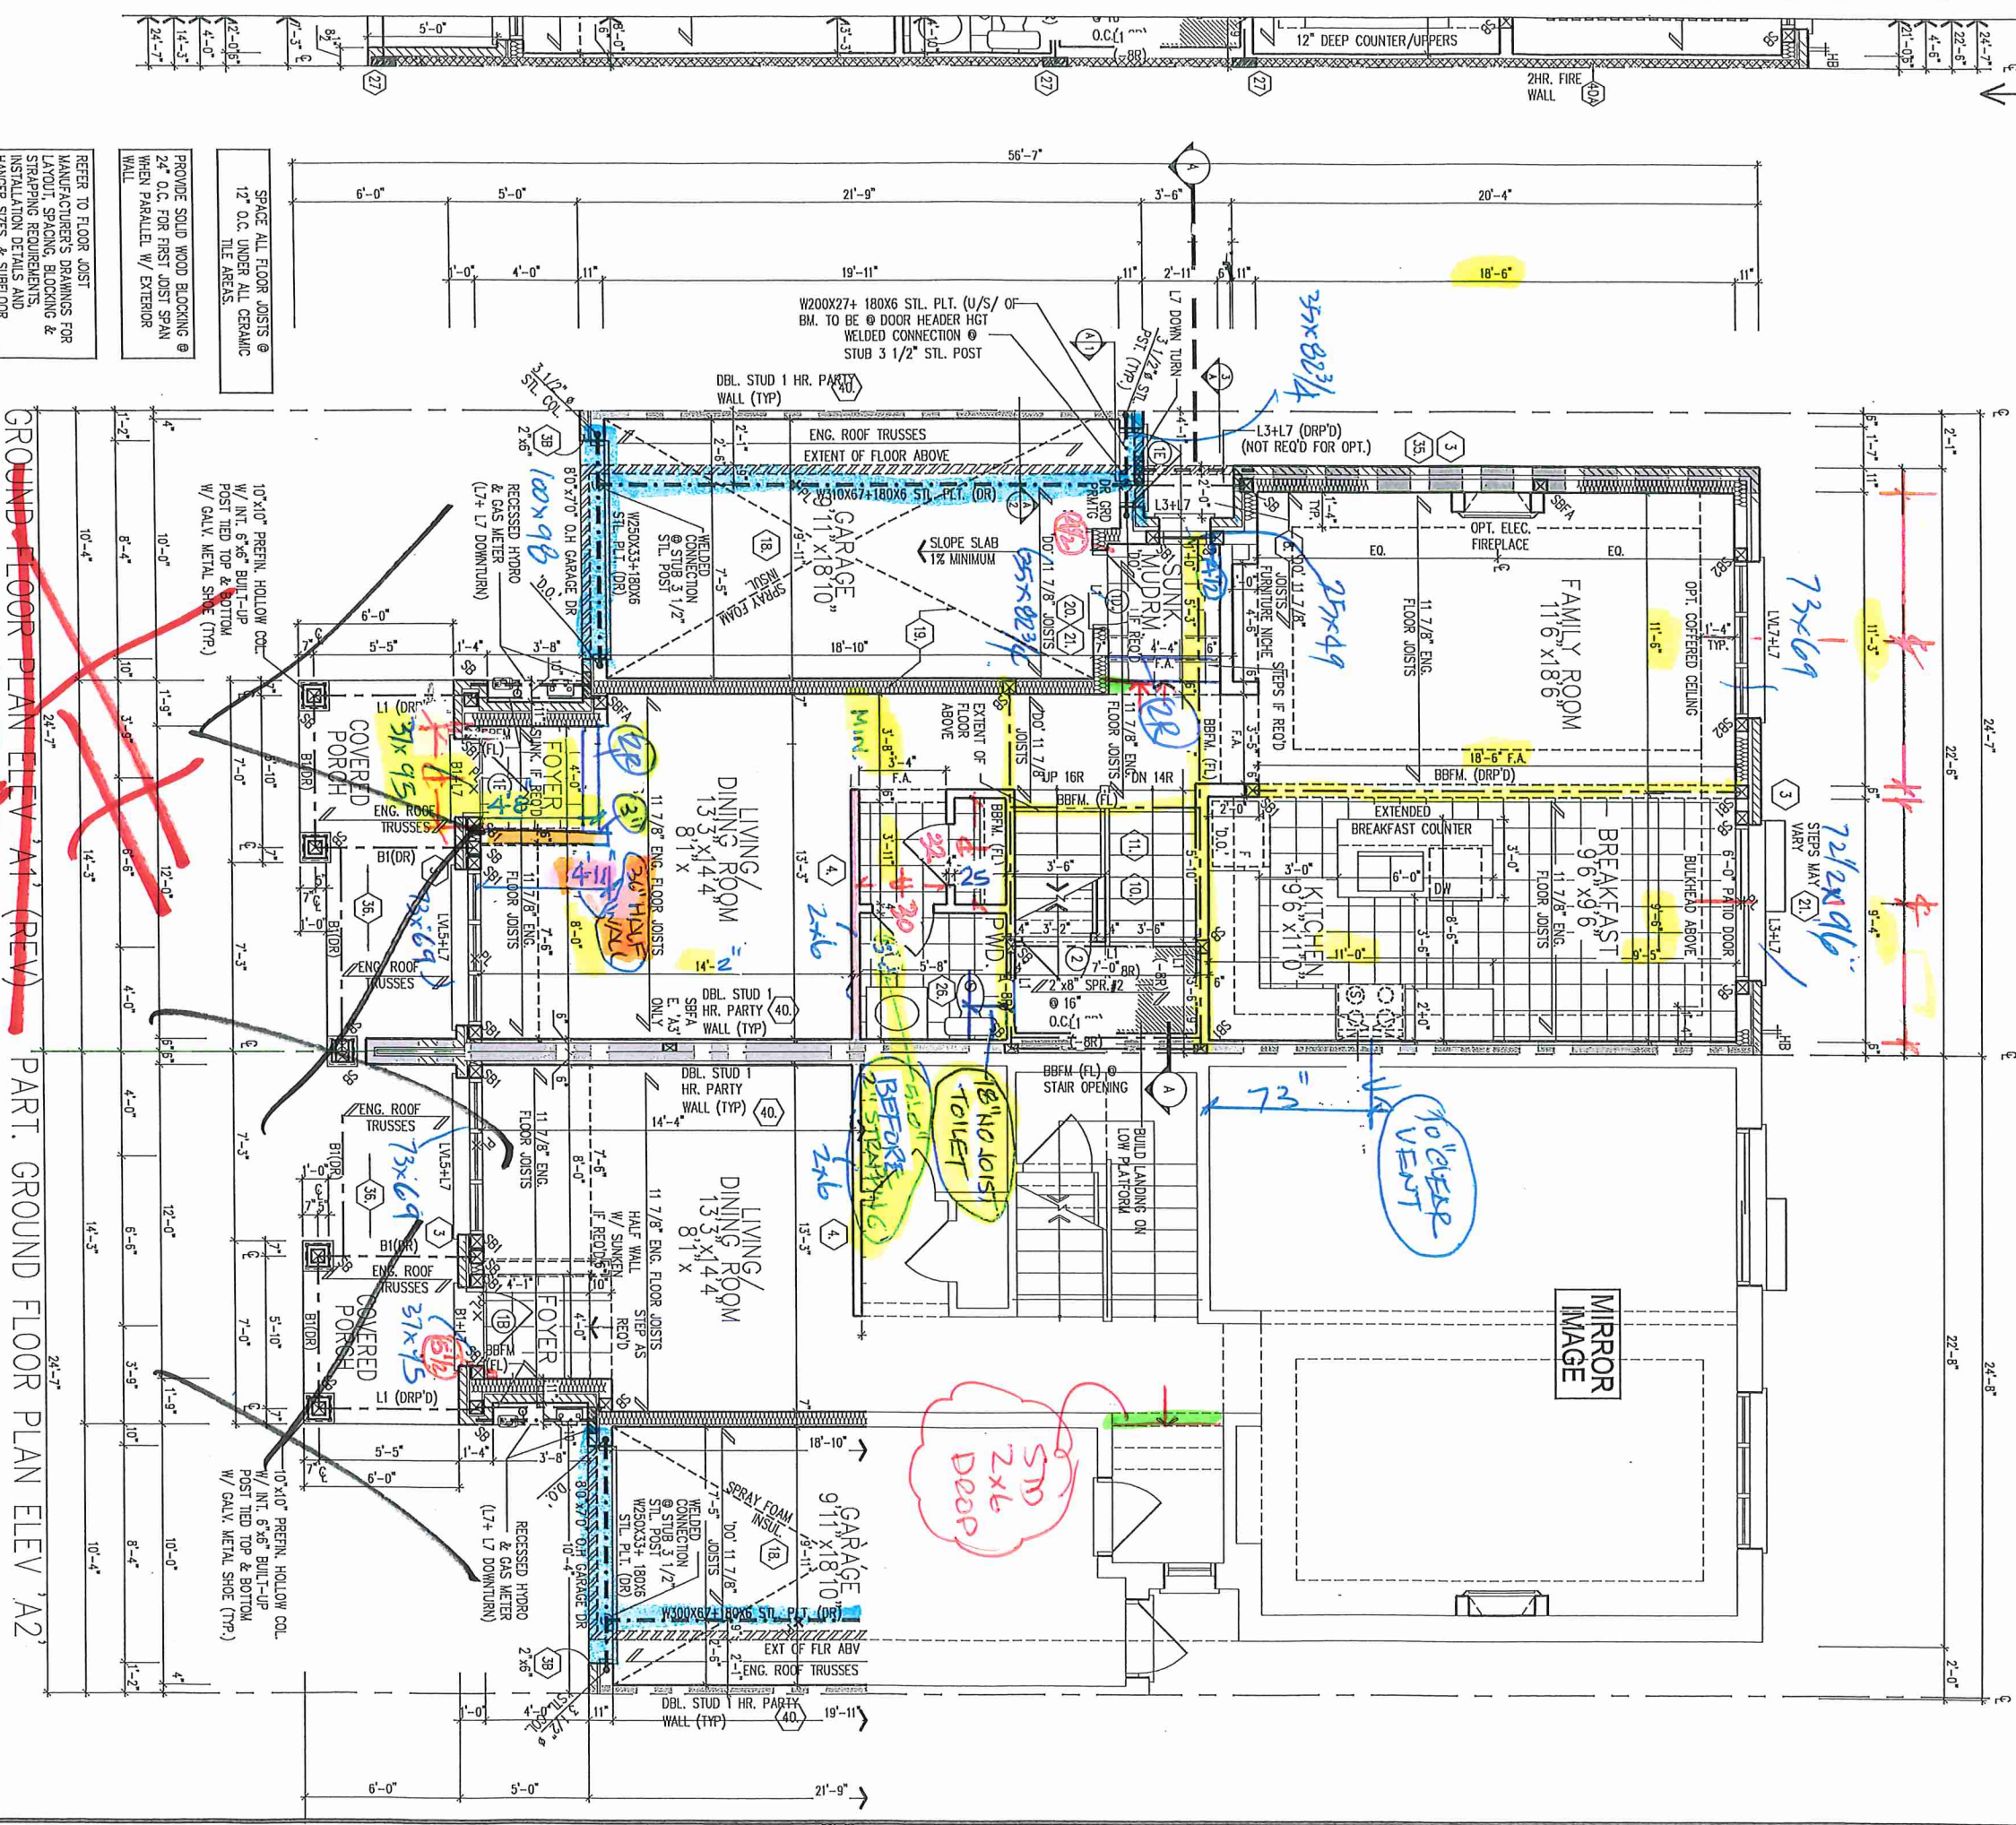

SPACE ALL FLOOR JOISTS @ 12" O.C. UNDER ALL CERAMIC TILE AREAS.

PROVIDE SOLID WOOD BLOCKING @ 24" O.C. FOR FIRST JOIST SPAN WHEN PARALLEL W/ EXTERIOR WALL

REFER TO FLOOR JOIST MANUFACTURER'S DRAWINGS FOR LAYOUT, SPACING, BLOCKING & STRAPPING REQUIREMENTS, INSTALLATION DETAILS AND HANGER SIZES, & SUBFLOOR THICKNESS

GROUND FLOOR PLAN ELEV 'A1' (REV) PART. GROUND FLOOR PLAN ELEV 'A2'

GROUND FLOOR PLAN ELEV 'A1' (REV)/ PART. GROUND FLOOR PLAN ELEV 'A2'



Royal Pine Homes/Summer Ridge Estates Inc.-216051 UNIT-2502
"MAYFIELD VILLAGE", BRAWPTON, ON.
3550 Langstaff Road, Suite 200 Woodbridge, Ontario, L4L 9G8

Drawn By: WD
Checked By: DS
Scale: 3/16"=1'-0"

File Number: 216051WS2502
Page Number: 3 of 17

SB: MIN. 2/ 2"x6" SPF OR 3/ 2"x4" SPF
SB: MIN. 3/ 2"x6" SPF OR 4/ 2"x4" SPF
SB2: MIN. 4/ 2"x6" SPF OR 5/ 2"x4" SPF


REV.2024.03.14

- 11ST. DOORS 83"
- 2x4L SHAPE BOTTOM
- CHORD CELING EVERY 8'
- WINDOWS SEE ELEV.

REFER TO ROOF TRUSS
MANUFACTURER'S DRAWINGS FOR
LAYOUT, SPACING, INSTALLATION
DETAILS AND HANGER SIZES.

OPT. SECOND FLOOR PLAN 'A1' (REV.)
(W/ OPT. 4 BEDROOM)
ELEV. 'A2', 'B1' & 'B2' SIMILAR

PART. SECOND FLR PLAN ELEV 'A2'

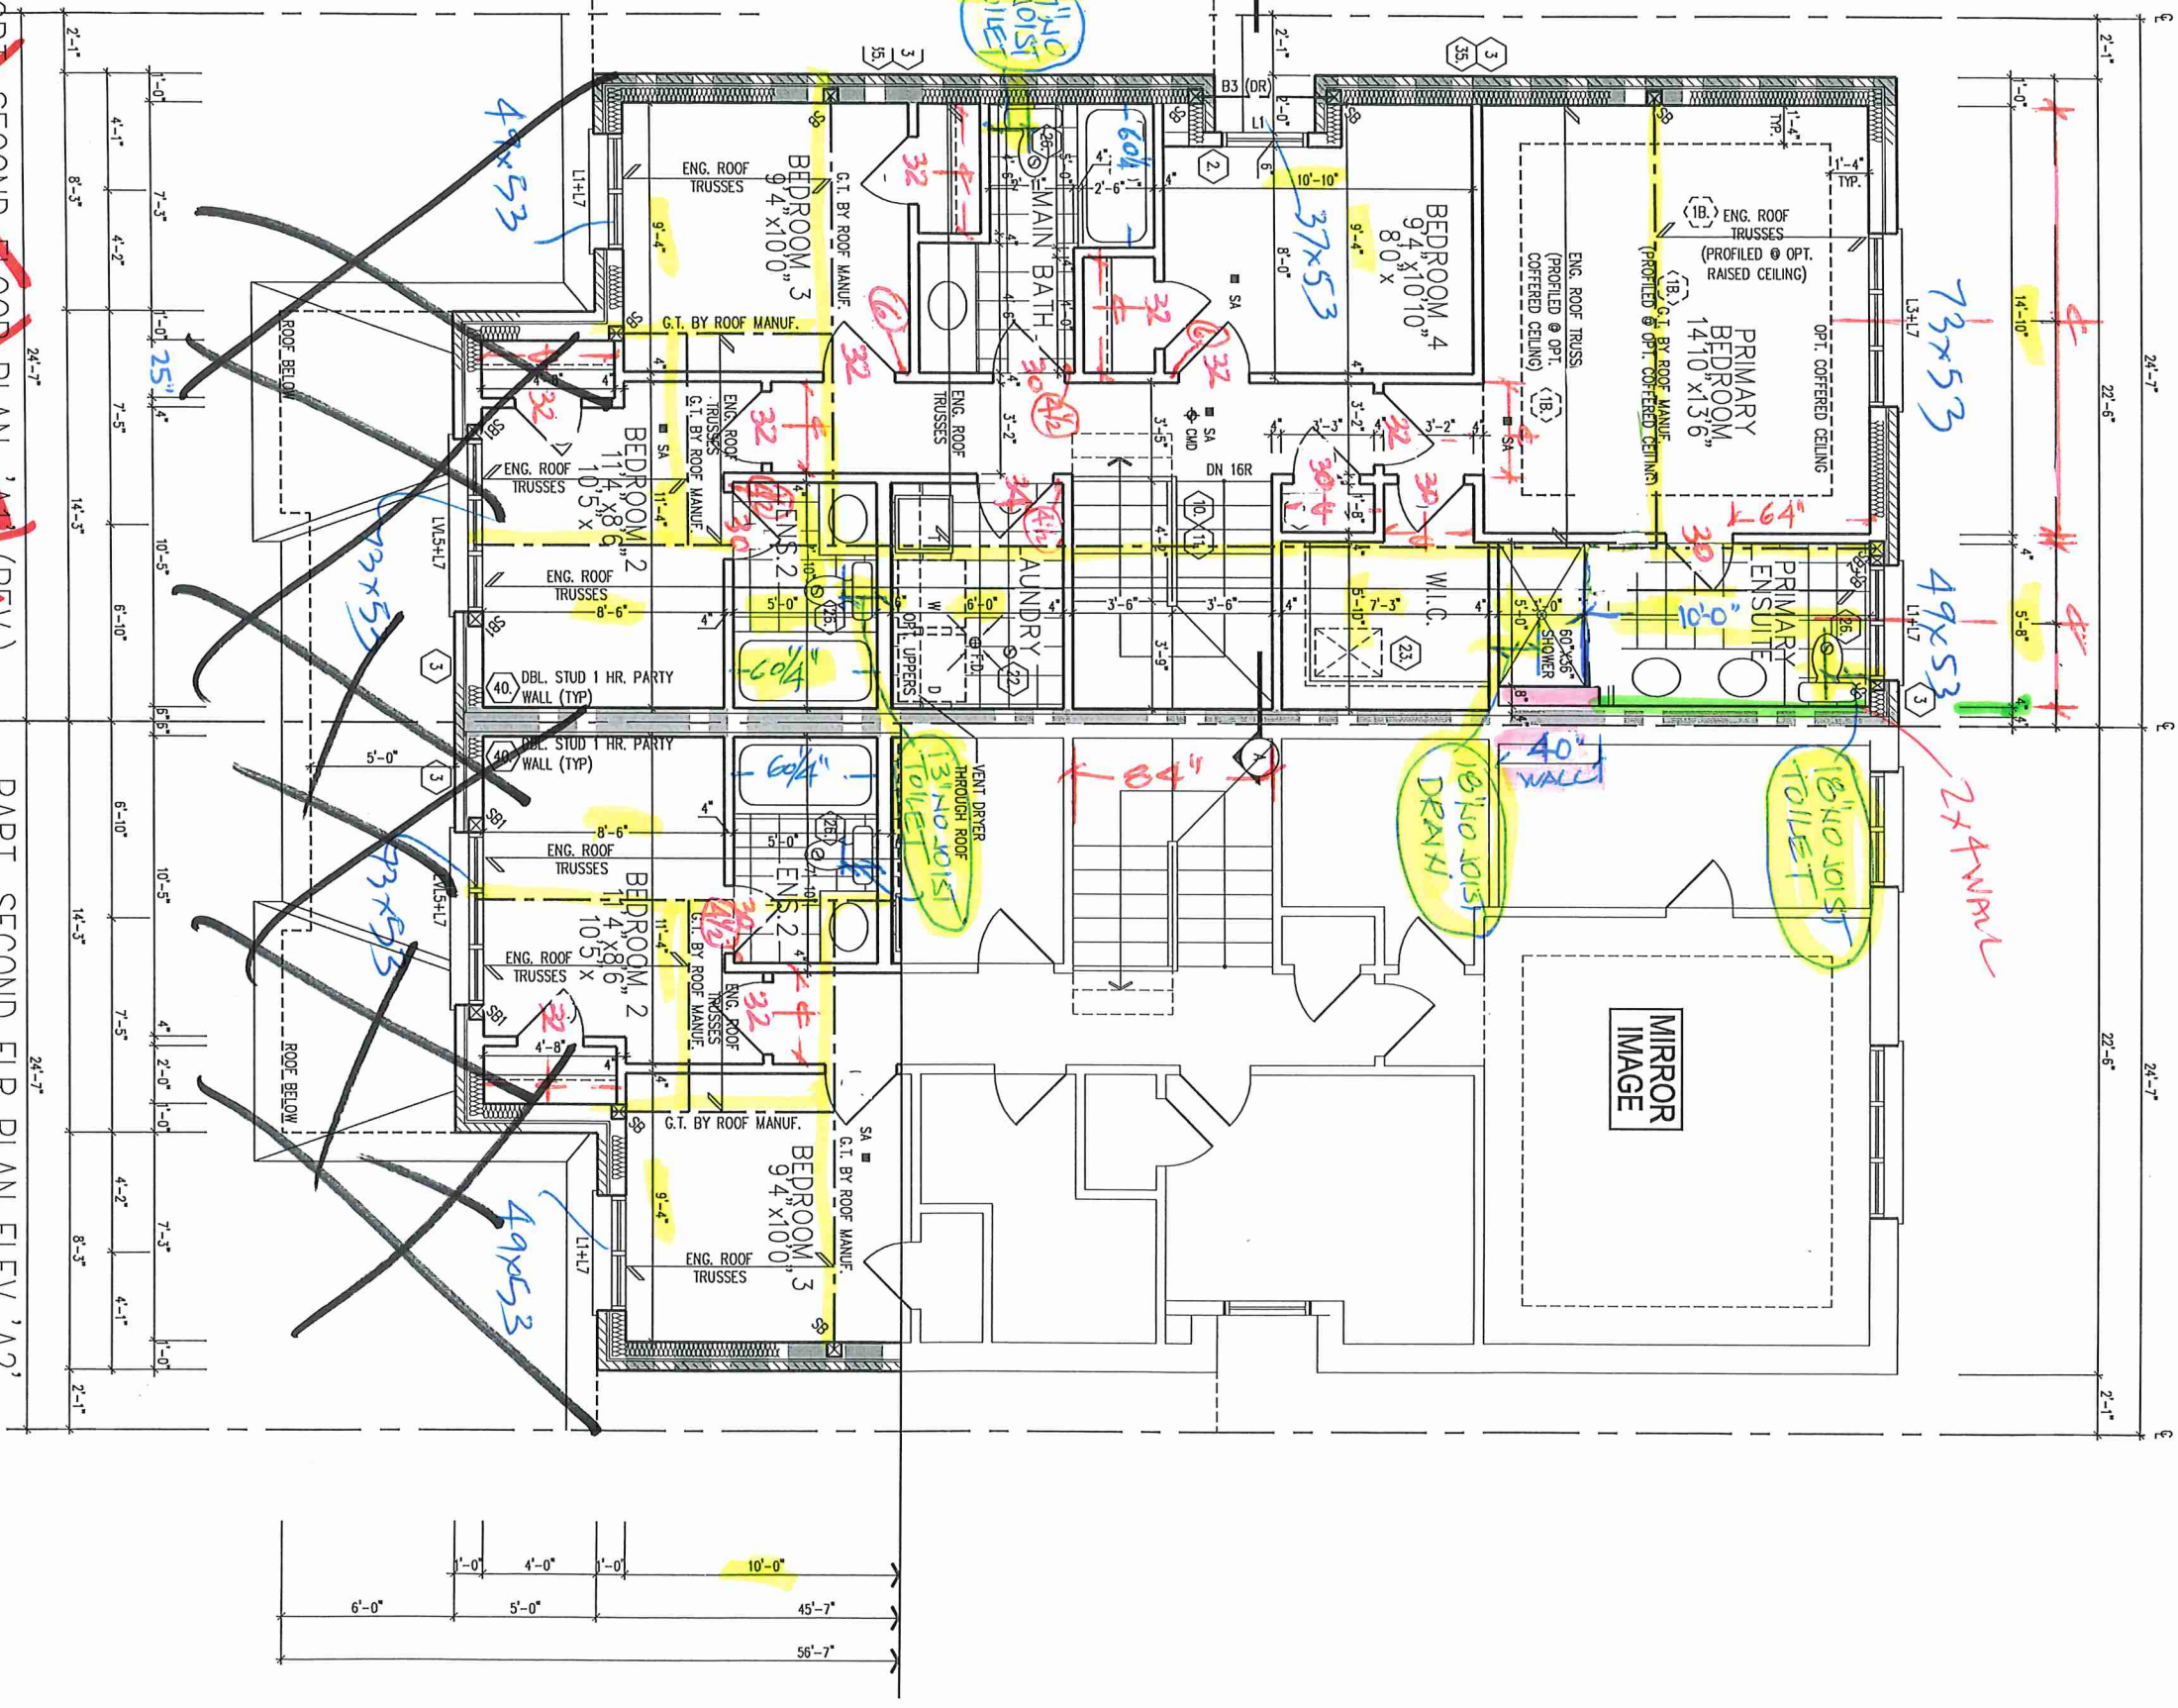

SB: MIN. 2/ 2"x6" SPF OR 3/ 2"x4" SPF
SB1: MIN. 3/ 2"x6" SPF OR 4/ 2"x4" SPF
SR2: MIN. 4/ 2"x6" SPF OR 5/ 2"x4" SPF

OPT. SECOND FLOOR PLAN, 'A1' (REV.) (W/ OPT. 4 BEDROOM) EL. A2, B1 & B2 SIMILAR / PART. SECOND FLOOR PLAN EL. A2

SEE ELEV. B1

PJK 290-10




Royal Pine Homes/Summer Ridge Estates Inc.-216051 UNIT-2502
"MAYFIELD VILLAGE", BRAMPTON, ON. REV.2024.03.14

Drawn By WD Created By DS Scale 3/16"=1'-0"
3550 Langstaff Road, Suite 200 Woodbridge, Ontario, L4L 9G3

216051WS2502

4a of 17

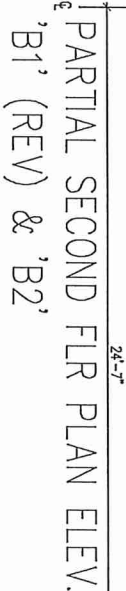

REFER TO STANDARD PLAN FOR
COMPLETE CONSTRUCTION NOTES &
DIMENSIONS



REFER TO STANDARD PLAN FOR
COMPLETE CONSTRUCTION NOTES &
DIMENSIONS

SPACE ALL FLOOR JOISTS @
12" O.C. UNDER ALL CERAMIC
TILE AREAS.

PROVIDE SOLID WOOD BLOCKING @
24" O.C. FOR FIRST JOIST SPAN
WHEN PARALLEL W/ EXTERIOR
WALL



PARTIAL GROUND FLR PLAN ELEV.
'B1' (REV) & ~~B2~~

Royal Pine Homes/Summer Ridge Estates Inc.-216051 UNIT-2502
"MAYFIELD VILLAGE", BRAMPTON, ON. REV.2024.03.14

Drawn By	Checked By	Scale	File Number	Page Number
WD	DS	3/16"=1'-0"	216051WS2502	5 of 17

3560 Langstaff Road, Suite 200 Woodbridge, Ontario, L4L 9G8

REFER TO ROOF TRUSS
MANUFACTURER'S DRAWINGS
FOR LAYOUT, SPACING,
INSTALLATION DETAILS AND
HANGER SIZES.

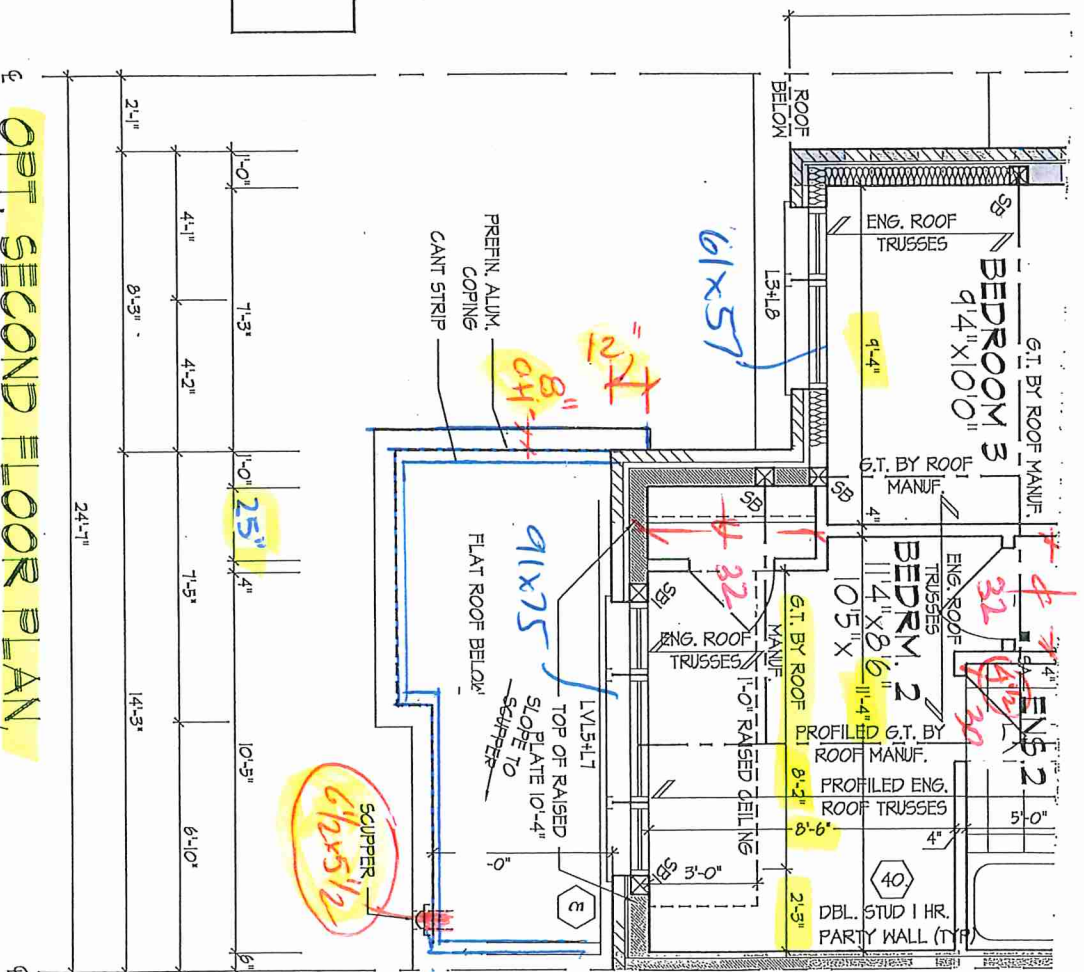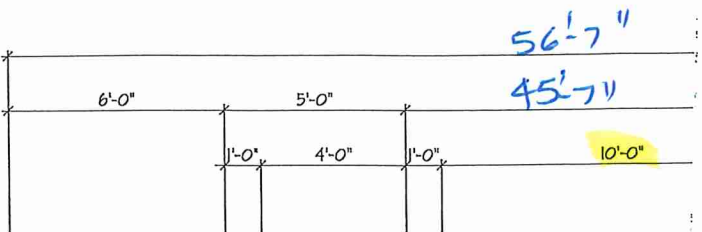

OPT. SECOND FLOOR
ELEV. B1
(W/ OPT. 4 BEDROOM)

2502

Buck 290-10





FRONT ELEVATION EL B1 REV. & B2


FRONT ELEVATION EL B1 REV. & B2


PART. FRONT ELEVATION, 'B1'
(REV) & 'B2' W/ FIREWALL

PART. ROOF, B1' (REV)
& B2' W/ FIREWALL
N.T.S.

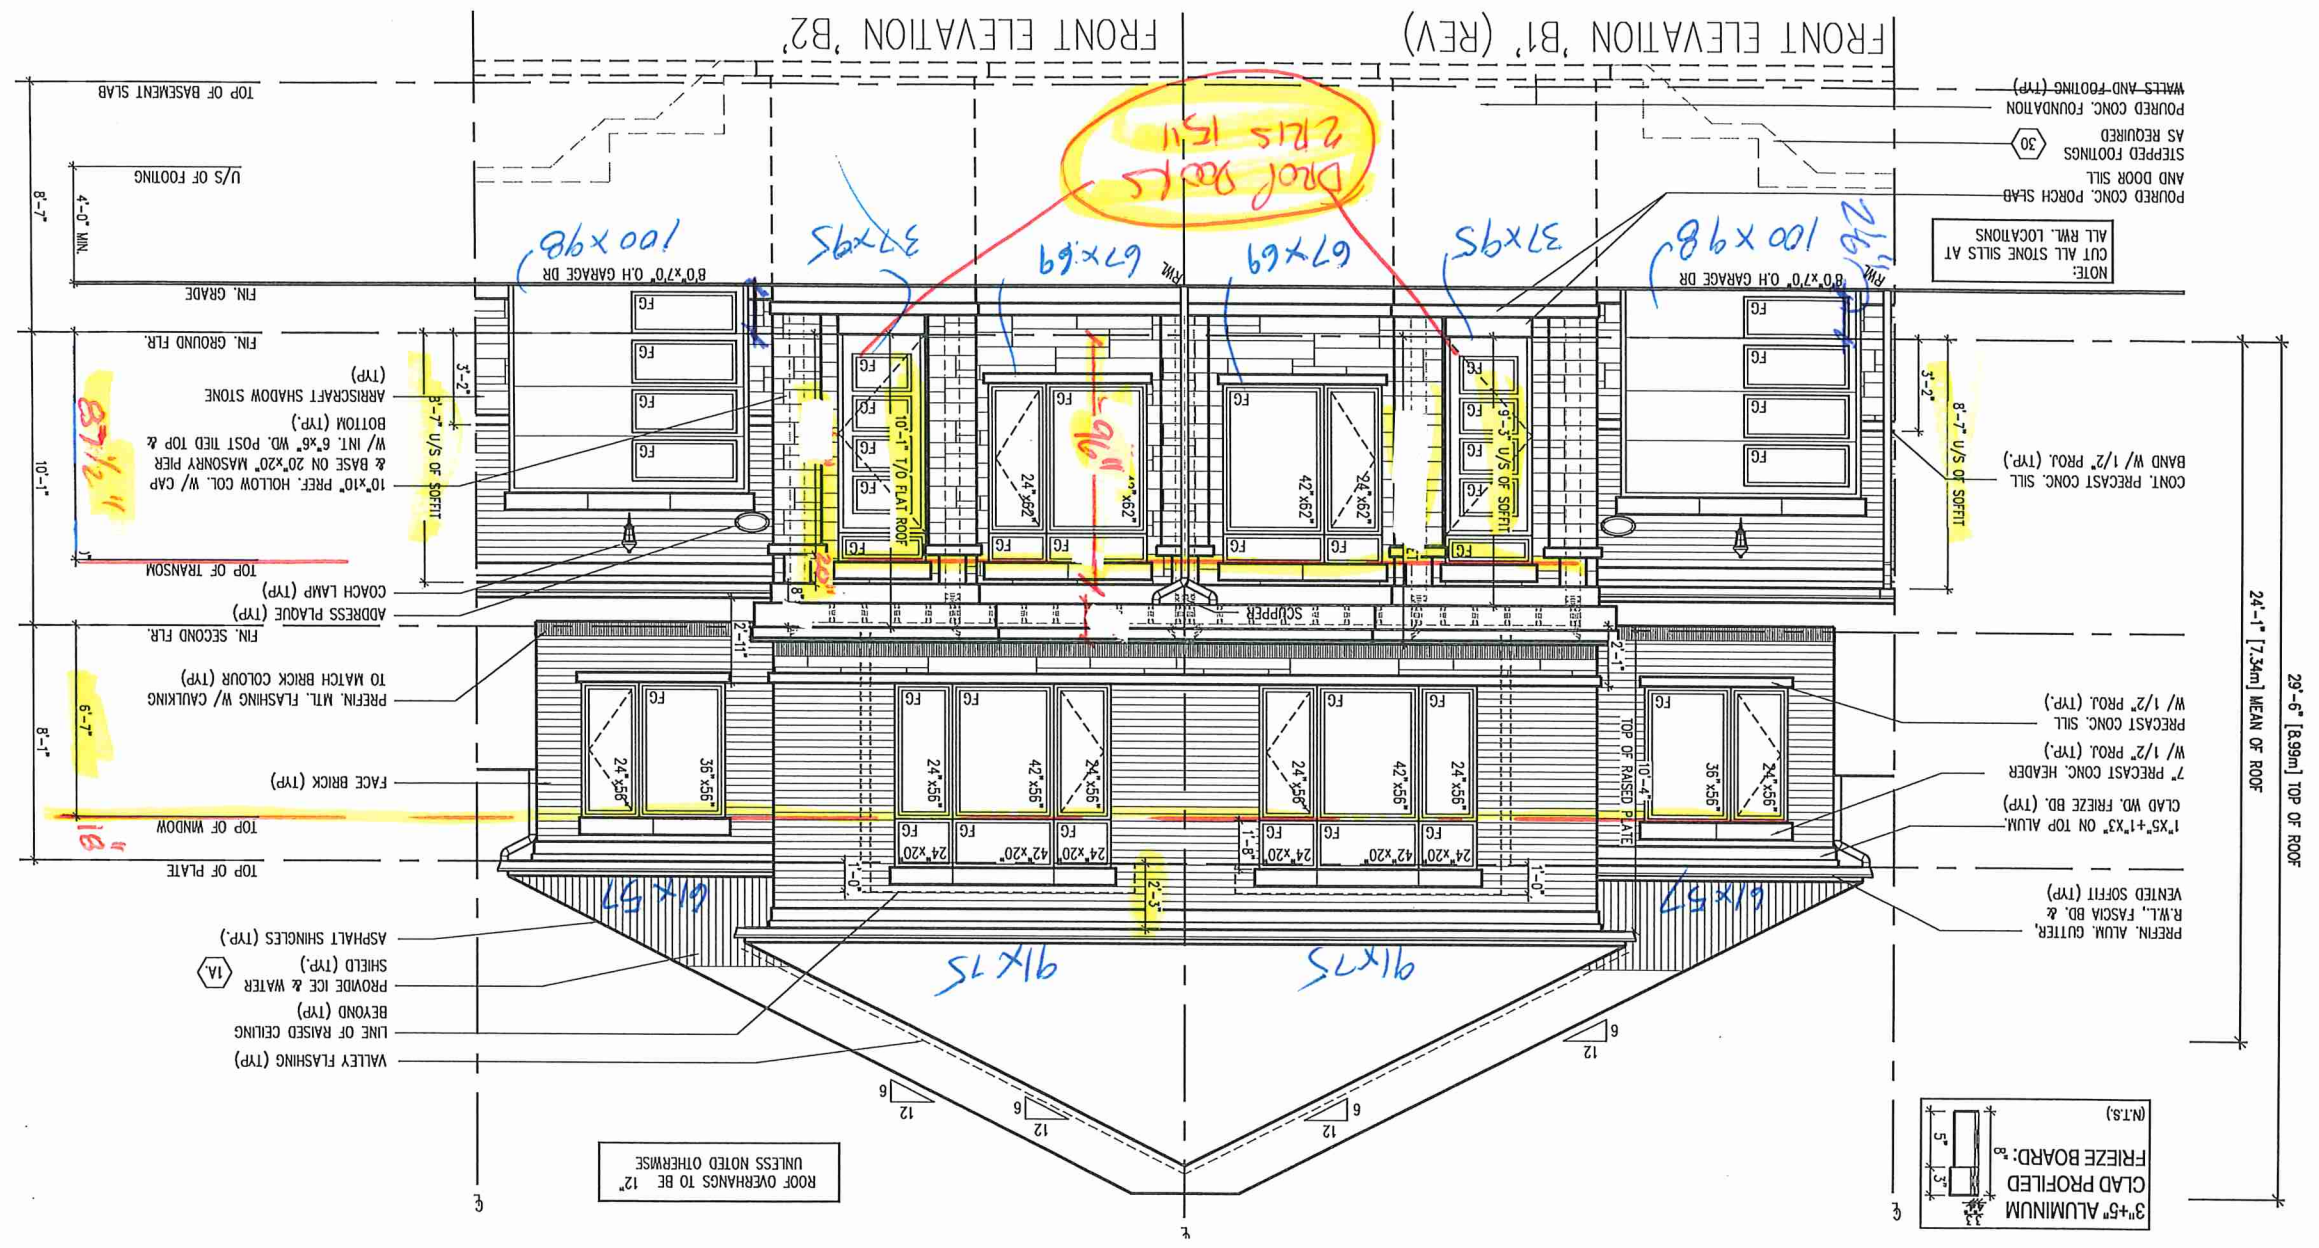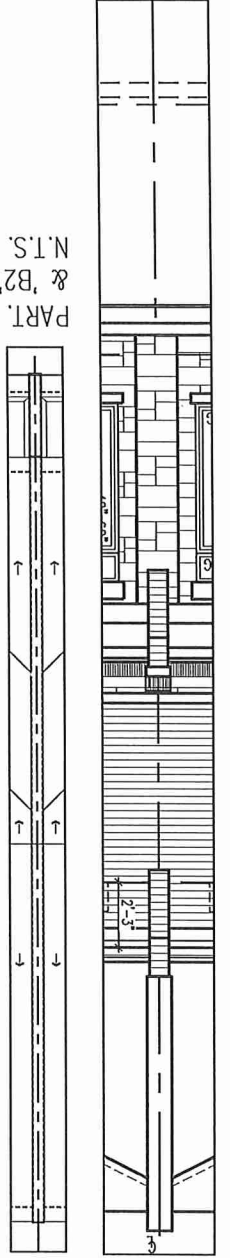

Garbage loop 18.0.11

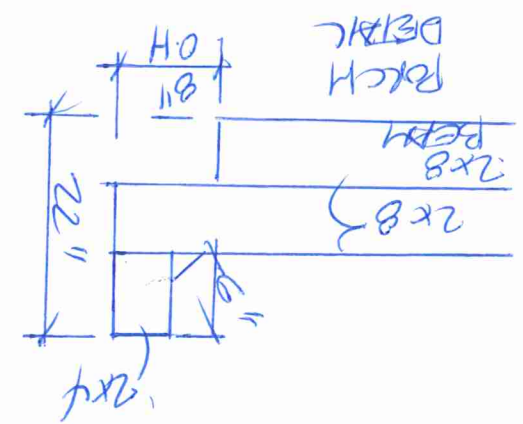

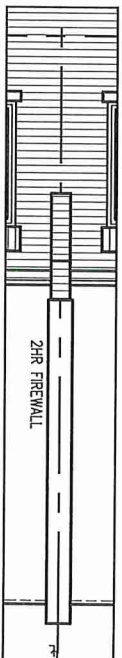

OUTLINE OF ROOF FOR
ELEVATION 'B' ONLY

BRICK SOLDER COURSE


W/ 1/2" PROL. (TYP.)

FACE BRICK (TYP.)

PART. REAR ELEVATION
'A1' & 'B1' (REV) & 'A2' & 'B2' W/ FIREWALL

6" POURED CONC. DOOR SILL &
PRECAST CONC. STEP(S) (TYP.)

8'-7" U/S OF SOFFIT

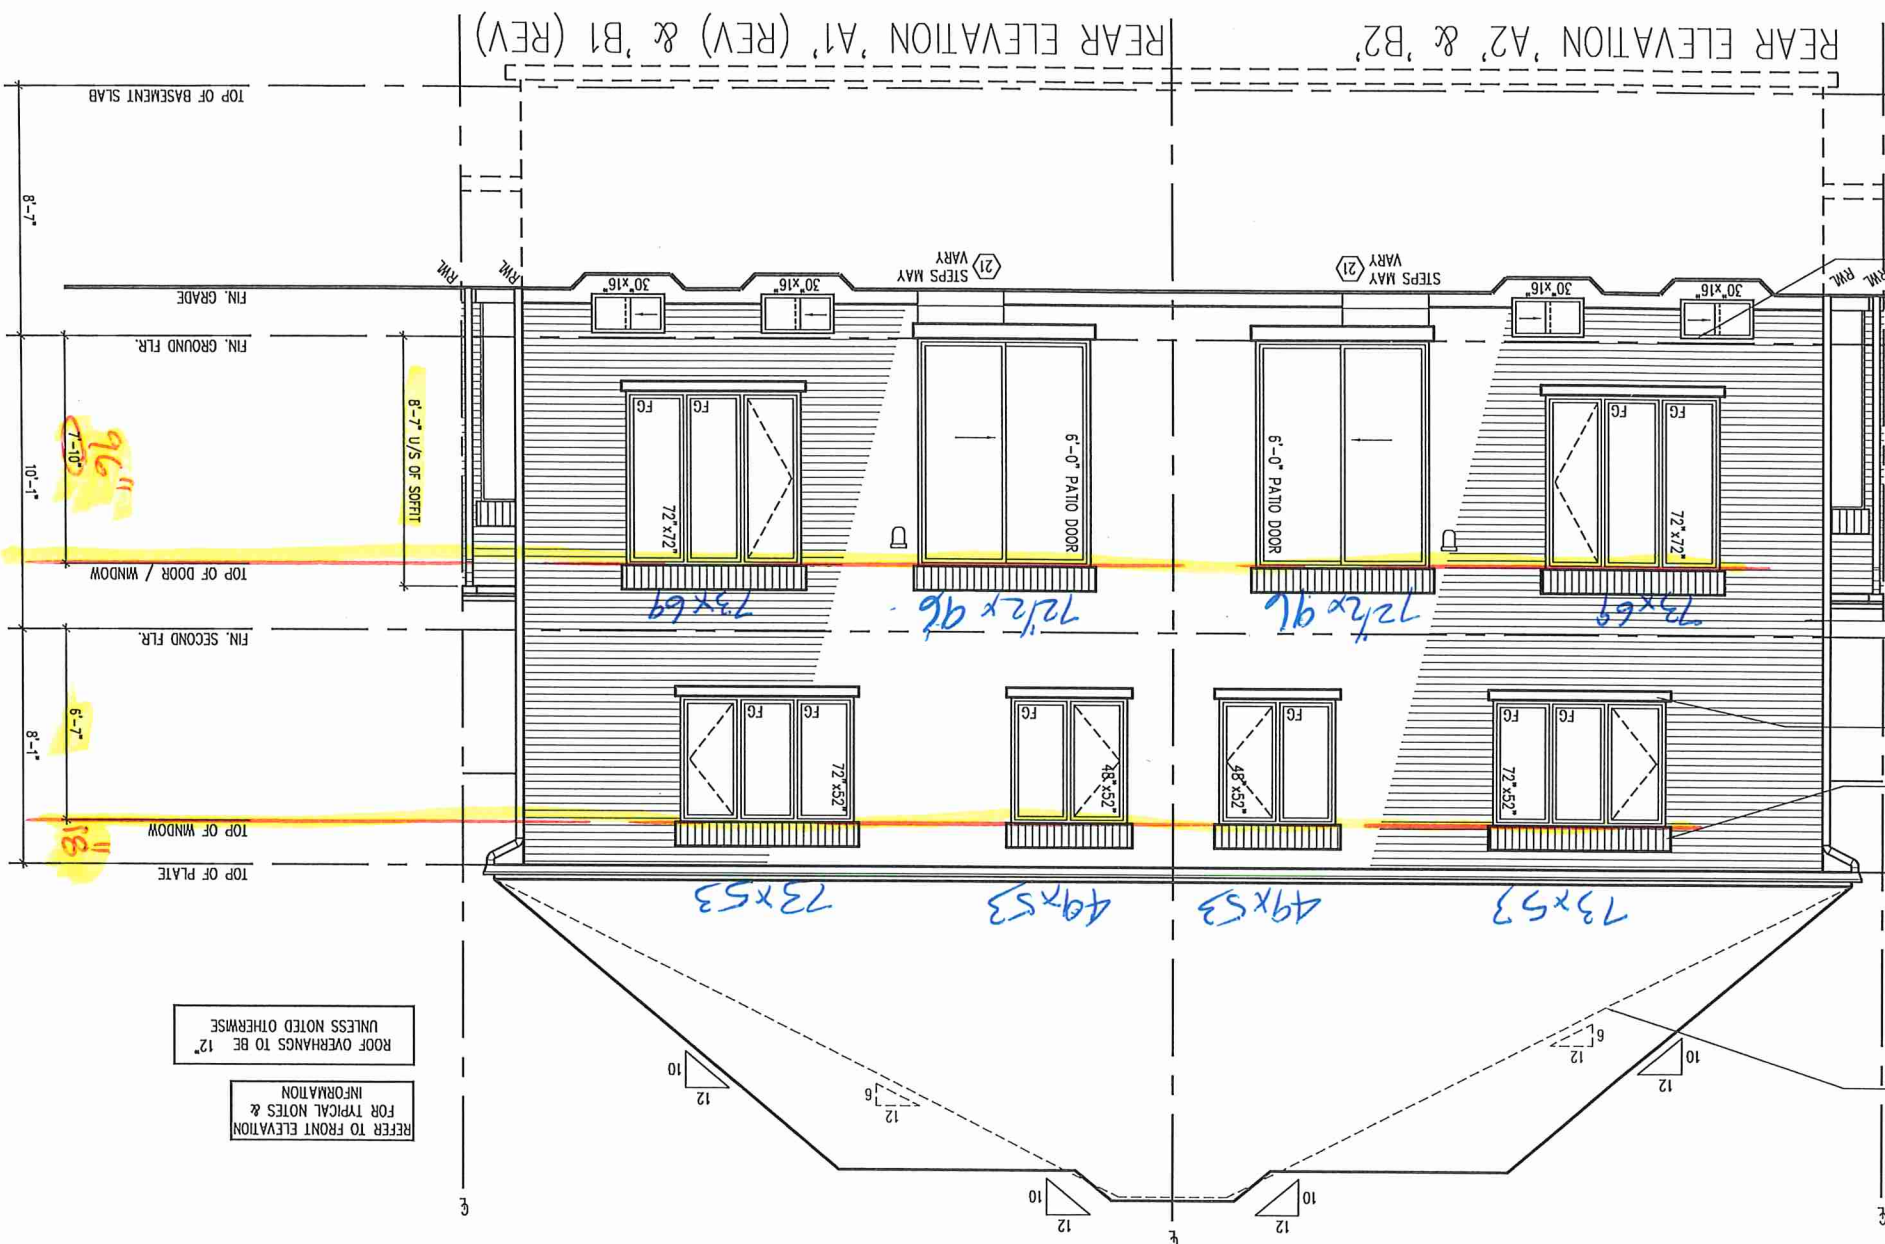

REFER TO FRONT ELEVATION
FOR TYPICAL NOTES &
INFORMATION
UNLESS NOTED OTHERWISE
ROOF OVERHANGS TO BE 12"

REAR ELEVATION EL A1 & A2/ B1 & B2


Royal Pine Homes/Summer Ridge Estates Inc.-216051 UNIT-2502
"MAYFIELD VILLAGE", BRAMPTON, ON. REV/2024.03.14



BLK 290-10

3550 Langstaff Road, Suite 200 Woodbridge, Ontario, L4L 9G3
Drawn By WJD DS 3/16=1'-0" Scale
Checked By DS 3/16=1'-0" Scale
File Number 216051WS2502
Page Number 11 of 17

All drawings specifications related documents and design are the copyright property of Royal Pine Homes. Reproduction of this property in whole or in part is strictly prohibited without R.P.H. written permission. (R.P.H. assumes no responsibility or liability for this property unless it bears the appropriate BCIN number and original signature.

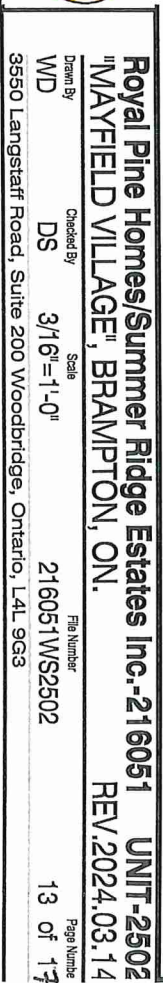

CROSS SECTION A'-A'

Basement: UNFINISHED BASEMENT. Includes a staircase leading up to the ground floor. Callouts: 13, 42, 12, 34A, 6, 5, 29, 28, 29, 10, 11, 9'-2" HEADING, 11, 10, 20, 21, 8, 8'-7" U/S OF SOFFIT, DOOR TO GARAGE, GARAGE PRMTG, DOOR TO SUNK, SUNK, RECD, FIN. GROUND FLR., FIN. SUNK, MUDRM., FIN. GRADE, TOP OF BASEMENT SLAB, 6'-7", 10'-1", 7'-10", TOP OF WINDOW (MUDRM WNL TO MAINTAIN 7'-10" FROM FIN. FLOOR), 8'-7" U/S OF SOFFIT.

Ground Floor: MAIN BATH, DOOR TO GARAGE, GARAGE PRMTG, DOOR TO SUNK, SUNK, RECD, FIN. GROUND FLR., FIN. SUNK, MUDRM., FIN. GRADE, TOP OF BASEMENT SLAB, 6'-7", 10'-1", 7'-10", TOP OF WINDOW (MUDRM WNL TO MAINTAIN 7'-10" FROM FIN. FLOOR), 8'-7" U/S OF SOFFIT.

Second Floor: 1 HR RATED PARTY WALL (TYP.), 40, 9, 11, 10, 11, 10, 20, 21, 8, 8'-7" U/S OF SOFFIT, DOOR TO GARAGE, GARAGE PRMTG, DOOR TO SUNK, SUNK, RECD, FIN. GROUND FLR., FIN. SUNK, MUDRM., FIN. GRADE, TOP OF BASEMENT SLAB, 6'-7", 10'-1", 7'-10", TOP OF WINDOW (MUDRM WNL TO MAINTAIN 7'-10" FROM FIN. FLOOR), 8'-7" U/S OF SOFFIT.

Roof: 12, 10, 11, 10, 11, 10, 20, 21, 8, 8'-7" U/S OF SOFFIT, DOOR TO GARAGE, GARAGE PRMTG, DOOR TO SUNK, SUNK, RECD, FIN. GROUND FLR., FIN. SUNK, MUDRM., FIN. GRADE, TOP OF BASEMENT SLAB, 6'-7", 10'-1", 7'-10", TOP OF WINDOW (MUDRM WNL TO MAINTAIN 7'-10" FROM FIN. FLOOR), 8'-7" U/S OF SOFFIT.

cont. SECTION 1.0. CONSTRUCTION NOTES

39

TWO STOREY VOLUME SPACES

(g.23.10.1., g.23.11., g.23.16.)

WALL ASSEMBLY

MAND LAYOUT

EXTERIOR STUDS	<= 0.5 RPA (g50)	SPACING MAX HEIGHT	SPACING MAX HEIGHT
BRICK	2-2x6" 12 (305) O.C.	18-4" (5588) 8' (200) O.C.	18-4" (5588) 8' (200) O.C.
SIDING	2-2x6" 12 (305) O.C.	18-4" (5588) 12 (305) O.C.	18-4" (5588) 12 (305) O.C.
BRICK	2-2x6" 12 (305) O.C.	21-4" (5440) 12 (305) O.C.	21-4" (5440) 12 (305) O.C.
SIDING	2-2x6" 12 (305) O.C.	21-4" (5440) 12 (305) O.C.	21-4" (5440) 12 (305) O.C.

**** STUD SIZE AND TO BE CONTINUED TO BE VERIFIED BY STRUCTURAL ENGINEER ****

STUDS ARE TO BE CONTINUOUS, C/W 3/8" (9.5), THICK EXTERIOR PL WOOD SHEATHING. PROVIDE SOLID WOOD BLOCKING BETWEEN WOOD STUDS @ 4'-0" (1220) O.C. VERTICALLY.

- FOR JOIST DISTANCES LESS THAN 8'-6" (2598) PROVIDE 2-x6" (50x140) STUDS @ 16" (406) O.C. WITH CONTNL 2-x2x6" (2-38x140) TOP PLATE + 1-x2x6" (1-38x140) BOTTOM PLATE & MN. OF 3-2x6" (3-38x184) CONT. HEADER AT GROUND FLOOR CEILING LEVEL. TO-NAILLED & GLUED AT TOP / BOTTOM FLAYERS & HEADERS.

SECTION 1.1. WALL STUDS

REFER TO SB-12 ENERGY EFFICIENCY DESIGN MATRIX ON THE TITLE P

- REFER TO THIS CHART FOR STUD SIZE & SPACING AS REQUIRED FOR EXTERIOR WALLS ONLY. REFER TO STUDS & GRADING PLAN OF THIS UNIT FOR CONFIRMATION OF TYPE OF FOUNDATION WALL AND ADDITIONAL INFORMATION.

- IF STUD WALL HEIGHT EXCEEDS MAX. UNSUPPORTED HEIGHT, WALL NEEDS TO BE REINFORCED AND APPROVED BY ENGINEER.

SIZE & SPACING OF STUDS: (OBC REFERENCE - TABLE 8.23.10.1.)	
MIN. STUD SIZE: In (mm)	UNSUPPORTED LOADS (EXTERIOR)
	ROOF w/ OR w/o ATTIC ROOF w/ OR w/o ROOF w/ OR w/o ATTIC & 3 FLOOR
MAX. STUD SPACING in (mm) O.C.	
MAX. UNSUPPORTED HGT.: 14ft (m)	
2"x4"	24" (610) 18" (455) 12" (305) N/A
2"x6"	36" (915) 30" (762) 18" (455) N/A
2"x8"	48" (1219) 42" (1067) 24" (609) 12" (305)
3"x4"	36" (915) 30" (762) 18" (455) 12" (305)
3"x6"	48" (1219) 42" (1067) 24" (609) 18" (455)
3"x8"	60" (1524) 54" (1371) 30" (762) 24" (609)

SECTION 2.0. GENERAL NOTES

2.1. WINDOWS 1) EXCEPT WHERE A DOOR ON THE SAME FLOOR LEVEL AS THE BEDROOM PROVIDES DIRECT ACCESS TO THE EXTERIOR, EVERY FLOOR LEVEL CONTAINING A BEDROOM IS TO HAVE AT LEAST ONE OUTSIDE WINDOW WITH MIN. 1.52m² UNOBSTRUCTED OPEN PORTION W/NO DIMENSION LESS THAN 1'-3" (80), CAPABLE OF MAINTAINING THE OPENING WITHOUT THE NEED FOR ADDITIONAL SUPPORT. CONFORMING TO 9.9.10. 2) WINDOW GUARDS: A GUARD OR A WINDOW WITH A MAXIMUM RESTRICTED OPENING WITH 0'-4" (100) IS REQUIRED WHERE THE TOP OF THE WINDOW SILL IS LOCATED LESS THAN 1'-4" (40) ABOVE FIN FLOOR AND THE DISTANCE FROM THE FINISHED FLOOR TO THE ADJACENT GRADE IS GREATER THAN 5'-11" (180). (9.8.5.1). 3) WINDOWS IN EXT STAIRWAYS THAT EXTEND TO LESS THAN 2'-1" (60) (3'-6" (107) FOR ALL OTHER BUILDINGS) SHALL BE PROTECTED BY GUARDS IN ACCORDANCE WITH NOTE #2 (ABOVE), OR THE WINDOW SHALL BE NON-OPERABLE AND DESIGNED TO WITHSTAND THE SPECIFIED LOADS FOR BALCONY GUARDS AS PROVIDED IN 4.1.5.15 OR 9.8.5.2 4) REFER TO TITLE PAGE FOR MAX. U-VALUE REQUIREMENTS		
2.2. CEILING HEIGHTS THE CEILING HEIGHTS OF ROOMS AND SPACES SHALL CONFORM TO TABLE 9.5.5.1.		
ROOM OR SPACE	MINIMUM HEIGHTS	
LIVING ROOM, DINING ROOM AND KITCHEN	7'-7" OVER 75% OF REQUIRED FLOOR AREA WITH A CLEAR HEIGHT OF 6'-11" AT ANY POINT	
BEDROOM	7'-7" OVER 50% OF REQUIRED FLOOR AREA OR 8'-11" OVER ALL OF THE REQUIRED FLOOR AREA.	
BASEMENT	8'-11" OVER AT LEAST 75% OF THE BASEMENT AREA EXCEPT THAT UNDER BEAMS AND PILTS THE CLEARANCE IS PERMITTED TO BE REDUCED TO 6'-5".	
BATHROOM, LAUNDRY AREA ABOVE GRADE	6'-11" IN ANY AREA WHERE A PERSON WOULD NORMALLY BE STANDING	
FINISHED ROOM NOT MENTIONED ABOVE	6'-11"	
MEZZANINES	6'-11" ABOVE & BELOW FLOOR ASSEMBLY (9.5.3.2)	
STORAGE GARAGE	6'-7" (9.5.3.3)	

2.3. MECHANICAL / PLUMBING

- IF NOT AIR CONDITIONED 1. PER HOUR IF AIR CONDITIONED AVERAGE OVER 24 HOURS WHEN A VENTILATION SYSTEM (FAN/PRINCPAL EXHAUST) IS REQUIRED. CONFORM TO OBC 3.322.4. WHEN A HRV IS REQUIRED, CONFORM TO 3.322.3.1. REFER TO MECHANICAL DRAWINGS.
2. REFER TO HOT WATER TANK MANUFACTURER SPECS. CONFORM TO OBC 3.31.6.
3. REFER TO TITLE PAGE FOR SPACE HEATING EQUIPMENT, HRV AND DOMESTIC HOT WATER HEATER MINIMUM EFFICIENCIES.
4. DRINK WATER HEAT RECOVERY (UNIT)S WILL BE INSTALLED CONFORMING TO THE REQUIREMENTS OF SB-12-3.1.12 OF THE O.B.C.

2.4. LUMBER

- 1) ALL LUMBER SHALL BE SPRUCE No.2 GRADE OR BETTER, UNLESS NOTED OTHERWISE
- 2) STUDS SHALL BE STUD GRADE SPRUCE, UNLESS NOTED OTHERWISE
- 3) LUMBER EXPOSED TO THE EXTERIOR TO BE SPRUCE No. 2 GRADE PRESURE TREATED OR CEDAR, UNLESS NOTED OTHERWISE
- 4) ALL LAMINATED VENEER LUMBER (LVL) BEAMS, GIRDERS, TRUSSES, AND METAL HANGER CONNECTIONS SUPPORTING ROOF FRAMING TO BE DESIGNED & CERTIFIED BY FLOOR AND ROOF TRUSS MANUFACTURER
- 5) JUST HANGERS, PROVIDE APPROVED METAL HANGERS FOR ALL JOISTS AND BUILT-UP WOOD MEMBERS INTERSECTING WITH FLUSH BUILT-UP WOOD MEMBERS.
- 6) WOOD FRAMING NOT TREATED WITH A WOOD PRESERVATIVE, IN CONTACT WITH CONCRETE, SHALL BE SEPARATED FROM THE CONC. BY AT LEAST 2" OF POLYETHYLENE FILM (GAP) (GAPS) OR ROOFING OR OTHER APPROVED MATERIAL, EXCEPT WHERE THE WOOD MEMBERS IS AT LEAST 6" (152) ABOVE THE GROUND.

2.5. STEEL (9.23.43.)
1) STRUCTURAL STEEL SHALL CONFORM TO CAN/CSA-G40-21 GRADE 350W, HOLLOW STRUT. SECTIONS SHALL CONFORM TO CAN/CSA-G40-21 GRADE 350W CLASS "H".
2) REINFORCING STEEL SHALL CONFORM TO CSA-G30-18M GRADE 400R.

2.6. FLAT ARCHES
1) FOR 8'-0" (2400) CEILINGS, FLAT ARCHES SHALL BE 8'-0" (2400) A.F.F.
2) FOR 6'-0" (2740) CEILINGS, FLAT ARCHES SHALL BE 7'-10" (2400) A.F.F.
3) FOR 10'-0" (3040) CEILINGS, FLAT ARCHES SHALL BE 8'-0" (2800) A.F.F.

2.7. ROOF OVERHANGS
1) ALL ROOF OVERHANGS SHALL BE 4'-0" (900), UNLESS NOTED OTHERWISE.

2.8. FLASHING (9.20.13, 9.26.4 & 9.27.3)
1) FLASHING MATERIALS & INSTALLATION SHALL CONFORM TO O.B.C.

2.9. GRADING
1) THE BUILDING SHALL BE LOCATED ON THE BUILDING SITE GRADED SO THE WATER WILL NOT ACCUMULATE AT OR NEAR THE BUILDING AND WILL NOT ADVERSELY AFFECT ADJACENT PROPERTIES. CONFORM TO 9.14.6.

2.10. UIC SPECIFIED ASSEMBLIES
ALL REQUIRED INDIVIDUAL COMPONENTS THAT FORM PART OF ANY UIC LISTED ASSEMBLY, SPECIFIED WITHIN THESE DRAWINGS, CANNOT BE ALTERED OR SUBSTITUTED FOR ANY OTHER MATERIAL/PRODUCT OR SPECIFIED MANUFACTURER THAT IS IDENTIFIED IN THAT SPECIFIED UIC LISTING. THERE SHALL BE NO DEVIATIONS UNDER ANY CIRCUMSTANCES IN ANY UIC LISTED ASSEMBLY IDENTIFIED IN THESE DRAWINGS.

SECTION 3.0. LEGEND

3.1. WOOD LINTELS AND BUILT-UP WOOD

(DIVISION B PART 9, TABLES A6 TO A10 AND A12, A15 & A16)
FORMING PART OF SENTENCE 9.23.4.2.(i), 9.23.4.2.(j), 9.23.13.2.(i),(j), 9.23.13.6.(d), 9.37.3.1.(1)

2x8 SPRUCE #2	2x12 SPRUCE #2	2x12 SPRUCE #2

ENGINEERED LUMBER SCHEDULE									
L1	2"x4" (236x184)	L3	2"x10" (236x285)	L5	2"x12" (236x286)				
L81	3/2"x6" (336x184)	B3	3/2"x12" (336x285)	B5	3/2"x12" (336x286)				
L82	4/2"x6" (436x184)	B4	4/2"x12" (436x285)	B6	4/2"x12" (436x286)				
L87	5/2"x6" (536x184)	B8	5/2"x12" (536x285)	B9	5/2"x12" (536x286)				
	1 3/4" x 9 1/2" LVL	LW3	1 3/4" x 11 7/8" LVL		1 3/4" x 14" LVL				
LW2	1-1 3/4"x9 1/2"	LW3	1-1 3/4"x11 7/8"	LW10	1-1 3/4"x14"				
LW4	2-1 3/4"x9 1/2"	LW6	2-1 3/4"x11 7/8"	LW11	2-1 3/4"x14"				
LW5	3-1 3/4"x9 1/2"	LW7	3-1 3/4"x11 7/8"	LW12	3-1 3/4"x14"				
LW8	4-1 3/4"x9 1/2"	LW9	4-1 3/4"x11 7/8"	LW13	4-1 3/4"x14"				
3.2. STEEL LINTEL SUPPORTING MASONRY VENEER									
(DIVISION B PART 9, TABLE 9.20.5.2.2.B.)									
FORMING PART OF SECTION 9.20.5.2.2) & 9.20.5.2.3)									

SIZE	MODE	STONE
3 1/2" x 3 1/2" x 1 1/4" (89 x 89 x 6.4)	L7	8-1" (2.47m)
4" x 3 1/2" x 1 1/4" (102 x 89 x 6.4)	L8	8-8" (2.69m)
5" x 3 1/2" x 5/8" (127 x 89 x 7.9)	L9	10-1" (3.31m)
5" x 3 1/2" x 7/8" (127 x 89 x 11)	L10	10-1" (3.03m)
6" x 3 1/2" x 7/8" (152 x 89 x 11)	L11	10-7" (3.24m)
7" x 4" x 7/8" (178 x 102 x 11)	L12	11-7" (3.54m)
		14-6" (4.30m)
		13-1" (3.99m)

3.3. DOOR SCHEDULE	
CONFORMING TO SECTIONS 9.5.1.1, 9.6, 9.7.2.1, 9.7.5.2, & 9.10.13.10	
1	2'-5" x 6'-5" x 1-3/8" (815 x 2030 x 45) INSULATED MIN. R4 (RSI 0.7)
1A	2'-0" x 6'-5" x 1-3/4" (865 x 2030 x 45) INSULATED MIN. R4 (RSI 0.7)
1B	3'-0" x 6'-5" x 1-3/4" (915 x 2030 x 45) INSULATED MIN. R4 (RSI 0.7)
1C	2'-5" x 6'-5" x 1-3/4" (760 x 2030 x 45) INSULATED MIN. R4 (RSI 0.7)
1D	2'-5" x 6'-5" x 1-3/4" (815 x 2030 x 45) INS. MIN. R4 (RSI 0.7) (SEE HEX NOTE 20)
1E	3'-0" x 6'-0" x 1-3/4" (915 x 2440 x 45) INSULATED MIN. R4 (RSI 0.7)
1F	2'-5" x 6'-0" x 1-3/4" (815 x 2440 x 45) INSULATED MIN. R4 (RSI 0.7)
2A	2'-5" x 6'-5" x 1-3/8" (815 x 2030 x 45) MIN. R4 R. COORDINATE WITH AWP, SELF-CLOSING DEVICE.
2	2'-5" x 6'-5" x 1-3/8" (815 x 2030 x 35)
3	2'-5" x 6'-5" x 1-3/8" (760 x 2030 x 35)
3A	2'-4" x 6'-5" x 1-3/8" (710 x 2030 x 35)
4	2'-0" x 6'-5" x 1-3/8" (610 x 2030 x 35)
4A	2'-2" x 6'-5" x 1-3/8" (660 x 2030 x 35)
5	1'-5" x 6'-5" x 1-3/8" (460 x 2030 x 35)

PROVIDE 8'-0" HIGH
 INTERIOR DOORS
 FOR ALL LOBBIES
 CONDITIONS

3.4. ACRONYMS			
ACRONYM	DEFINITION	ACRONYM	DEFINITION
AFF	ABOVE FINISHED FLOOR	JST	JOST
BBFM	BEAM BY FLOOR MANUFACTURER	UN	UNEN CLOSET
BG	FIXED GLASS W/ BLACK BACKING	LVL	LAMINATED VENEER LUMBER
BM	BEAM	OTBA	OPEN TO BELOW/ABOVE
BBFM	BEAM BY ROOF MANUFACTURER	PL	POINT LOAD
CRF	CONVENTIONAL ROOF FRAMING	PLT	PLATE
C/W	COMPLETE WITH	PT	PRESSURE TREATED
D/J/D	DOUBLE JOIST/ TRIPLE JOIST	PTD	PAINTED
DO	DO OVER	PWD	POWDER ROOM
DRP	DROPPED	RWL	RAIN WATER LEADER
ENG	ENGINEERED	SB	SOLID BEARING WOOD POST
EST	ESTIMATED	SBFA	SB FLOW ABOVE
FA	FLAT ARCH	SJ	SINGLE JOIST
FD	FLOOR DRAIN	SPR	SPRUCE
FG	FIXED GLASS	STL	STEEL
FL	FLUSH	T/O	TOP OF
FLA	FLOOR	TYP	TYPICAL
GT	GARDER TRUSS	U/S	UNDERSIDE
HB	HOSE BIB	WD	WOOD
HRV	HEAT RETURN VENTILATION UNIT	WC	WALK IN CLOSET

HP/WT	HOT WATER TANK	WP	WEATHER PROOF
3.5. SYMBOLS			
ALL ELECTRICAL FACILITIES SHALL BE INSTALLED IN ACCORDANCE WITH SECTION 9.34.			
	CLASS 'B' VENT		EXHAUST VENT
	DUPLEX OUTLET (12' HIGH)		DUPLEX OUTLET (HEIGHT AS NOTED A.E.)
	HEAVY DUTY OUTLET		SWITCH (24' WAA)
	POT LIGHT		LIGHT FIXTURE (CEILING MOUNTED)
	LIGHT FIXTURE (PULL CHAIN)		LIGHT FIXTURE (WALL MOUNTED)
	CABLE T.V. JACK		TELEPHONE JACK
	CENTRAL VACUUM OUTLET		CHANDELIER (CEILING MOUNTED)

1 HR. PARTY WALL	◆ CMD CARBON MONOXIDE ALARM (g. 33.4.) ***CHECK LOCAL BY-LAWS FOR REQUIREMENTS *** CARBON MONOXIDE ALARMS) CONFORMING TO CAN/CGA-33.3 SHALL BE INSTALLED ON OR NEAR THE CEILING IN EACH CONFINING TAIL ADJACENT TO EACH SLEEPING AREA. CARBON MONOXIDE ALARMS) SHALL BE PERMANENTLY YIMED WITH NO DISCONNECT SWITCH, WITH AN ALARM THAT IS AUDIBLE WITHIN SLEEPING ROOMS WHEN THE INTERVENING DOORS ARE CLOSED.
2 HR. FIREWALL	SOLID BEARING (BUILT-UP WOOD COLUMNS AND STUD POSTS) THE WIDTH OF A WOOD COLUMN SHALL NOT BE LESS THAN THE WIDTH OF SUPPORTED MEMBER. BUILT-UP WOOD COLUMNS SHALL BE NAILLED TOGETHER WITH NOT LESS THAN 3 (76) NAILS SPACED NOT MORE THAN 11.8" (300 O.C. THE NUMBER OF STUDS IN A WALL DIRECTLY BE DW/A GIRDER TRUSS OR ROOF BEAM SHALL CONFORM TO TABLE A-34 TO A-37. (g.17.4, g.22.10.7.)
	TWO STOREY VOLUME SPACE SEE CONSTRUCTION NOTE 39.
	WARNING PLATES, BUILT-UP FLOORS, BEARING WALLS, ICE & WATER SHIELD
	EXPPOSED BUILDING FACE O.B.C. g. 10.14, OR g.10.15, REFER TO HEX NOTE 33, & DETAILS FOR TYPE AND SPECIFICATIONS.

SECTION 4.0. CLIMATIC DATA	
DESIGN SNOW LOAD (9.4.2.2.): WIND PRESSURE (9.50) (SB-1.2.):	1.12 kPa 0.44 kPa
STAMP	

W Architect Inc.

DESIGN CONTROL REVIEW

MAR. 28, 2023

FINAL
 BY: 

This stamp is only for the purposes of design control and carries no other professional obligations.



FOR STRUCTURAL ONLY

NOT RECOMMENDED FOR FOUNDATIONS

NO! INCLUDING ENGINEERED
FLOOR OR ROOF SYSTEM

CONTRACTOR MUST VERIFY ALL DIMENSIONS ON THE JOB, REPORT ANY DISCREPANCIES TO PLUMB DESIGN ASSOCIATES INC. (LDAL) BEFORE PROCEEDING WITH THE WORK. ALL THE DRAWINGS & SPECIFICATIONS ARE THE PROPERTY OF LDAL. NO PARTS THEREOF MAY BE REPRODUCED OR TRANSMITTED IN ANY FORM OR BY ANY MEANS, ELECTRONIC OR MECHANICAL, WITHOUT PERMISSION IN WRITING FROM LDAL. ANY VIOLATION OF THIS POLICY WILL BE CONSIDERED A BREACH OF CONTRACT AND SUBJECT TO LEGAL ACTION. THE USER SHALL BE RESPONSIBLE FOR OBTAINING ALL NECESSARY PERMITS AND APPROVALS FROM THE APPROPRIATE AUTHORITIES. THE USER SHALL BE RESPONSIBLE FOR OBTAINING ALL NECESSARY INSURANCE COVERAGE. THE USER SHALL BE RESPONSIBLE FOR OBTAINING ALL NECESSARY BONDS. THE USER SHALL BE RESPONSIBLE FOR OBTAINING ALL NECESSARY REFERENCES. THE USER SHALL BE RESPONSIBLE FOR OBTAINING ALL NECESSARY REFERENCES. THE USER SHALL BE RESPONSIBLE FOR OBTAINING ALL NECESSARY REFERENCES.

CONSTRUCTION NOTE REVISION DATE: JUNE 09, 2022

BU 290-10

