


BASEMENT TO GROUND
BSMT 11-7/8" JOIST


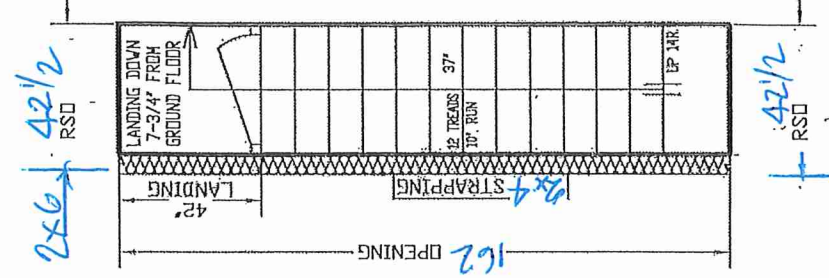


ALL OPENINGS ARE ALLOWED
FOR 1 LAYER OF DRY WALL
ANY ADDITIONAL LAYERS MUST
BE ALLOWED BY CARPENTERS

NO WALLS UNTIL
STAIRS INSTALLED

[illegible]

BLK 234 - FH 62

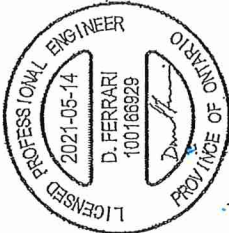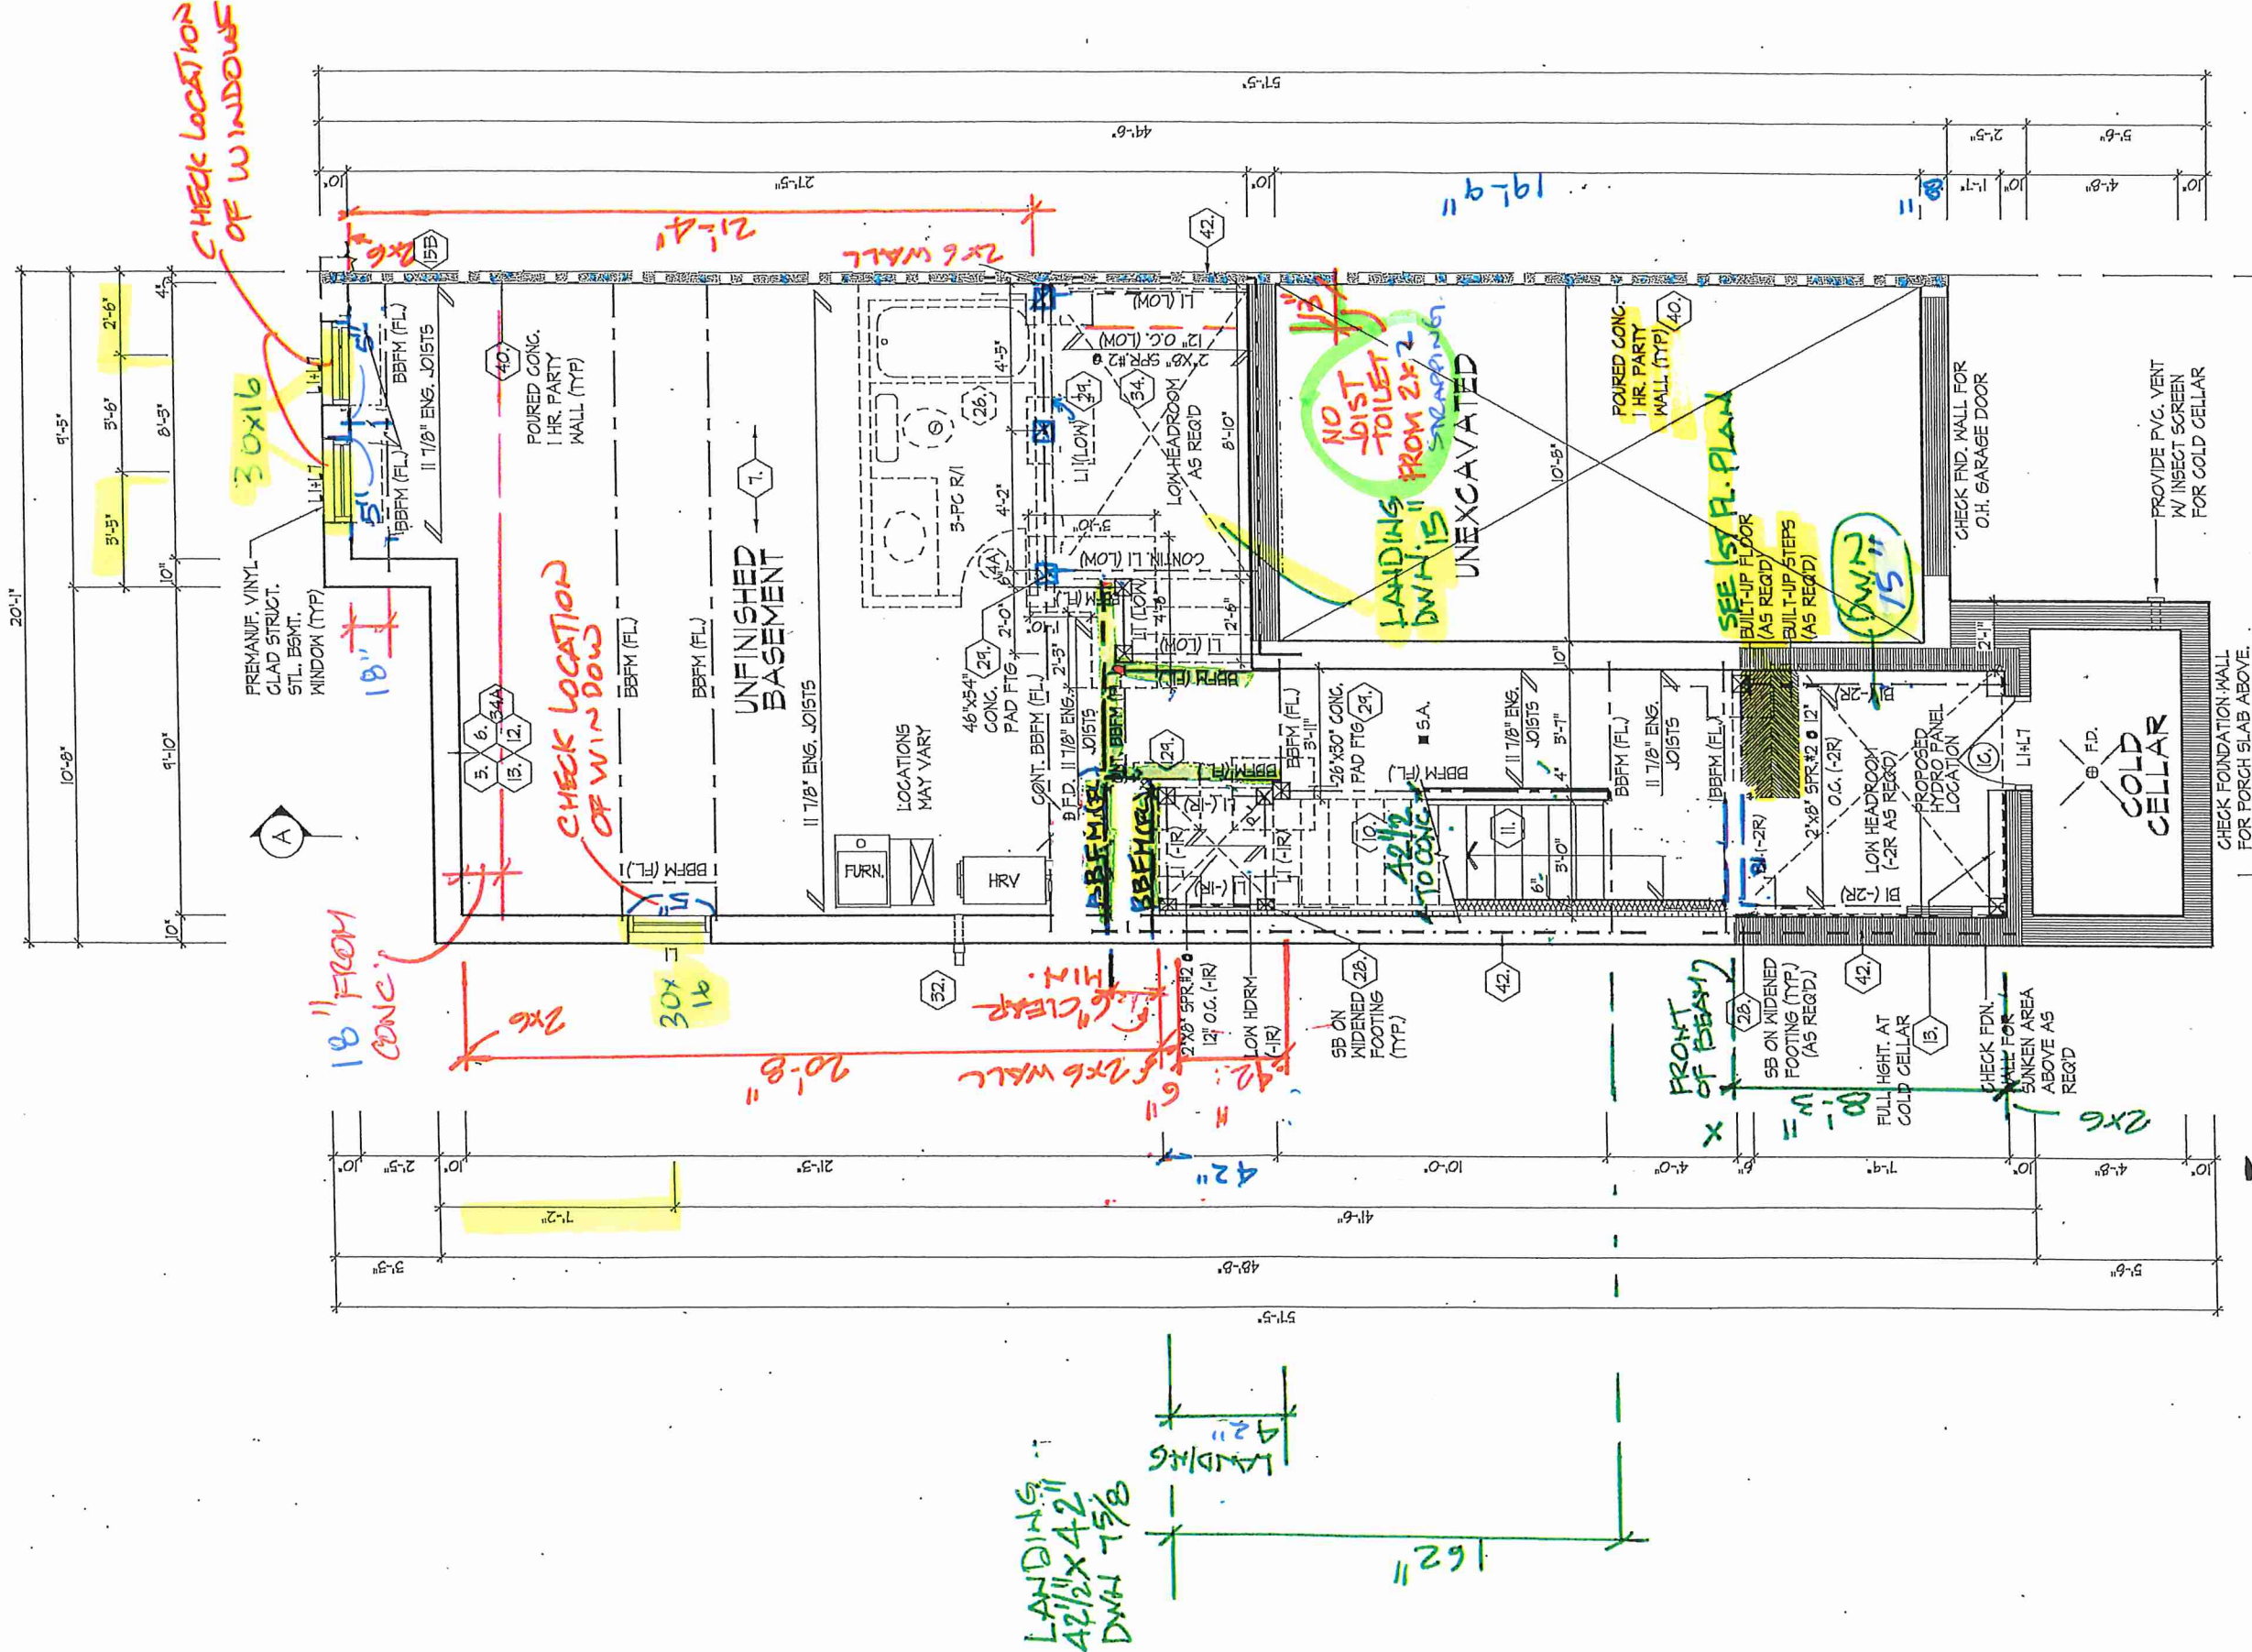

FOR STRUCTURAL ONLY
NOT INCLUDING ENGINEERED
FLOOR OR ROOF SYSTEM

REFER TO FLOOR JOIST
MANUFACTURER'S DRAWINGS
FOR LAYOUT, SPACING,
BLOCKING & STRAPPING
REQUIREMENTS, INSTALLATION
DETAILS AND HANGER SIZES, &
SUBFLOOR THICKNESS

APPROX. LOCATION OF
FURNACE AND HOT
WATER TANK

PROVIDE SOLID WOOD
BLOCKING @ 24" O.C. FOR
FIRST JOIST SPAN WHEN
PARALLEL W/ EXTERIOR WALL.

BASEMENT PLAN, EL. 'A' & 'B'

- END COND.

BK 234-62

BASEMENT PLAN, ELEV. 'A' & 'B'

ROYAL PINE HOMES - 216102
'CENTREFIELD', WEST GORMLEY, RICHMOND HILL, ON. REV. 2021.05.11

HUNT
DESIGN ASSOCIATES INC.
www.hunt-design.ca

THE UNDERSIGNED HAS REVIEWED AND TAKES RESPONSIBILITY FOR THE
DESIGN AND HAS THE QUALIFICATIONS AND EXPERIENCE TO MEET THE REQUIREMENTS SET
OUT IN THE ONTARIO BUILDING CODE TO BE A DESIGNER.


QUALIFICATION INFORMATION
NAME: Derek R. Santos
REGISTRATION NUMBER: 37308
BCIN: 19695

SIGNATURE

File Number: 216102WT2009-END
Scale: 3/16" = 1'-0"
Checked By: DS
Drawn By: KM

Page Number: 2 of 18


8966 Woodbine Ave, Markham, ON L3R 0J7 T 905.737.5133 F 905.737.7326
Reproduction of this property in whole or in part is strictly prohibited without H.D.A.'s written permission (H.D.A. assumes no responsibility or liability for this property unless it bears the appropriate BCIN number and original signature).

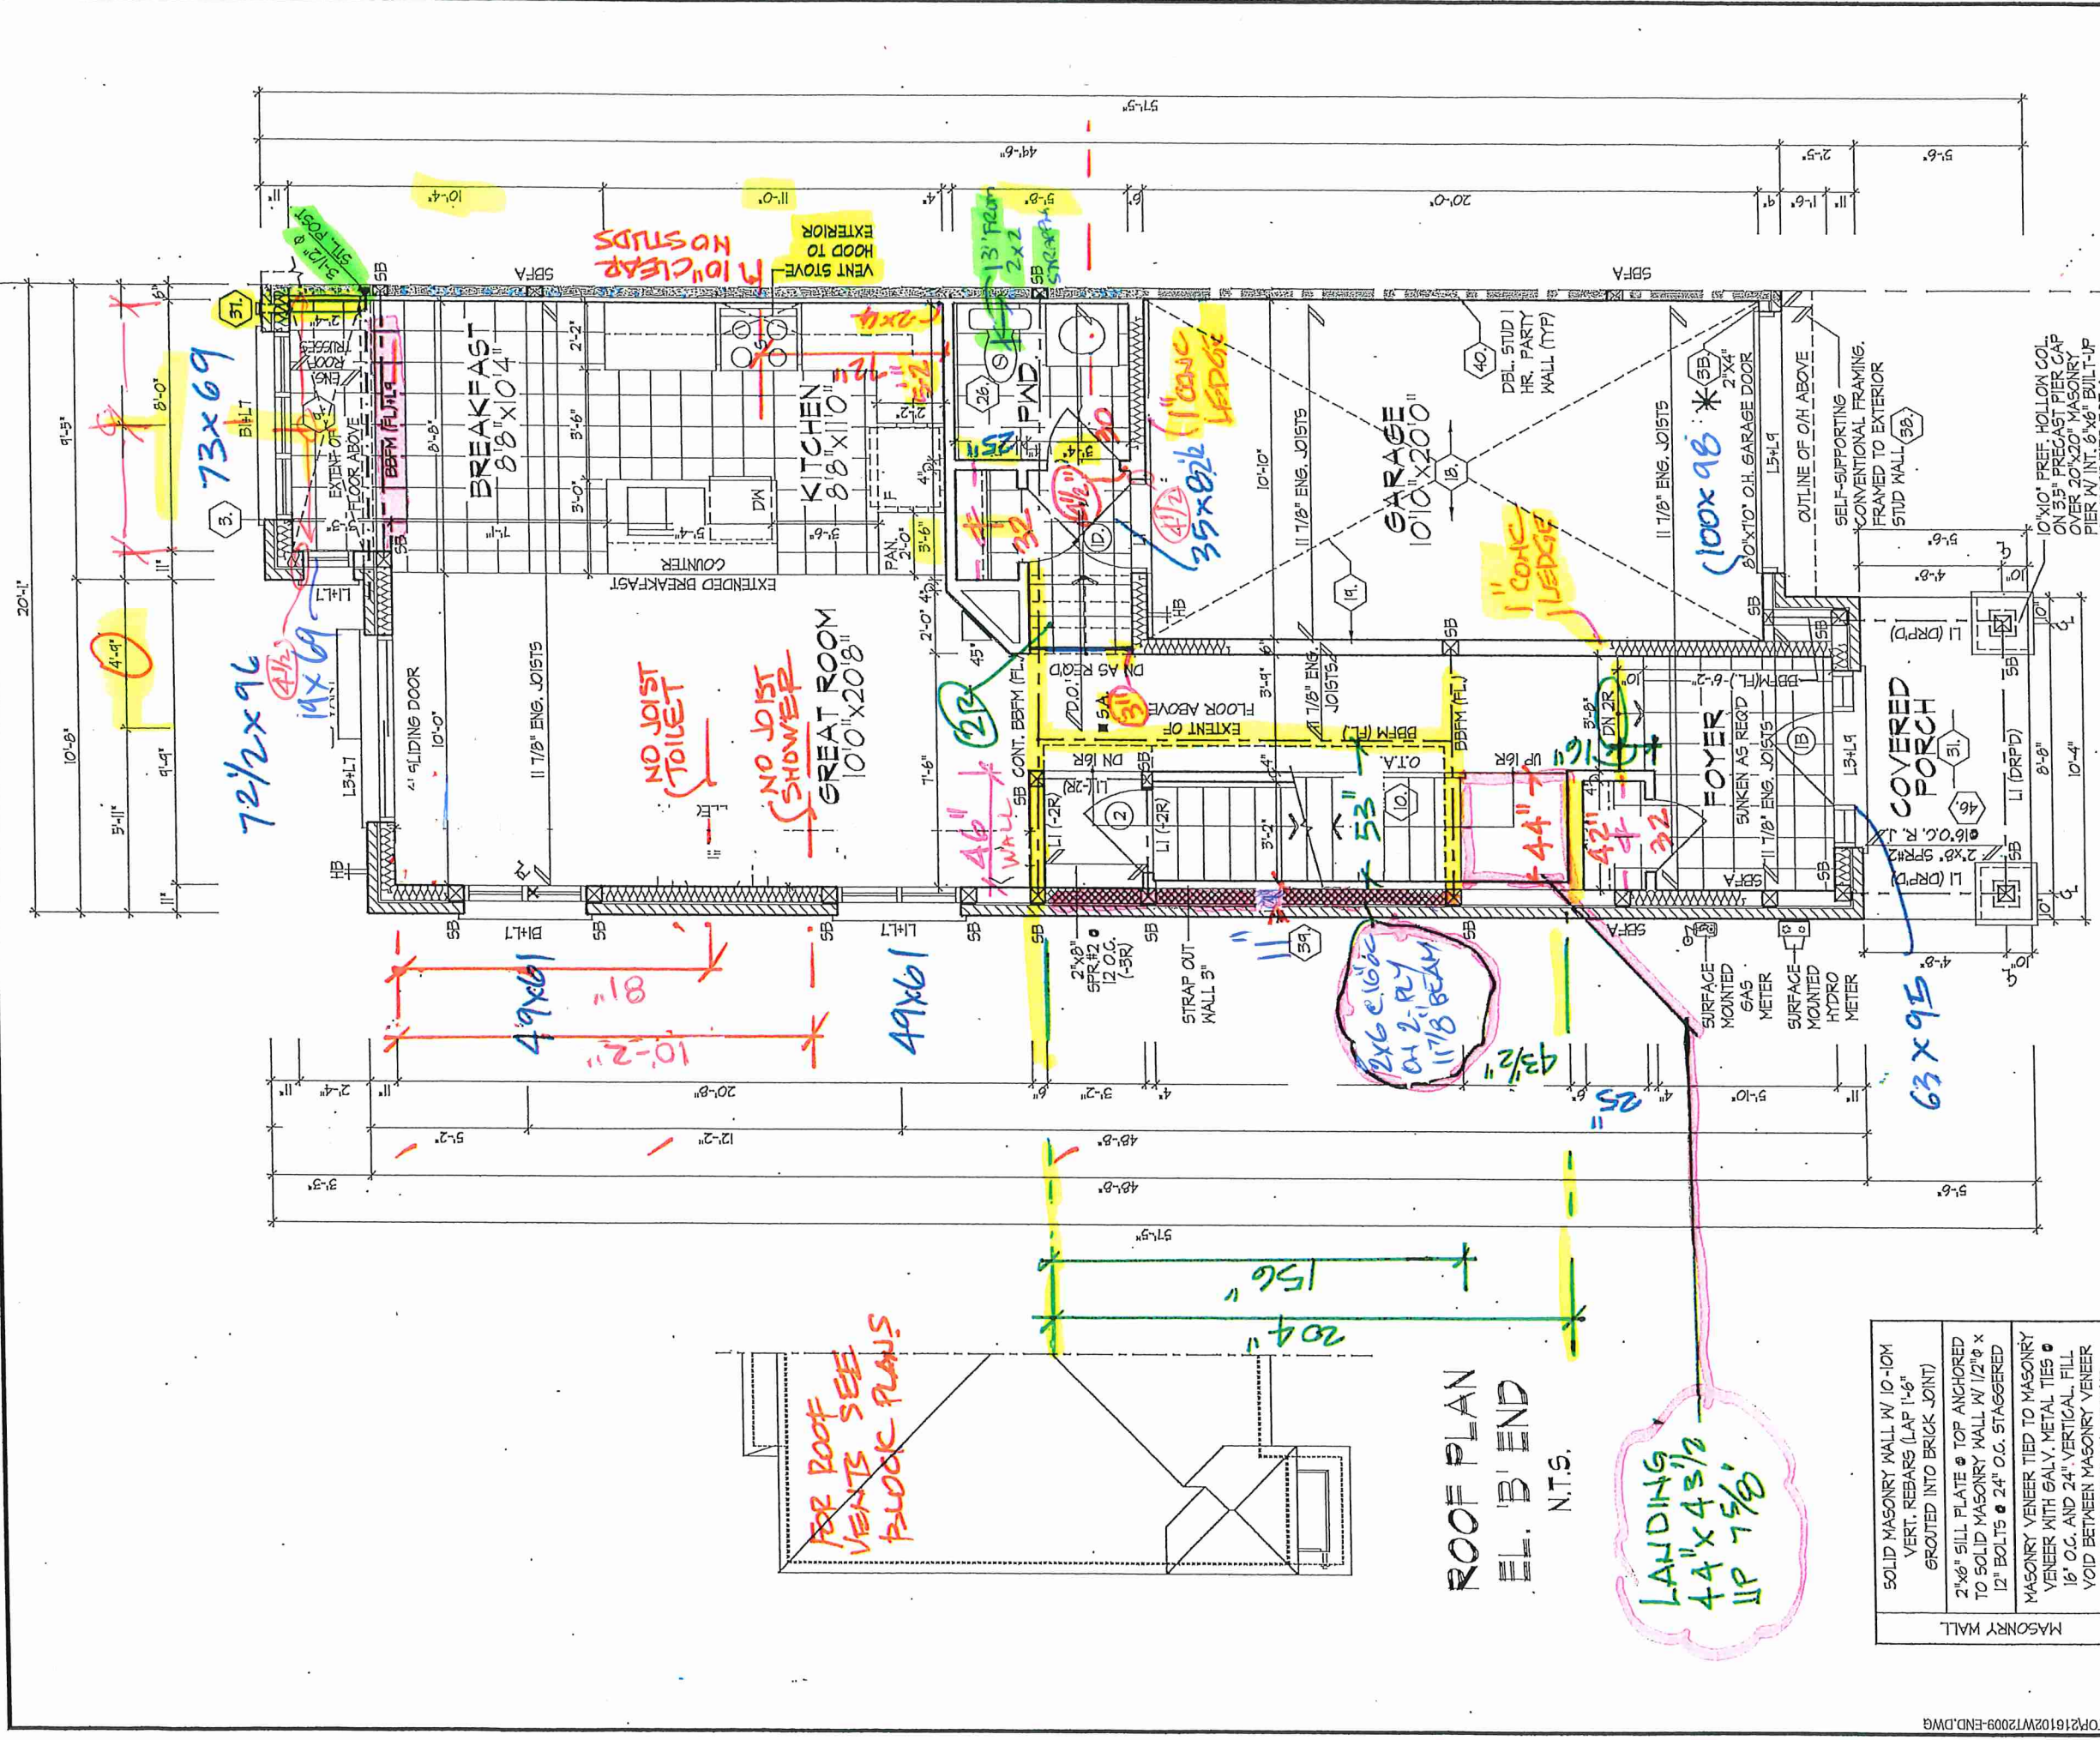

MASONRY WALL	
SOLID MASONRY WALL W/ 10'-10M VERT. REBARS (LAP 1'-6\"/>	
2"x6\"/>	
MASONRY VENEER TIED TO MASONRY VENEER WITH GALV. METAL TIES @ 16\"/>	
VOID BETWEEN MASONRY VENEER MYTHES SOLID W/ MORTAR	
* 2"x4\"/>	
MAX. UNSUPPORTED HEIGHT	
- W/O FLOOR LOAD, DOUBLE UP EVERY STUD @ 16\"/>	
- W/ FLOOR LOAD, DOUBLE UP EVERY STUD @ 12\"/>	
PROVIDE BLOCKING EVERY 4'-0\"/>	
REFER TO FLOOR JOIST	ALL DOORS ON PLAN ARE 1'-10\"/>
MANUFACTURER'S DRAWINGS	HIGH TOP OF FRAME, UNLESS
FOR LAYOUT, SPACING,	LABELLED OTHERWISE.
BLOCKING & STRAPPING	PROVIDE SOLID WOOD
REQUIREMENTS, INSTALLATION	BLOCKING @ 24\"/>
DETAILS AND HANGER SIZES, &	FIRST JOIST SPAN WHEN
SUBFLOOR THICKNESS	PARALLEL W/ EXTERIOR WALL

GROUND FLOOR PLAN,

EL. 'B' - END
- DOORS - 8'3 1/2"
- ARCHES DEEP 15"
- WINDOWS - 96"

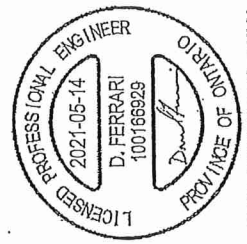

FOR STRUCTURAL ONLY
NOT INCLUDING ENGINEERED
FLOOR OR ROOF SYSTEM

P2K 234-62


ROYAL PINE HOMES - 216102
'CENTREFIELD', WEST GORMLEY, RICHMOND HILL, ON. REV. 2021.05.11

HUNT
DESIGN ASSOCIATES INC.
www.huntdesign.ca

THE UNDERSIGNED HAS REVIEWED AND TAKES RESPONSIBILITY FOR THIS DESIGN AND HAS THE QUALIFICATIONS AND MEETS THE REQUIREMENTS SET OUT IN THE ONTARIO BUILDING CODE TO BE A DESIGNER.
QUALIFICATION INFORMATION
Derek R. Sattos
NAME
REGISTRATION INFORMATION
37308
BCIN
19695

Drawn By: KM
Checked By: DS
Scale: 3/16"=1'-0"
File Number: 216102MT2009-END
Page Number: 7 of 18

GROUND FLOOR PLAN, ELEV. 'B'

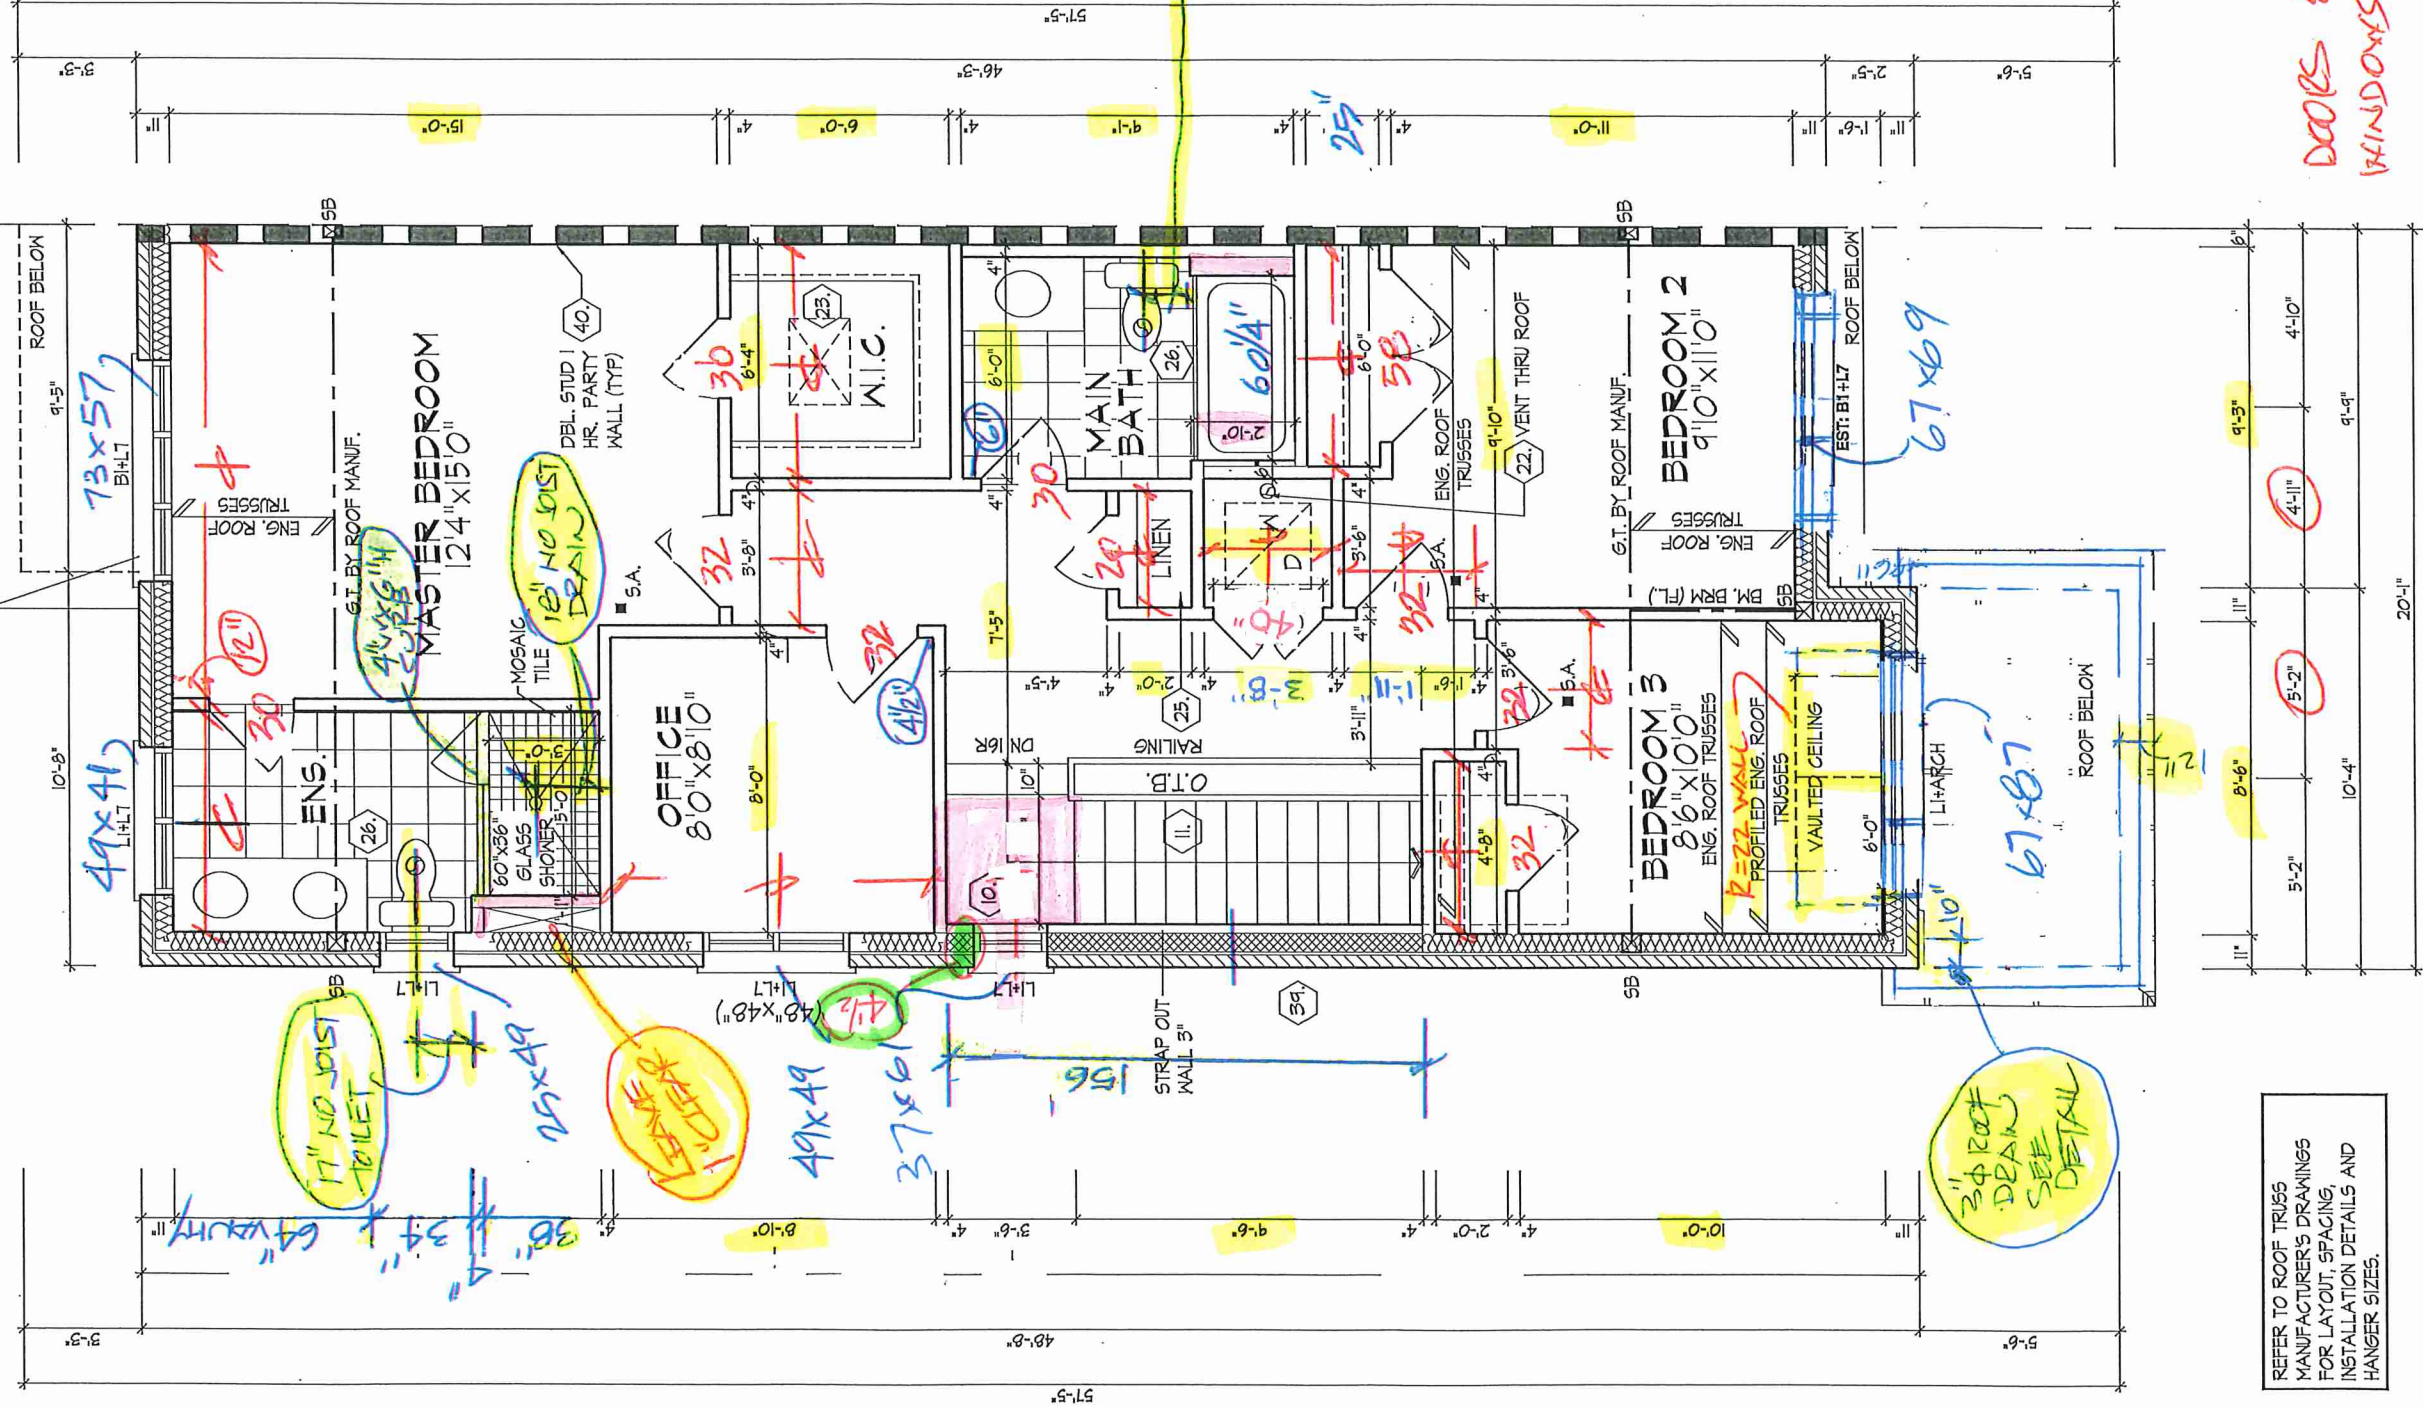

OPT. SECOND FLOOR PLAN, EL. B
OFFICE / FLEX SPACE LAYOUT

20-09 END THE MACKENZIE


BK 234-62
opt. SECOND FLOOR PLAN, ELEV. 'A1/A2'

THE UNDERSIGNED HAS REVIEWED AND TAKES RESPONSIBILITY FOR THIS DESIGN AND HAS THE QUALIFICATIONS AND MEETS THE REQUIREMENTS SET OUT IN THE ONTARIO BUILDING CODE TO BE A DESIGNER.
QUALIFICATION INFORMATION
Derek R. Santos
21-0111 CEILING
37308
SIGNATURE
REGISTRATION INFORMATION
HUNT DESIGN ASSOCIATES INC.
19695
All drawings specifications related documents and design are the copyright property of Hunt Design Associates (H.D.A.). Reproduction of this property in whole or in part is strictly prohibited without H.D.A.'s written permission (H.D.A. assumes no responsibility or liability for this property unless it bears the appropriate BCIN number and original signature.

HUNT
DESIGN ASSOCIATES INC.
www.huntdesign.ca

ROYAL PINE HOMES - 216102
'CENTREFIELD', WEST GORMLEY, RICHMOND HILL, ON.
REV. 2025.03.13
Page Number
216102WT2009-END
6a of 18
Checked By
DS
3/16"=1'-0"
T 905.737.5133 F 905.737.7926

FINAL , BY:
This stamp is only for the purposes of design control and carries no other professional obligations.

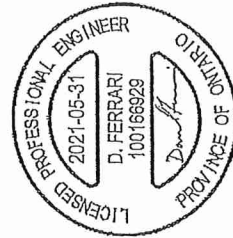

PART. SECTION 'C'


UNIT 2009-END
REV.2021.05.31

Page Number
13 of 18

13 of 18

State BCIN number and original signature.)

THE UNIVERSITY OF CHICAGO

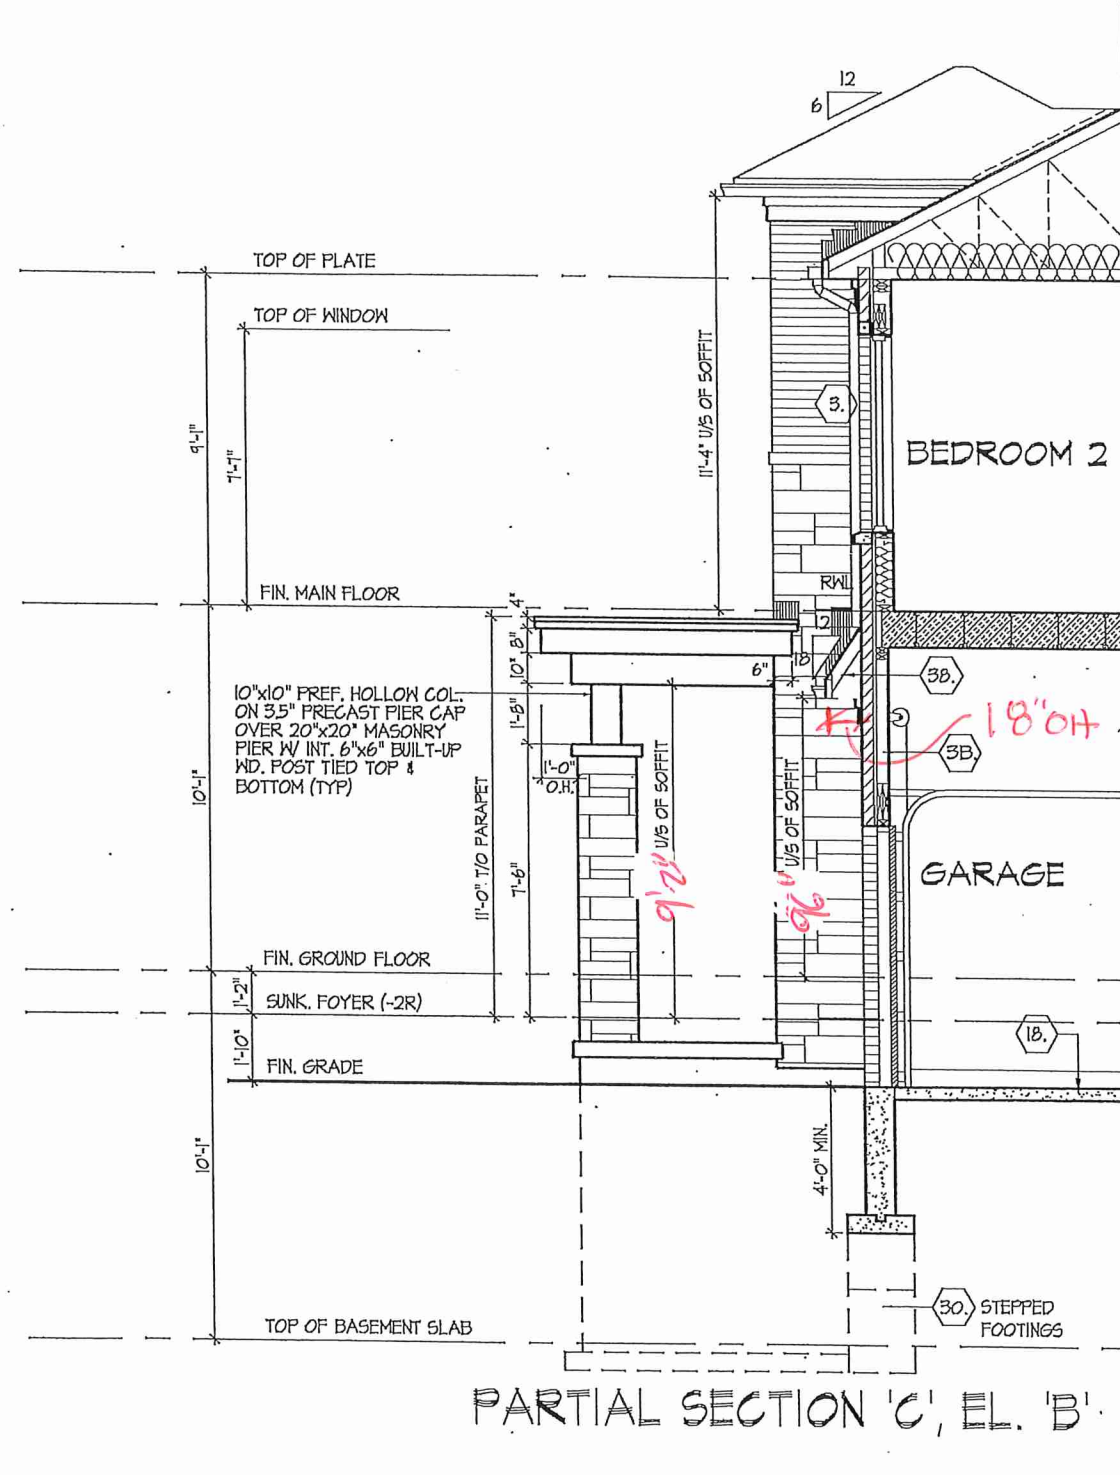

PARTIAL SECTION 'C', EL. 'B'

BLK 234-62

HUNT
DESIGN ASSOCIATES INC.

ROYAL PINE HOMES - 216102


'CENTREFIELD', WEST GORMLEY

Drawn By	Checked By	Scale

KM DS $3/16"=1.0"$

8966 Woodbine Ave, Markham, ON L3R 0J7

without H.D.A.'s written permission (H.D.A. assesses fee 100,000,000 VND)

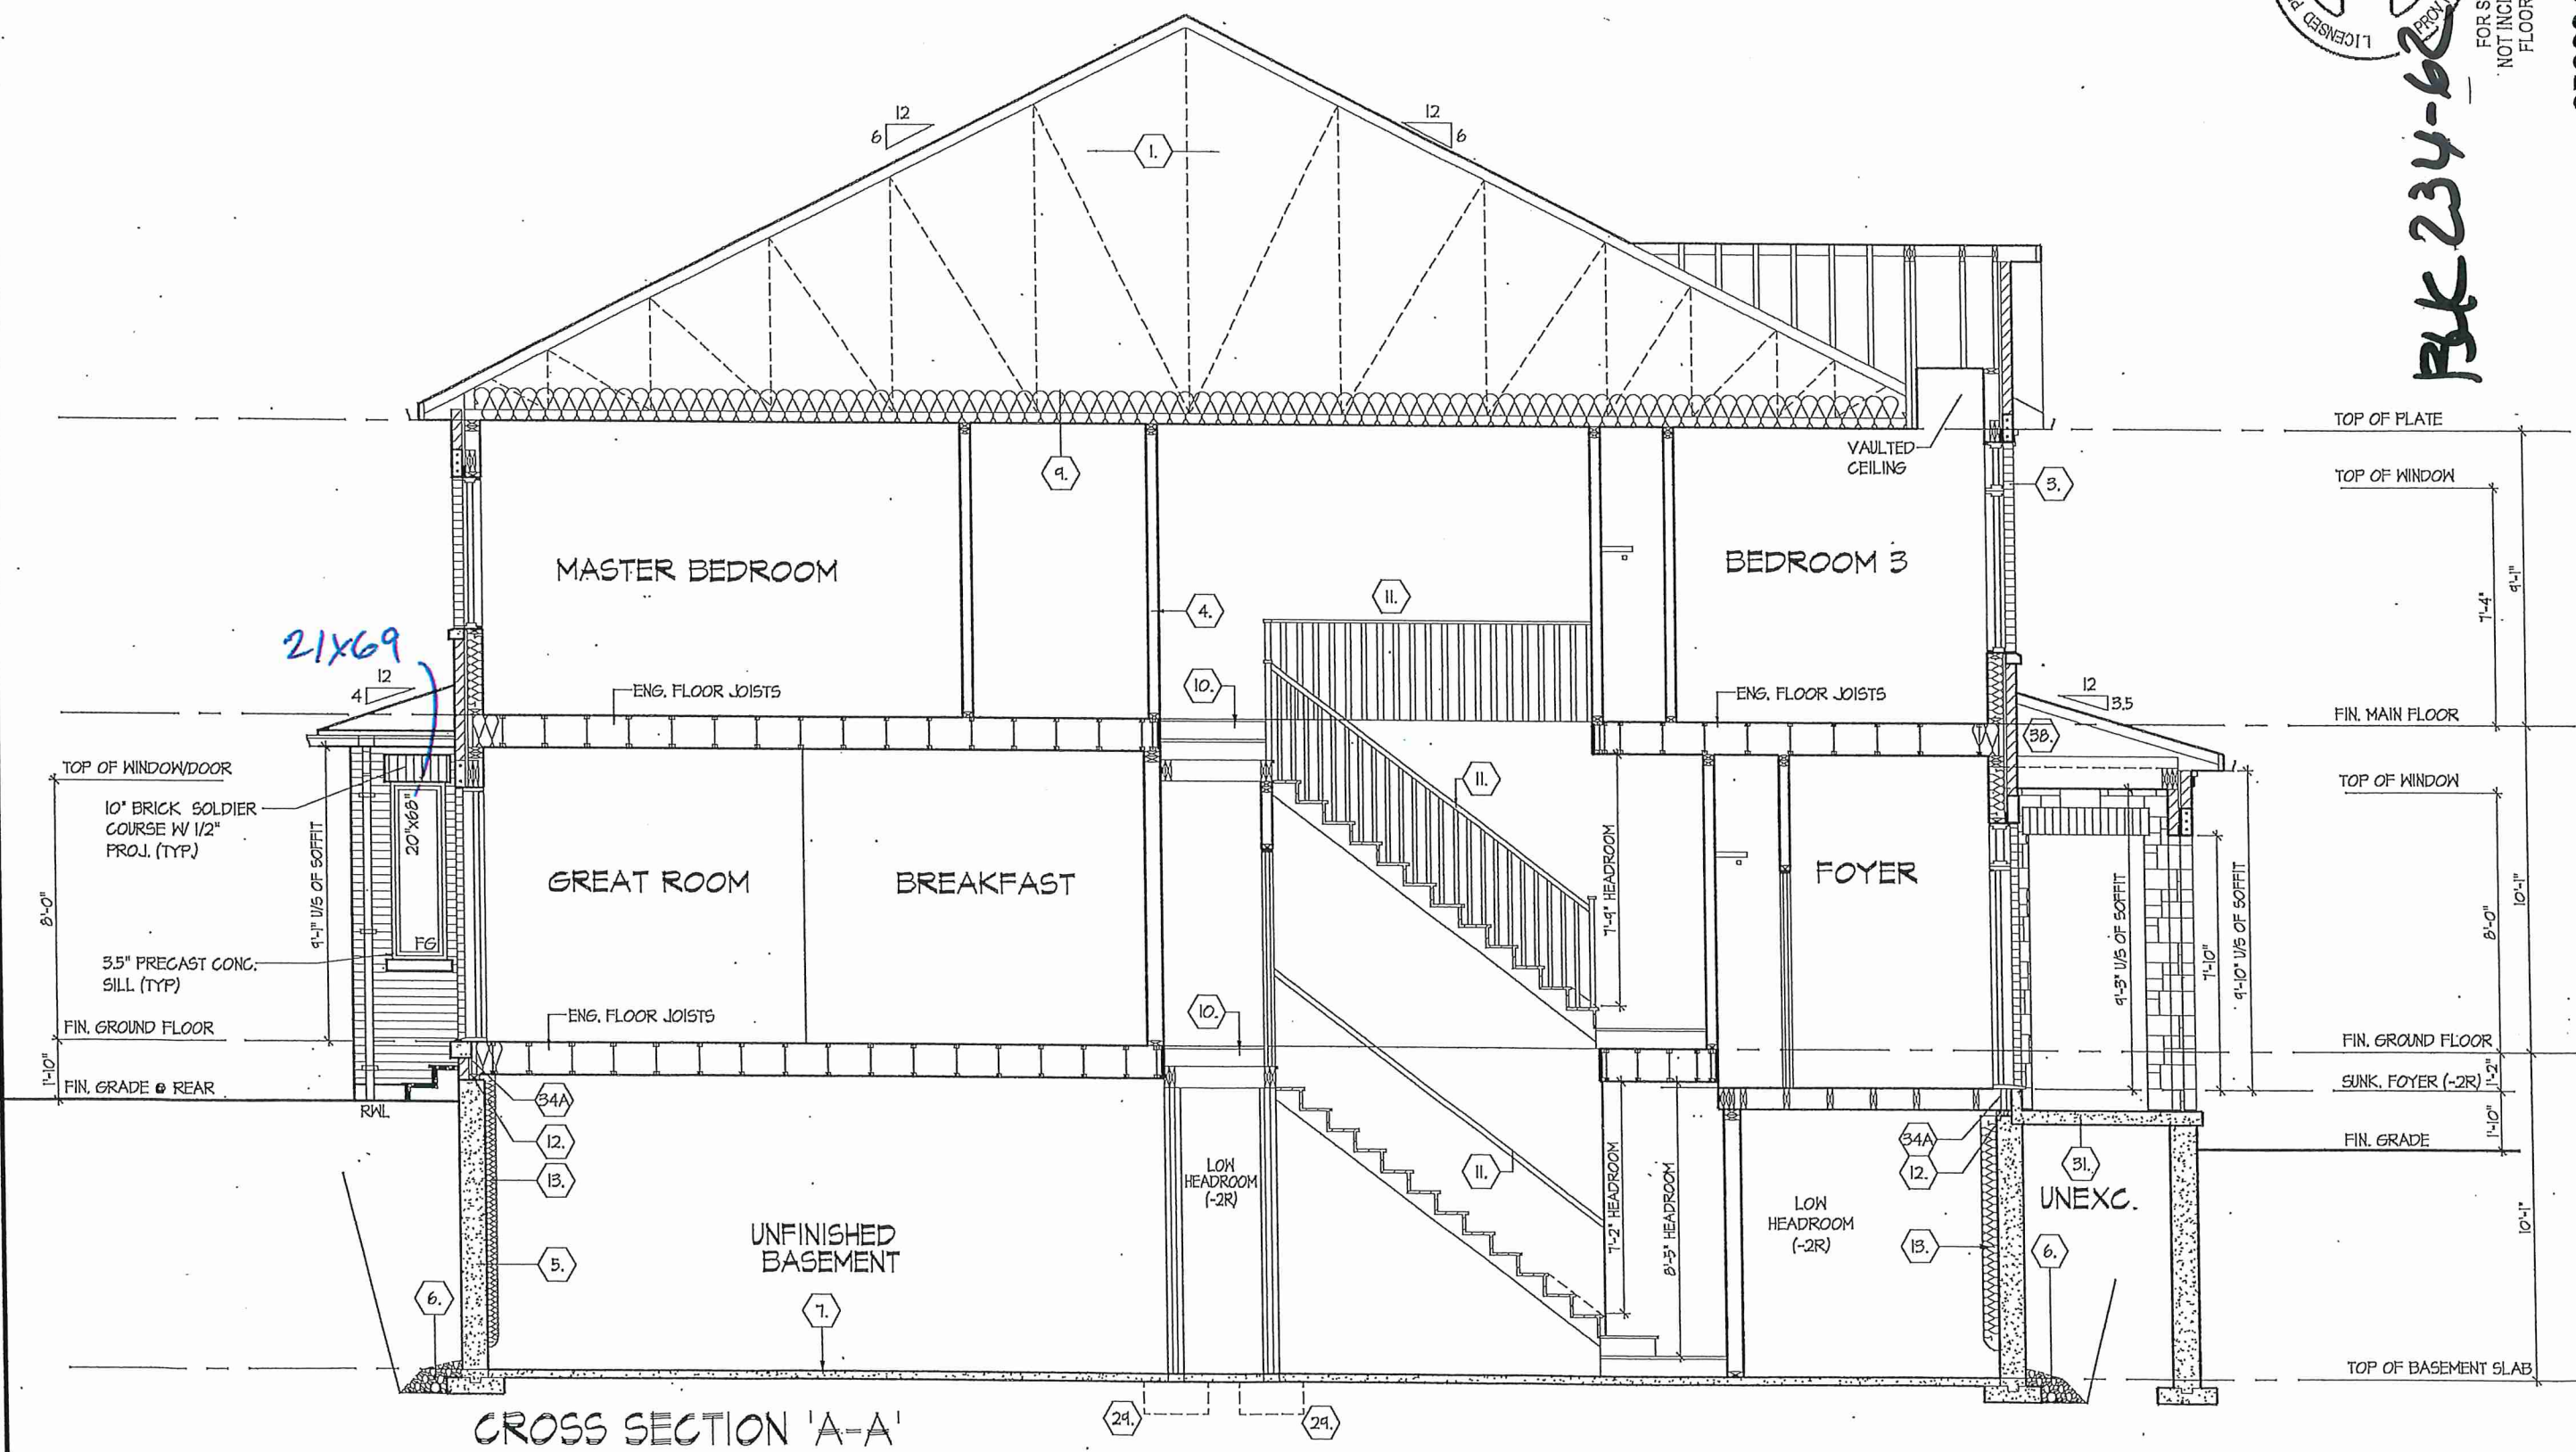

CROSS SECTION 'A-A'



FOR STRUCTURAL ONLY
NOT INCLUDING ENGINEERED
FLOOR OR ROOF SYSTEM

CROSS SECTION 'A-A'

UNIT 2009-END

ROYAL PINE HOMES - 216102
'CENTREFIELD', WEST GORMLEY, RICHMOND HILL, ON. REV. 2021.05.11



DESIGN ASSOCIATES INC.
www.hunt-design.ca
8966 Woodbine Ave, Markham, ON L3R 0J7
T 905.737.5193 F 905.737.7326
Drawn By: KM
Checked By: DS
Scale: 3/16" = 1'-0"
File Number: 216102WT2009-END
Page Number: 15 of 18

THE UNDERSIGNED HAS REVIEWED AND TAKES RESPONSIBILITY FOR THIS DESIGN AND HAS THE QUALIFICATIONS AND MEETS THE REQUIREMENTS SET OUT IN THE ONTARIO BUILDING CODE TO BE A DESIGNER.
QUALIFICATION INFORMATION
Derek R. Santos
NAME
REGISTRATION INFORMATION
37308 BCIN
19655
HUNT DESIGN ASSOCIATES INC.
All drawings specifications related documents and design are the copyright property of Hunt Design Associates (H.D.A.). Reproduction of this property in whole or in part is strictly prohibited without H.D.A.'s written permission (H.D.A. assumes no responsibility or liability for this property unless it bears the appropriate BCIN number and original signature.)

FIRE RATINGS - PARTY WALL TRUSS SPACE (OBC REF. - SB-2.3)		
COMPONENT	FIRE RATING	CODE REFERENCE
5/8" (15.9mm) TYPE X GYPSUM WALL BOARD	40 min.	O.B.C. SB-2.3.4.(2) (TABLE 2.3.4.A)
WOOD TRUSSES	NO RATING ASSIGNED	
5/8" (15.9mm) TYPE X GYPSUM WALL BOARD	40 min.	O.B.C. SB-2.3.4.(2) (TABLE 2.3.4.A)
TOTAL FIRE RATING	80 min.	O.B.C. SB-2.3.4.(1)

FIRE & SOUND RATINGS - PARTY WALL		
WALL TYPE	CODE REFERENCE	RATING
W150	O.B.C. SB-3	54 STC 10 IIR FRR

FILL ANY VOID TO UNDERSIDE OF ROOF DECK AND TOP OF WALL WITH MINERAL WOOL

WHEN ROOF JOISTS SPACING EXCEEDS 24" O.C. PROVIDE H-CLIPS @ 12" O.C.

TYPICAL ROOF & EAVES CONSTRUCTION

5/8" TYPE 'X' GYPSUM SHTS' ON PREMANUFACTURED ROOF TRUSS ON 5/8" TYPE 'X' GYPSUM SHTS'. PREMANUFACTURED ROOF TRUSS ON 5/8" TYPE 'X' GYPSUM SHTS'. TAPE FILL AND SAND ALL GYPSUM JOINTS TO PREVENT SOUND LEAKAGE. ALL DRYWALL EDGES TO BE SUPPORTED

PROVIDE 2 LAYERS 1/2" TYPE 'X' GYPSUM BOARD FIRESTOP.

PROVIDE 2 LAYERS 1/2" TYPE 'X' GYPSUM BOARD FIRESTOP. (SEPARATELY FASTEN 1 LAYER TO EACH HEADER BEFORE INSTALLATION OF HEADER)

5/8" TYPE 'X' GYPSUM SHTS' ON BLOCKING ON CONTINUOUS HEADER BOARD, EACH SIDE

FURR OUT BOXING FROM FACE OF GYPSUM SHTS' TO ENCLOSE ANY MECHANICAL'S

PROVIDE 2 LAYERS 1/2" TYPE 'X' GYPSUM BOARD FIRESTOP. (SEPARATELY FASTEN 1 LAYER TO EACH HEADER BEFORE INSTALLATION OF HEADER)

5/8" TYPE 'X' GYPSUM SHTS' ON BLOCKING ON CONTINUOUS HEADER BOARD, EACH SIDE

FURR OUT BOXING FROM FACE OF GYPSUM SHTS' TO ENCLOSE ANY MECHANICAL'S

5/8" TYPE 'X' GYPSUM SHTS' ON APPROVED AIR BARRIER ON EACH EXTERIOR SIDE OF 2 ROWS OF 2"x4" STUDS @ 16" O.C., 1" APART AND ON SEPARATE 2"x4" SILL PLATES TIED TO TOP OF FOUNDATION WALL. FILL ONE SIDE OF STUD CAVITY WITH AT LEAST 40% OF ABSORPTIVE MATERIAL PROCESSED FROM ROCK, SLAG OR GLASS. TAPE FILL AND SAND ALL GYPSUM JOINTS TO PREVENT SOUND LEAKAGE. ALL DRYWALL EDGES TO BE SUPPORTED

NOTE:
TO HOLD INSULATION PROVIDE 4" WIDE 1/2" GYPSUM SHEATHING OR 4" WIDE 1/4" PLYWOOD SHEATHING @ 24" O.C. VERT. ON EXTERIOR FACE OF STUD (IN AIR SPACE)

5/8" TYPE 'X' GYPSUM SHTS' ON BLOCKING ON CONTINUOUS HEADER BOARD, EACH SIDE

PROVIDE 2 LAYERS 1/2" TYPE 'X' GYPSUM BOARD FIRESTOP. (SEPARATELY FASTEN 1 LAYER TO EACH HEADER BEFORE INSTALLATION OF HEADER)

MINIMUM 2"x4" SILL PLATE (2"x6" AS REQ.), TIED TO TOP OF POURED CONC. FND. WALL WITH 8" LONG 1/2" ANCHOR BOLTS C/M NUT AND WASHER WITH 2 1/2" HOOK. ANCHOR BOLTS TO BE SPACED NOT MORE THAN 1'-0" O.C. AND EMBEDDED NOT LESS THAN 4" INTO CONC. PROVIDE SILL GASKET BETWEEN PLATE AND FOUNDATION WALL. PROVIDE NON-SHRINK GROUT TO LEVEL PLATE.

UNFINISHED BASEMENT
8" POURED IS MPa CONCRETE FOUNDATION WALL ON POURED CONC. FOOTING

3" MIN. 25 MPa CONC. SLAB ON 4" COARSE CLEAN GRANULAR FILL OR 20 MPa CONC. WITH DAMPROOFING BELOW SLAB.

CONTINUOUS KEY IN CONCRETE

POURED CONC. FOOTINGS. SEE MINIMUM STRIP FOOTING SIZES FOR EXTERIOR WALLS' CHART

NOTE: POURED CONC. FOOTING ON NATURAL UNDISTURBED SOIL OF 15KPa OR COMPACTED ENGINEERED FILL WITH MIN. BEARING CAPACITY OF 150KPa. FOOTING SIZE SHOWN FOR 16'-0" (4.9m) MAXIMUM JOIST SPAN ONLY. JOIST SPAN EXCEEDING 16'-0" (4.9m) SHALL BE ENGINEERED. IF SOIL BEARING DOES NOT MEET MINIMUM CAPACITY, ENGINEERED FOOTINGS ARE REQUIRED. ACTUAL SOIL BEARING CAPACITY TO BE VERIFIED WITH SOIL ENGINEERING REPORT.

MINIMUM STRIP FOOTING SIZES (1515.3)		
NUMBER FLOORS SUPPORTED	SUPPORTING INT. LOAD BEARING MASONRY WALL	SUPPORTING PARTY WALL
1	16" W x 8" D	16" W x 8" D
2	24" W x 8" D	20" W x 6" D
3	36" W x 14" D	26" W x 4" D

NOTE: FOOTING SIZE SUBJECT TO CERTIFICATION BY A SOIL CONSULTANT

TYPICAL 1 HR PARTY WALL SECTION, PARALLEL ROOF TRUSSES, 2"x4" DOUBLE STUDS - 3 STOREY

1/2" = 1'-0"

SB-12 E

PRESCRIPTIVE COM

PA

BUILDING COMPO

CEILING W/ ATTIC S

CEILING W/O ATTIC

EXPOSED FLOOR

WALLS ABOVE GRA

BASEMENT WALLS

* PROPOSED VALU

BELOW GRADE SLA

EDGE OF BELOW G

HEATED SLAB OR S

WINDOWS/SLIDING

SKYLIGHTS (MAX. U

SPACE HEATING EC

H/RV EFFICIENCY (%)

DHW HEATER (EF)

AREA CALCULATIONS

GROUND FLOOR AREA

MAIN FLOOR AREA

THIRD FLOOR AREA

SUBTOTAL

DEDUCT ALL OPEN AREAS

TOTAL NET AREA

COVERAGE

W/O UT PORCH

COVERAGE

W/ PORCH

WINDOW / WALL AREA

CALCULATIONS

GROSS WALL AREA

GROSS WINDOW AREA

(INCL. GLASS DOORS & SKYLIGHT

TOTAL WINDOW %