






BAYVIEW HEIGHTS

RICHMOND HILL



Materials, specifications and floor plans are subject to change without notice. All renderings are artist's concept. All floor plans are approximate dimensions. Actual usable floor space may vary from the stated floor area. E.&O.E.

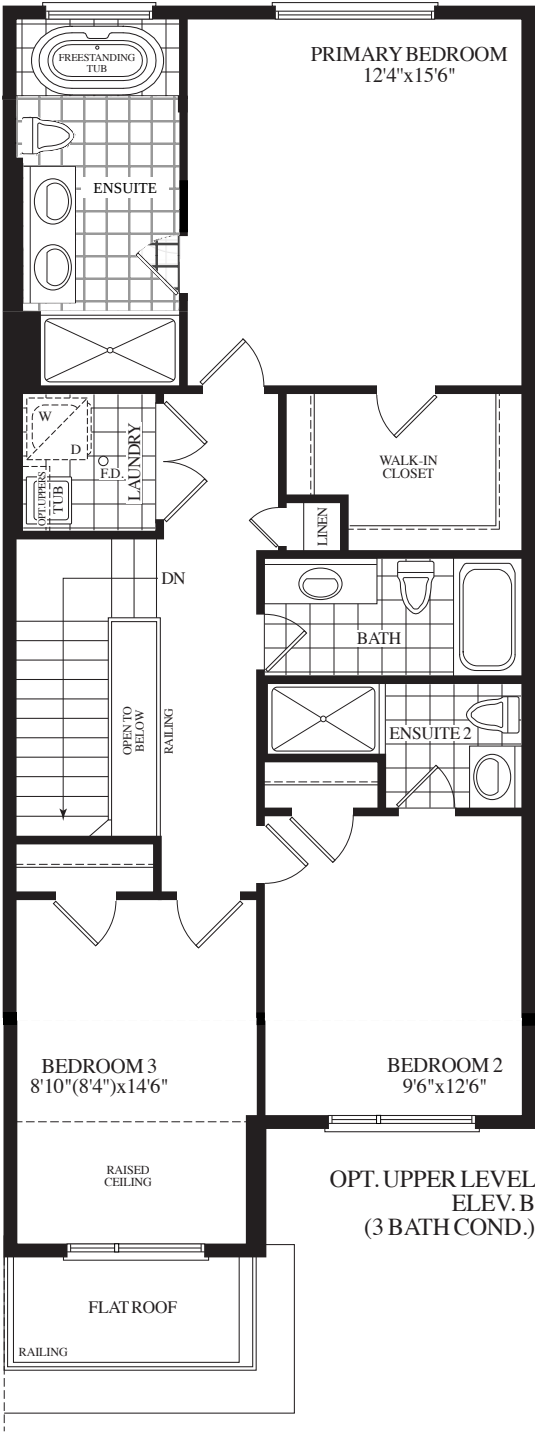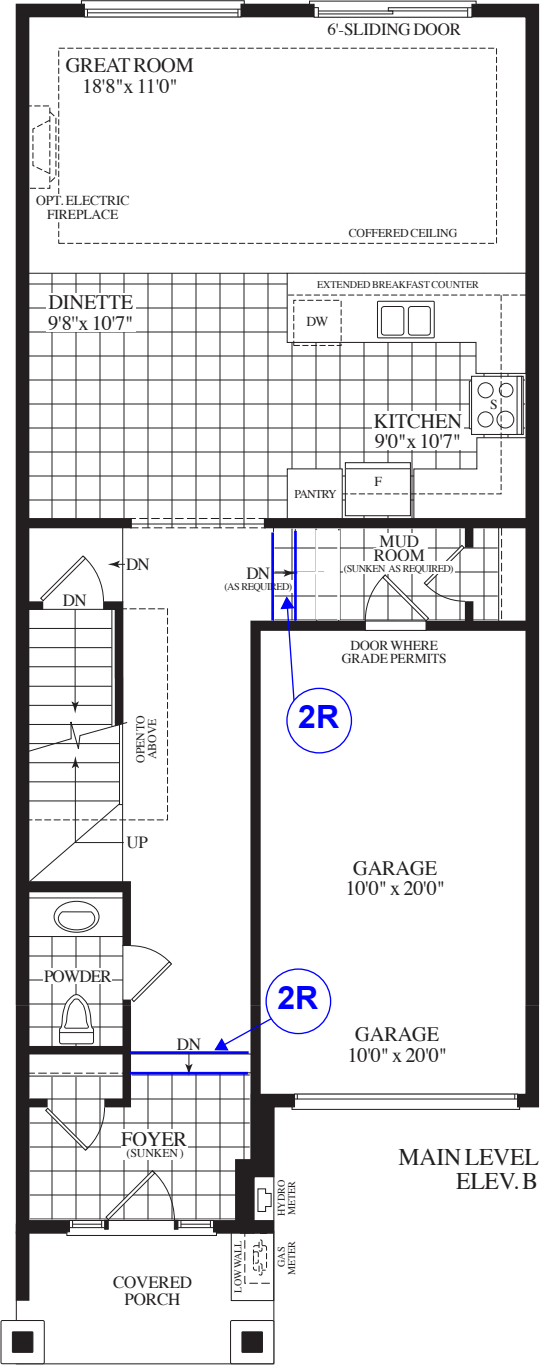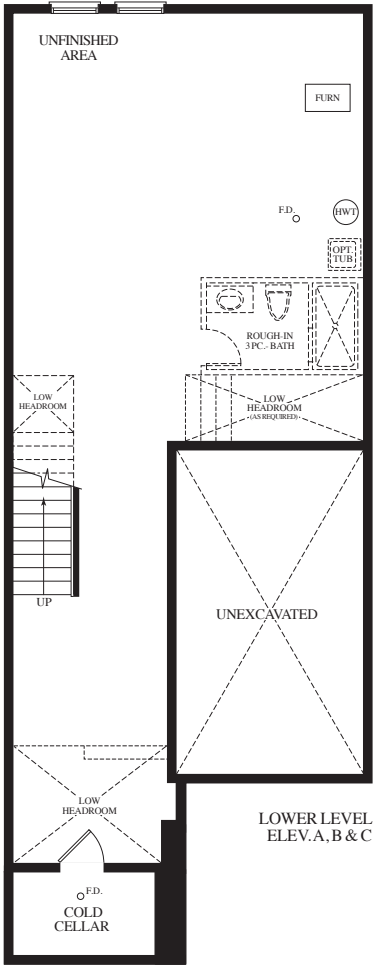



THE CHARLOTTE
20-16
1,795 SQ.FT.

BLK. 9 TH.57
EL. B

SCHEDULE "B"

Purchaser

And

Vendor

Lot Number

Date of Offer

Dated Required:

Model:

YANG WANG

EARLGLEN INVESTMENTS INC.

057 BLOCK 009 HOOK DRIVE, Phase 1, Plan as per schedule C

in the CITY of RICHMOND HILL

February 06, 2025

April 01, 2026

THE CHARLOTTE-ELEV B-STD MAIN-3 BDRM-3 BATHS (20-16BSO)

Description - Vendor to Supply and Install the Following as Per Purchase Price
■ PURCHASER HAS APPLIED THE \$10,000.00 BONUS PACKAGE TOWARDS THE PURCHASE OF 3 BATHROOM LAYOUT. NO FURTHER BONUS IS AVAILABLE ■ APPLIANCE PACKAGE: PURCHASER TO RECEIVE 5 APPLIANCES TO INCLUDE FRIDGE, STOVE, DISHWASHER WITH STAINLESS STEEL FINISH AND WHITE WASHER & DRYER AS PER VENDORS SAMPLES. ■ COMPLETE CENTRAL AIR CONDITIONING SYSTEM, AS PER VENDORS STANDARD SAMPLES. ■ VENDOR AGREES TO SUPPLY AND INSTALL 7 1/2inch LAMINATE FLOORING ON UPPER HALLWAY, AS PER PLAN AND AS PER VENDORS STANDARD SAMPLES.