




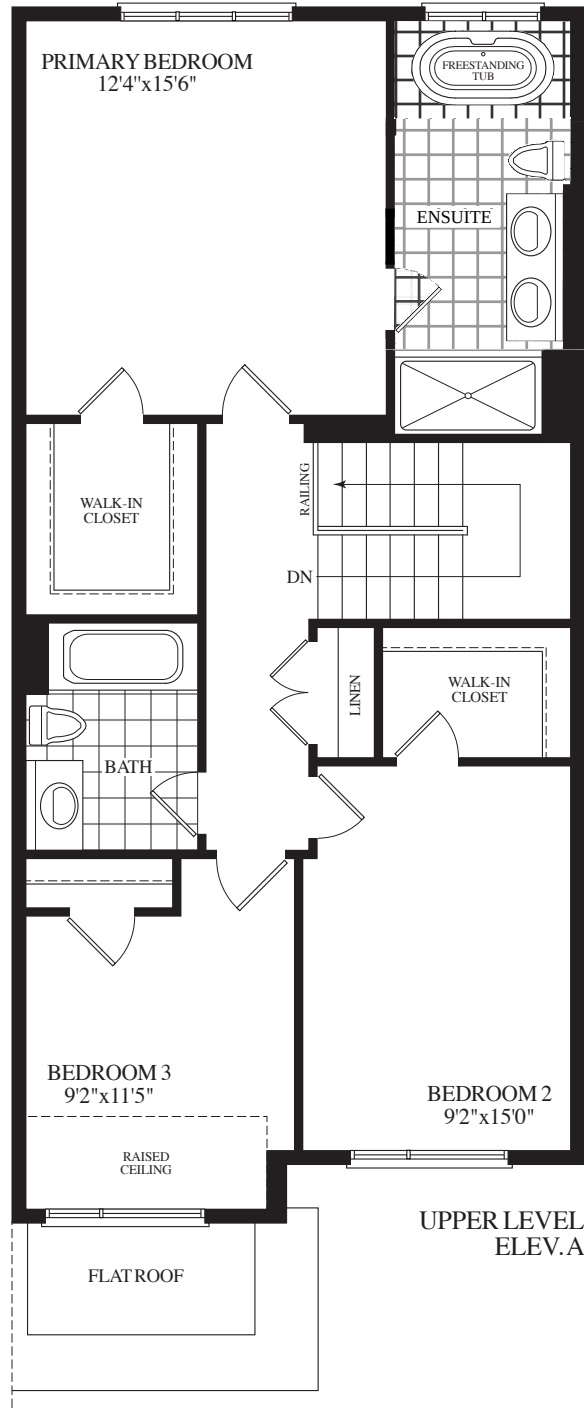

Materials, specifications and floor plans are subject to change without notice. All renderings are artist's concept. All floor plans are approximate dimensions. Actual usable floor space may vary from the stated floor area. E.&O.E.

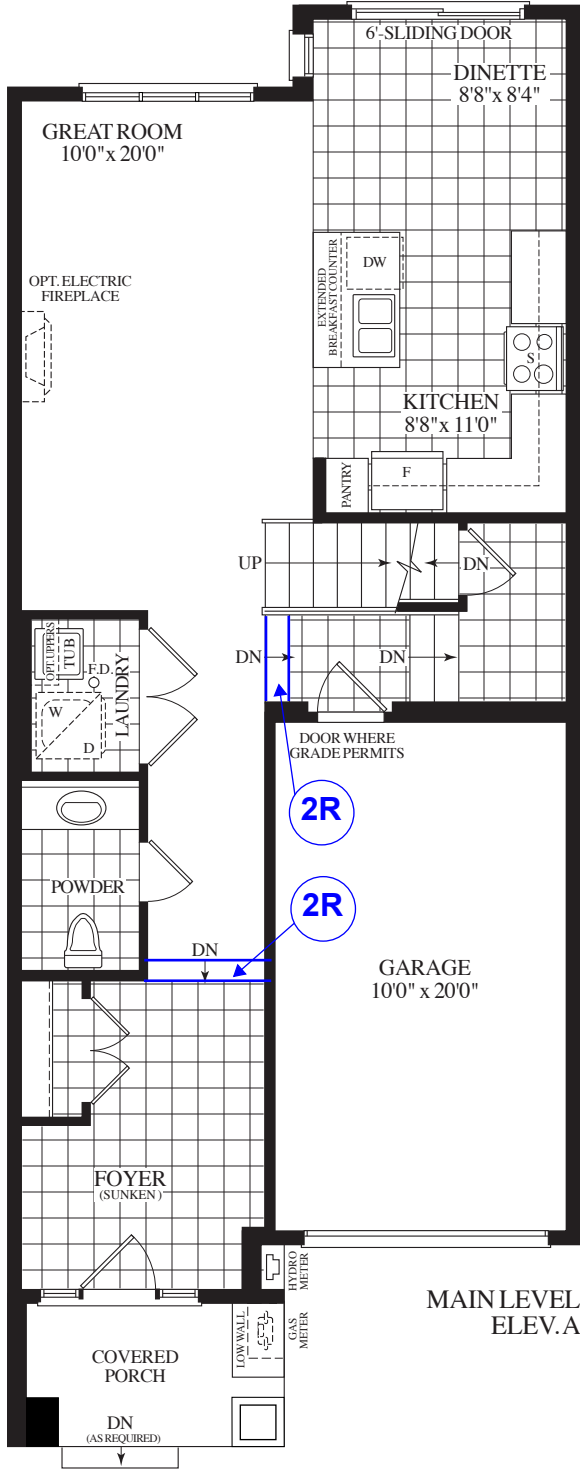

THE ANNE  
20-15  
1,685 SQ. FT.  
BLK. 17 TH. 108

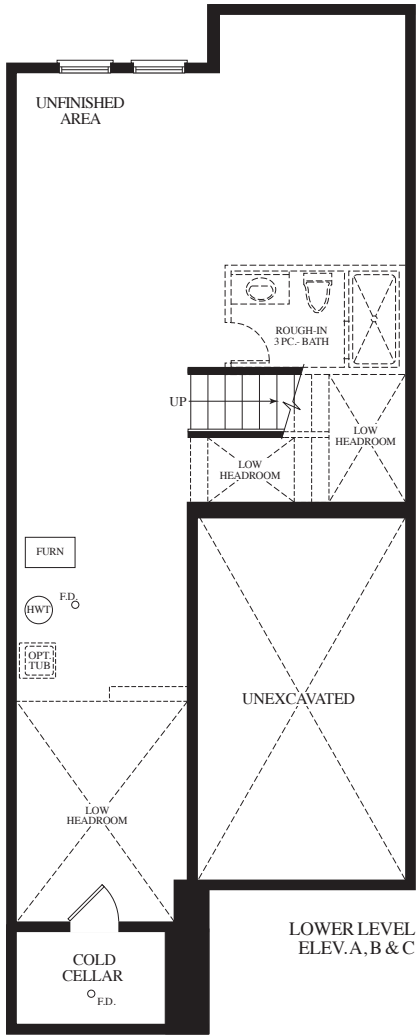

SCHEDULE "B"

Purchaser  
And  
Vendor  
Lot Number  
Date of Offer  
Dated Required:  
Model:

DIAN FA  
  
EARLGLEN INVESTMENTS INC.  
108 BLOCK 017 HOOK DRIVE, Phase 1, Plan as per schedule C  
in the CITY of RICHMOND HILL  
December 04, 2024  
September 08, 2026  
THE ANNE-ELEV A-3 BDRM-2 BATHS (20-15AS)

| Description - Vendor to Supply and Install the Following as Per Purchase Price                                                                                           |
|--------------------------------------------------------------------------------------------------------------------------------------------------------------------------|
| ■ BONUS PACKAGE: PURCHASER TO RECEIVE \$10,000 (INCLUSIVE OF TAXES) WORTH OF UPGRADES AT DECOR CENTER AT TIME OF COLOUR CHART.                                           |
| ■ APPLIANCE PACKAGE: PURCHASER TO RECEIVE 5 APPLIANCES TO INCLUDE FRIDGE, STOVE, DISHWASHER WITH STAINLESS STEEL FINISH AND WHITE WASHER & DRYER AS PER VENDORS SAMPLES. |
| ■ COMPLETE CENTRAL AIR CONDITIONING SYSTEM, AS PER VENDORS STANDARD SAMPLES.                                                                                             |
| ■ VENDOR AGREES TO SUPPLY AND INSTALL 7 1/2inch LAMINATE FLOORING ON UPPER HALLWAY, AS PER PLAN AND AS PER VENDORS STANDARD SAMPLES.                                     |