

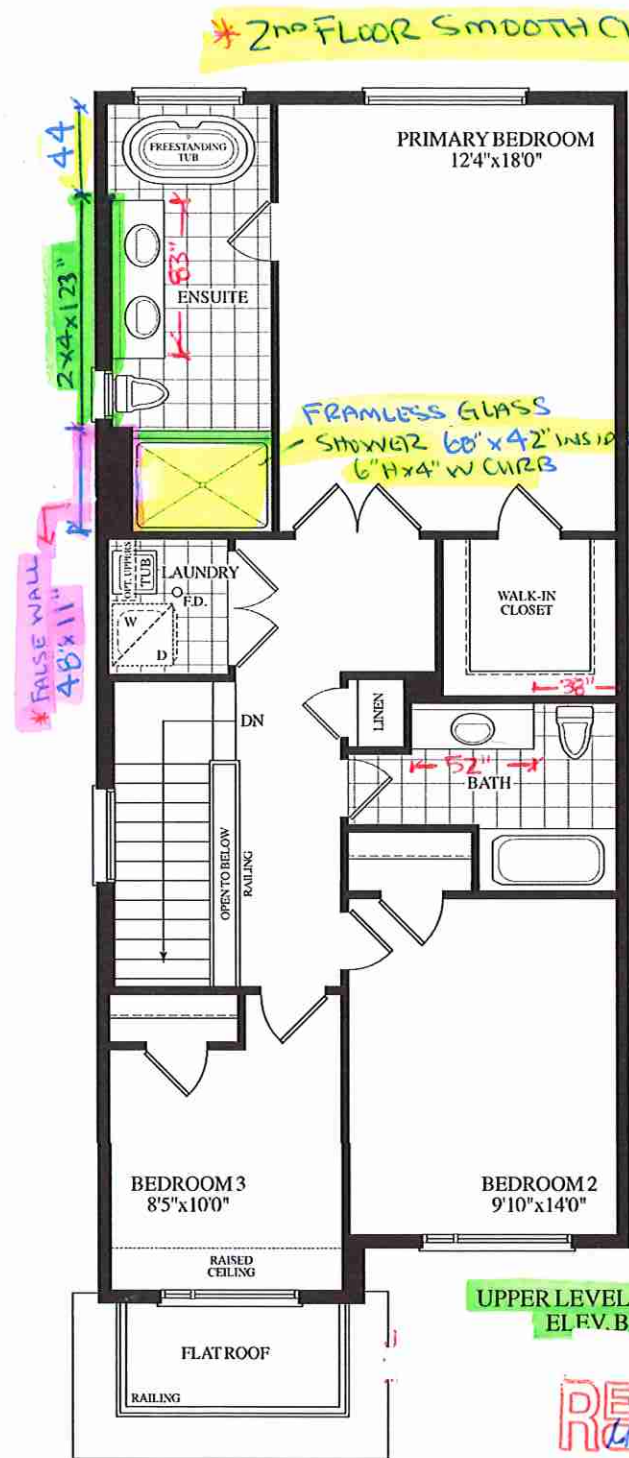
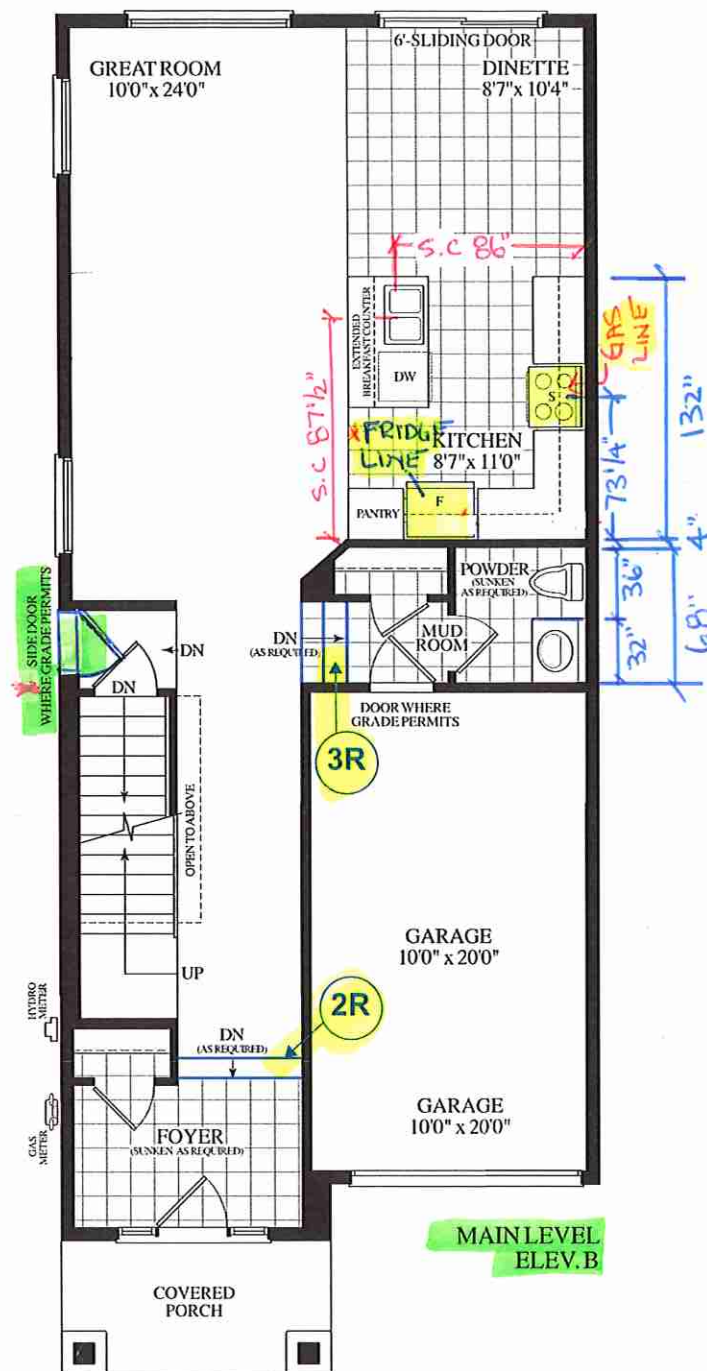 


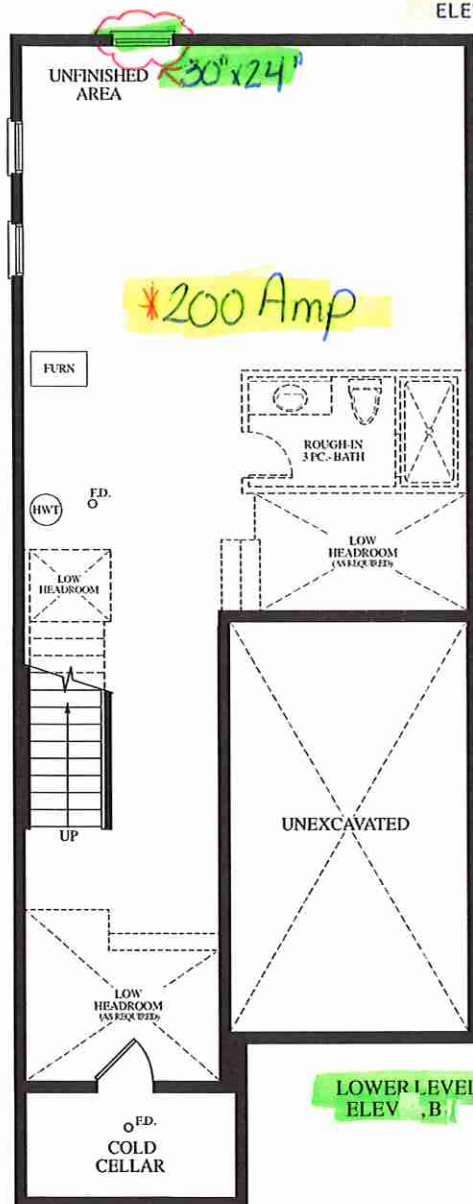

TEL: RES.: 647-894-1877



Materials, specifications and floor plans are subject to change without notice. All renderings are artist's concept. All floor plans are approximate dimensions. Actual usable floor space may vary from the stated floor area. E.&O.E.

BLK.9	TH. 53	20-18 THE KATHERINE (END)	EL. B	3 BDRM 2 BATH	1815 SQ.FT.
-------	--------	---------------------------	-------	---------------	-------------

RECEIVED
May 23/25