


BAYVIEW HEIGHTS


RICHMOND HILL



ELEVATION B

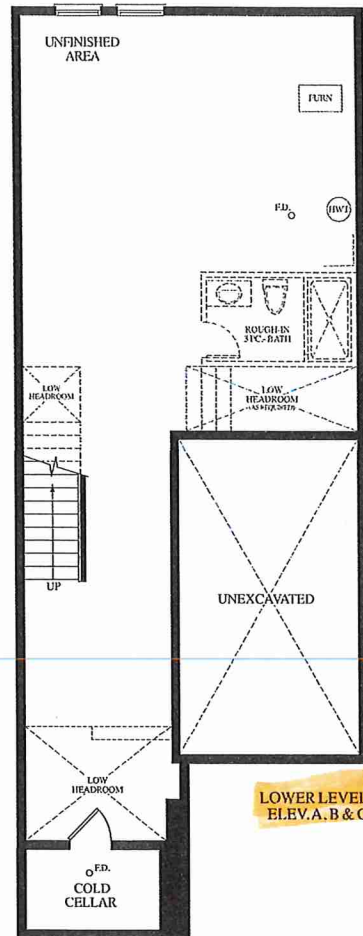


LOWER LEVEL
ELEV. A, B & C

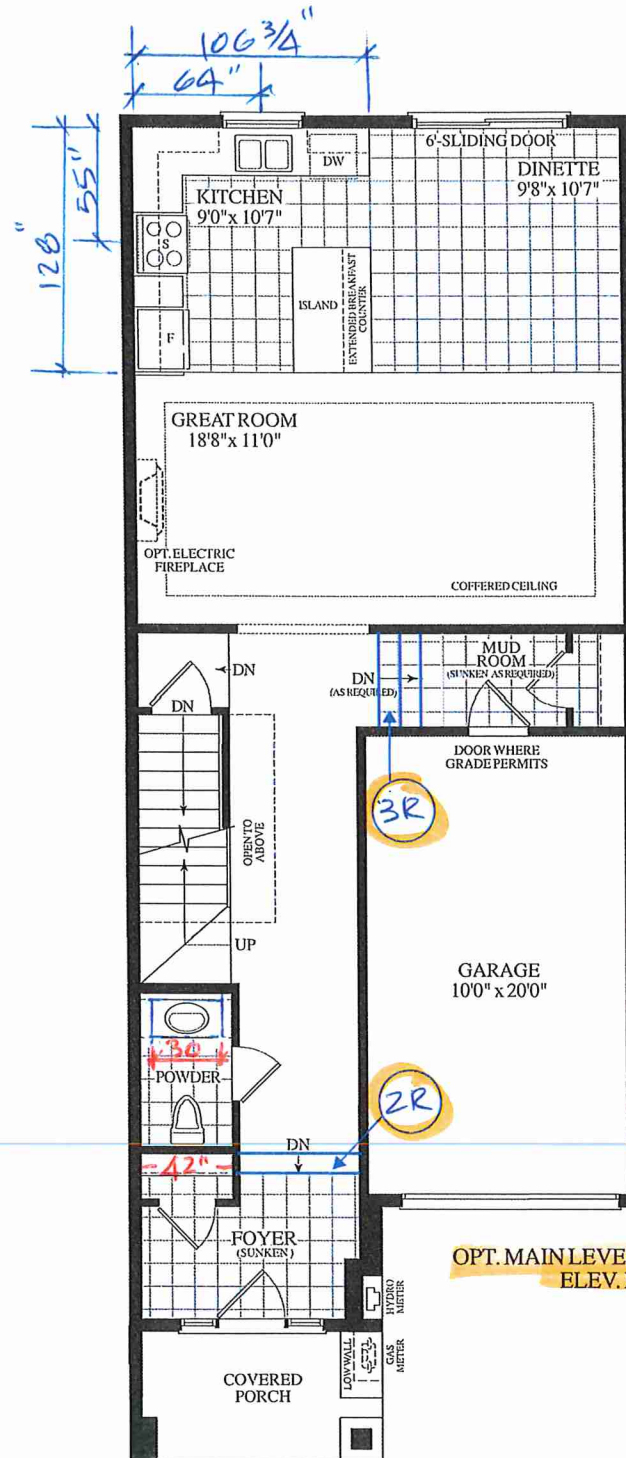

OPT. MAIN LEVEL
ELEV. B

Materials, specifications and floor plans are subject to change without notice. All renderings are artist's concept. All floor plans are approximate dimensions. Actual usable floor space may vary from the stated floor area. E.&O.E.

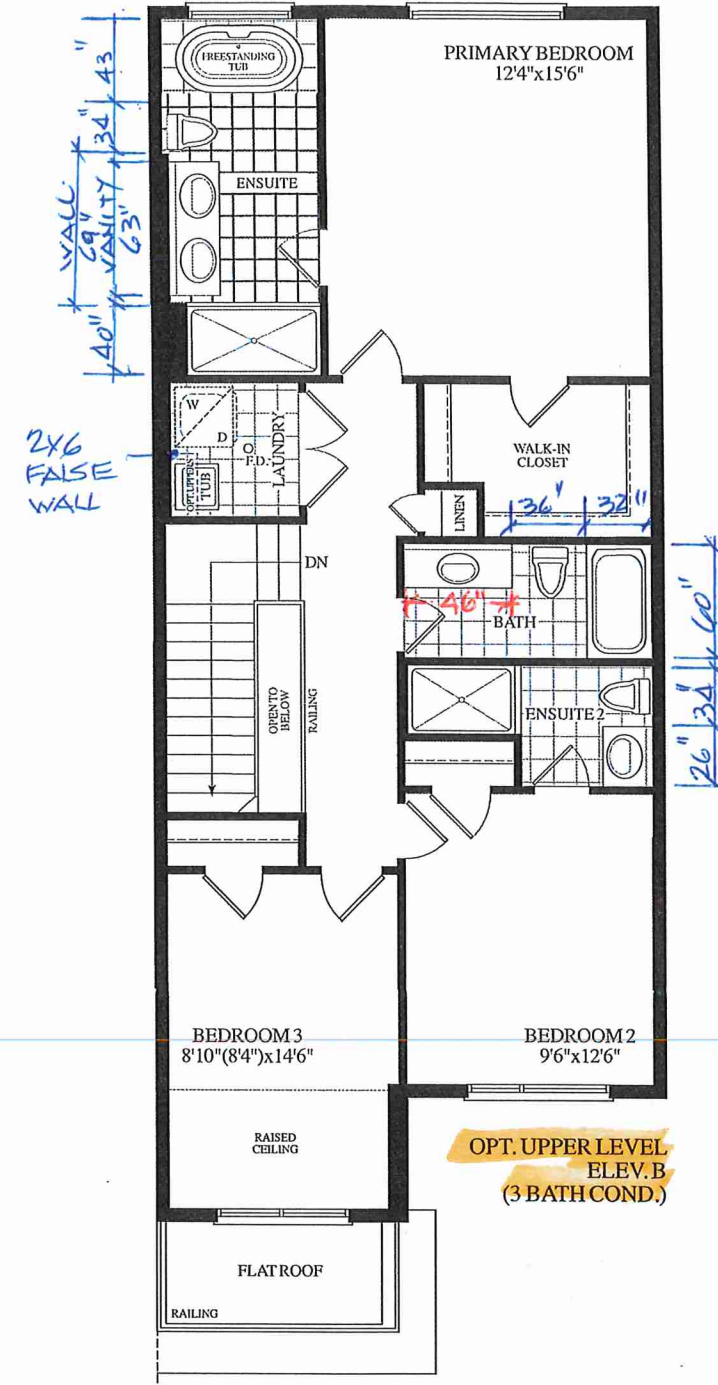

OPT. UPPER LEVEL
ELEV. B
(3 BATH COND.)

INVENTORY HOUSE

BLK. 18 TH. 115 20-16 THE CHARLOTTE EL. B OPT. MAIN 3 BDRM 3 BATH 1/95 SQ.FT.



ELEVATION B

THE CHARLOTTE

20-16

1,795 SQ.FT.

BLK. 18 TH.115