

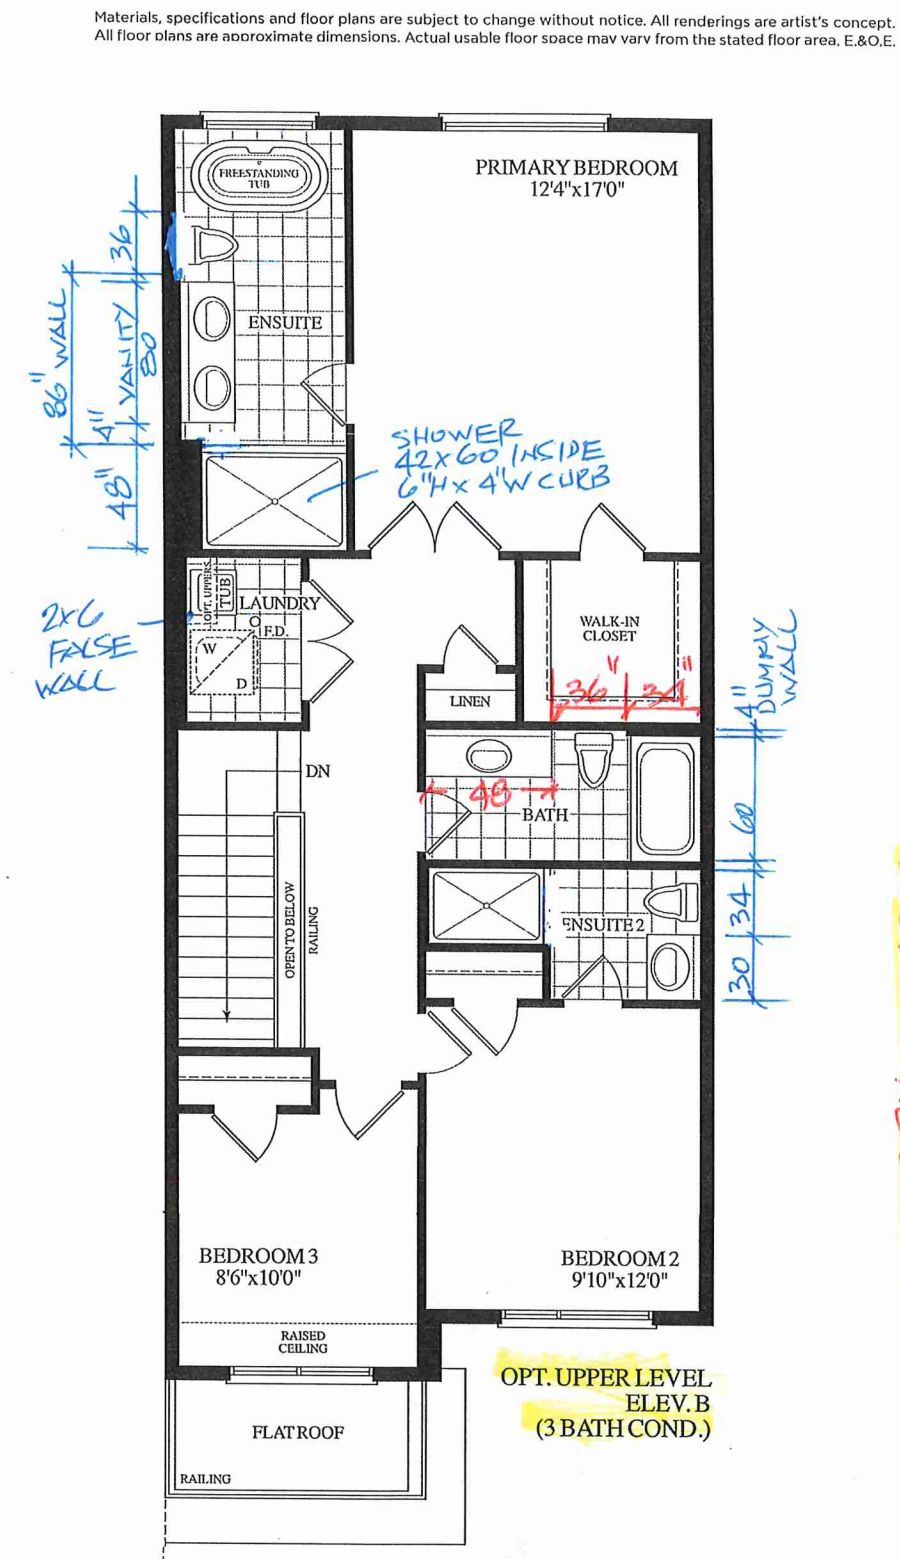


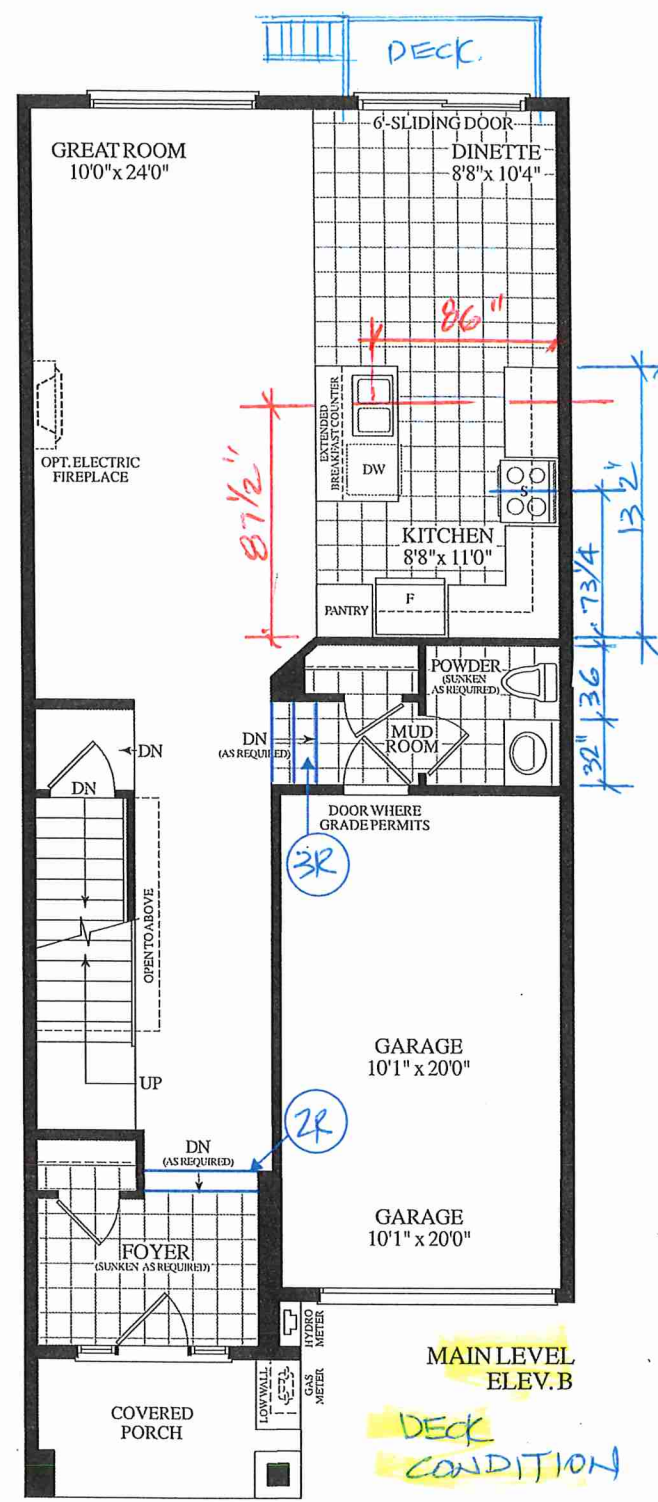

INVENTORY HOUSE

BLK.9 TH. 54	20-17 THE DIANA EL. B	DECK CONDITION 3 BDRM. 3 BATH.	1780 SQ.FT.
--------------	-----------------------	-----------------------------------	-------------

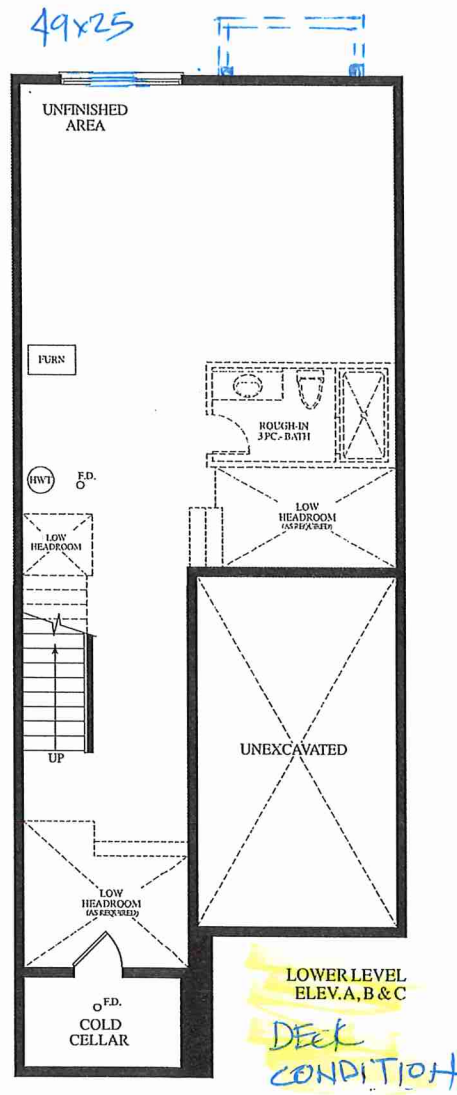

ELEVATION B

THE DIANA

20-17

1,780 SQ. FT.

BLK. 18 TH. 117