


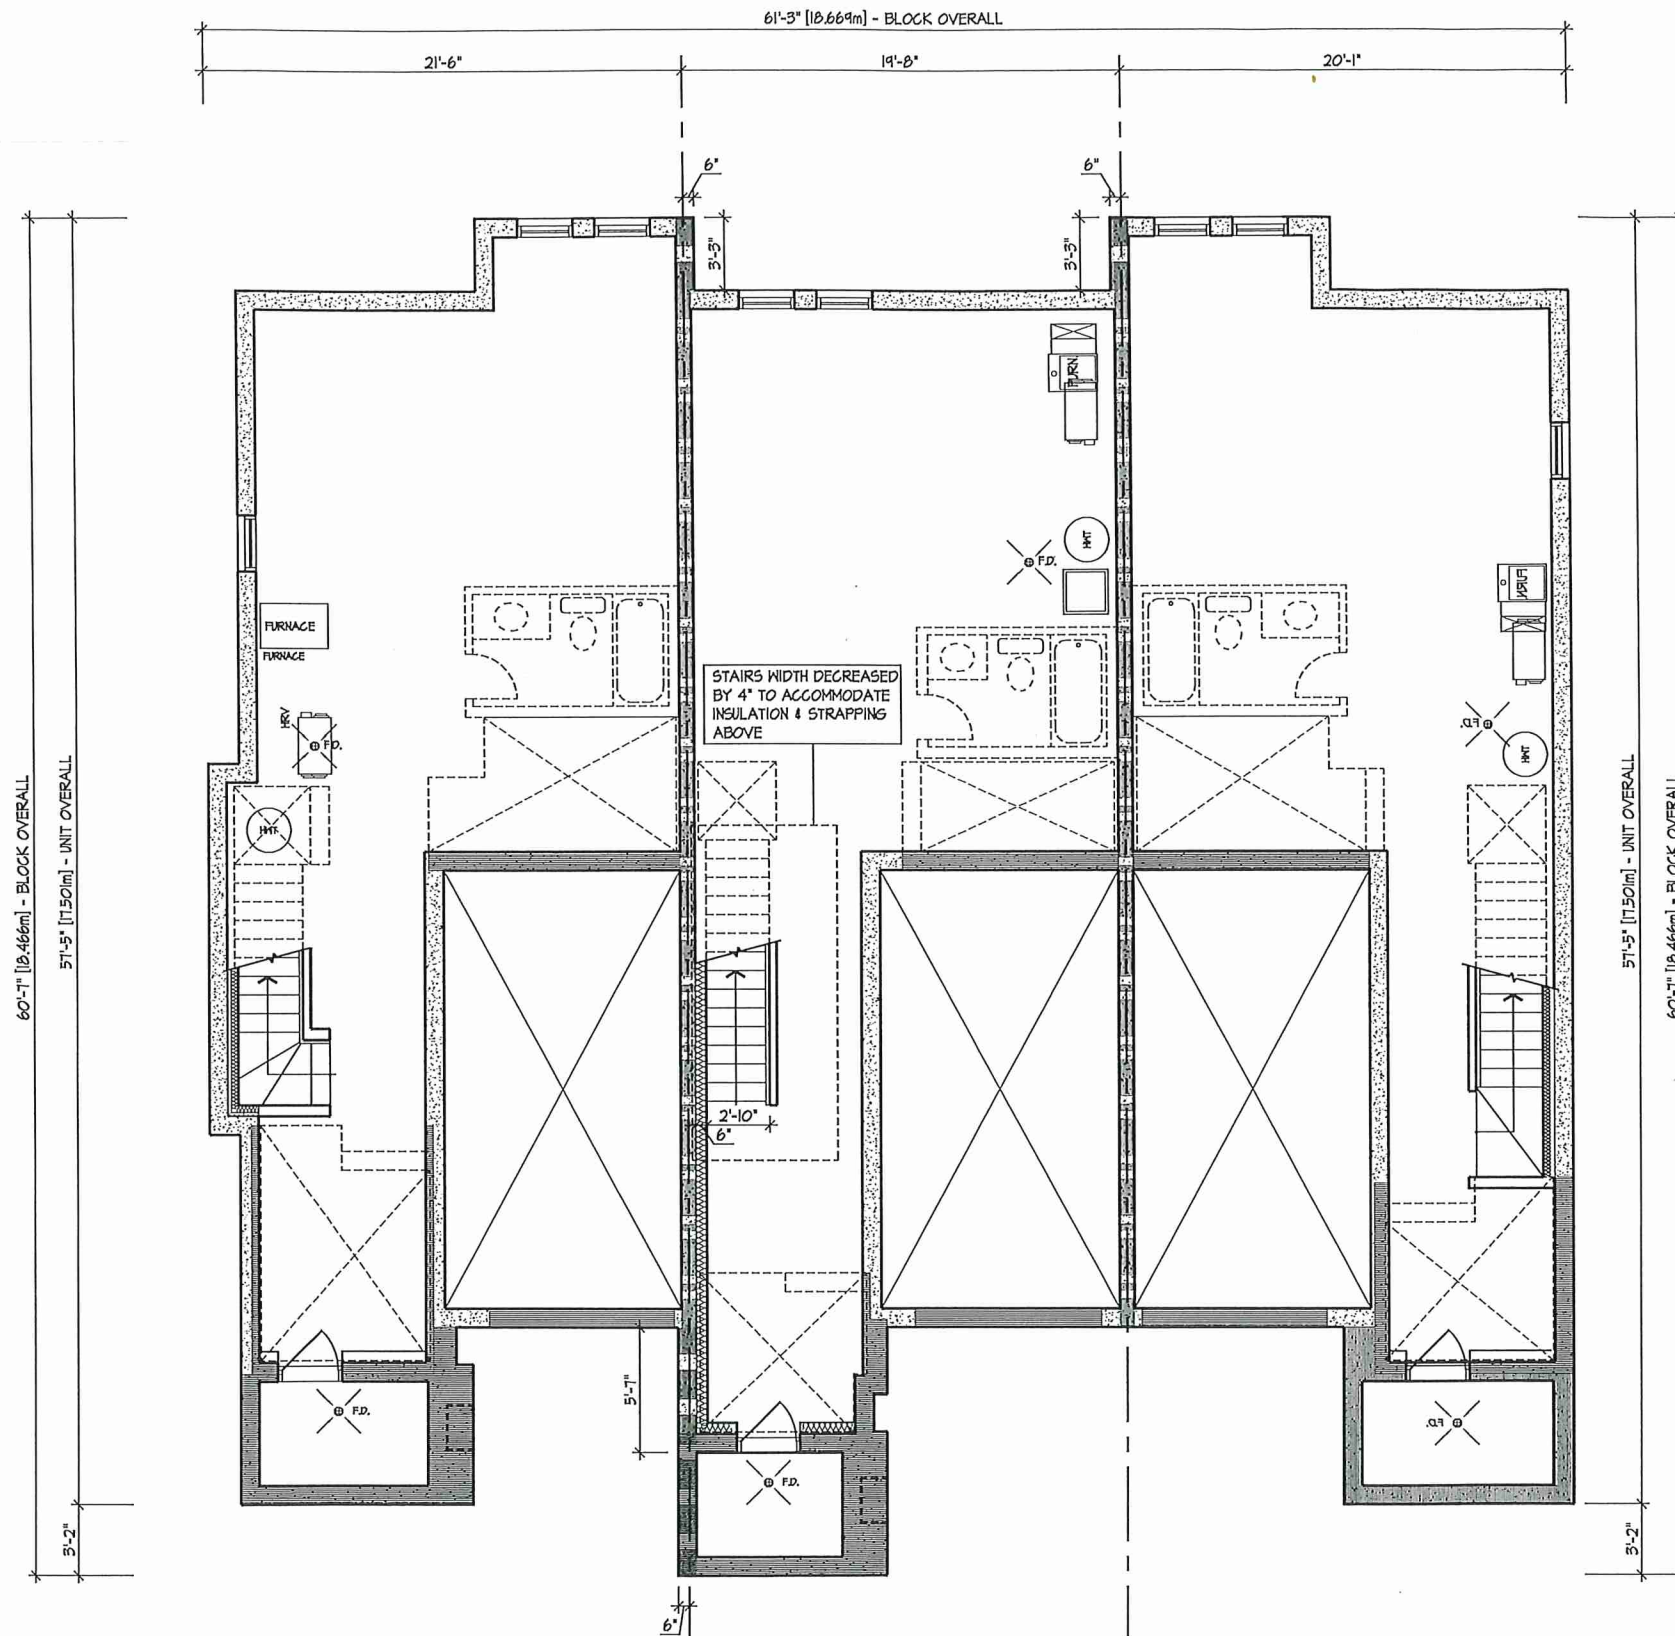


61 2010-FLANKAGE
233 EL. 'A'

60 2008
233 EL. 'A1'

59 2009-END
233 EL. 'A1' (REV)

BASEMENT PLAN

BK 233

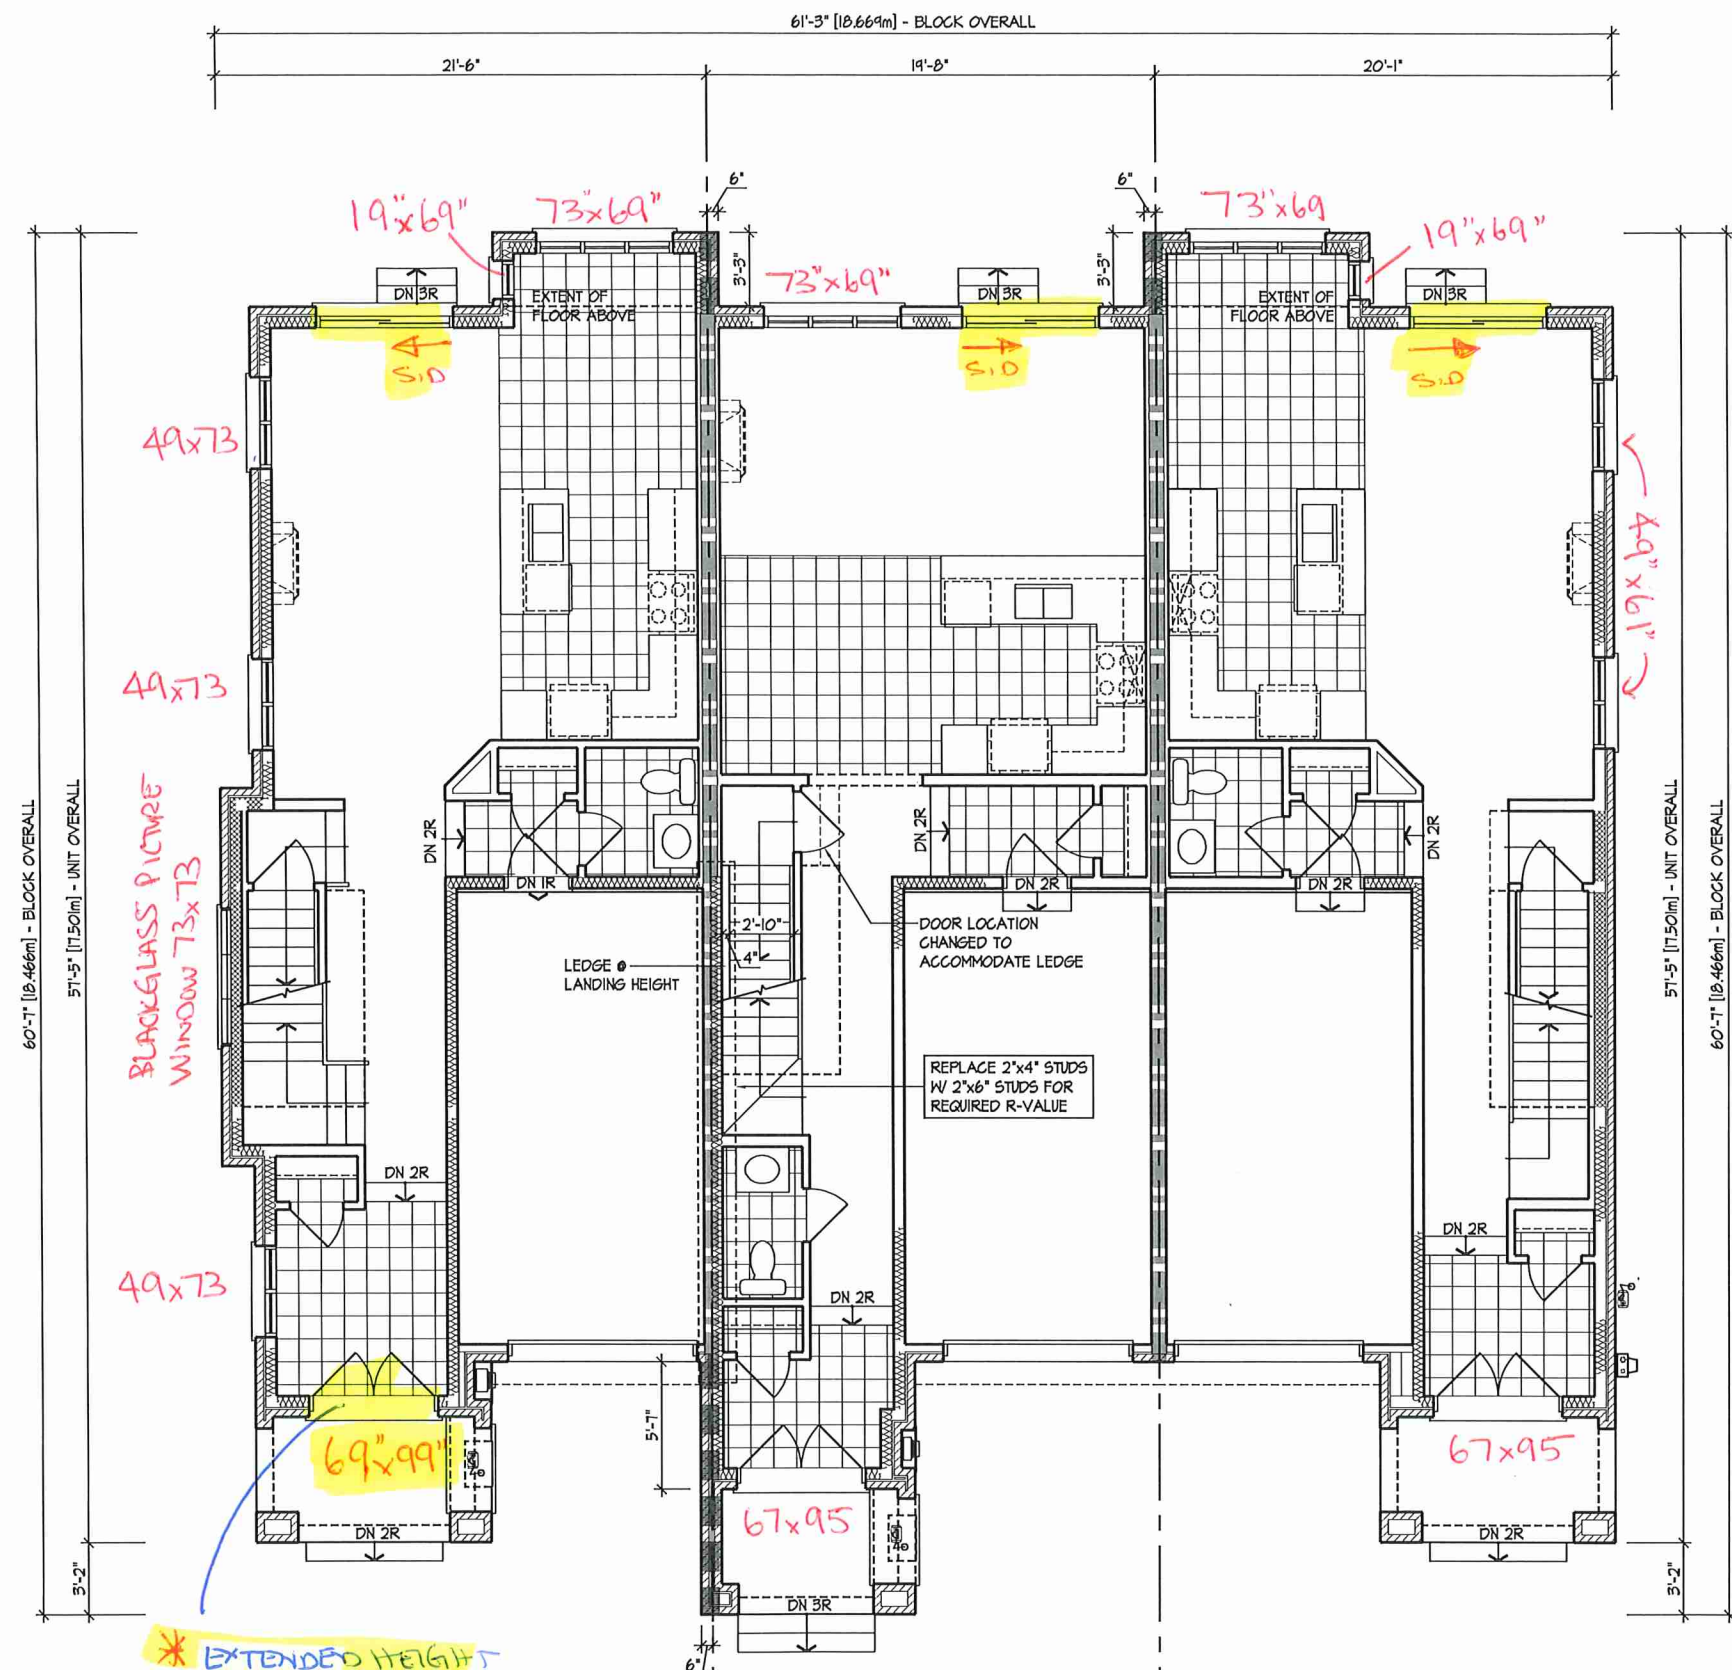


* EXTENDED HEIGHT
 8'-0" DOUBLE DOOR
 DELETE TRANSOM

61 2010-FLANKAGE
 233 EL. 'A' VOK


60 2008
 233 EL. 'A' VOK

59 2009-END
 233 EL. 'A' (REV) VOK

GROUND FLOOR PLAN

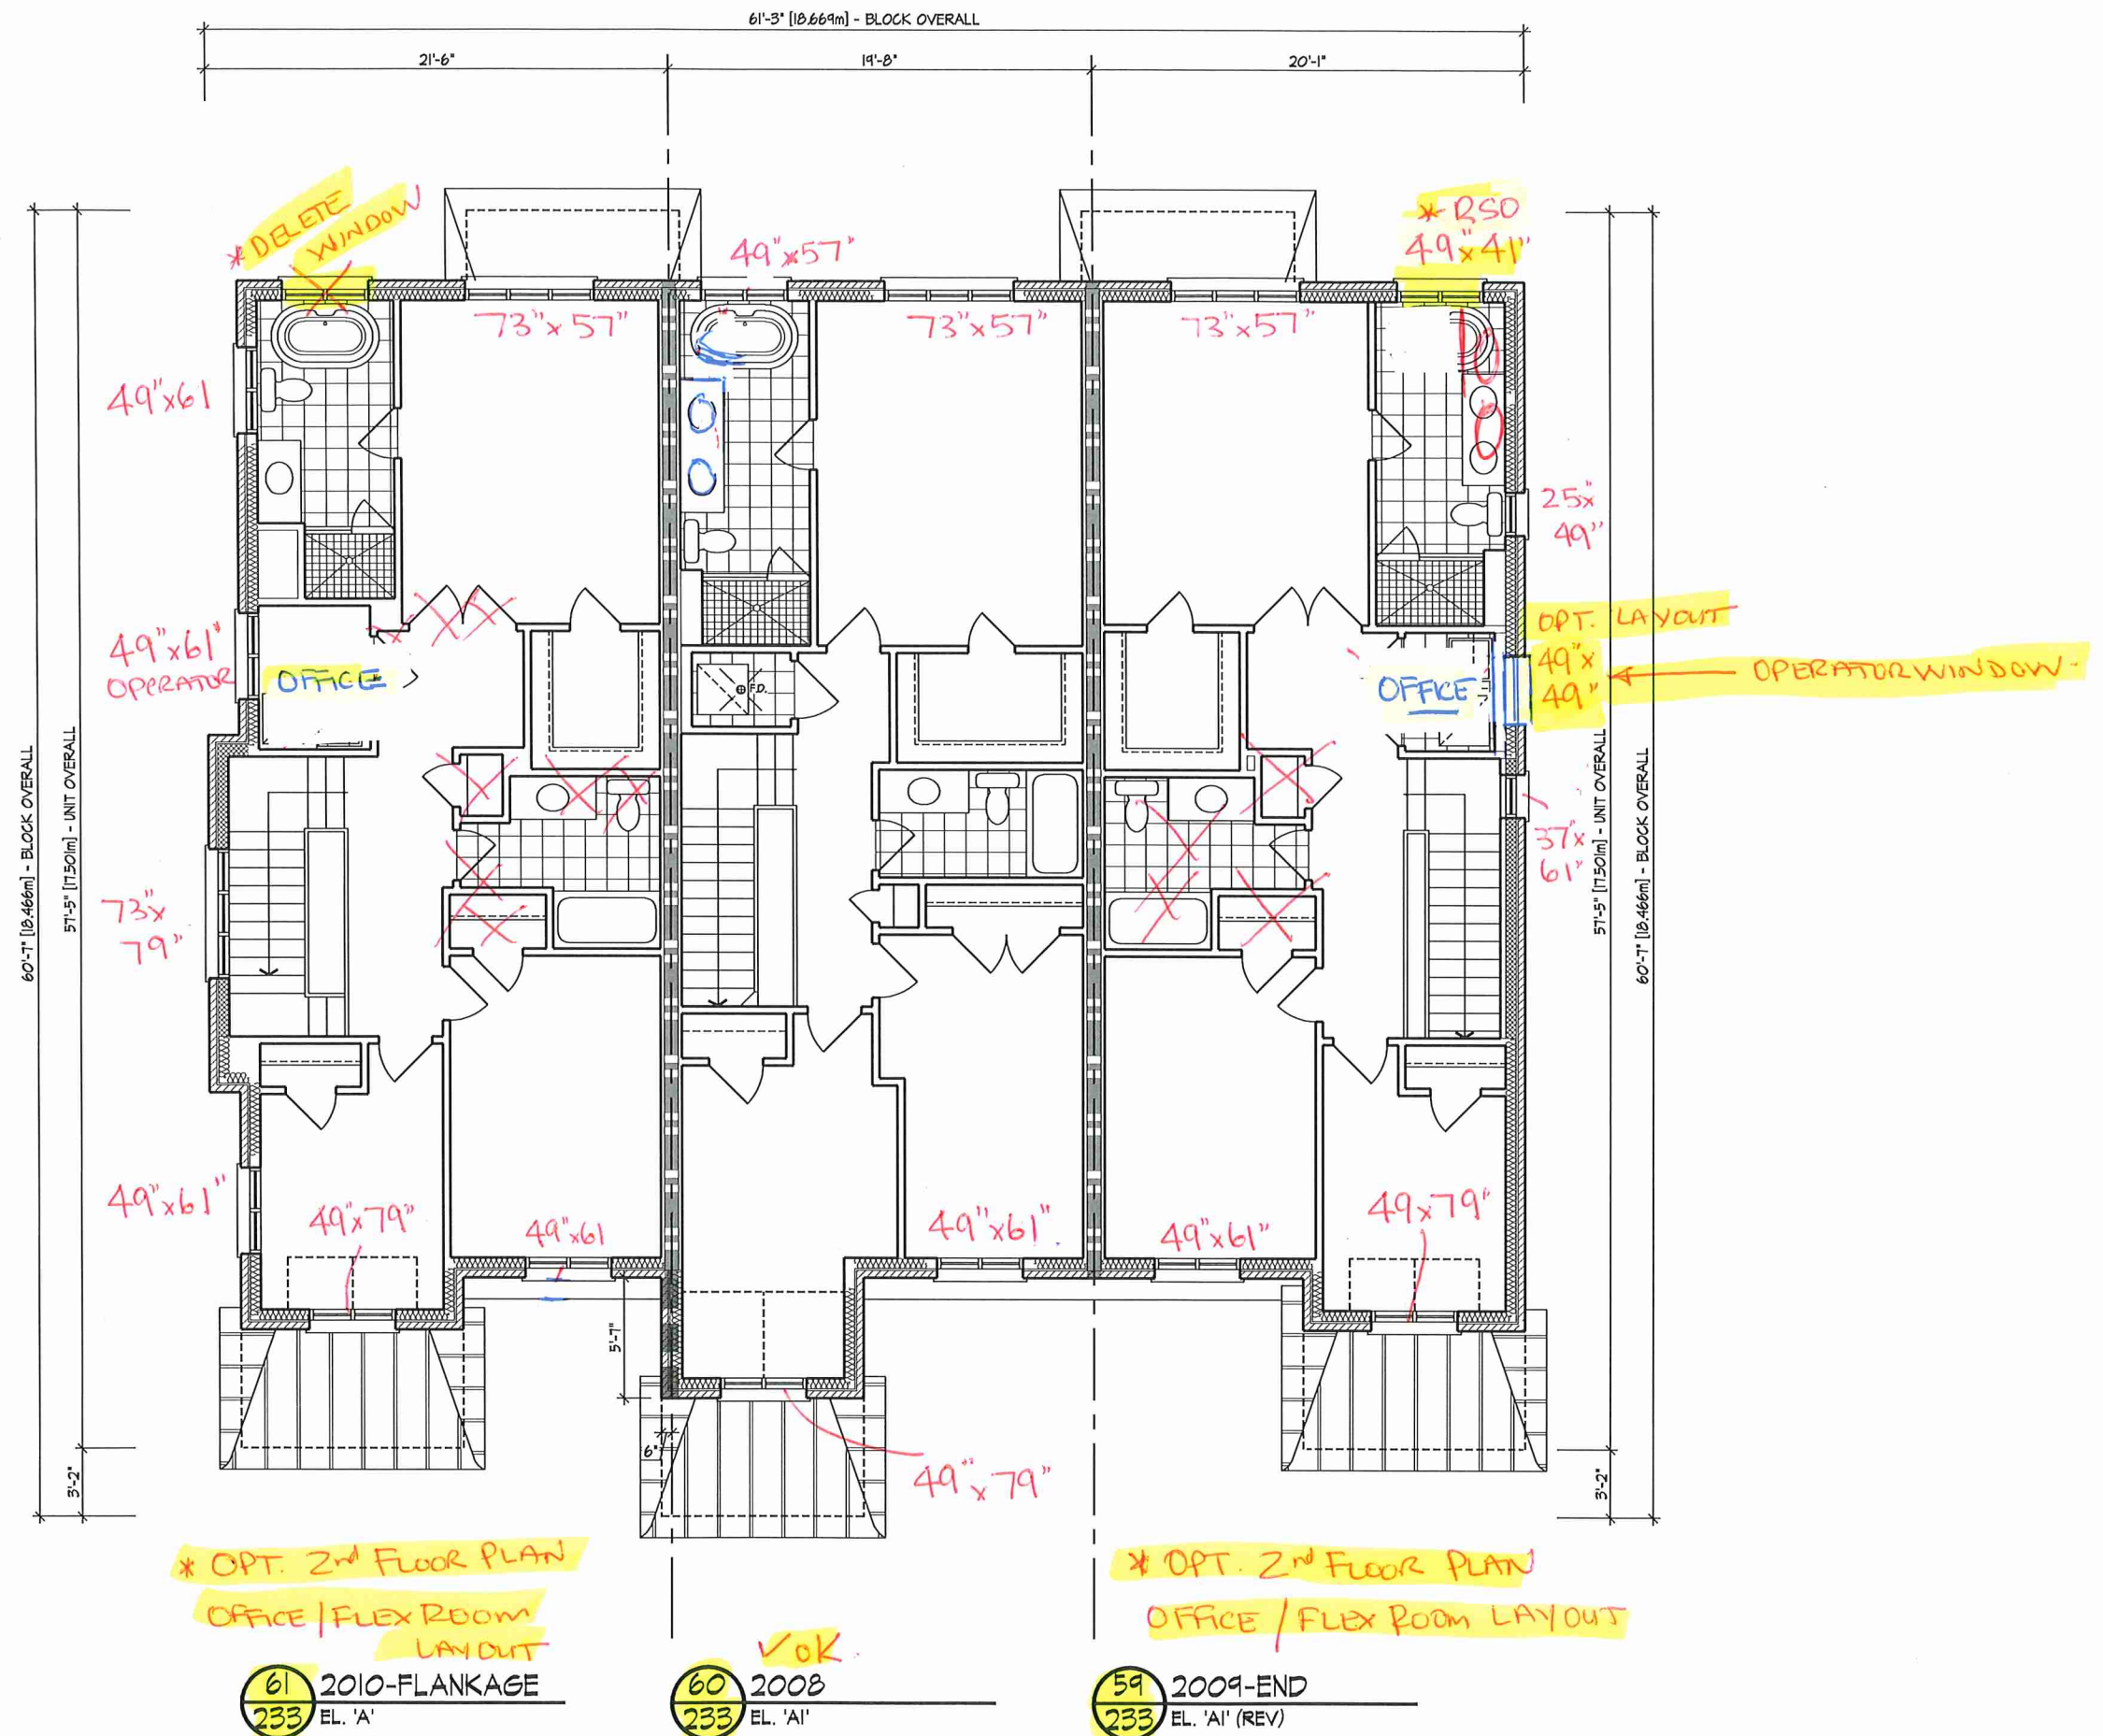

SECOND FLOOR PLAN

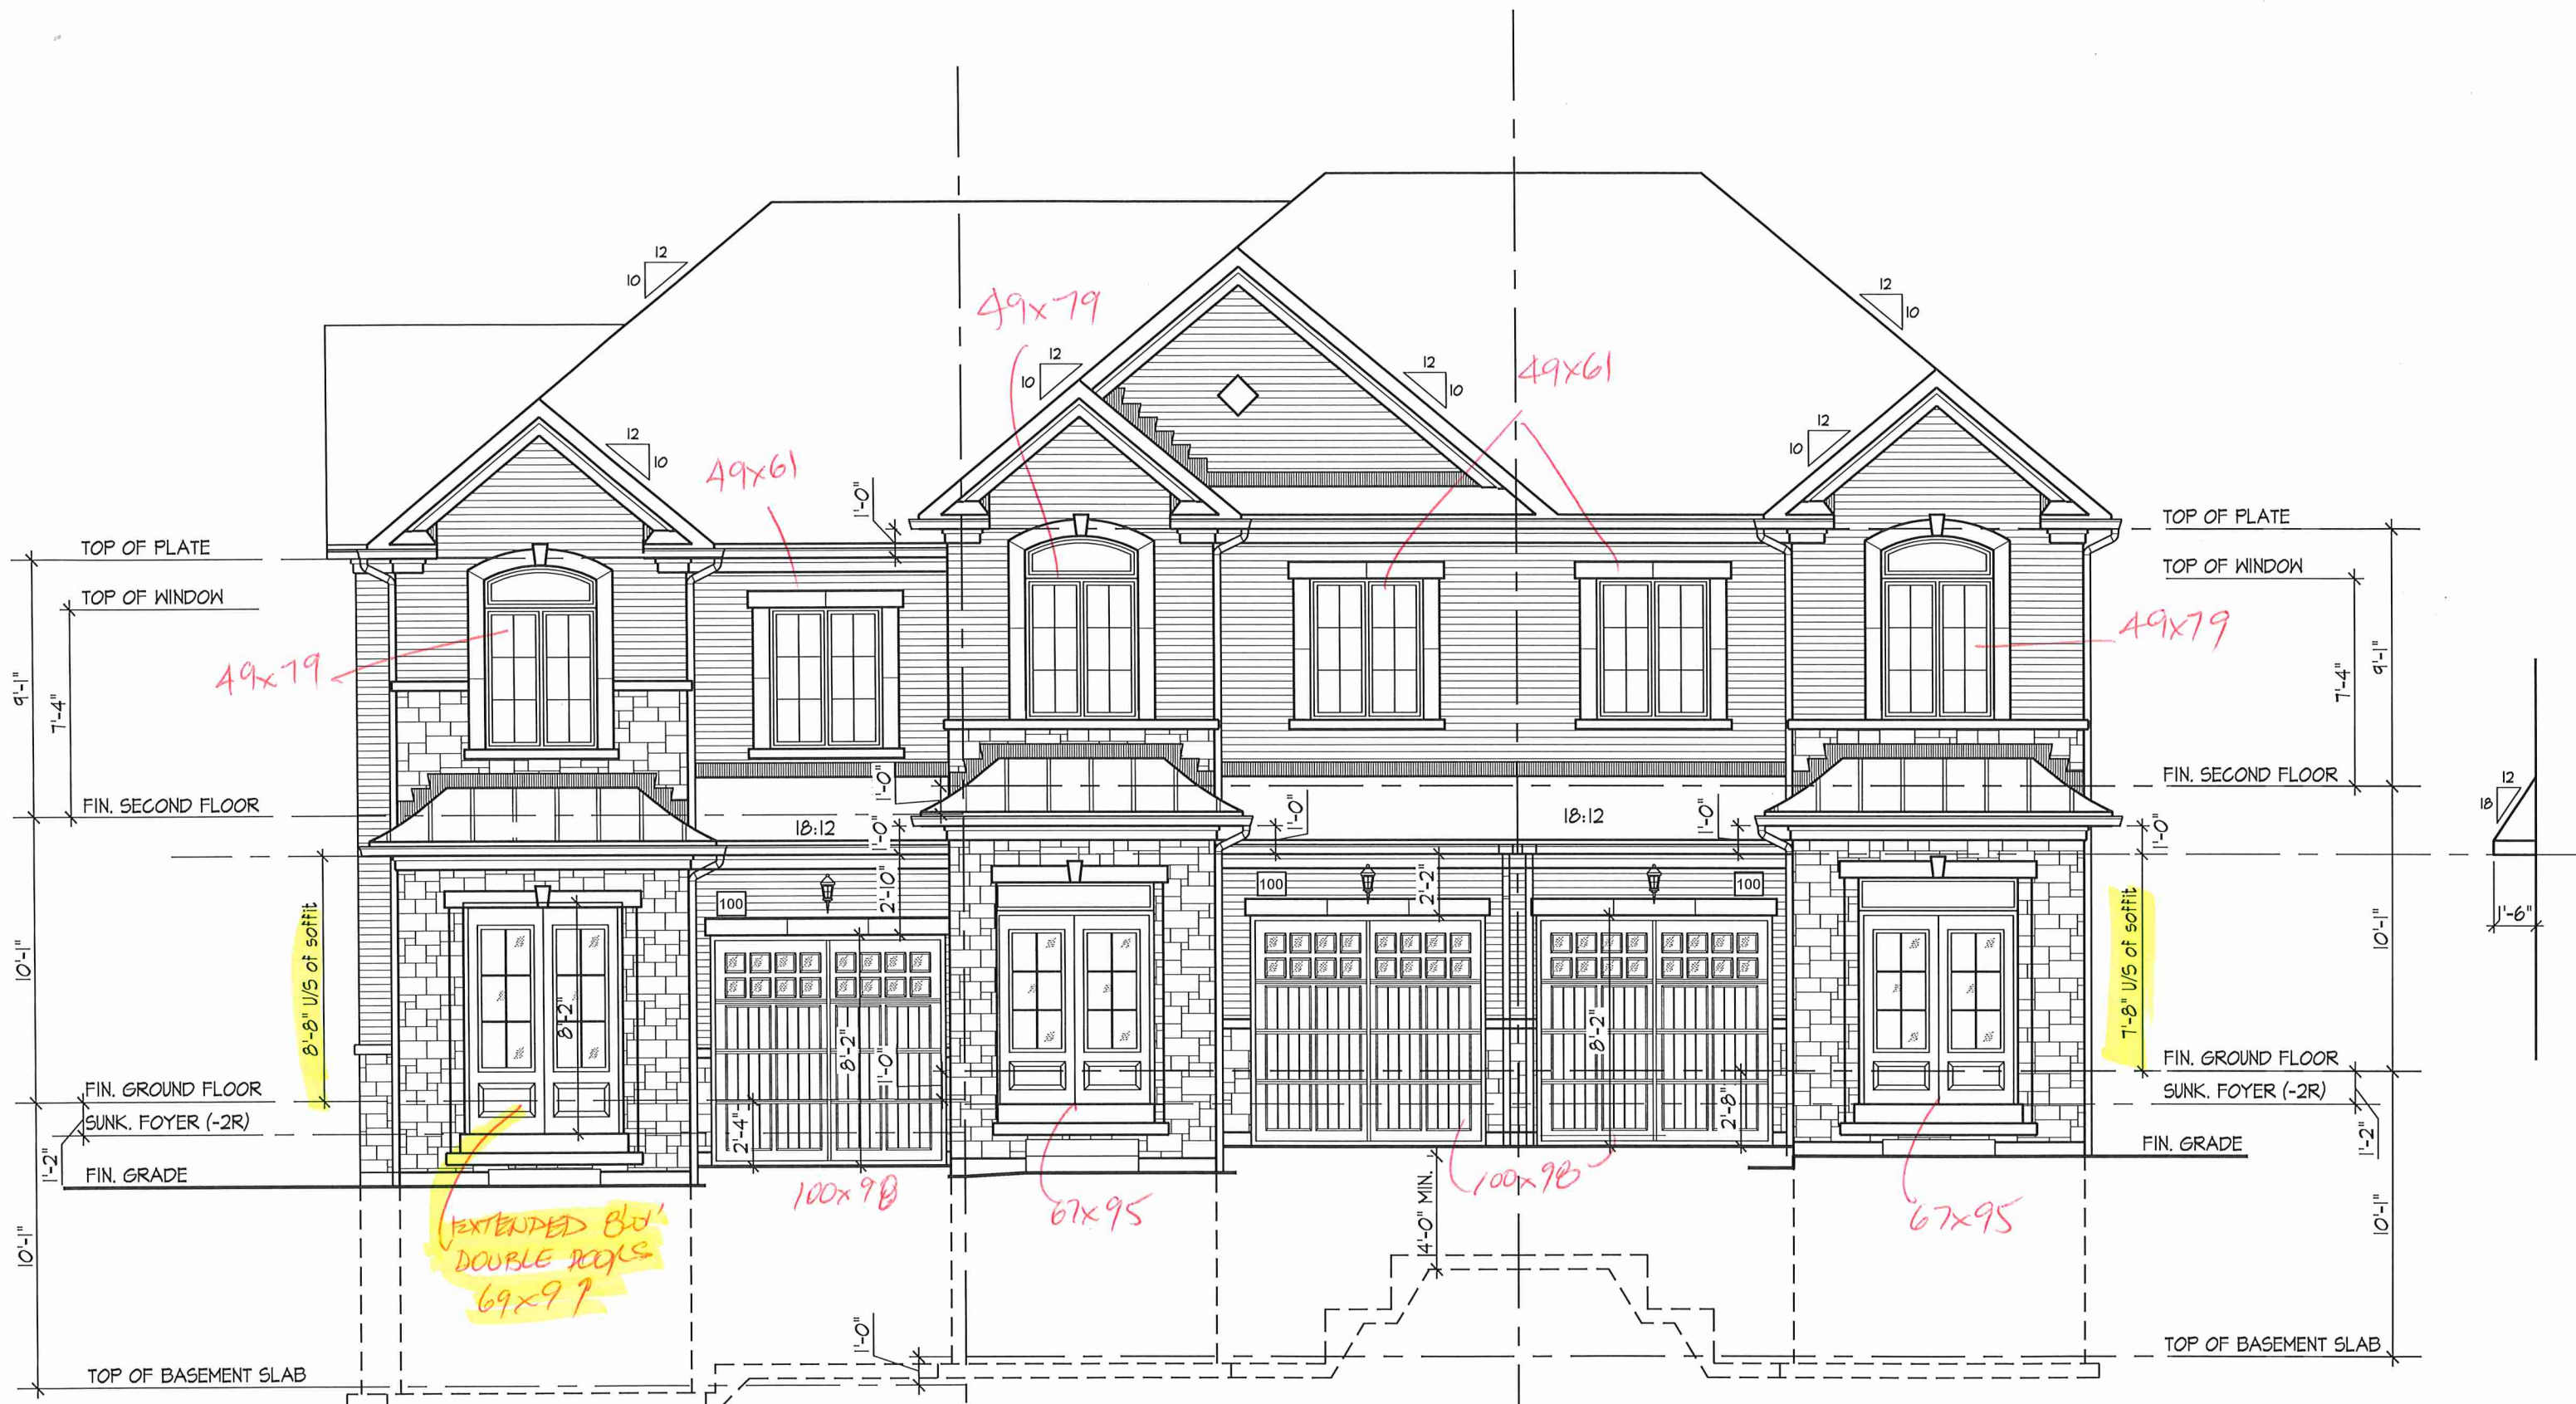

61 2010-FLANKAGE
233 EL. 'A'


60 2008
233 EL. 'A'

59 2009-END
233 EL. 'A' (REV)

FRONT ELEVATION



REAR ELEVATION

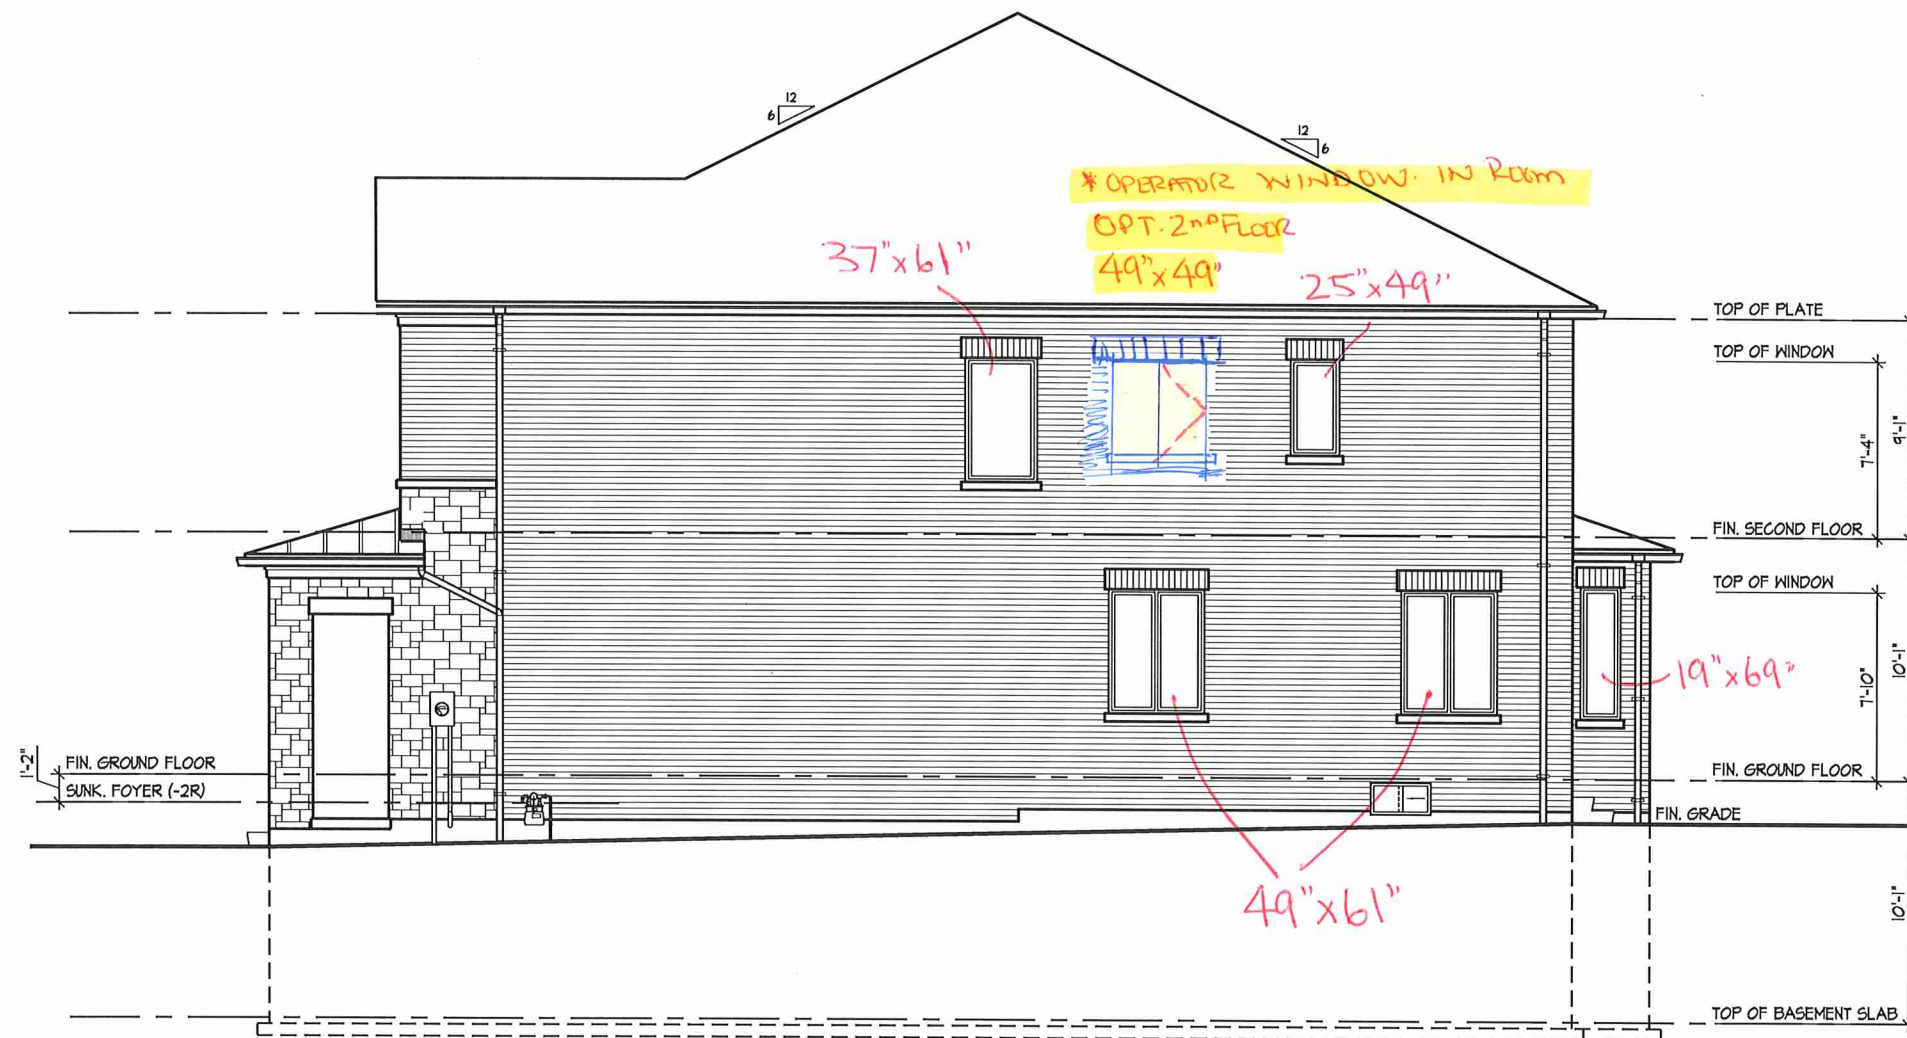


59 2009-END
233 EL. 'A1' (REV)

RIGHT SIDE ELEVATION



61 2010-FLANKAGE
233 EL. 'A'

FLANKAGE ELEVATION

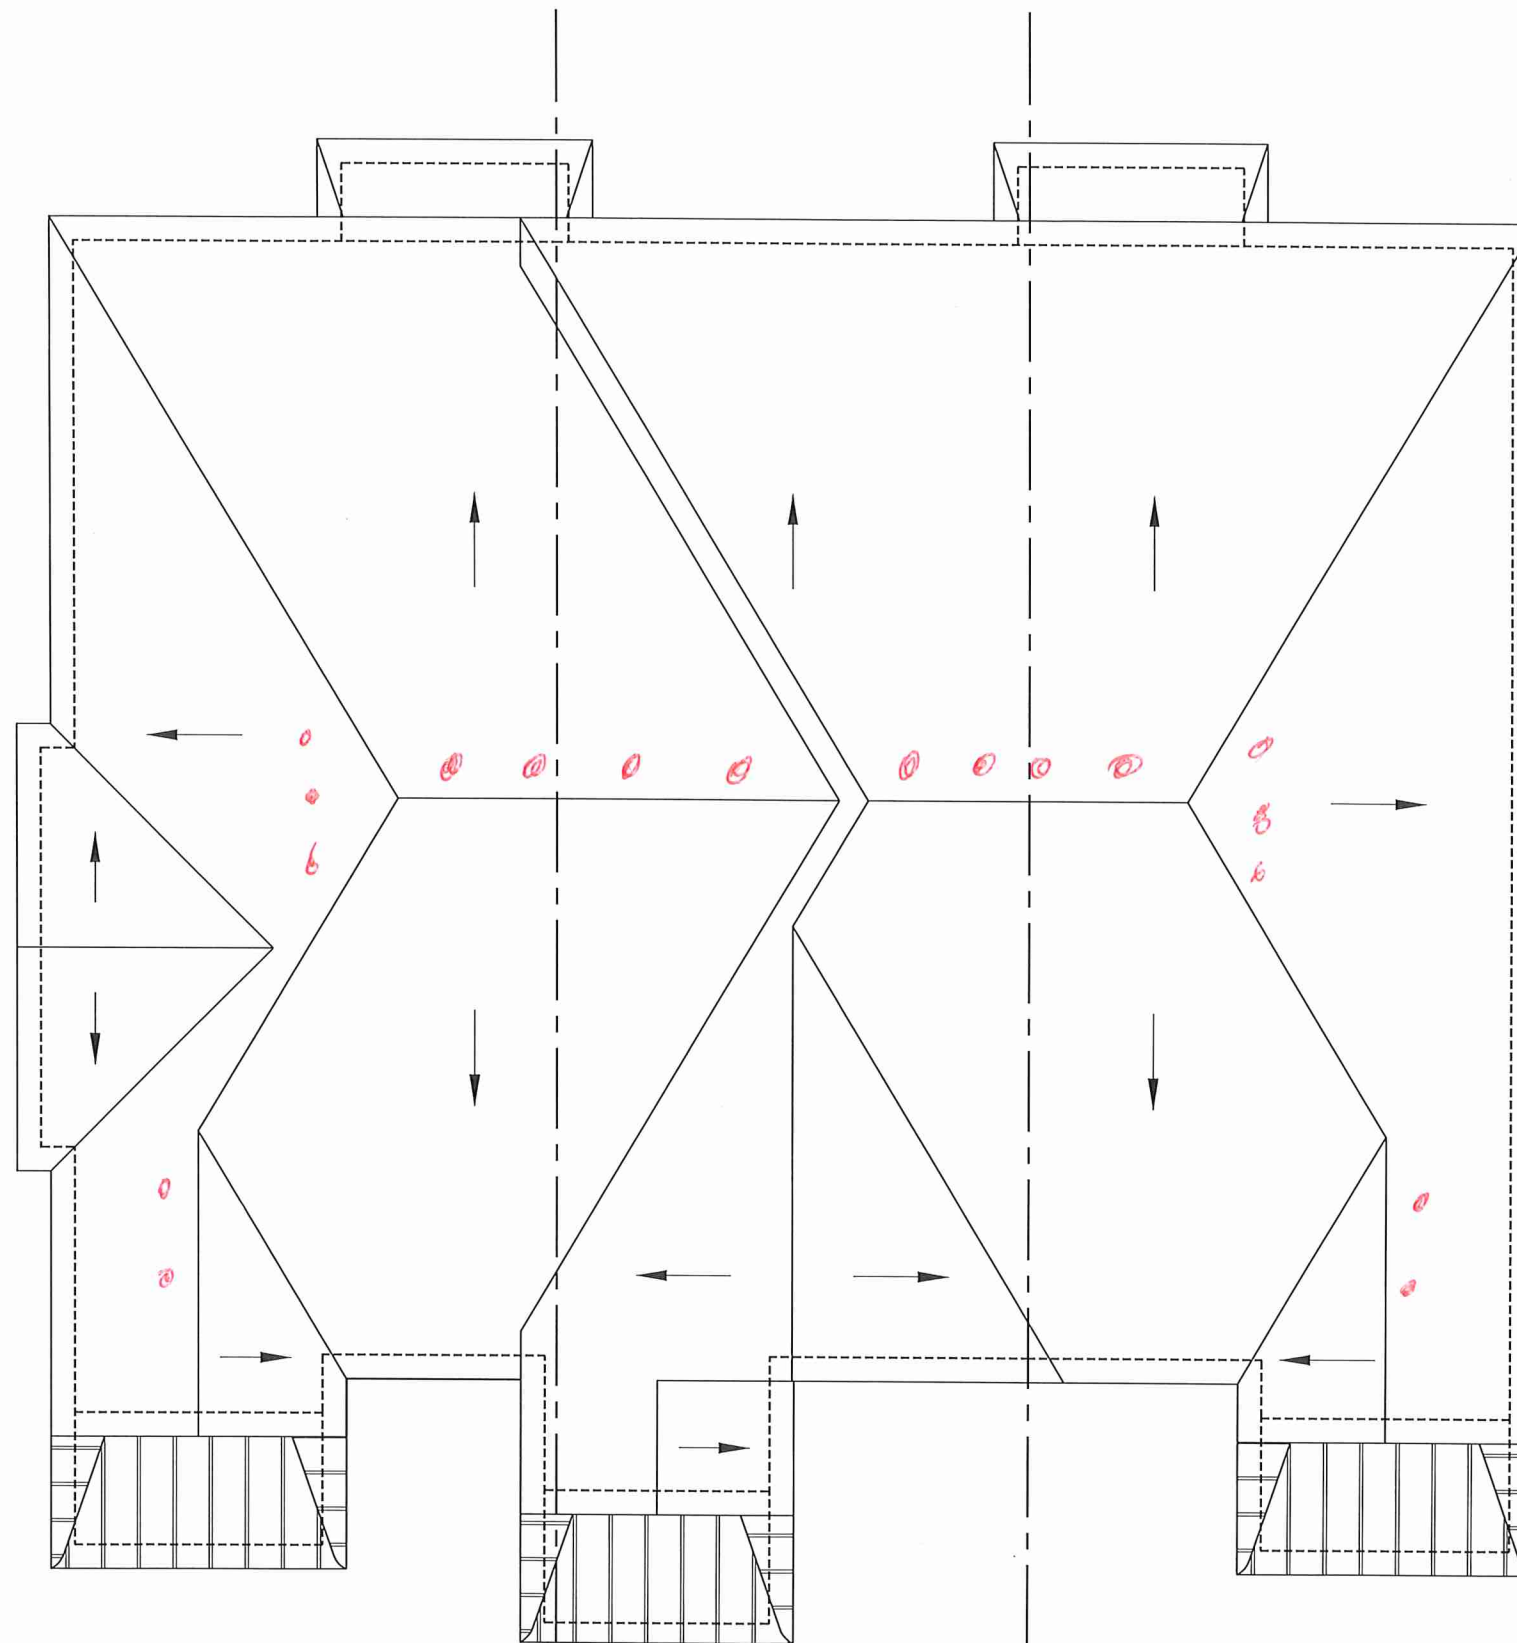

61 2010-FLANKAGE
233 EL. 'A'

60 2008
233 EL. 'A'

59 2009-END
233 EL. 'A' (REV)

ROOF PLAN