


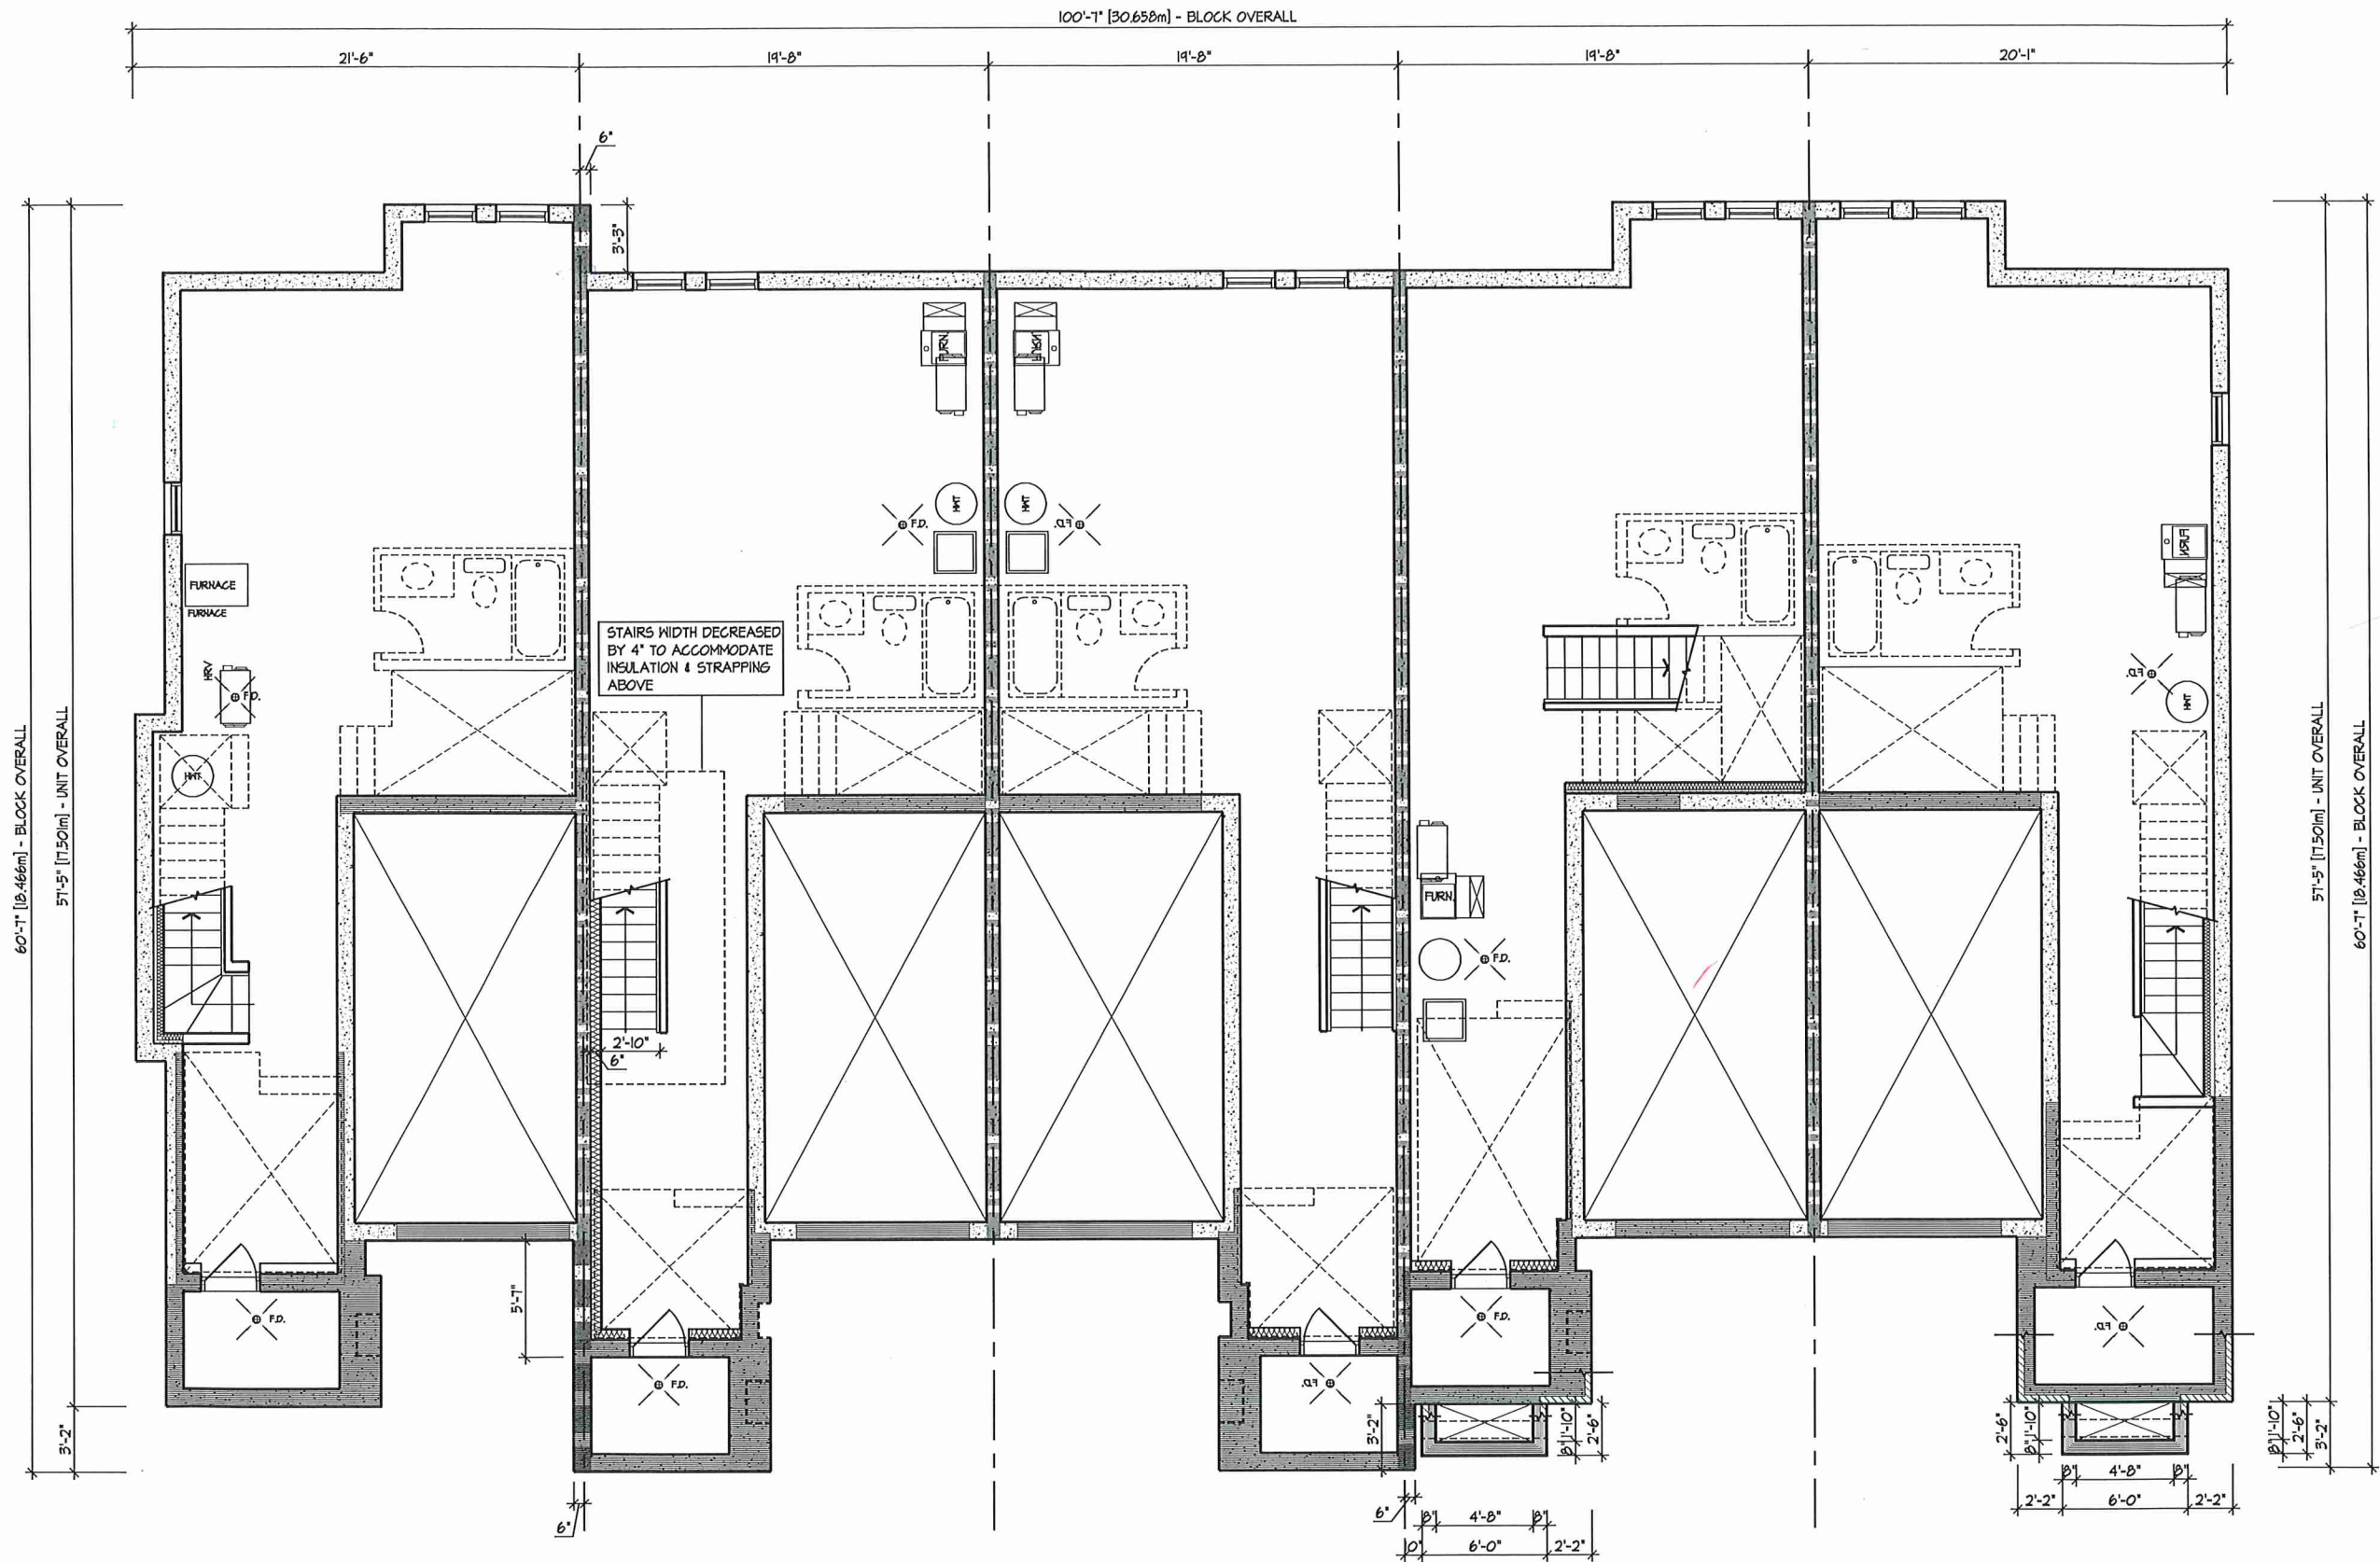

68 2010-FLANKAGE
235 EL. 'A'

69 2008
235 EL. 'A2'

70 2008
235 EL. 'A2' (REV)

71 2007
235 EL. 'A1'


72 2009-END
235 EL. 'A2' (REV)

BASEMENT PLAN

Office Master Bk 235 - Block Plan




FRONT ELEVATION

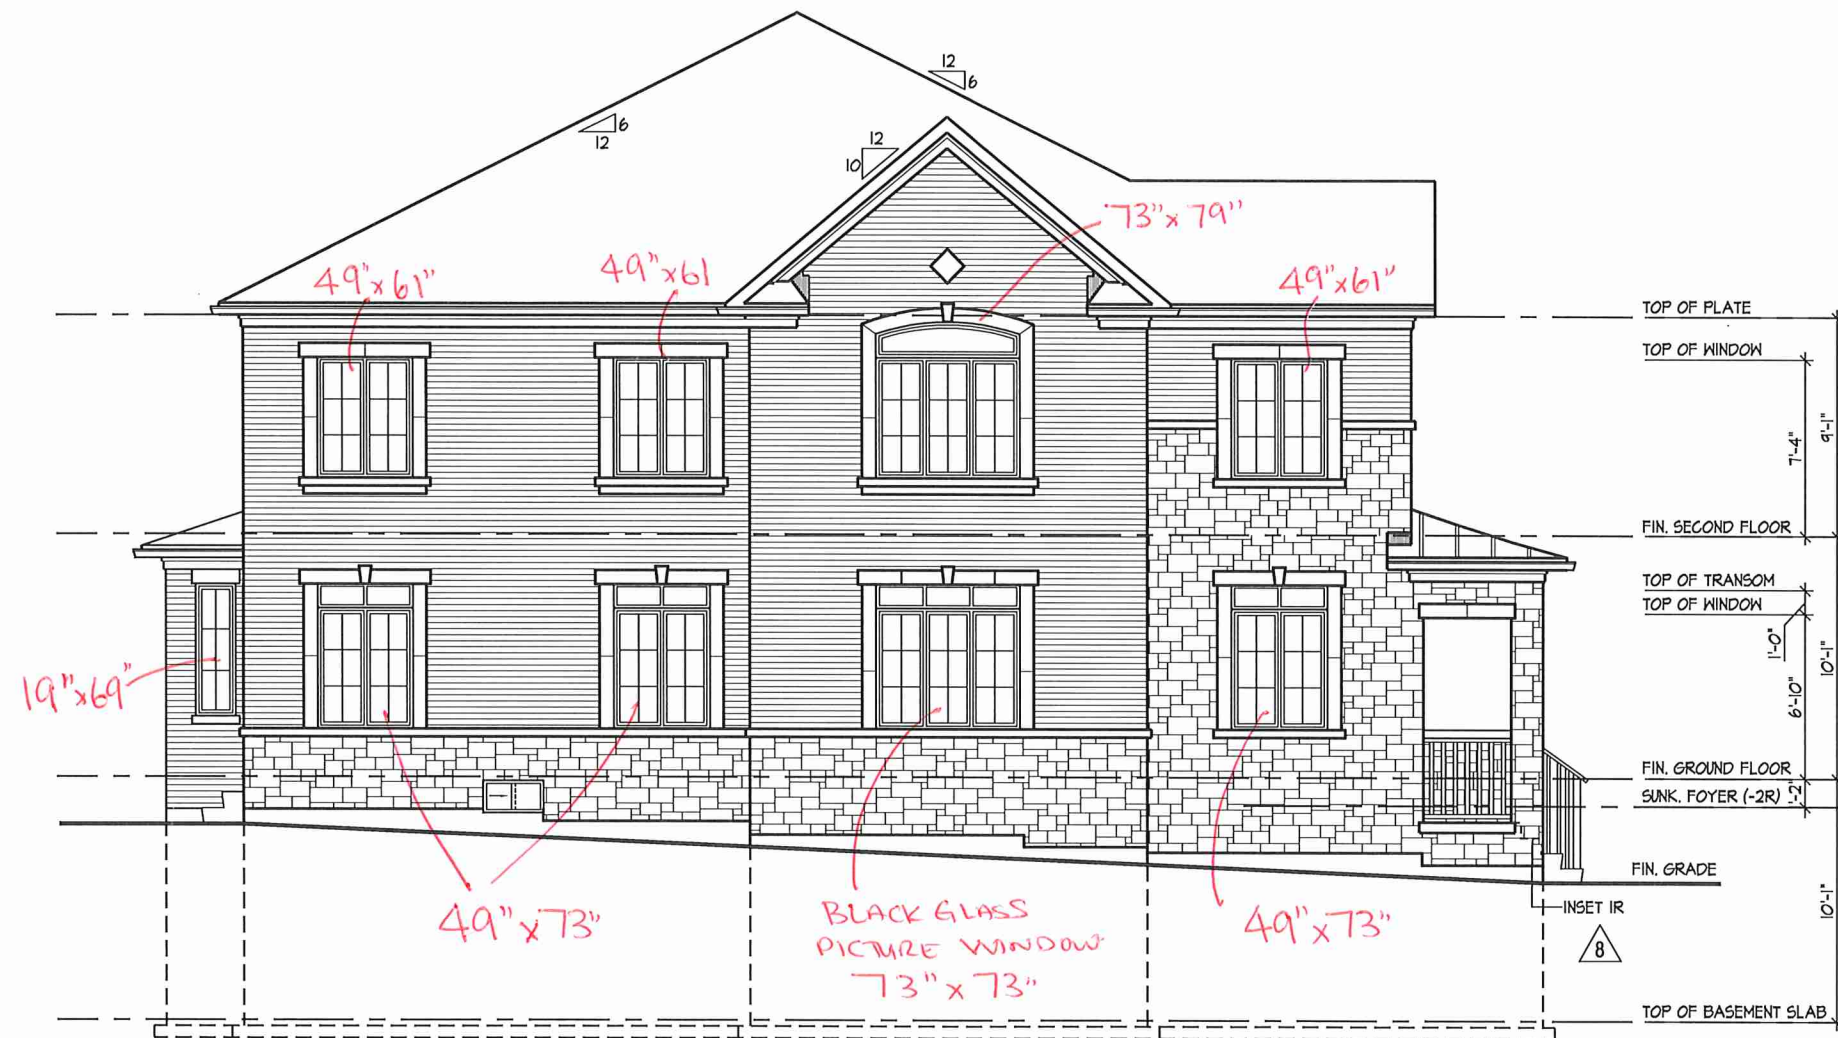

68 2010-FLANKAGE
235 EL. 'A'

FLANKAGE ELEVATION

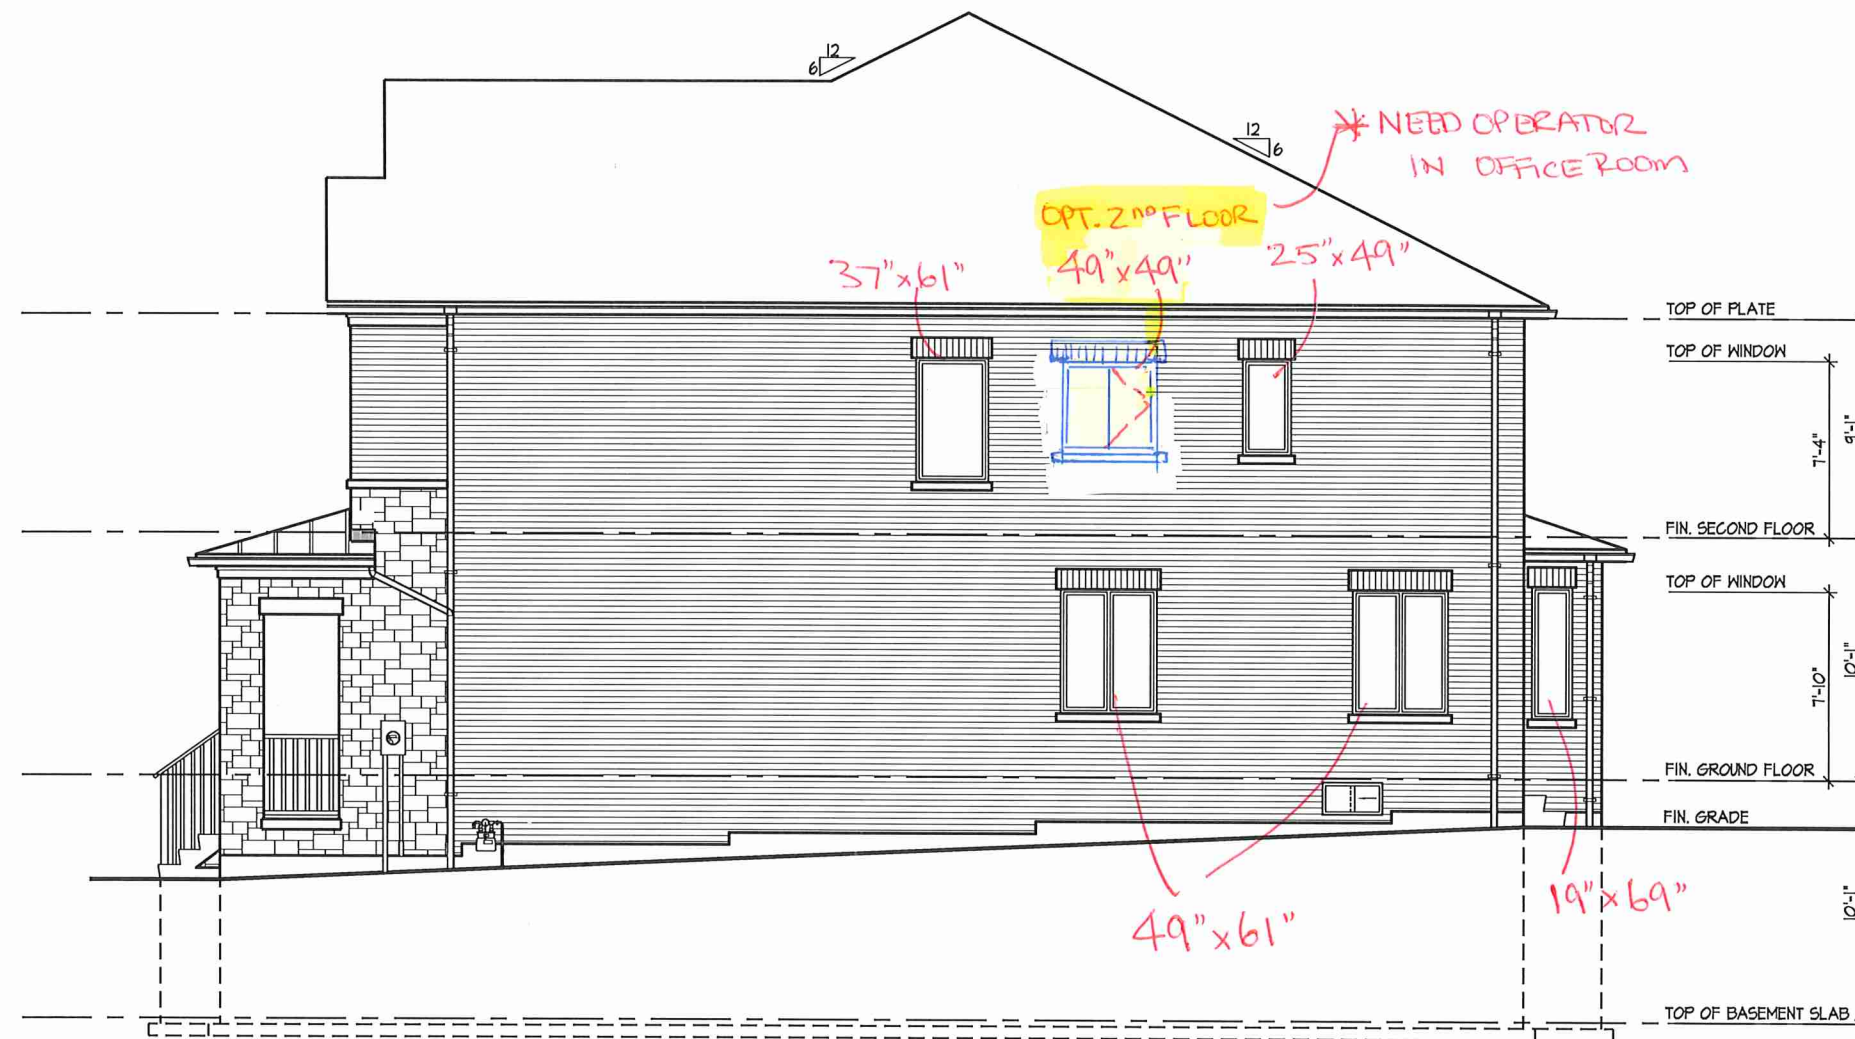


72 2009-END
 235 EL. 'A1' (REV)

RIGHT SIDE ELEVATION



REAR ELEVATION

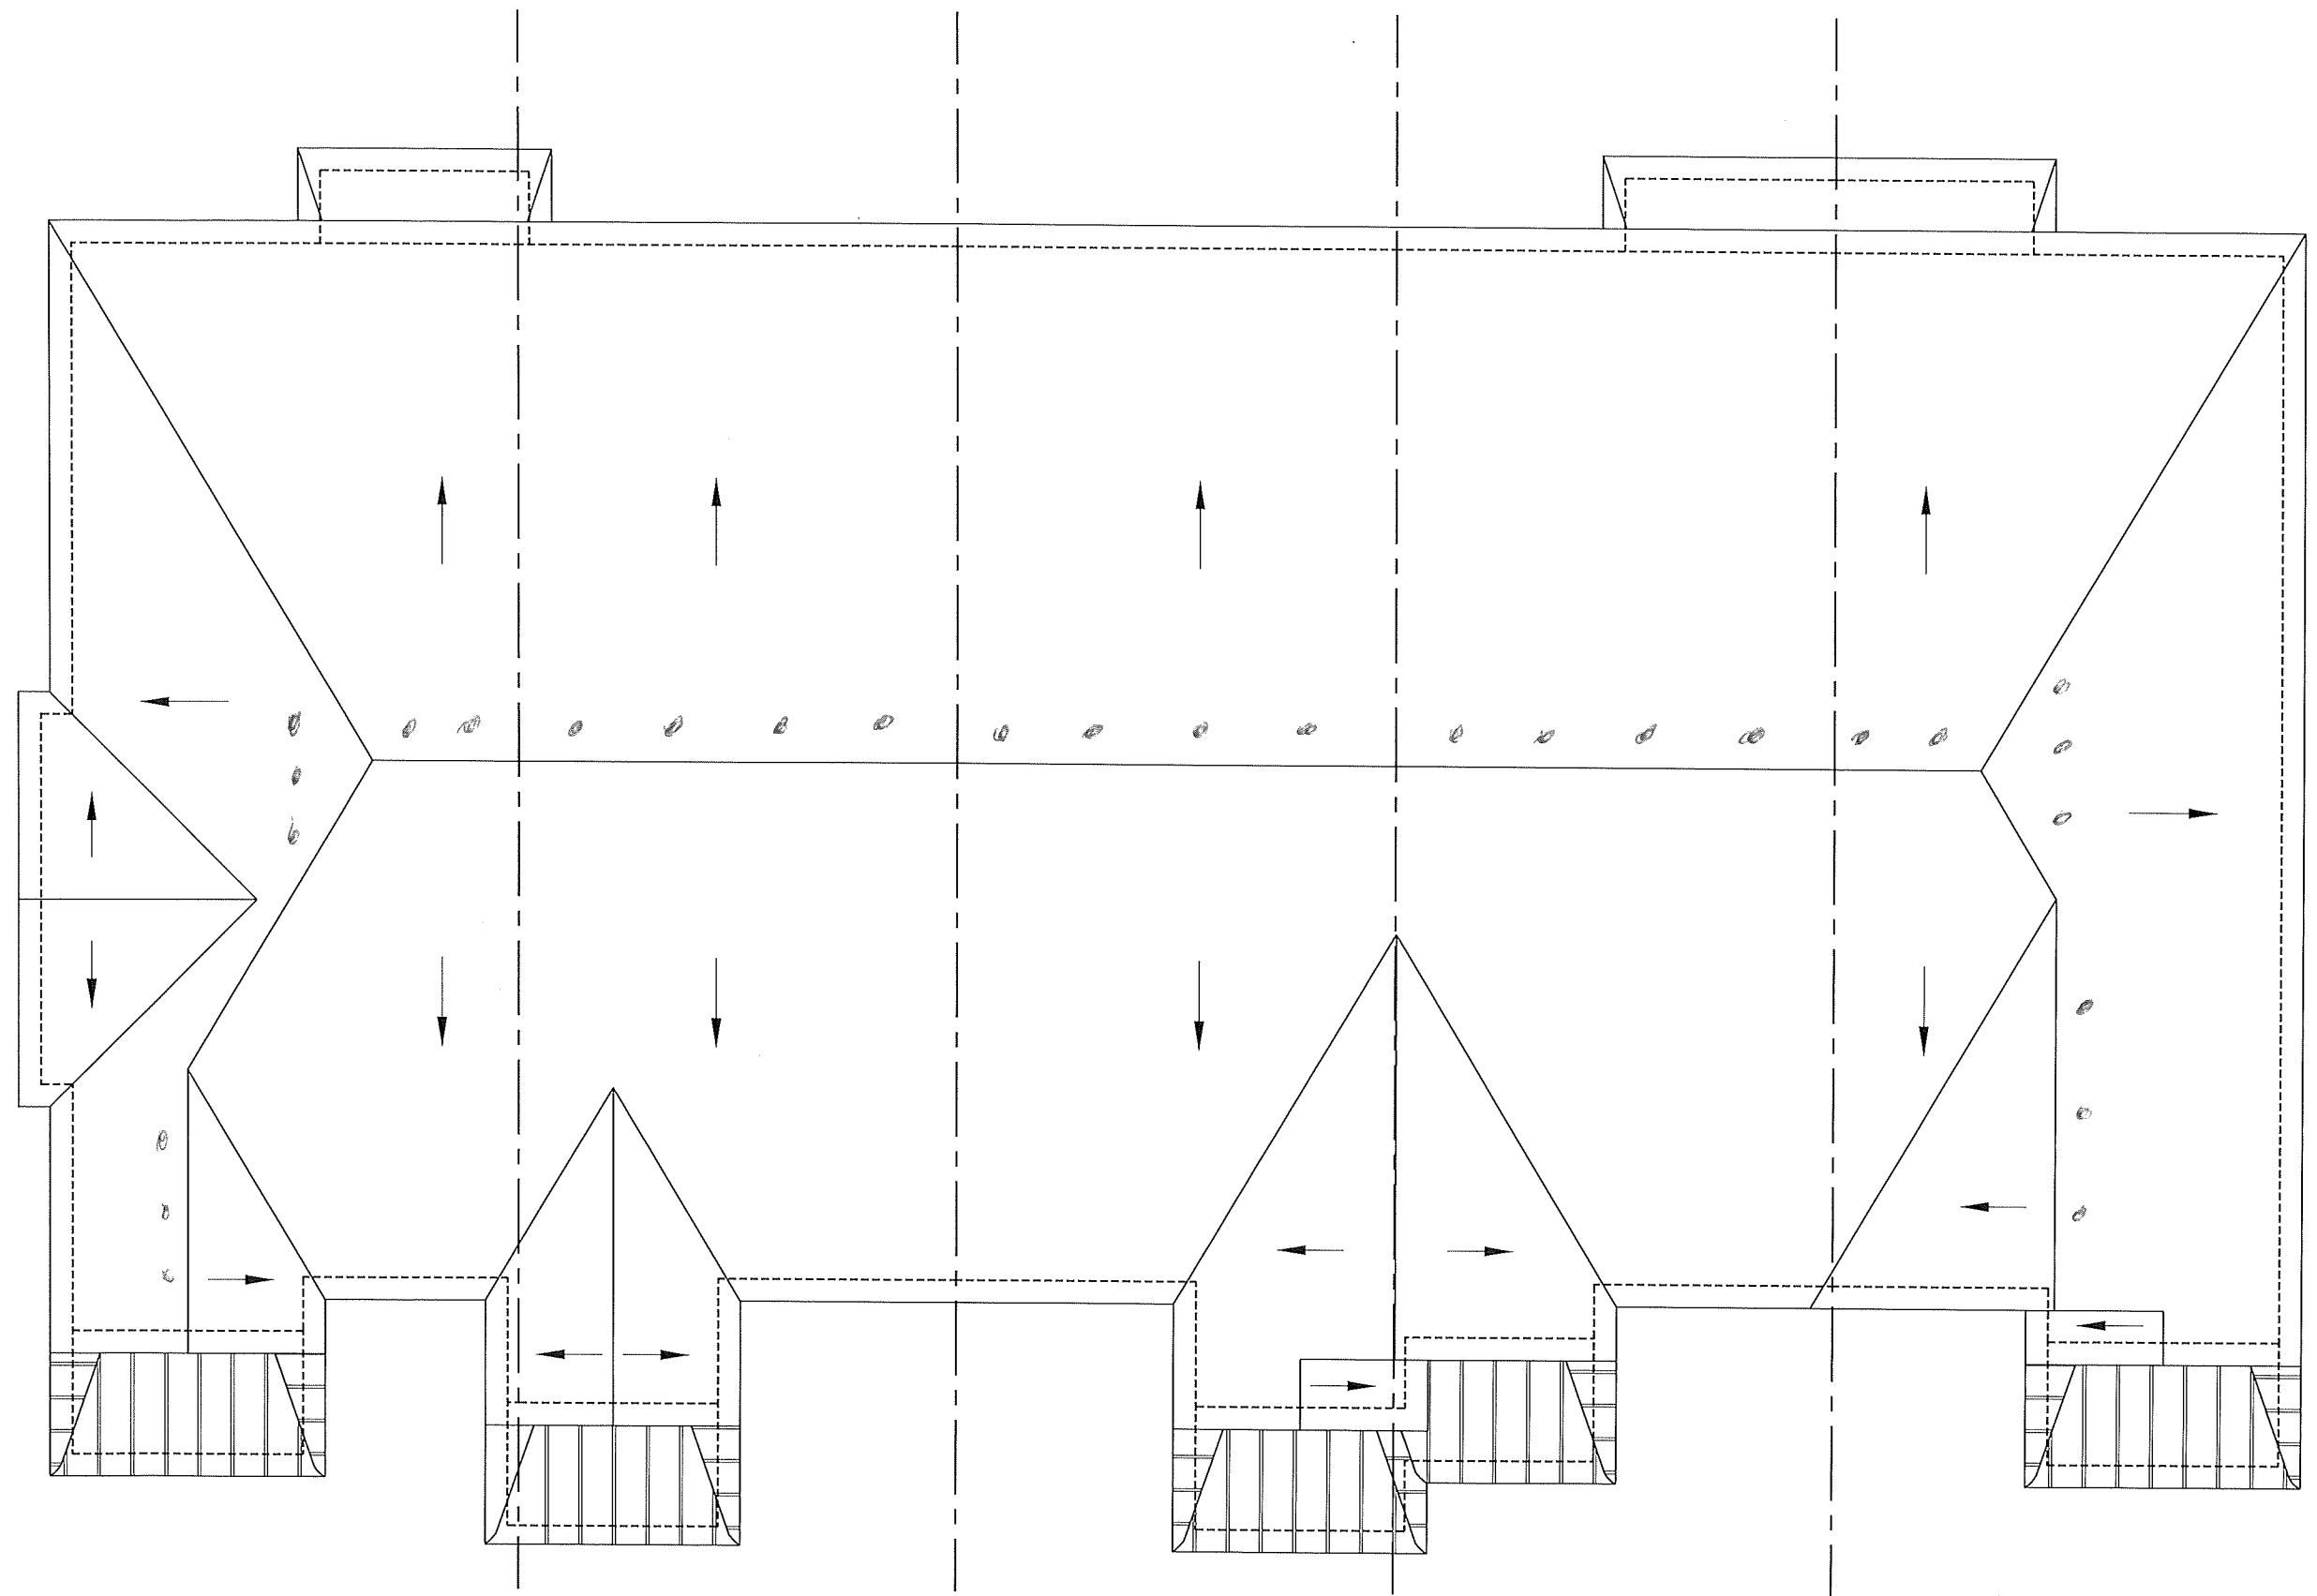

68 2010-FLANKAGE
235 EL. 'A'

69 2008
235 EL. 'A2'

70 2008
235 EL. 'A2' (REV)

71 2007
235 EL. 'A1'

72 2009-END
235 EL. 'A2' (REV)

ROOF PLAN