



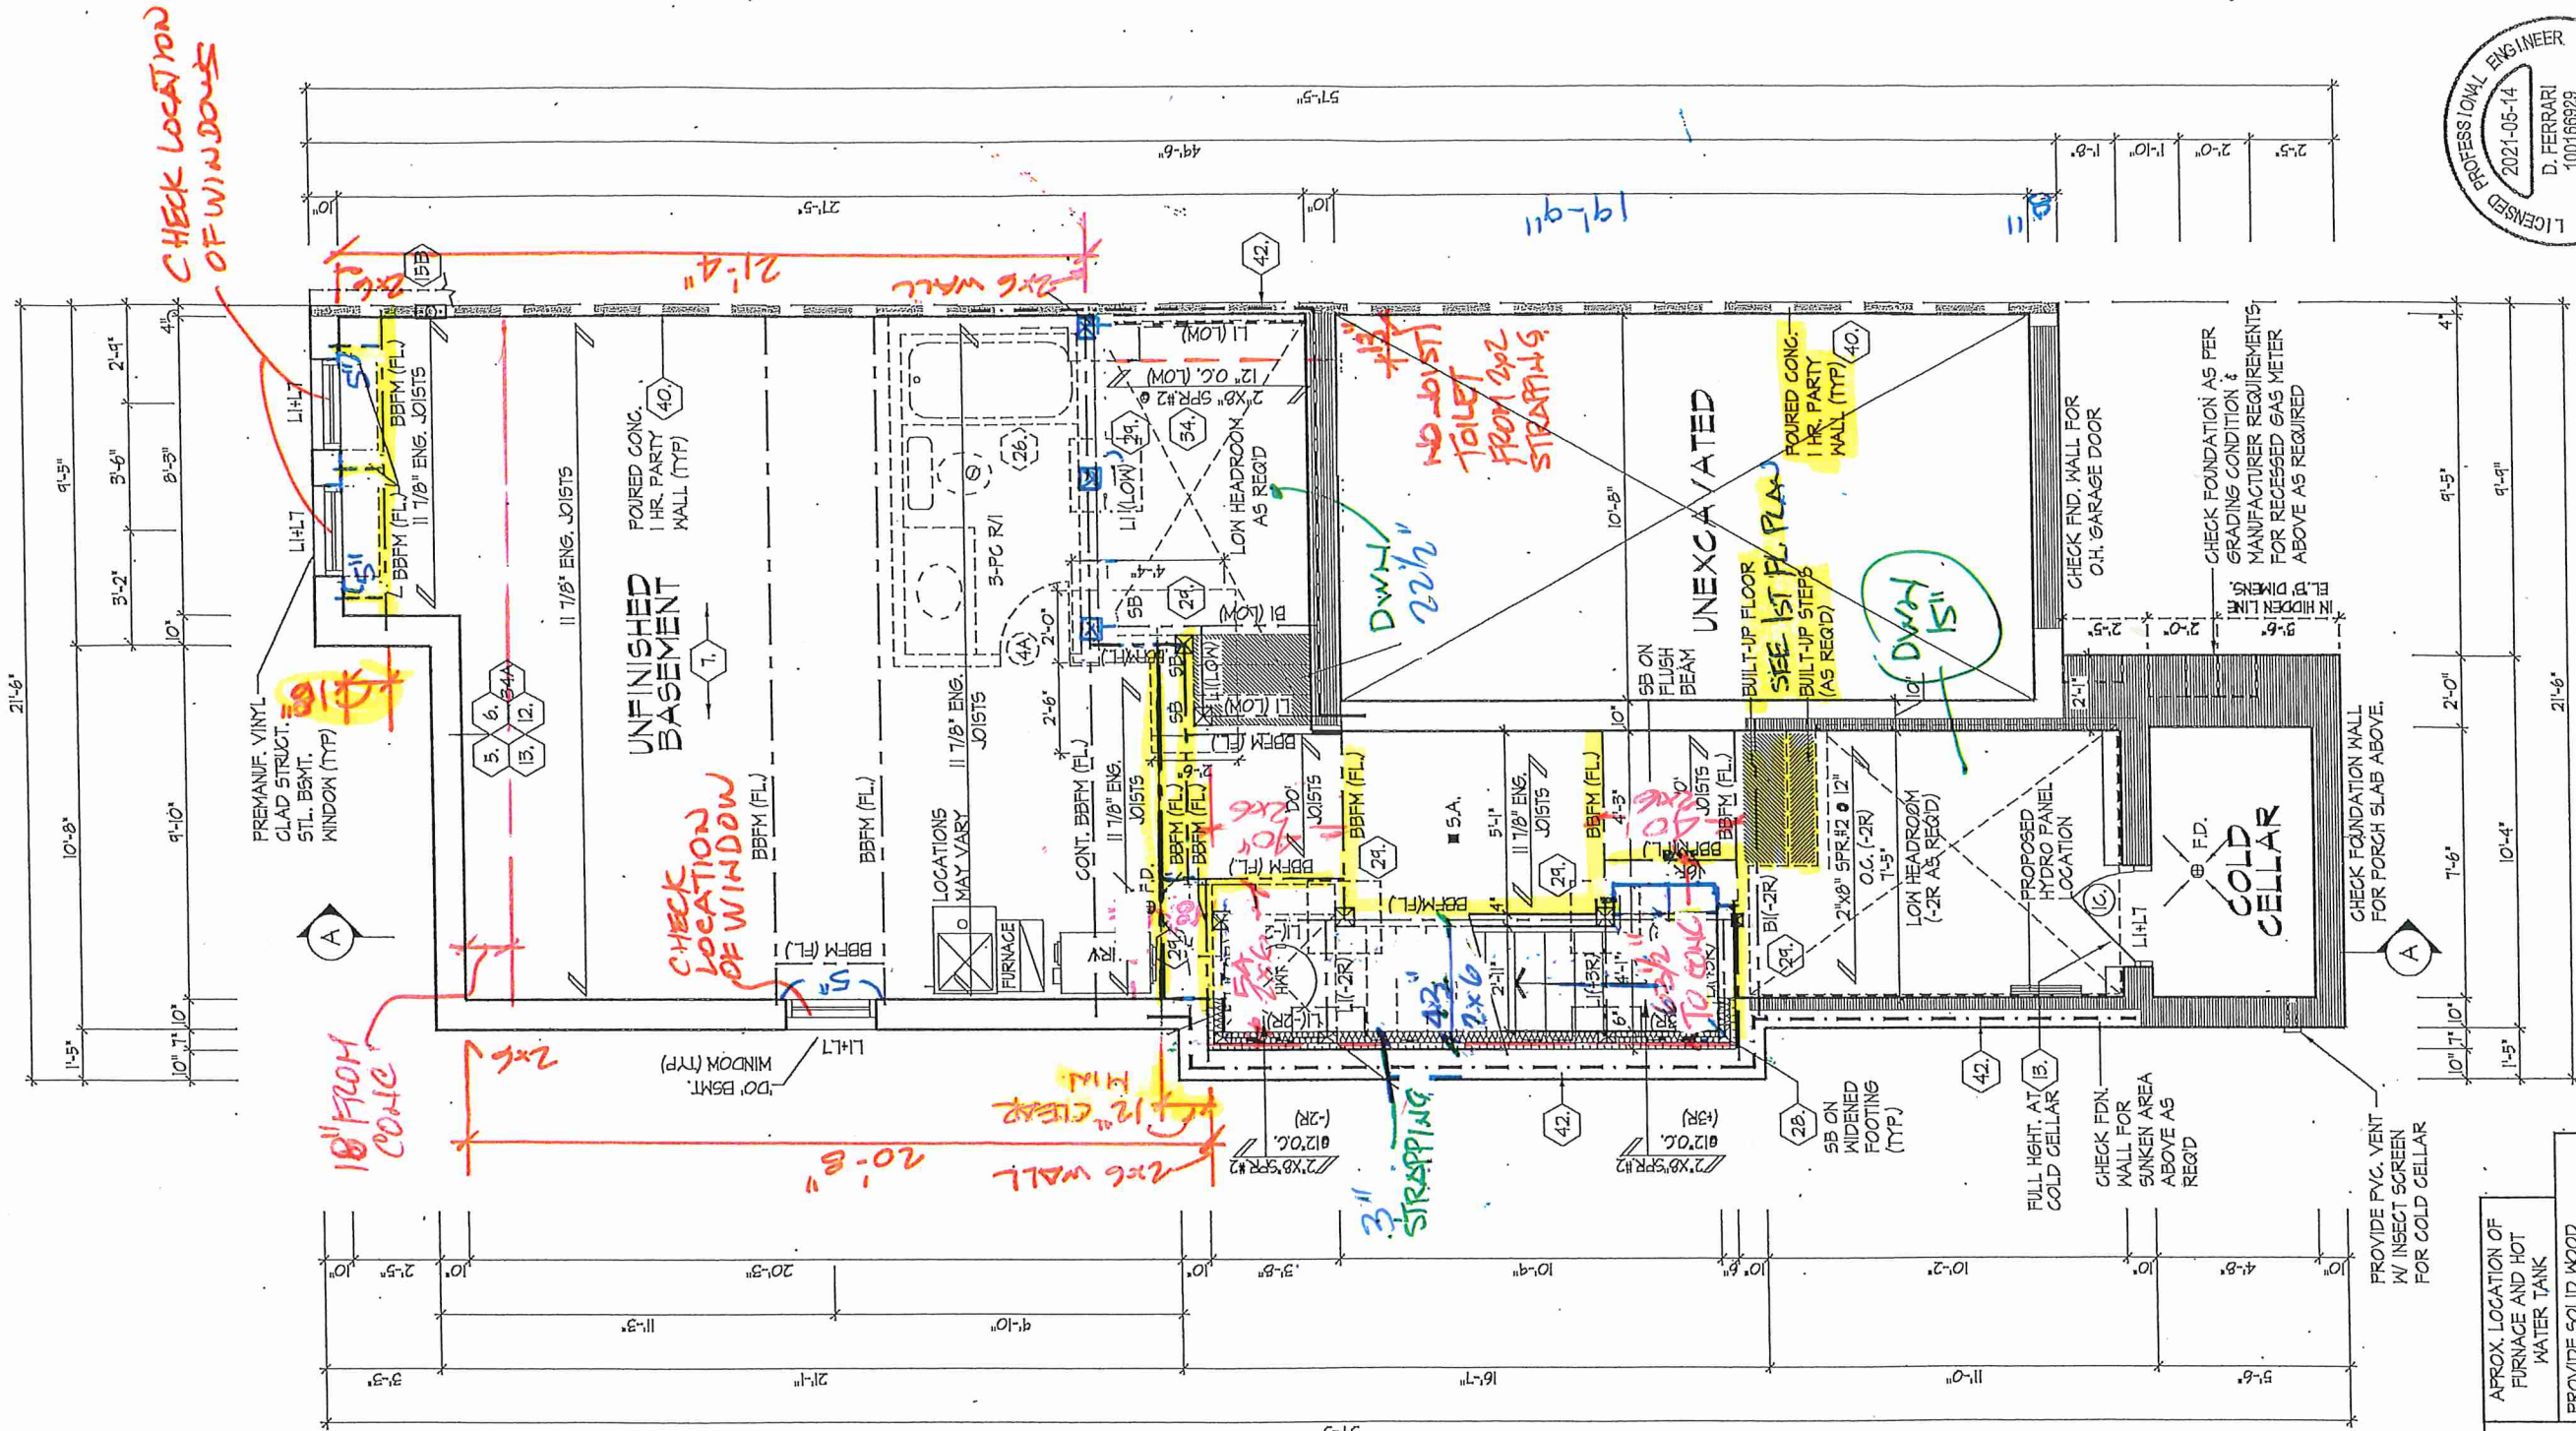

REFER TO FLOOR JOIST MANUFACTURER'S DRAWINGS FOR LAYOUT, SPACING, BLOCKING & STRAPPING REQUIREMENTS, INSTALLATION DETAILS AND HANGER SIZES, & SUBFLOOR THICKNESS	APPROX. LOCATION OF FURNACE AND HOT WATER TANK
PROVIDE SOLID WOOD BLOCKING @ 24" O.C. FOR FIRST JOIST SPAN WHEN PARALLEL W/ EXTERIOR WALL	

BASEMENT PLAN, EL. 'A' & 'B'

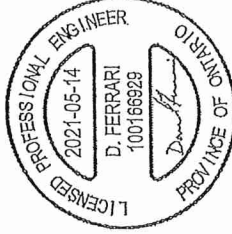

FOR STRUCTURAL ONLY
NOT INCLUDING ENGINEERED
FLOOR OR ROOF SYSTEM

BK 235-68 - PORTAL

UNIT 2010
REV. 2021.05.11

ROYAL PINE HOMES - 216102
'CENTREFIELD', WEST GORMLEY, RICHMOND HILL, ON.

HUNT
DESIGN ASSOCIATES INC.
www.hunt-design.ca

Drawn By VM Checked By DS Scale 3/16"=1'-0" File Number 216102WT2010 Page Number 2 of 17


UNDESIGNED HAS REVIEWED AND TAKES RESPONSIBILITY FOR THIS DESIGN AND HAS QUALIFICATIONS AND MEETS THE REQUIREMENTS SET OUT IN THE ONTARIO BUILDING ACT TO BE A DESIGNER. Licensure Information: 37308 BGN 1995

DOORS 8'3 1/2"
WINDOWST = 9'6"
SLIDING DOOR = 9'5"
ARCHES 9'5"

4" STRAPPING
50"
43 1/2"
38 1/2"
LANDING
DOWN 15 1/4"



73x73 BLACK GLASS WINDOW

2-11'6" LVL 1" x 6" x 10'0" @ 16" O.C. FILL

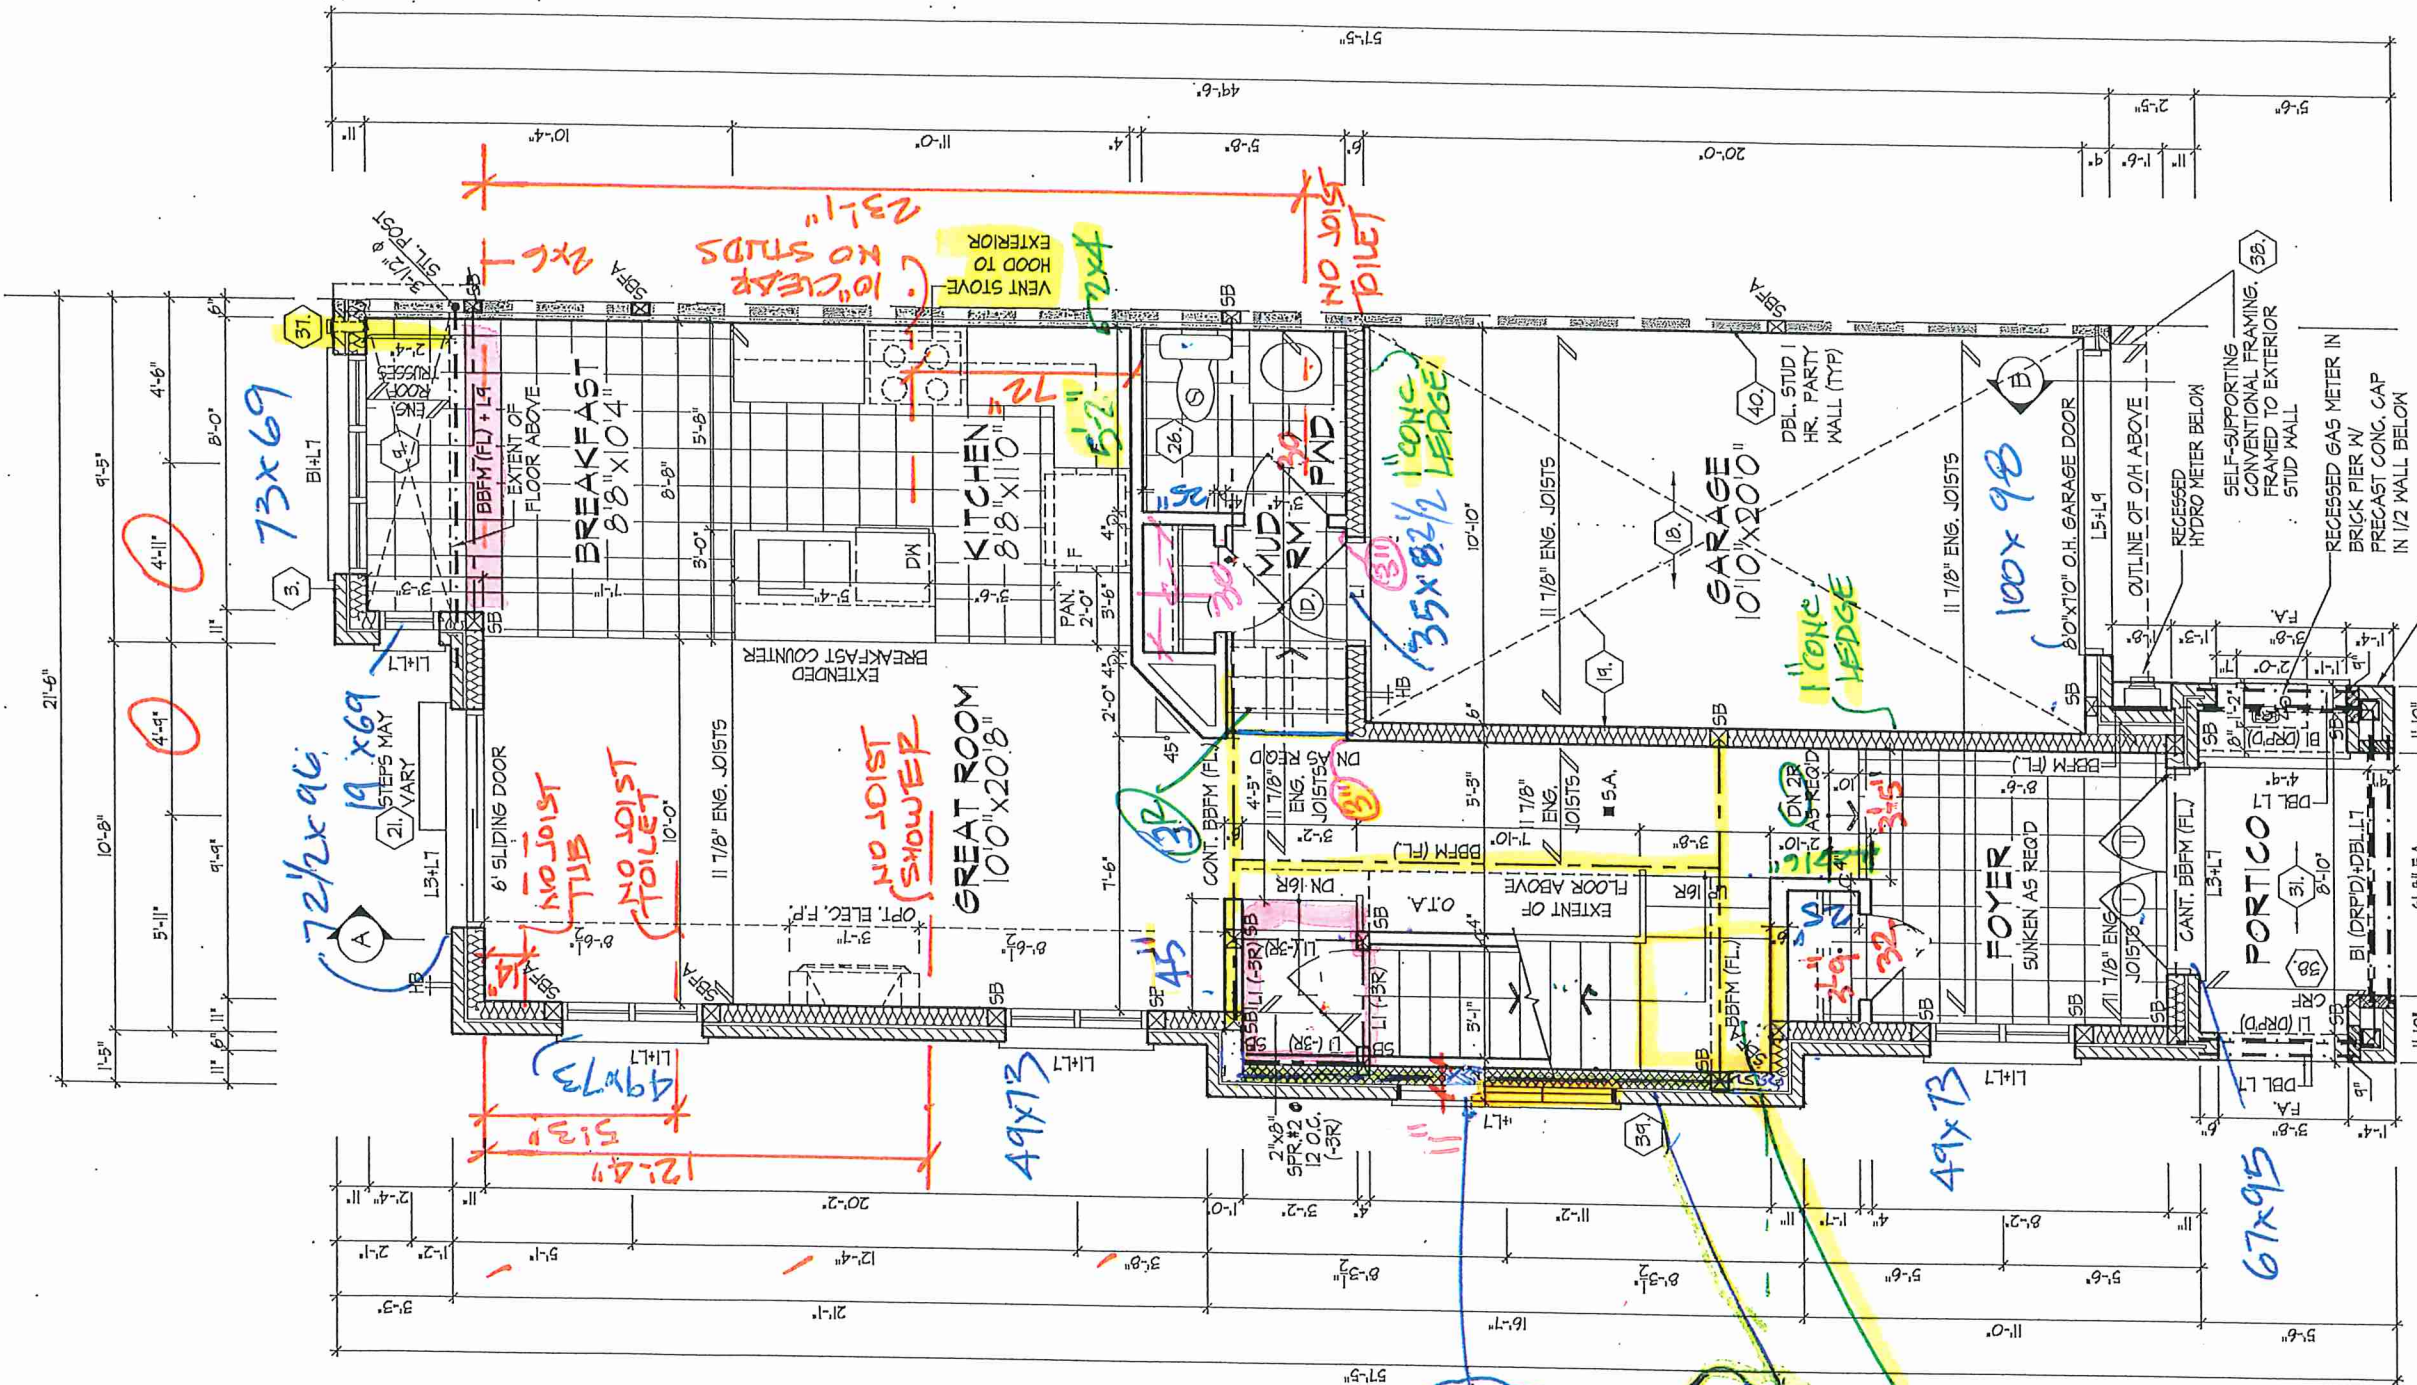

MASONRY WALL	SOLID MASONRY WALL W/ 10'-10M VERT. REBARS (LAP 1'-6") GROUTED INTO BRICK JOINT
	2"x6" SILL PLATE TOP ANCHORED TO SOLID MASONRY WALL W/ 12"x6 x 12" BOLTS @ 24" O.C. STAGGERED
	MASONRY VENEER TIED TO MASONRY VENEER WITH GALV. METAL TIES @ 16" O.C. AND 24" VERTICAL FILL VOID BETWEEN MASONRY VENEER MYTHES SOLID W/ MORTAR

- * 2"x4" STUD WALL ASSEMBLY EXCEEDING MAX. UNSUPPORTED HEIGHT FOR WALLS GREATER THAN 4'-10" TO MAX. 12'-0" HIGH, - NO FLOOR LOAD, DOUBLE UP EVERY STUD @ 16" O.C. - NO FLOOR LOAD DOUBLE UP EVERY STUD @ 12" O.C. PROVIDE BLOCKING EVERY 4'-0" O.C. VERTICAL.
- REFER TO FLOOR JOIST MANUFACTURER'S DRAWINGS FOR LAYOUT, SPACING, BLOCKING & STRAPPING REQUIREMENTS, INSTALLATION DETAILS AND HANGER SIZES, & SUBFLOOR THICKNESS
- ALL DOORS ON PLAN ARE 7'-10" HIGH TOP OF FRAME UNLESS LABELED OTHERWISE.
- PROVIDE SOLID WOOD BLOCKING @ 24" O.C. FOR FIRST JOIST SPAN WHEN PARALLEL W/ EXTERIOR WALL

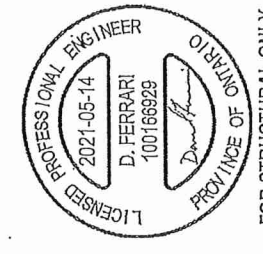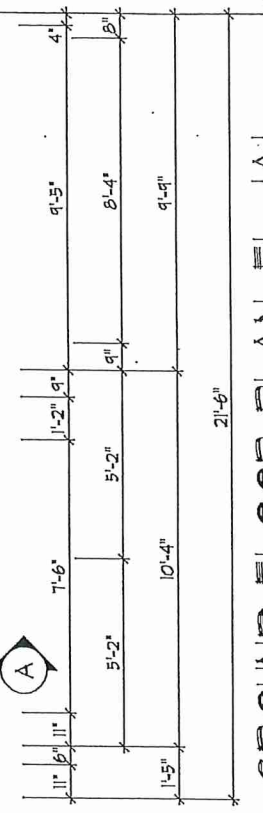

GROUND FLOOR PLAN, EL. 'A'

BK 235-68

FOR ROOF VENTS
SEE BLOCK PLAN

LANDING
45' x 43 1/2"
DWN. 22 7/8"

ROOF PLAN
EL. 'A' END

N.T.S.

177' wall to wall




157' to closet

45"

43 1/2"

2x6 @ 16" OC
ON TOP OF 1" BEAM
2x6 @ 11" @ BEAM

DOORS 8'3"
WINDOWS SEE ELEV.

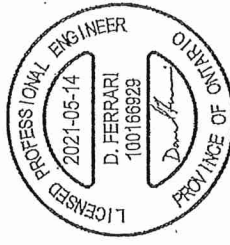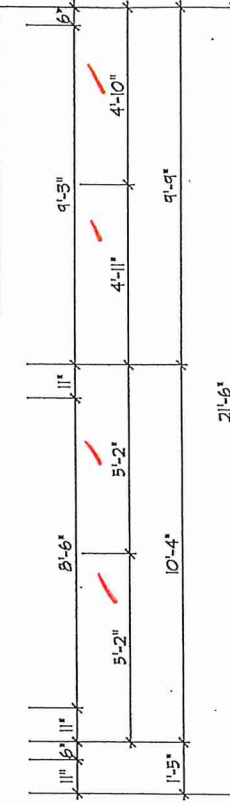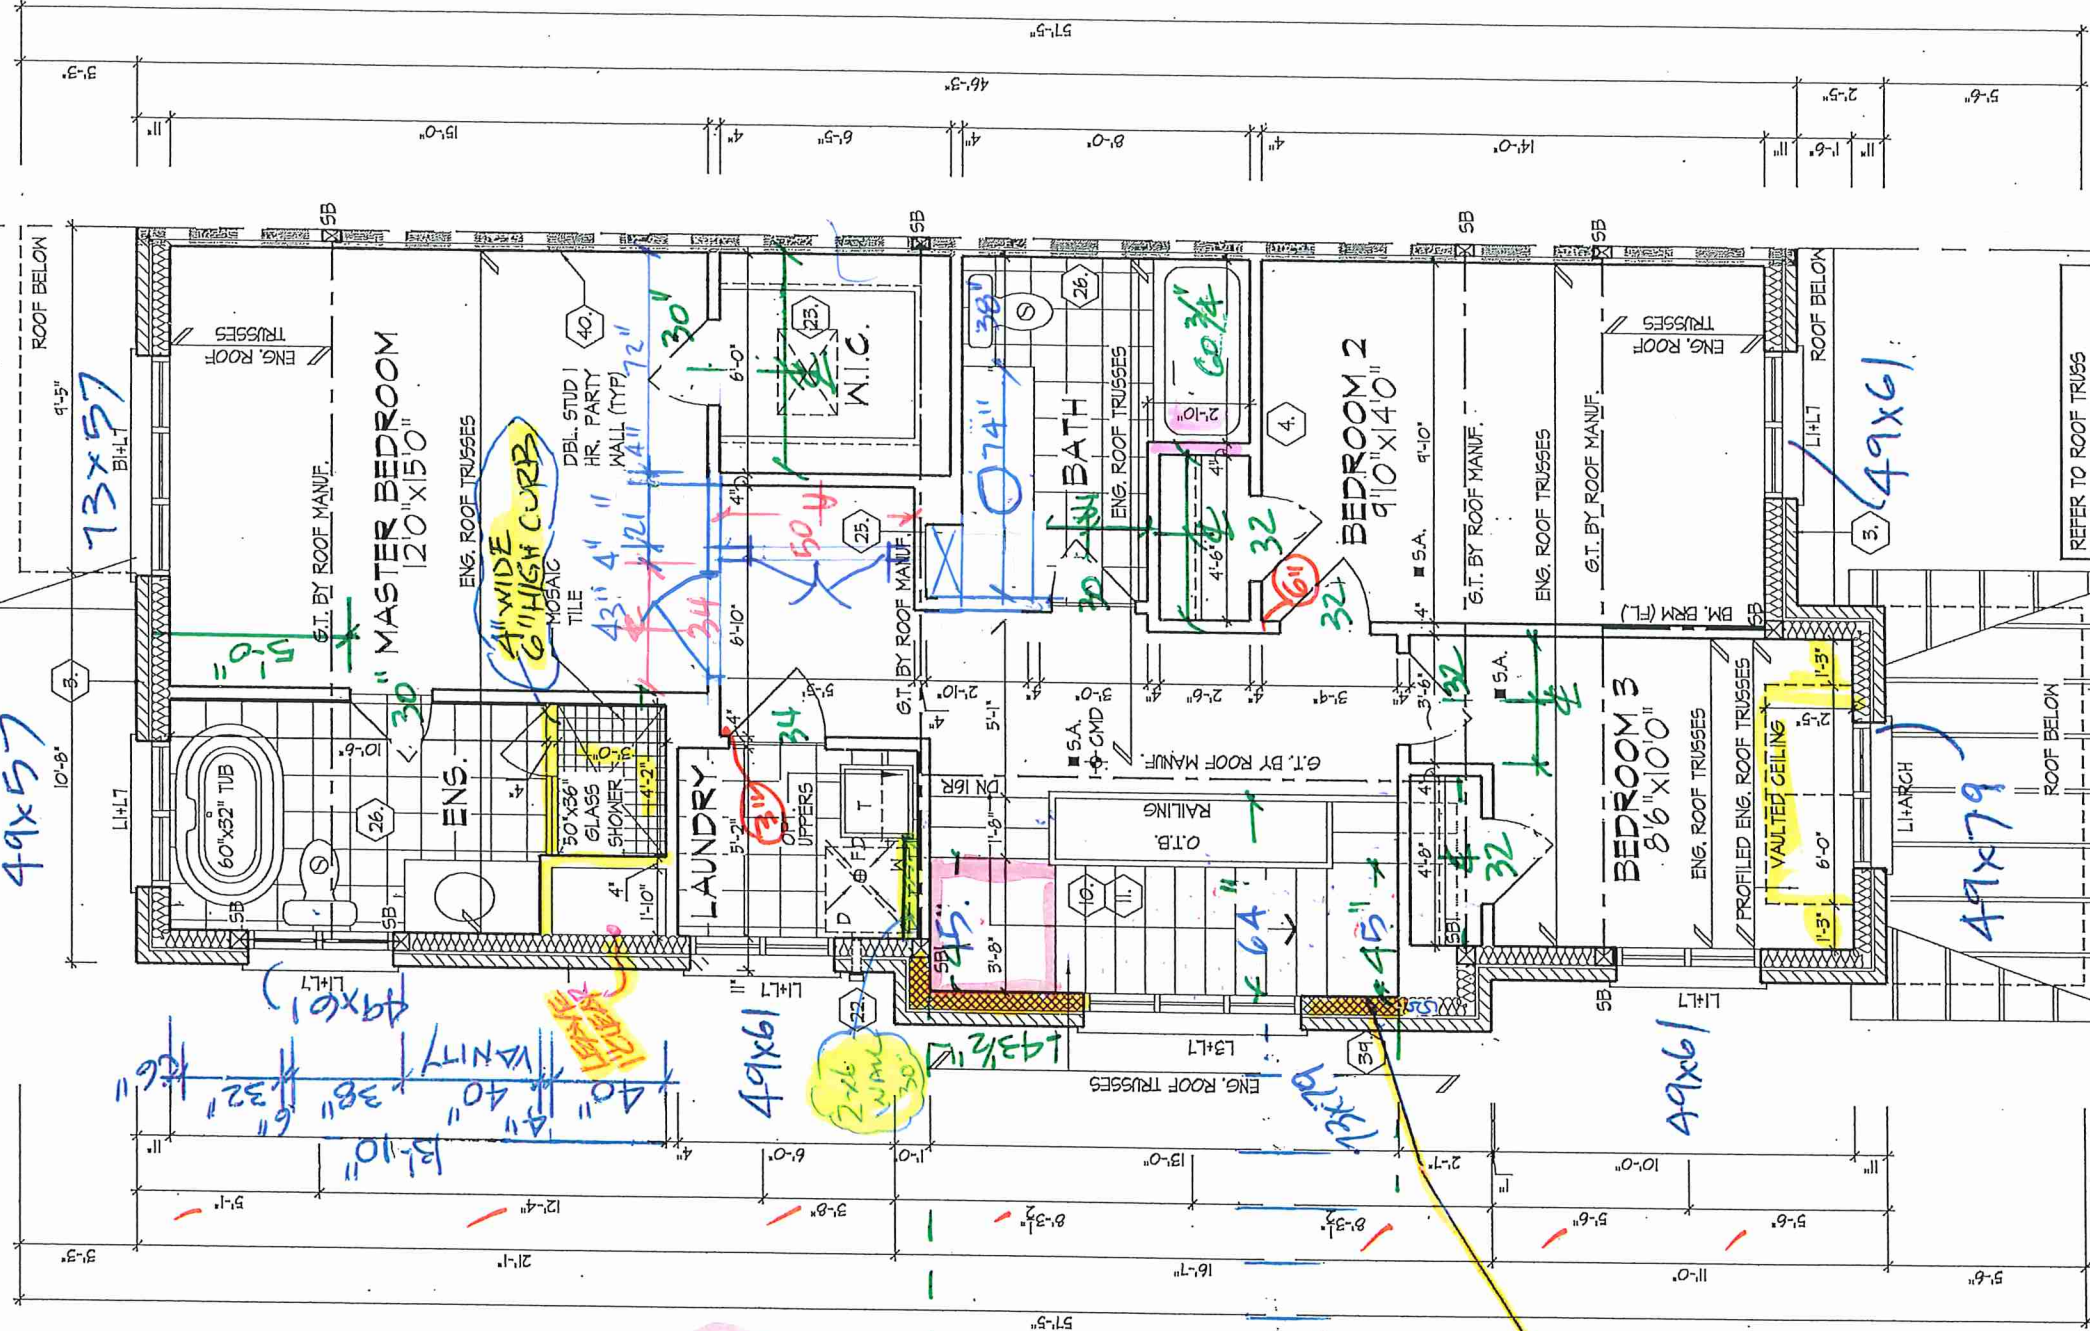

FOR STRUCTURAL ONLY
NOT INCLUDING ENGINEERED
FLOOR OR ROOF SYSTEM

SECOND FLOOR PLAN, EL. 'A'

BK 235-68

SECOND FLOOR PLAN, ELEV. 'A'

UNIT 2010
REV. 2021.05.11


ROYAL PINE HOMES - 216102
'CENTREFIELD', WEST GORMLEY, RICHMOND HILL, ON.

HUNT
DESIGN ASSOCIATES INC.
www.hunt-design.ca

DESIGNED AND DRAWN BY: R. SANTOS
CHECKED BY: D. S. 3/16/21
DATE: 3/16/21
SCALE: 3/16"=1'-0"

Page Number
6 of 17


Reproduction of this property in whole or in part is strictly prohibited without H.D.A.'s written permission (H.D.A. assumes no responsibility or liability for this property unless it bears the appropriate BCIN number and original signature.)

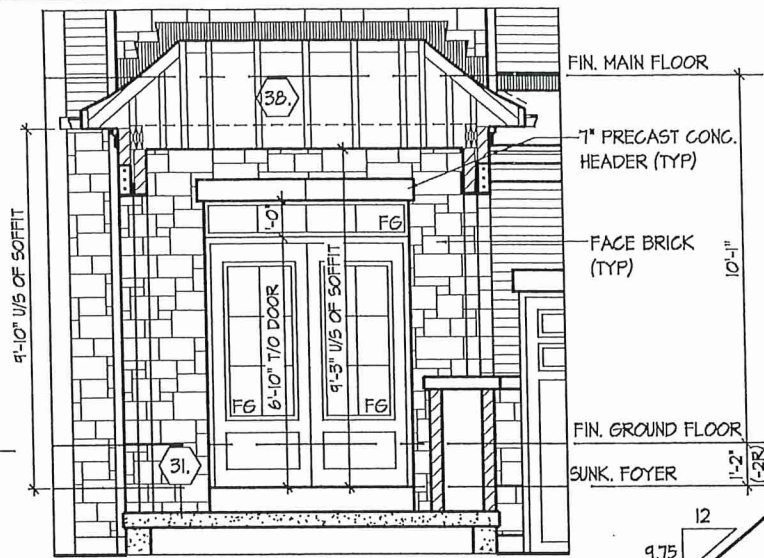

INTERIOR PORTIC SECTION

GARAGE ROOF
18" O.H + 18/12 PITCH

W Architect Inc.
DESIGN CONTROL REVIEW
JUNE 01, 2021
FINAL BY: *ALL*
This stamp is only for the purposes of design control and carries no other professional obligations.


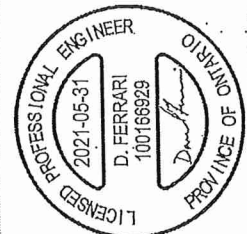


FOR STRUCTURAL ONLY
NOT INCLUDING ENGINEERED
FLOOR OR ROOF SYSTEM

FRONT AND REAR ELEV. 'A'

UNIT 2010
REV. 2021.05.31

Page Number
9 of 17

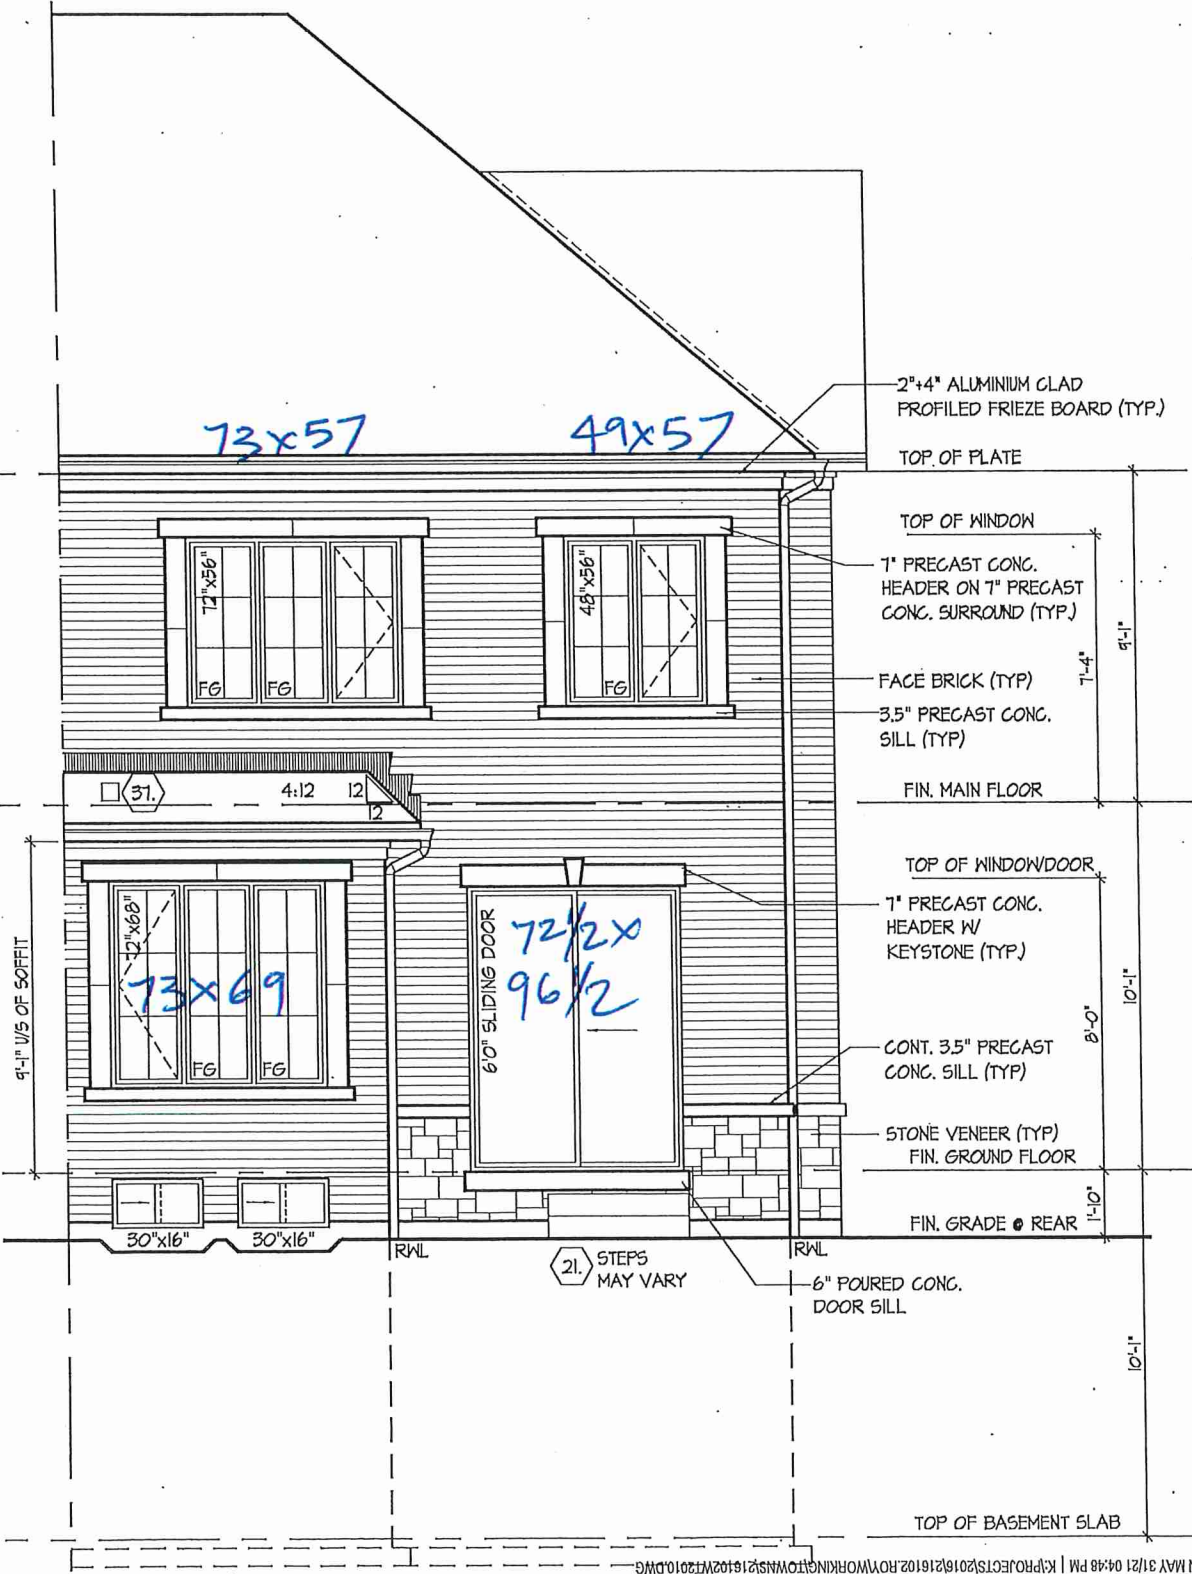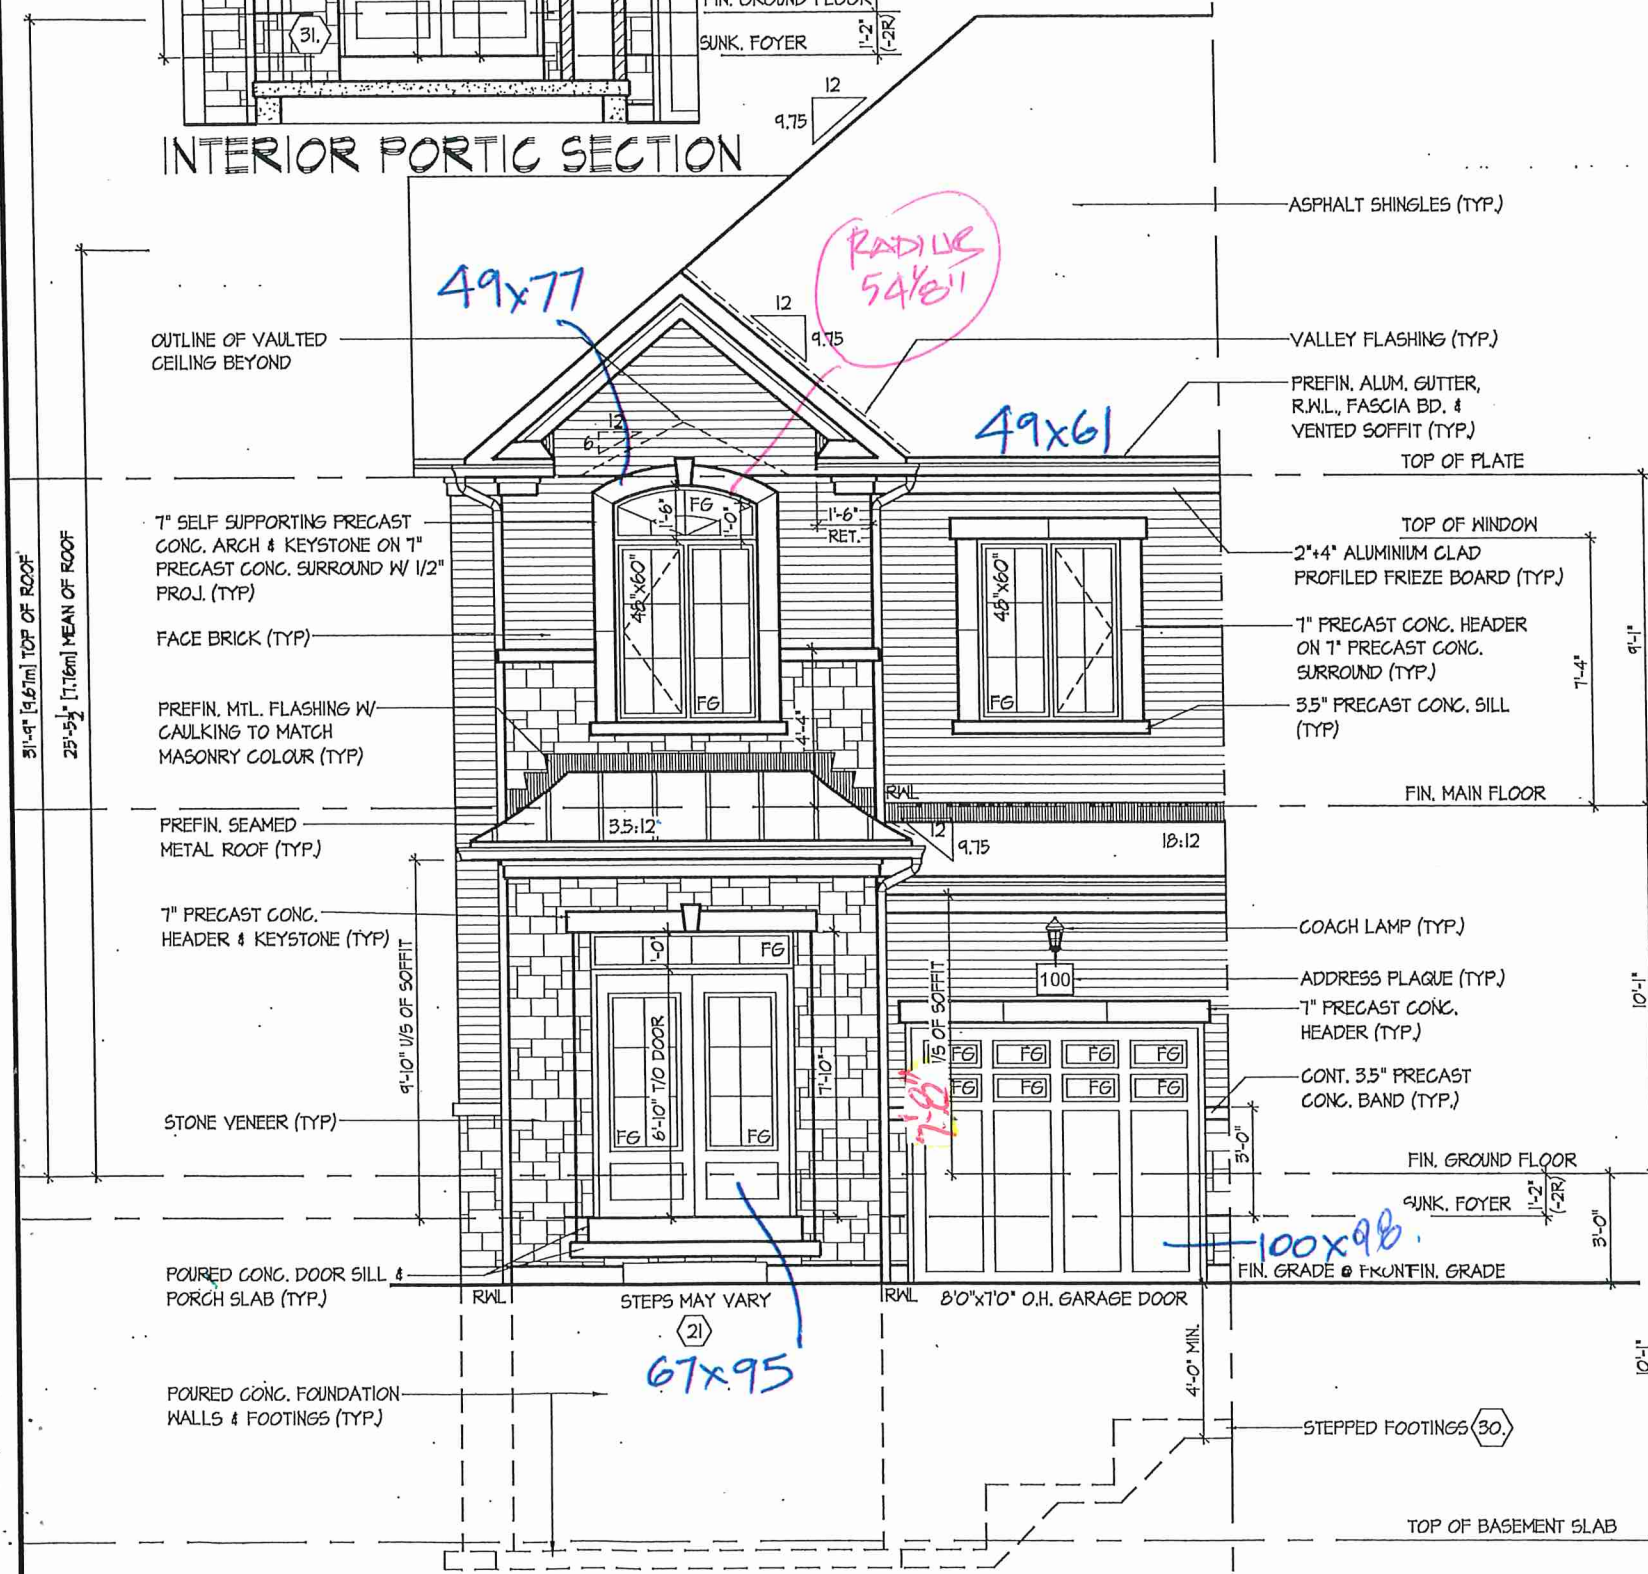


BLK 235-68

ROYAL PINE HOMES - 216102
'CENTREFIELD', WEST GORMLEY, RICHMOND HILL, ON.



DESIGN ASSOCIATES INC.
www.hunt-design.ca
37308
1995
THE UNDERSIGNED HAS REVIEWED AND TAKES RESPONSIBILITY FOR THIS DESIGN AND HAS
THE QUALIFICATIONS AND MEETS THE REQUIREMENTS SET OUT IN THE ONTARIO BUILDING
CODE TO BE A DESIGNER.
QUALIFICATION INFORMATION
Derek R. Santos
SIGNATURE
HUNT DESIGN ASSOCIATES INC.
All drawings specifications related documents and design are the copyright property of Hunt Design Associates (H.D.A.). Reproduction of this property in whole or in part is strictly prohibited without H.D.A.'s written permission (H.D.A. assumes no responsibility or liability for this property unless it bears the appropriate BCIN number and original signature.)

W Architect Inc.
DESIGN CONTROL REVIEW
JUNE 01, 2021
FINAL BY: *Ally*
This stamp is only for the purposes of design control and carries no other professional obligations.

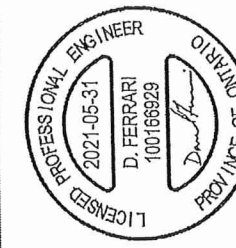

FOR STRUCTURAL ONLY
NOT INCLUDING ENGINEERED
FLOOR OR ROOF SYSTEM

FLANKAGE ELEV. 'A'

UNIT 2010

REV. 2021.05.31

Page Number
10 of 17

File Number
216102WT2010

Scale
3/16"=1'-0"

Checked By
DS

Drawn By
VM

8966 Woodbine Ave, Markham, ON L3R 0J7

T 905.737.5133 F 905.737.7826

ROYAL PINE HOMES - 216102
'CENTREFIELD', WEST GORMLEY, RICHMOND HILL, ON.

HUNT
DESIGN ASSOCIATES INC.
www.hunt-design.ca


THE UNDERSIGNED HAS REVIEWED AND TAKES RESPONSIBILITY FOR THIS DESIGN AND HAS
THE QUALIFICATIONS AND MEETS THE REQUIREMENTS SET OUT IN THE ONTARIO BUILDING
CODE TO BE A DESIGNER.

QUALIFICATION INFORMATION
Derek R. Santos



REGISTRATION INFORMATION
NAME
HUNT DESIGN ASSOCIATES INC.

37308 BCN 19855


All drawings specifications related documents and design are the copyright property of Hunt Design Associates (H.D.A.). Reproduction of this property in whole or in part is strictly prohibited without H.D.A.'s written permission (H.D.A. assumes no responsibility or liability for this property unless it bears the appropriate BCIN number and original signature).

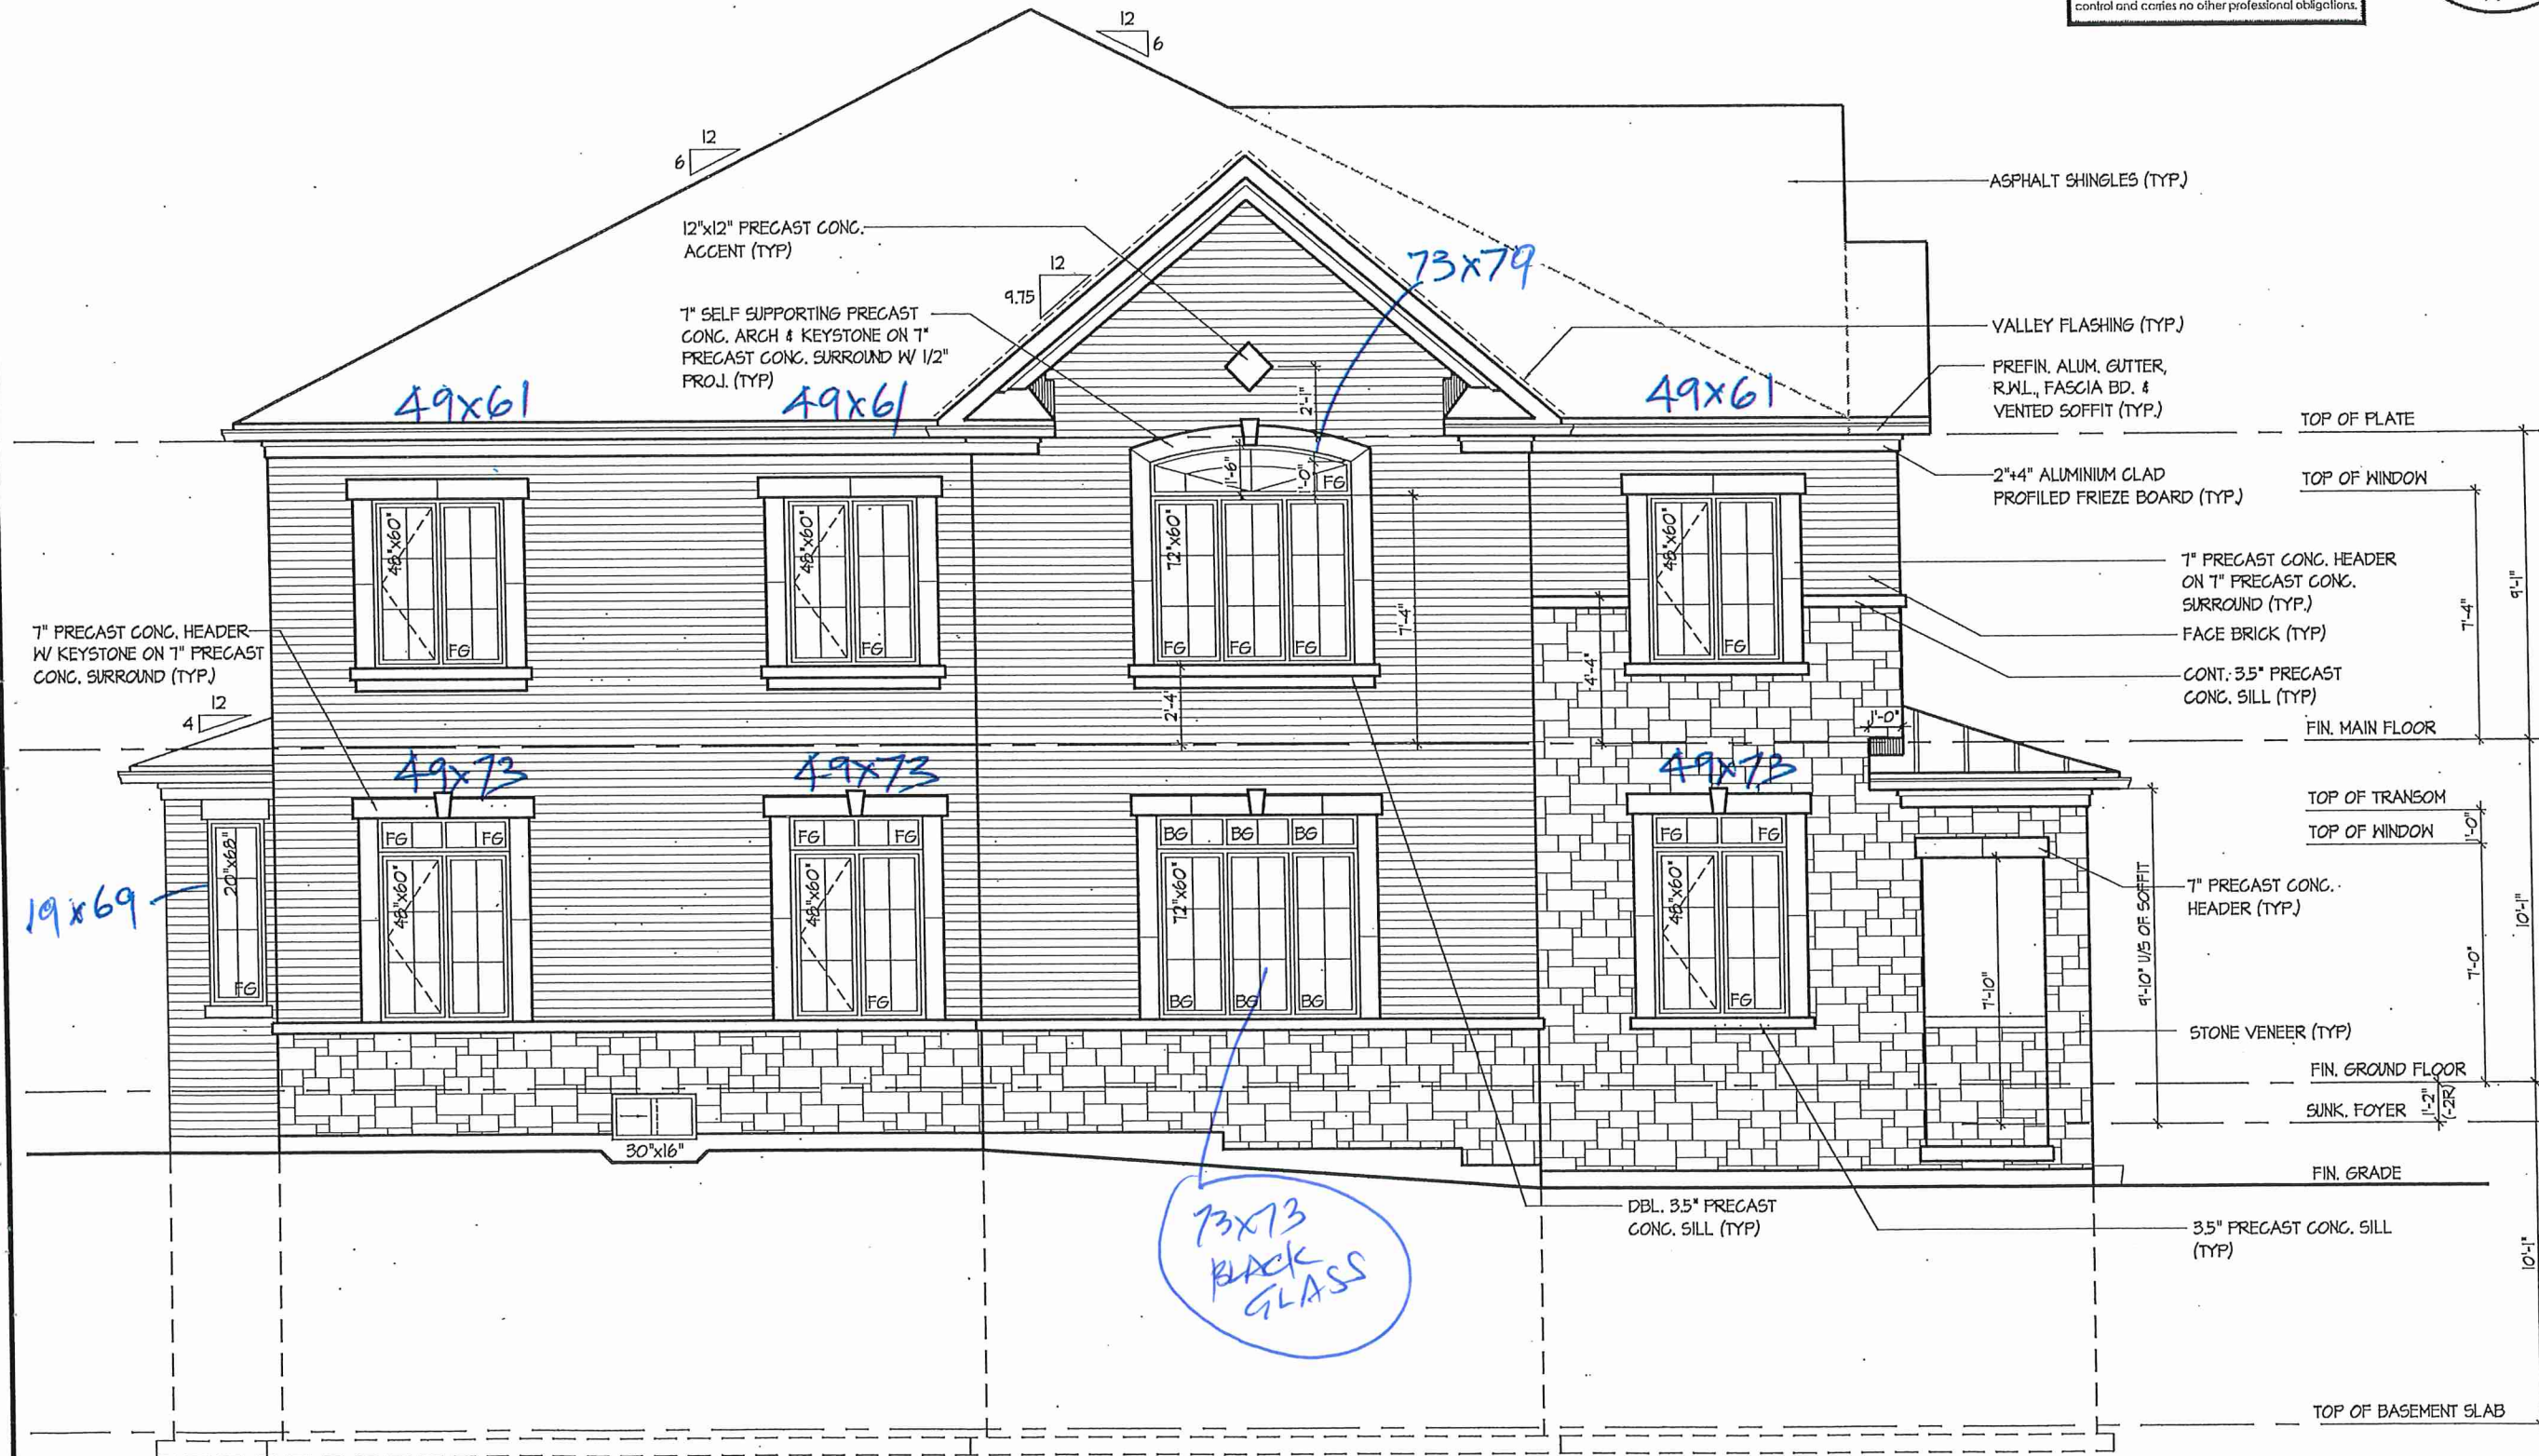

FLANKAGE ELEVATION 'A'

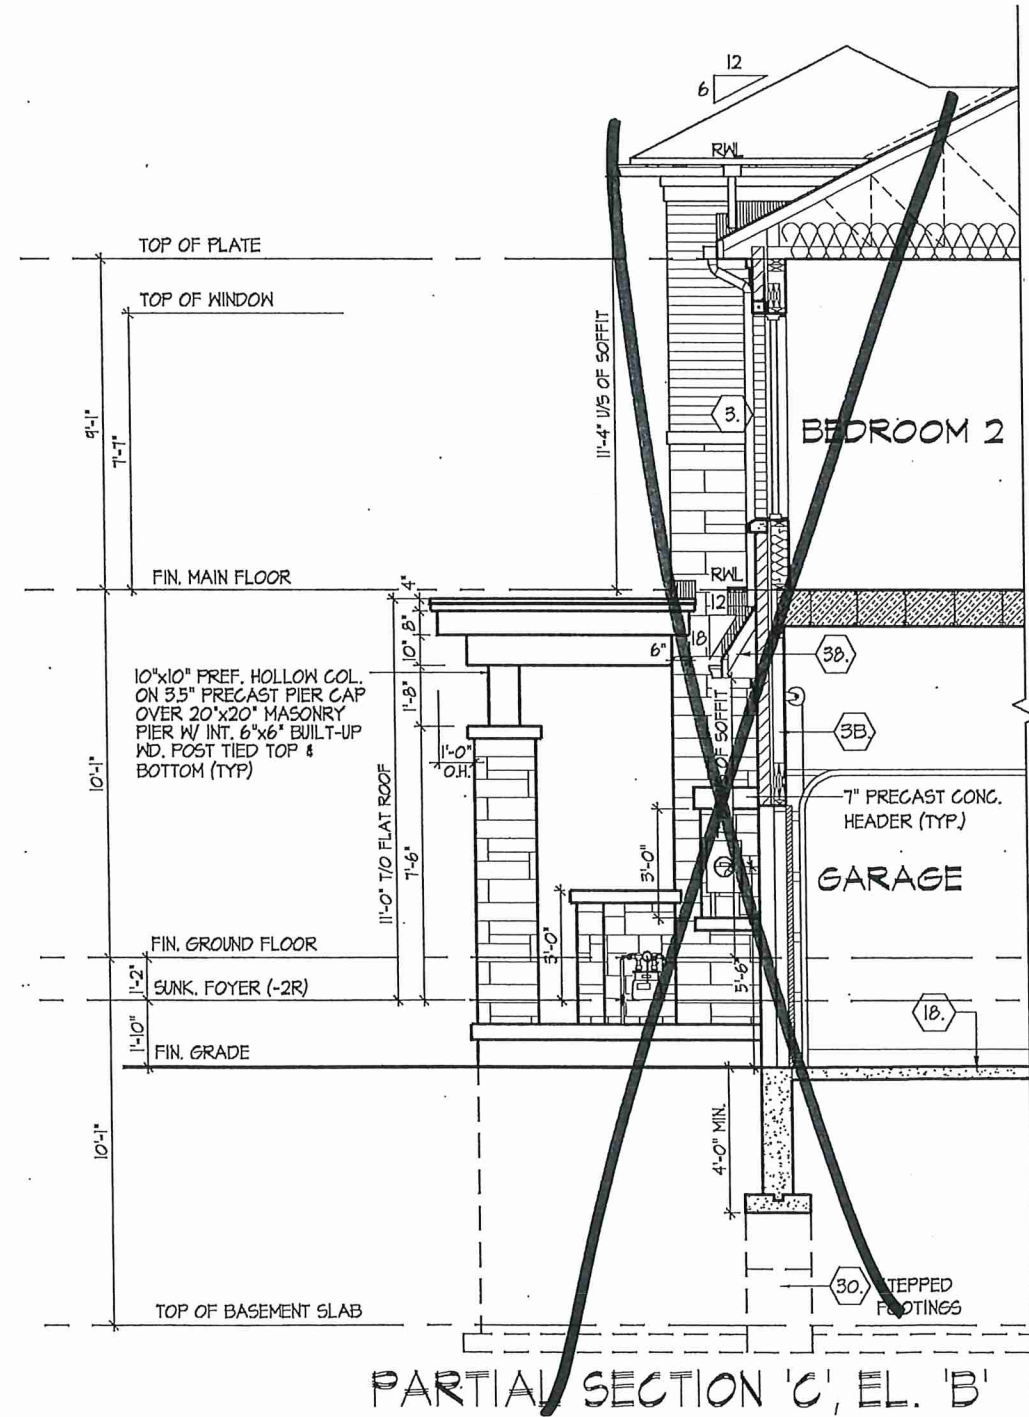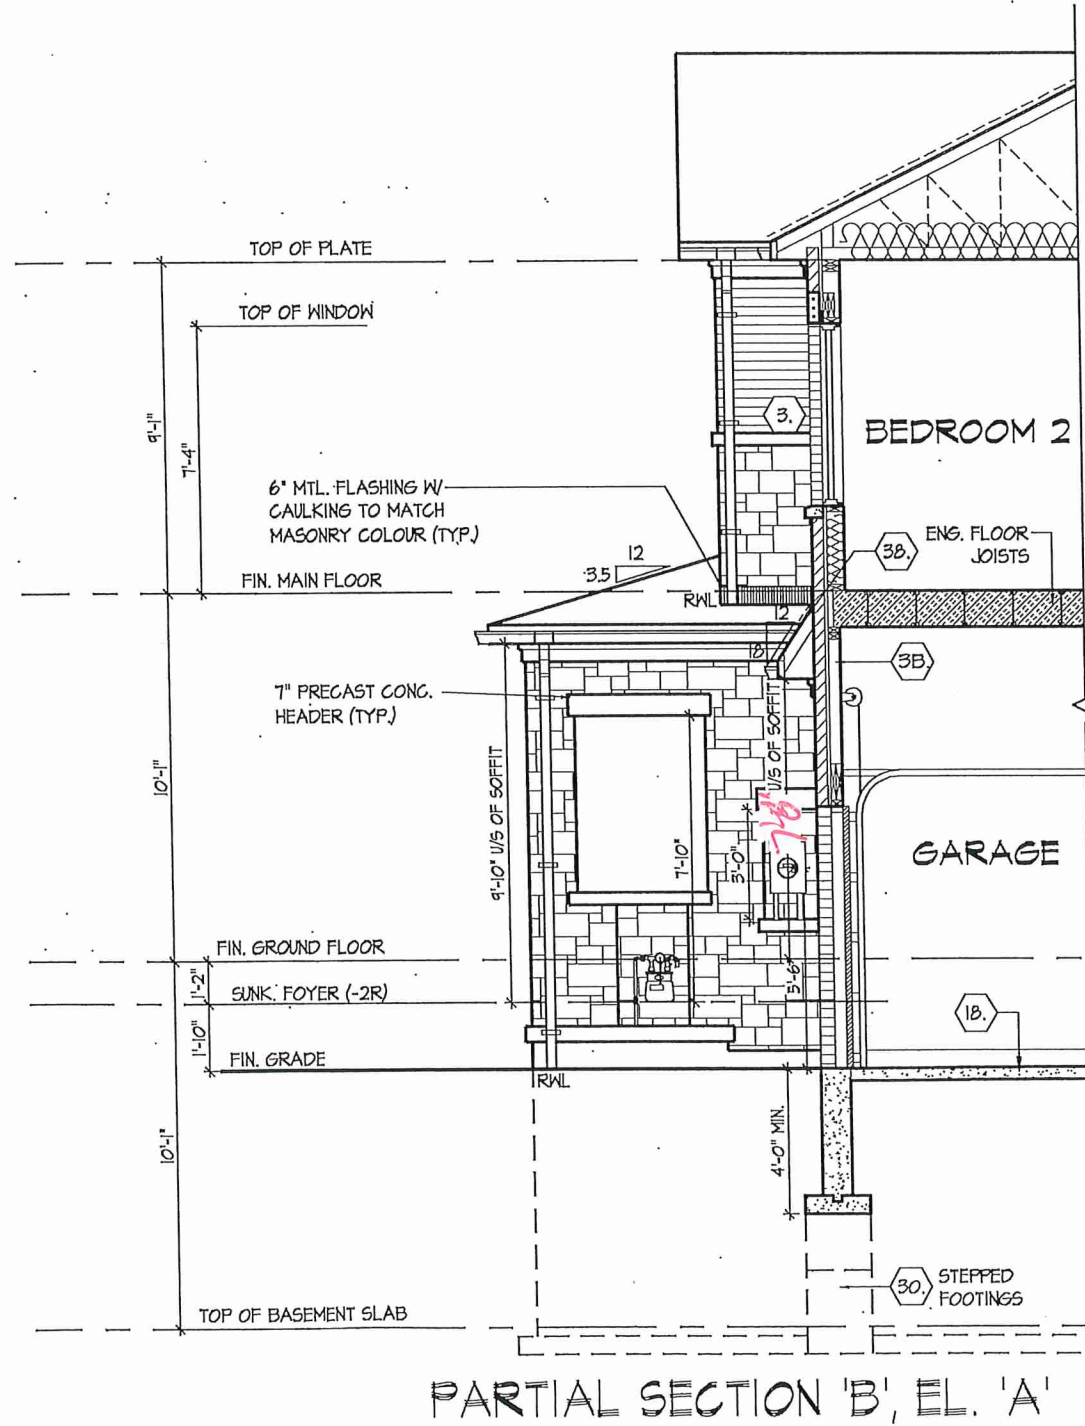

W Architect Inc.
DESIGN CONTROL REVIEW
JUNE 01, 2021
FINAL BY: *Ally*
This stamp is only for the purposes of design control and carries no other professional obligations.

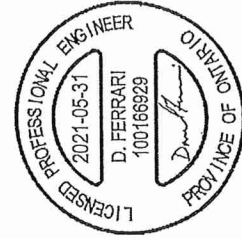

FOR STRUCTURAL ONLY
NOT INCLUDING ENGINEERED
FLOOR OR ROOF SYSTEM

235-68 PARTIAL SECTION ELEV. 'A' & 'B'
ROYAL PINE HOMES - 216102
'CENTREFIELD', WEST GORMLEY, RICHMOND HILL, ON.

UNIT 2010
REV. 2021.05.31

Drawn By: VM
Checked By: DS
Scale: 3/16"=1'-0"
File Number: 216102WT2010
Page Number: 14 of 17

HUNT
DESIGN ASSOCIATES INC.
www.hunt-design.ca

REGISTRATION INFORMATION
NAME: Derek R. Santos
BCIN: 37308
1995

THE UNDERSIGNED HAS REVIEWED AND TAKES RESPONSIBILITY FOR THIS DESIGN AND HAS
THE QUALIFICATIONS AND MEETS THE REQUIREMENTS SET OUT IN THE ONTARIO BUILDING
CODE TO BE A DESIGNER.
All drawings specifications related documents and design are the copyright property of Hunt Design Associates (H.D.A.). Reproduction of this property in whole or in part is strictly prohibited without H.D.A.'s written permission. (H.D.A. assumes no responsibility or liability for this property unless it bears the appropriate BCIN number and original signature.)

FINAL BY: [Signature]
This stamp is only for the purposes of design control and carries no other professional obligations.

Page Number
11 of 17


File Number
216102WT2010

www.huntidesign.ca

CODE TO BUY REVIEWS

REGISTRATION INFORMATION

10000
HUNT DESIGN ASSOCIATES INC.
All drawings specifications related documents and design are the copyright property of Hunt/Design Associates (H.D.A.). Reproduction of this property in whole or in part is strictly prohibited without H.D.A.'s written permission (H.D.A. assumes no responsibility or liability for this property unless it bears the appropriate BCIN number and original signature)

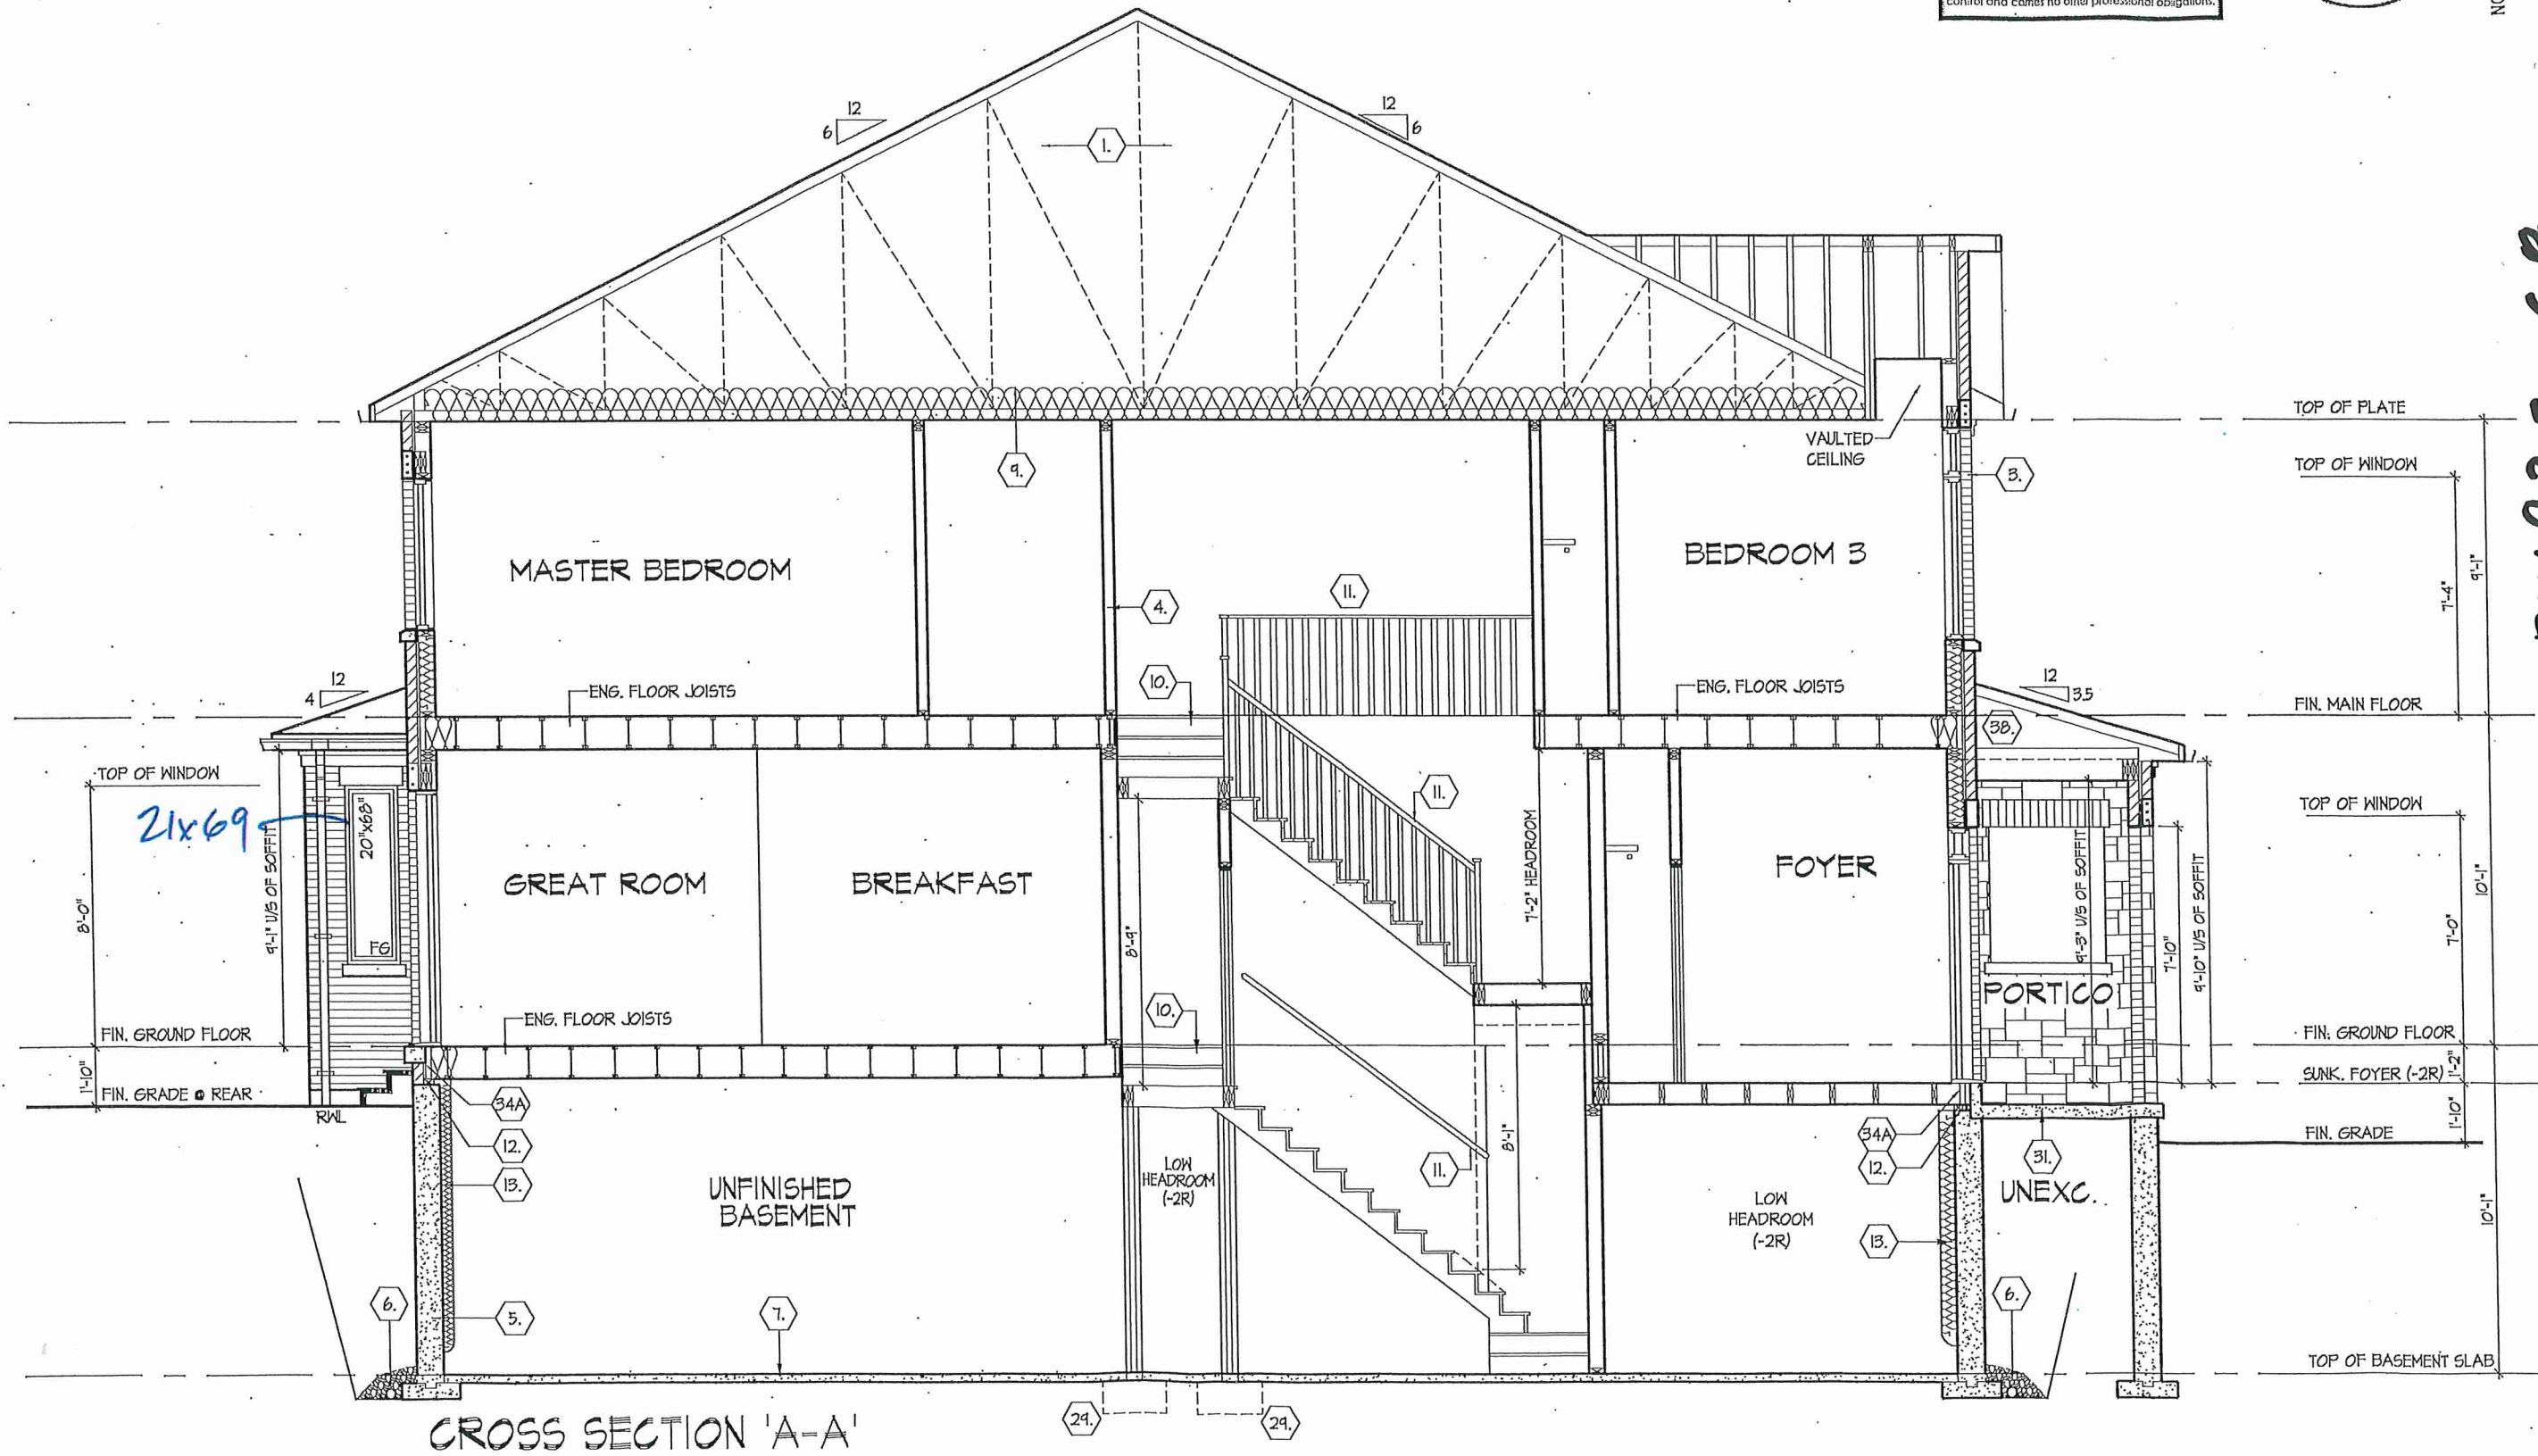

cont. SECTION 1.0. CONSTRUCTION NOTES

- 401 HR. PARTY WALL (CONC. BLOCK) (SB-3) WALL TYPE B&E & B1b) 1/2" (12.7) GYPSUM SHEATHING ON EACH SIDE ON 2"x2" (38x38) VERTICAL WD. STRAPPING @ 24" (610) O.C. ON 8" (200) CONC. BLOCK FILL STRAPPING CAVITY EACH SIDE WITH AT LEAST 90% OF ABSORPTIVE MATERIAL PROCESSED FROM ROCK, SLAG OR GLASS. TAPE, FILL & SAND ALL GYPSUM JOINTS. EXPOSED BLOCK MUST BE SEALED W/ 2 COATS OF PAINT OR FURRED WITH 2"x2" (38x38) WD. STRAPPING & 1/2" (12.7) GYPSUM SHEATHING.
- 402 HR. PARTY WALL (DOUBLE STUD) (SB-3) WALL TYPE W13c) 5/8" (15.9) TYPE 'X' GYPSUM SHEATHING ON EXTERIOR SIDE OF 2 ROWS OF 2"x4" (38x89) STUDS @ 16" (406) O.C., MIN. 1" (25) APART ON SEPARATE 2"x4" (38x89) SILL PLATES. (2"x6" (38x140) AS REQUIRED) FILL ONE SIDE OF STUD CAVITY WITH AT LEAST 90% OF ABSORPTIVE MATERIAL PROCESSED FROM ROCK, SLAG OR GLASS. TAPE FILL AND SAND ALL GYPSUM JOINTS.
- 40A2 HR. FIREWALL (SB-3) WALL TYPE B&E & B1b) 1/2" (12.7) GYPSUM SHEATHING ON EACH SIDE ON 2"x2" (38x38) VERTICAL WD. STRAPPING @ 24" (610) O.C. ON 8" (200) CONC. BLOCK 75% SOLID. FILL STRAPPING CAVITY EACH SIDE WITH AT LEAST 90% OF ABSORPTIVE MATERIAL PROCESSED FROM ROCK, SLAG OR GLASS. TAPE, FILL & SAND ALL GYPSUM JOINTS. AT UNFINISHED AREAS, EXTERIOR FACE OF CONC. BLOCK TO BE SEALED WITH 2 COATS OF PAINT. GYPSUM SHEATHING TO BE ATTACHED TO CONC. BLOCK. (REFER TO DETAILS)
- 41STUCCO WALL CONSTRUCTION (2"x6") STUCCO FINISH CONFORMING TO O.B.C. SECTION 9.28. AND APPLIED PER MANUFACTURERS SPECIFICATIONS OVER 1 1/2" (38) E.F.L.S. (MINIMUM) ON APPROVED DRAINAGE MAT ON 1/2" (12.7) DENSGLASS GOLD GYPSUM BOARD ON STUDS CONFORMING TO O.B.C (9.23.10.1) & SECTION 1.1. INSULATION, APPROVED 6 MIL POLYETHYLENE VAPOUR BARRIER, 1/2" (12.7) GYPSUM WALLBOARD INT. FINISH. (REFER TO 35 NOTE AS REQUIRED)
- 41A2STUCCO WALL CONSTRUCTION (2"x6") W/ CONTIN. INSUL. STUCCO FINISH CONFORMING TO O.B.C. SECTION 9.28. AND APPLIED PER MANUFACTURERS SPECIFICATIONS OVER 1 1/2" (38) E.F.L.S. (MINIMUM) ON APPROVED DRAINAGE MAT ON APPROVED AIRWATER BARRIER AS PER O.B.C. 9.27.3. ON EXTERIOR TYPE RIGID INSULATION (JOINTS UNTAPED) MECHANICALLY FASTENED AS PER MANUFACTURERS SPECIFICATIONS, ON 7/16" EXTERIOR TYPE SHEATHING ON STUDS CONFORMING TO O.B.C (9.23.10.1) & SECTION 1.1. INSULATION, APPROVED 6 MIL POLYETHYLENE VAPOUR BARRIER, 1/2" (12.7) GYPSUM WALLBOARD INT. FINISH. (REFER TO 35 NOTE AS REQUIRED)
- 41B2STUCCO WALL @ GARAGE CONST. STUCCO FINISH CONFORMING TO O.B.C. SECTION 9.28. AND APPLIED PER MANUFACTURERS SPECIFICATIONS OVER 1 1/2" (38) E.F.L.S. (MINIMUM) ON APPROVED DRAINAGE MAT ON 1/2" (12.7) DENSGLASS GOLD GYPSUM BRD. ON STUDS CONFORMING TO O.B.C (9.23.10.1) & SECTION 1.1. 1/2" (12.7) GYPSUM WALLBOARD INT. FINISH. (REFER TO 35 NOTE AS REQ.) *** FOR DWELLINGS USING CONTIN. INSULATION CONSTRUCTION, PROVIDE APPROVED DRAINAGE MAT ON 7/16" (11) EXTERIOR TYPE SHEATHING OVER FURRING (AS REQ.) AND STUDS IN LIEU OF 1 1/2" (38) E.F.L.S. (MINIMUM) ON APPROVED DRAINAGE MAT ON 1/2" (12.7) DENSGLASS GOLD GYPSUM BRD. REINFORCING AT BASEMENT WINDOWS
- 422-15M HORIZ. REINFORCING ON THE INSIDE AND OUTSIDE FACE OF THE FOUNDATION WALL BELOW THE WIN. SILL. EXTEND BARS 24" (610) BEYOND THE OPENING. 2-15M VERTICAL REINFORCING ON THE INSIDE AND OUTSIDE FACE OF THE FOUNDATION WALL ON EACH SIDE OF THE WINDOW OPENING. BARS TO HAVE MIN. 1" (25) CONC. COVER - BARS TO EXTEND 2'-0" (610) BEYOND BOTH SIDES OF OPENING
- 43STUD WALL REINFORCEMENT PROVIDE STUD WALL REINFORCEMENT IN MAIN BATHROOM CONFORMING TO O.B.C. (9.5.2.3.1) AND 3.8.3.8.(3) (REFER TO DETAILS)
- 44WINDOW WELLS WHERE A WINDOW OPENS INTO A WINDOW WELL, A CLEARANCE OF NOT LESS THAN 21.5" (550) SHALL BE PROVIDED IN FRONT OF THE WINDOW. EVERY WINDOW WELL SHALL BE DRAINED TO THE FOOTING LEVEL OR OTHER SUITABLE LOCATION WITH A 4" (100) WEEPING TILE C/W A FILTER CLOTH WRAP AND FILLED WITH CRUSHED STONE. (9.9.10.1.(6), 9.14.6.3)
- 45SLOPED CEILING CONSTRUCTION (SSB-12) 2.1.1.7, 9.23.4.2) 2"x12" (38x286) ROOF JOISTS @ 16" (406) O.C. MAX. (UNLESS OTHERWISE NOTED) W/ 2"x2" (38x38) PURLINS @ 16" (406) O.C. PERPENDICULAR TO ROOF CURB TO BE 4" (100) MIN. ABOVE FINISHED BALCONY FLOOR. CONTINUOUS 1" JOIST POLYETHYLENE VAPOUR BARRIER, 1/2" (12.7) GYPSUM WALLBOARD INT. FINISH OR APPROVED EQ. INSULATION VALUE DIRECTLY ABOVE THE INNER SURFACE OF EXTERIOR WALLS SHALL NOT BE LESS THAN R20 (3.32 RS). FLAT ROOF/BALCONY CONSTRUCTION WATERPROOFING MEMBRANE (9.26.11, 9.26.15, 9.26.16) FULLY ADHERED TO 5/8" (15.9) T&G EXTERIOR GRADE PLYWOOD SHEATHING ON 2"x2" (38x38) PURLINS ANGLED TOWARDS SCUPPER @ 2% MINIMUM LAID PERPENDICULAR TO 2"x6" (38x184) FLOOR JOISTS @ 16" (406) O.C. (UNLESS OTHERWISE NOTED). BUILT UP CURB TO BE 4" (100) MIN. ABOVE FINISHED BALCONY FLOOR. CONTINUOUS 1" TRIM DRIP EDGE TO BE PROVIDED ON OUTSIDE FACE OF CURB. SCUPPER DRAIN TO BE LOCATED 24" (610) MIN. AWAY FROM HOUSE. PREFINISHED ALUMINUM OR PANEL FOR UNDERSIDE OF SOFFIT (9.23.2.3). REMOVE CURB WHERE REQ. BALCONY CONDITION SEE FLAT ROOF/BALCONY CONSTRUCTION NOTE. INCLUDE 2"x4" (38x89) PT. DECKING W/ 1/4" (6.4) GAPS LAID FLAT PARALLEL TO JOISTS ON 2"x4" (38x89) PT. SLEEPERS @ 12" (305) O.C. LAID FLAT PERPENDICULAR TO JOISTS
- 46BALCONY OVER HEATED SPACE CONDITION SEE FLAT ROOF/BALCONY CONSTRUCTION NOTE FOR ASSEMBLY. REFER TO PLANS FOR FLOOR JOIST SIZE & REFER TO HEX NOTE 9 FOR INSULATION AND INTERIOR FINISH
- 47BARREL VAULT CONSTRUCTION CANTILEVERED 2"x4" (38x89) SPACERS LAID FLAT ON 2"x10" (38x235) SPR. #2 ROOF JOIST NAILED TO BUILT-UP 3-3/4" (19) PLYWOOD HEADER PROFILED FOR BARREL. SPRAY FOAM INSULATION BETWEEN JOISTS W/ GYPSUM BOARD. INTERIOR FIN. (REFER TO DETAILS)

SECTION 1.1. WALL STUDS

- REFER TO THIS CHART FOR STUD SIZE & SPACING AS REQUIRED FOR EXTERIOR WALLS ONLY. REFER TO STRING & GRADING PLAN OF THIS UNIT FOR CONFORMATION OF TOP OF FOUNDATION WALL AND ADDITIONAL INFORMATION.
- IF STUD WALL HEIGHT EXCEEDS MAX. UNSUPPORTED HEIGHT, WALL NEEDS TO BE REVIEWED AND APPROVED BY ENGINEER.

SIZE & SPACING OF STUDS: (OBC REFERENCE - TABLE 9.23.10.1.)	
MIN. STUD SIZE, in (mm)	SUPPORTED LOADS (EXTERIOR)
ROOF w/ OR w/o ATTIC	ROOF w/ OR w/o ROOF w/ OR w/o
MAX. STUD SPACING, in (mm) O.C.	ATTIC & 1 FLOOR/ATTIC & 3 FLOOR
MAX. UNSUPPORTED HGT., ft-in (m)	
2"x4" (38x69)	16" (406) 12" (305) N/A
9"-10" (3.0)	9"-10" (3.0) N/A
2"x6" (38x140)	24" (610) 16" (406) 12" (305)
-	9"-10" (3.0) 11"-10" (3.5) 5'-11" (1.8)

SECTION 2.0. GENERAL NOTES

- 2.1. WINDOWS
- 1) EXCEPT WHERE A DOOR ON THE SAME FLOOR LEVEL AS THE BEDROOM PROVIDES DIRECT ACCESS TO THE EXTERIOR, EVERY FLOOR LEVEL CONTAINING A BEDROOM IS TO HAVE AT LEAST ONE OUTSIDE WINDOW W/ MIN. 0.35x2 UNOBSTRUCTED OPEN PORTION W/ NO DIMENSION LESS THAN 1'-8" (380), CAPABLE OF MAINTAINING THE OPENING WITHOUT THE NEED FOR ADDITIONAL SUPPORT, CONFORMING TO 9.9.10.
- 2) WINDOW GUARDS: A GUARD OR A WINDOW WITH A MAXIMUM RESTRICTED OPENING WIDTH OF 4" (100) IS REQUIRED WHERE THE TOP OF THE WINDOW SILL IS LOCATED LESS THAN 1'-7" (380) ABOVE FIN. FLOOR AND THE DISTANCE FROM THE FINISHED FLOOR TO THE ADJACENT GRADE IS GREATER THAN 5'-11" (1800), (9.8.8.1.)
- 3) WINDOWS IN EXIT STAIRWAYS THAT EXTEND TO LESS THAN 2'-11" (800) (9-9" (1070) FOR ALL OTHER BUILDINGS) SHALL BE PROTECTED BY GUARDS IN ACCORDANCE WITH NOTE #2 (ABOVE), OR THE WINDOW SHALL BE NON-OPERABLE AND DESIGNED TO WITHSTAND THE SPECIFIED LOADS FOR BALCONY GUARDS AS PROVIDED IN 4.1.5.15 OR 9.8.8.2
- 4) REFER TO TITLE PAGE FOR MAX. U-VALUE REQUIREMENTS
- 2.2. CEILING HEIGHTS
- THE CEILING HEIGHTS OF ROOMS AND SPACES SHALL CONFORM TO TABLE 9.5.3.1.

ROOM OR SPACE	MINIMUM HEIGHTS
LIVING ROOM, DINING ROOM AND KITCHEN	7'-7" OVER 75% OF REQUIRED FLOOR AREA WITH A CLEAR HEIGHT OF 6'-11" AT ANY POINT
BEDROOM	7'-7" OVER 50% OF REQUIRED FLOOR AREA OR 6'-11" OVERALL OF THE REQUIRED FLOOR AREA.
BASEMENT	6'-11" OVER AT LEAST 75% OF THE BASEMENT AREA EXCEPT THAT UNDER BEAMS AND DUCTS THE CLEARANCE IS PERMITTED TO BE REDUCED TO 6'-5".
BATHROOM, LAUNDRY AREA ABOVE GRADE MENTIONED ABOVE	6'-11" IN ANY AREA WHERE A PERSON WOULD NORMALLY BE STANDING
FINISHED ROOM NOT MENTIONED ABOVE	6'-11"
MEZZANINES	6'-11" ABOVE & BELOW FLOOR ASSEMBLY (9.5.3.2.)
STORAGE GARAGE	8'-7" (9.5.3.3)

- 2.3. MECHANICAL / PLUMBING
- 1) MECHANICAL VENTILATION IS REQUIRED TO PROVIDE 0.7 AIR CHANGE PER HOUR IF NOT AIR CONDITIONED 1 PER HOUR IF AIR CONDITIONED AVERAGED OVER 24 HOURS. WHEN A VENTILATION FAN (PRINCIPAL EXHAUST) IS REQUIRED, CONFORM TO OBC 9.32.3.4. WHEN A HRV IS REQUIRED, CONFORM TO 9.32.3.11. REFER TO MECHANICAL DRAWINGS.
- 2) REFER TO HOT WATER TANK MANUFACTURER SPECS. CONFORM TO OBC 9.8.1.6.
- 3) REFER TO TITLE PAGE FOR SPACE HEATING EQUIPMENT, HRV AND DOMESTIC HOT WATER HEATER MINIMUM EFFICIENCIES.
- 4) DRAIN WATER HEAT RECOVERY UNIT(S) WILL BE INSTALLED CONFORMING TO THE REQUIREMENTS OF 3.1.1.12. OF THE O.B.C.
- 2.4. LUMBER
- 1) ALL LUMBER SHALL BE SPRUCE No.2 GRADE OR BETTER, UNLESS NOTED OTHERWISE.
- 2) STUDS SHALL BE STUD GRADE SPRUCE, UNLESS NOTED OTHERWISE.
- 3) LUMBER EXPOSED TO THE EXTERIOR TO BE SPRUCE No. 2 GRADE PRESSURE TREATED OR CEDAR, UNLESS NOTED OTHERWISE.
- 4) ALL LAMINATED VENEER LUMBER (LVL) BEAMS, GIRDER TRUSSES, AND METAL HANGER CONNECTIONS SUPPORTING ROOF FRAMING TO BE DESIGNED & CERTIFIED BY FLOOR AND ROOF TRUSS MANUFACTURER.
- 5) JOIST HANGERS: PROVIDE APPROVED METAL HANGERS FOR ALL JOISTS AND BUILT-UP WOOD MEMBERS INTERSECTING WITH FLUSH BUILT-UP WOOD MEMBERS.
- 6) WOOD FRAMING NOT TREATED WITH A WOOD PRESERVATIVE, IN CONTACT WITH CONCRETE, SHALL BE SEPARATED FROM THE CONC. BY AT LEAST 2" OF POLYETHYLENE FILM, No.50 (45lbs) HOLL ROOFING OR OTHER DAMPPROOFING MATERIAL, EXCEPT WHERE THE WOOD MEMBER IS AT LEAST 16" (152) ABOVE THE GROUND.

SA SMOKE ALARM (9.10.19)
CD CARBON MONOXIDE ALARM (9.33.4)
CLASS B' VENT
DUPLUX OUTLET (12" HIGH)
HEAVY DUTY OUTLET
POT LIGHT
LIGHT FIXTURE (PULL CHAIN)
CABLE T.V. JACK
CENTRAL VACUUM OUTLET

- SA SMOKE ALARM (9.10.19)
- CD CARBON MONOXIDE ALARM (9.33.4)
- ** CHECK LOCAL BY-LAWS FOR REQUIREMENTS ** A CARBON MONOXIDE ALARM(S) CONFORMING TO CAN/CGA-6.19 SHALL BE INSTALLED ON OR NEAR THE CEILING IN EACH DWELLING UNIT ADJACENT TO EACH SLEEPING AREA. CARBON MONOXIDE ALARM(S) SHALL BE PERMANENTLY WIRED WITH NO DISCONNECT SWITCH, WITH AN ALARM THAT IS AUDIBLE WITHIN SLEEPING ROOMS WHEN THE INTERVENING DOORS ARE CLOSED.
- SB SOLID BEARING (BUILT-UP WOOD COLUMNS AND STUD POSTS)
- THE WIDTH OF A WOOD COLUMN SHALL NOT BE LESS THAN THE WIDTH OF SUPPORTED MEMBER. BUILT-UP WOOD COLUMNS SHALL BE NAILED TOGETHER WITH NOT LESS THAN 3" (76) NAILS SPACED NOT MORE THAN 11 3/4" (300) O.C. THE NUMBER OF STUDS IN A WALL DIRECTLY BELOW A GIRDER TRUSS OR ROOF BEAM SHALL CONFORM TO TABLES A-34 TO A-37. (9.17.4, 9.23.10.7.)
- TWO STOREY VOLUME SPACE. SEE CONSTRUCTION NOTE 39.
- VARYING PLATES, BUILT-OUT FLOORS, BEARING WALLS, ICE & WATER SHIELD
- EXPOSED BUILDING FACE -O.B.C. 9.10.14, OR 9.10.15. REFER TO HEX NOTE 35. & DETAILS FOR TYPE AND SPECIFICATIONS.
- 1 HR. PARTY WALL REFER TO HEX NOTE 40.
- 2 HR. FIREWALL REFER TO HEX NOTE 40A.

- CMD CARBON MONOXIDE ALARM (9.33.4)
- ** CHECK LOCAL BY-LAWS FOR REQUIREMENTS ** A CARBON MONOXIDE ALARM(S) CONFORMING TO CAN/CGA-6.19 SHALL BE INSTALLED ON OR NEAR THE CEILING IN EACH DWELLING UNIT ADJACENT TO EACH SLEEPING AREA. CARBON MONOXIDE ALARM(S) SHALL BE PERMANENTLY WIRED WITH NO DISCONNECT SWITCH, WITH AN ALARM THAT IS AUDIBLE WITHIN SLEEPING ROOMS WHEN THE INTERVENING DOORS ARE CLOSED.
- SB SOLID BEARING (BUILT-UP WOOD COLUMNS AND STUD POSTS)
- THE WIDTH OF A WOOD COLUMN SHALL NOT BE LESS THAN THE WIDTH OF SUPPORTED MEMBER. BUILT-UP WOOD COLUMNS SHALL BE NAILED TOGETHER WITH NOT LESS THAN 3" (76) NAILS SPACED NOT MORE THAN 11 3/4" (300) O.C. THE NUMBER OF STUDS IN A WALL DIRECTLY BELOW A GIRDER TRUSS OR ROOF BEAM SHALL CONFORM TO TABLES A-34 TO A-37. (9.17.4, 9.23.10.7.)
- TWO STOREY VOLUME SPACE. SEE CONSTRUCTION NOTE 39.
- VARYING PLATES, BUILT-OUT FLOORS, BEARING WALLS, ICE & WATER SHIELD
- EXPOSED BUILDING FACE -O.B.C. 9.10.14, OR 9.10.15. REFER TO HEX NOTE 35. & DETAILS FOR TYPE AND SPECIFICATIONS.
- 1 HR. PARTY WALL REFER TO HEX NOTE 40.
- 2 HR. FIREWALL REFER TO HEX NOTE 40A.

SECTION 4.0. CLIMATIC DATA

- DESIGN SNOW LOAD (9.4.2.2.): 1.23 kPa
- WIND LOAD (q50) (SB-1.2.): 0.44 kPa

STAMP

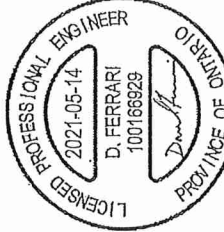

FOR STRUCTURAL ONLY
NOT INCLUDING ENGINEERED
FLOOR OR ROOF SYSTEM

CONTRACTOR MUST VERIFY ALL DIMENSIONS ON THE JOB. REPORT ANY DISCREPANCIES TO HUNT DESIGN ASSOCIATES INC. (H.D.A.) BEFORE PROCEEDING WITH THE WORK. ALL THE DRAWINGS & SPECIFICATIONS ARE THE INSTRUMENTS OF SERVICE AND ARE THE PROPERTY OF H.D.A. ALL CONSTRUCTION ARE TO ADHERE TO THESE PLANS AND SPECIFICATIONS AND TO CONFORM TO THE ONTARIO BUILDING CODE AND ALL OTHER APPLICABLE CODES AND AUTHORITIES HAVING JURISDICTION. THESE REQUIREMENTS ARE TO BE TAKEN AS MINIMUM SPECIFICATIONS. ONT. REG. 33212.

CONSTRUCTION NOTE REVISION DATE: MAY 9, 2019

CONSTRUCTION NOTES 2


FIRE RATINGS - PARTY WALL TRUSS SPACE (OBC REF. - SB-2.3)		
COMPONENT	FIRE RATING	CODE REFERENCE
5/8" (15.9mm) TYPE X GYPSUM WALL BOARD	40 min.	OBC, SB-2.3.4.2 (TABLE 2.3.4.A)
WOOD TRUSSES	NO RATING ASSIGNED	
5/8" (15.9mm) TYPE X GYPSUM WALL BOARD	40 min.	OBC, SB-2.3.4.2 (TABLE 2.3.4.A)
TOTAL FIRE RATING	80 min.	OBC, SB-2.3.4.1(i)

FIRE & SOUND RATINGS - PARTY WALL		
WALL TYPE	CODE REFERENCE	RATING
MBC	OBC, SB-3	54 STC 10 IIR, FRR

FILL ANY VOID TO UNDERSIDE OF ROOF DECK AND TOP OF WALL WITH MINERAL WOOL

WHEN ROOF JOISTS SPACING EXCEEDS 24" O.C. PROVIDE H-CLIPS @ 12" O.C.

TYPICAL ROOF & EAVES CONSTRUCTION

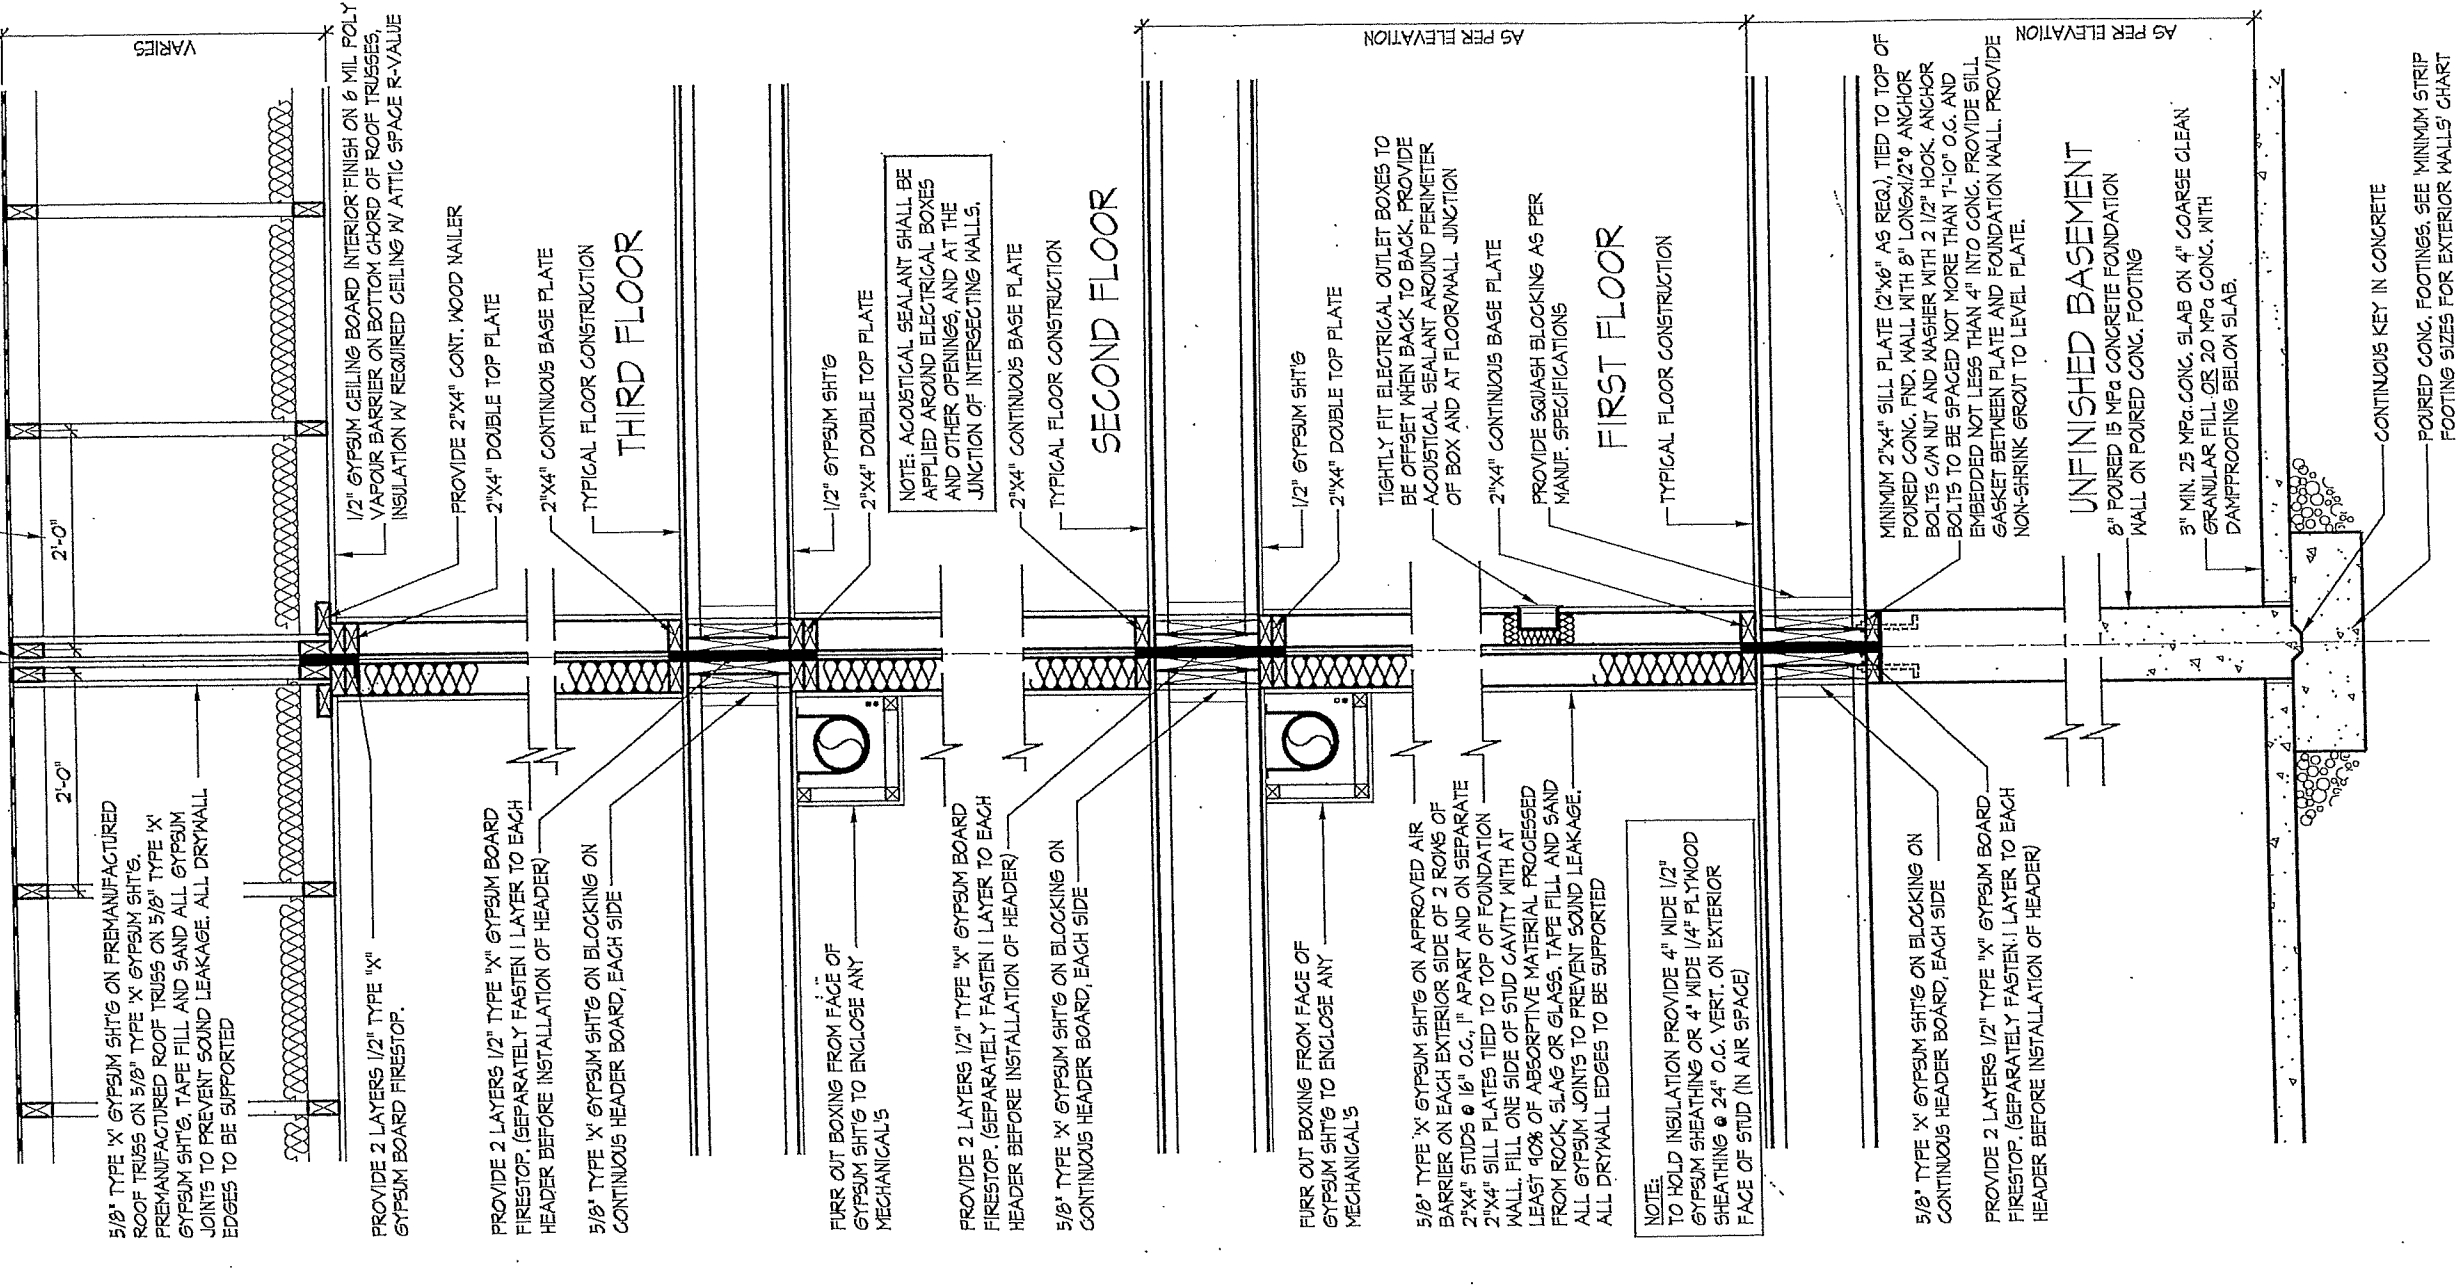

NOTE: POURED CONC. FOOTING ON NATURAL UNDISTURBED SOIL OF 15KPa OR COMPACTED ENGINEERED FILL WITH MIN. BEARING CAPACITY OF 150KPa. FOOTING SIZE SHOWN FOR 16'-0" (4.9m) MAXIMUM JOIST SPAN ONLY. JOIST SPAN EXCEEDING 16'-0" (4.9m) SHALL BE ENGINEERED. IF SOIL BEARING DOES NOT MEET MINIMUM CAPACITY, ENGINEERED FOOTINGS ARE REQUIRED. ACTUAL SOIL BEARING CAPACITY TO BE VERIFIED WITH SOIL ENGINEERING REPORT.

MINIMUM STRIP FOOTING SIZES (4153)			
NUMBER FLOORS SUPPORTED	SUPPORTING INT. LOAD BEARING MASONRY WALL	SUPPORTING EXTERIOR PARTY WALL	SUPPORTING PARTIAL WALL
1	16" W x 8" D	16" W x 8" D	16" W x 8" D
2	24" W x 8" D	20" W x 8" D	24" W x 8" D
3	36" W x 14" D	26" W x 14" D	36" W x 14" D

NOTE: FOOTING SIZE SUBJECT TO CERTIFICATION BY A SOIL CONSULTANT

02 TYPICAL 1 HR PARTY WALL SECTION, PARALLEL ROOF TRUSSES, 2"X4" DOUBLE STUDS - 3 STOREY

1/2" = 1'-0"

SB-12 EN

PRESCRIPTIVE COMP

PAC

BUILDING COMPONENT

INSULATION/STUDS

CEILING W/ ATTIC SP.

CEILING W/O ATTIC S

EXPOSED FLOOR

WALLS ABOVE GRAD

BASEMENT WALLS

* PROPOSED VALUES

BELOW GRADE SLAB

EDGE OF BELOW GR

HEATED SLAB OR SL

WINDOVS/DOORS

WINDOWS/SLIDING C

SKYLIGHTS (MAX. U-I

APPLIANCE EFFICIEN

SPACE HEATING EQ

HRV EFFICIENCY (%)

DHW HEATER (EF)

AREA CALCULATIONS

GROUND FLOOR AREA

MAIN FLOOR AREA

THIRD FLOOR AREA

SUBTOTAL

DEDUCT ALL OPEN AREAS

TOTAL NET AREA

COVERAGE

W/O UT PORCH

COVERAGE

W/ PORCH

WINDOW / WALL AREA



CALCULATIONS

GROSS WALL AREA

GROSS WINDOW AREA

(INCL. GLASS DOORS & SKYLIGHTS)

TOTAL WINDOW %

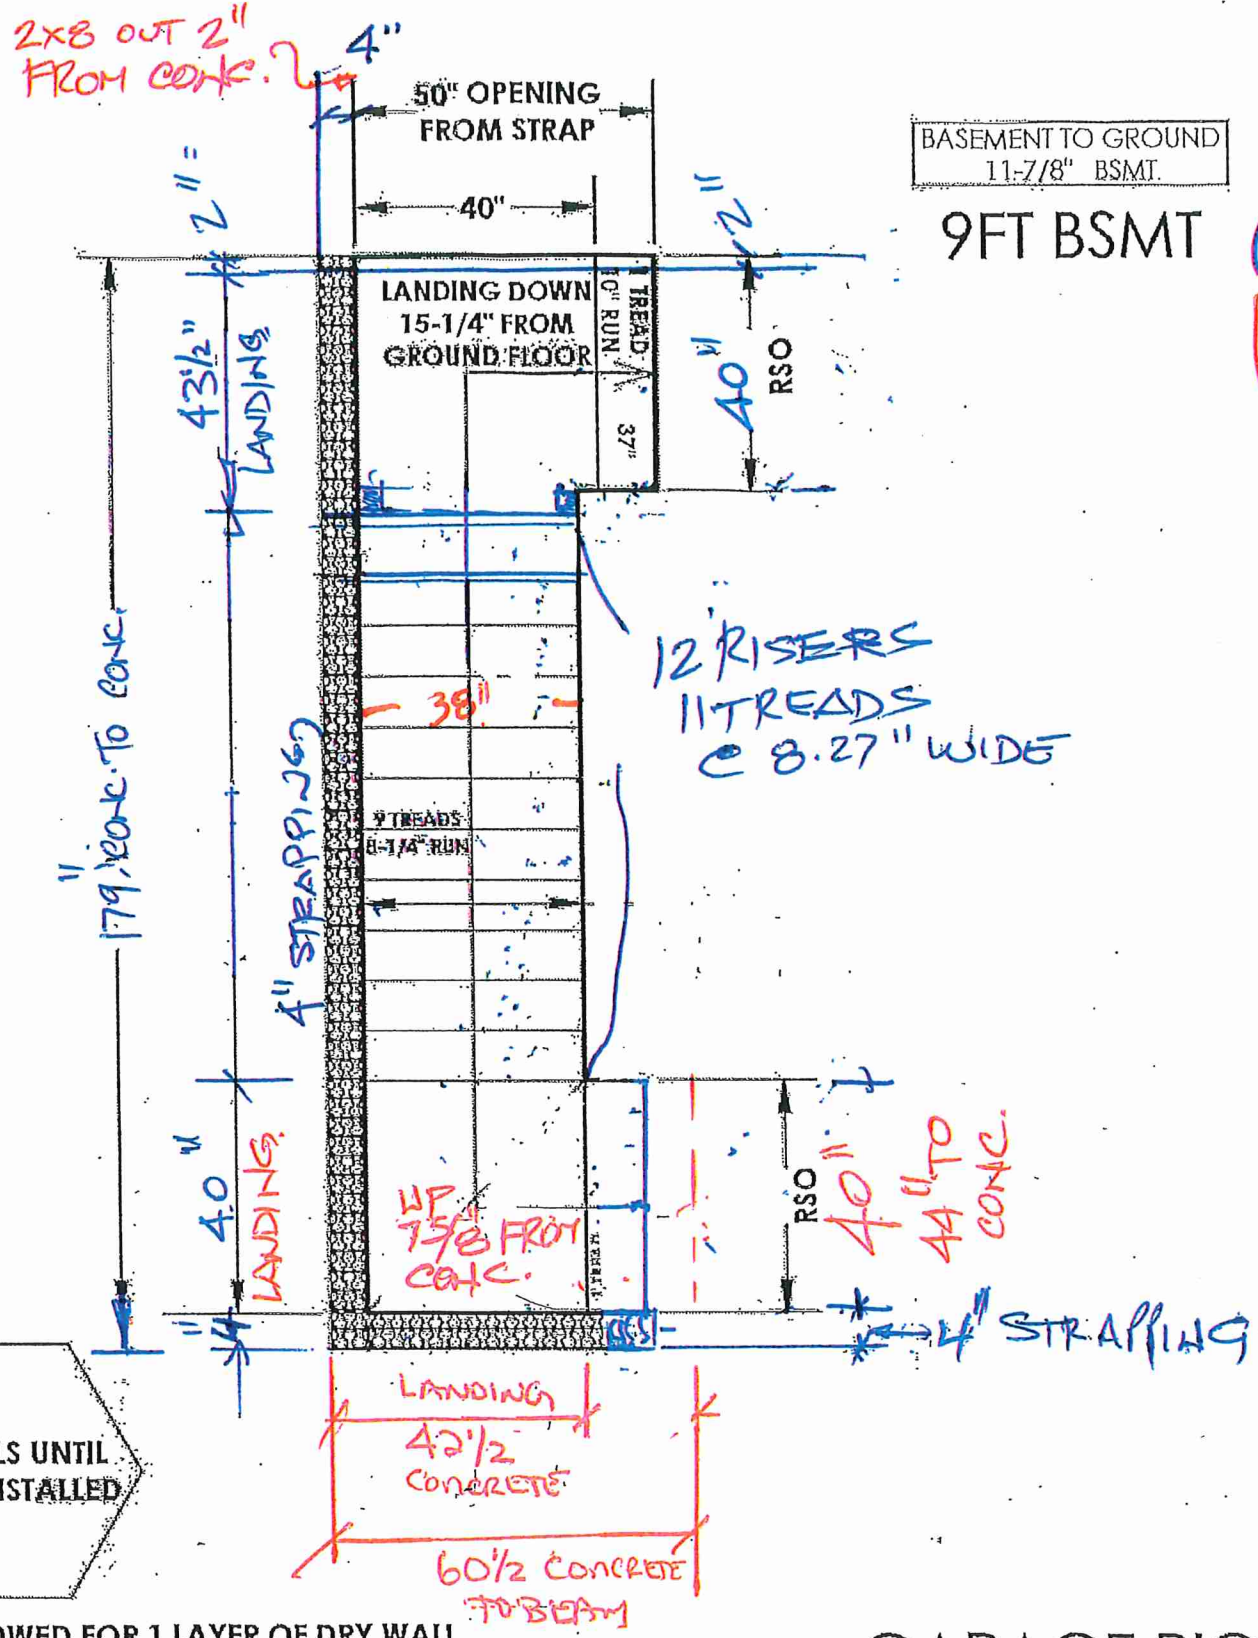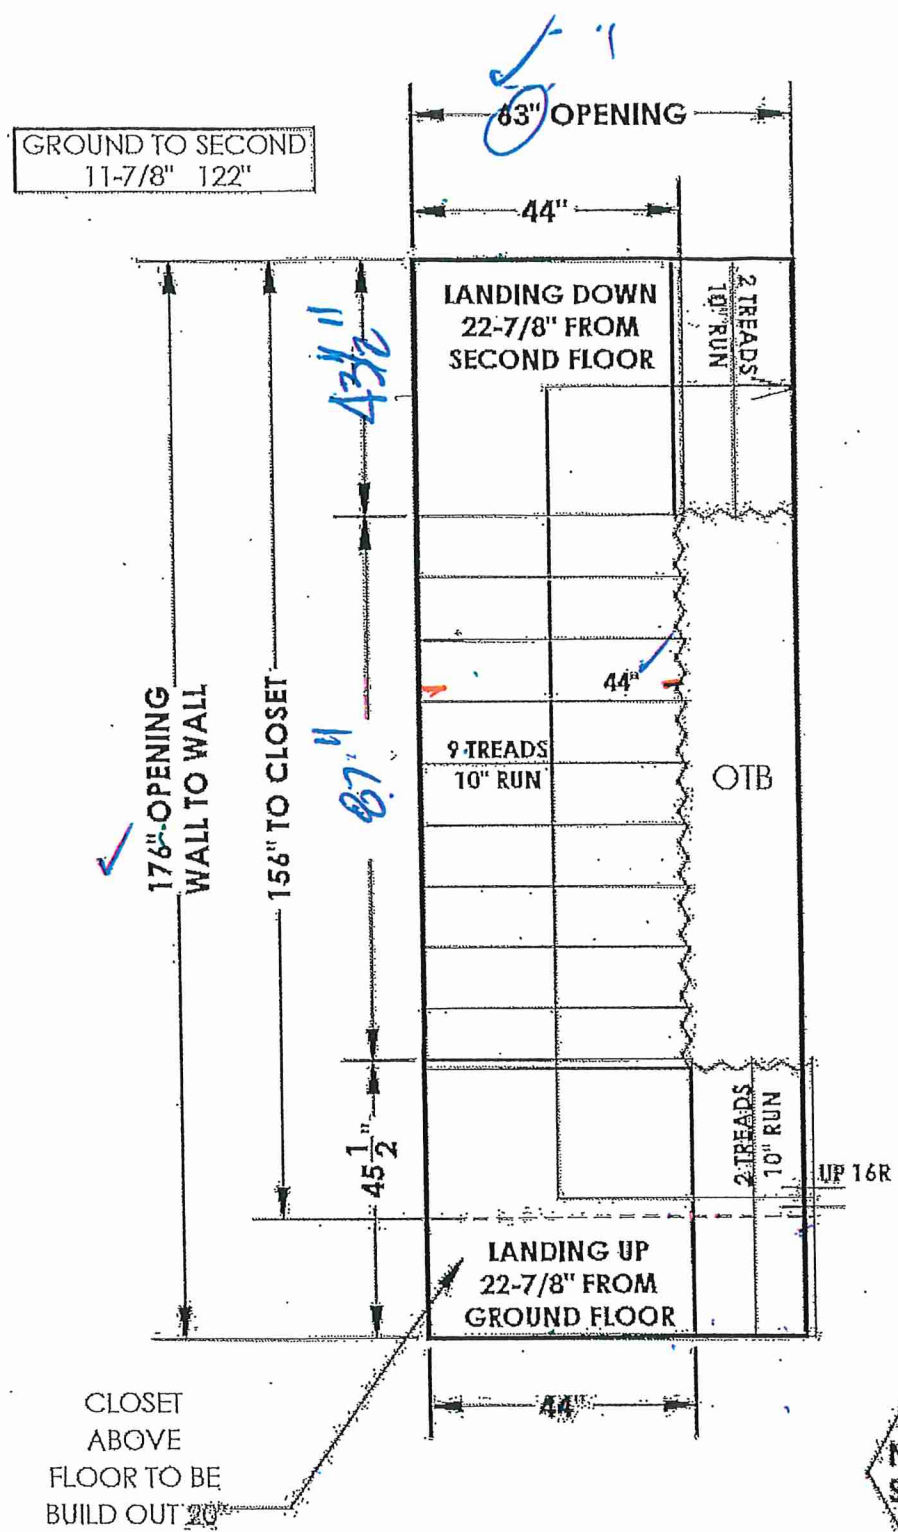


ROYAL
PINE
COPY

PX 235-68

ALL OPENINGS ARE ALLOWED FOR 1 LAYER OF DRY WALL
ANY ADDITIONAL LAYERS MUST BE ALLOWED BY CARPENTERS

GARAGE RIGHT >

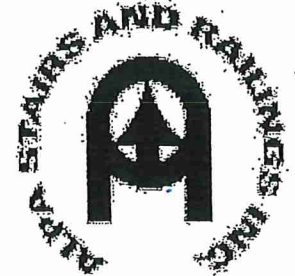 Alpha Stairs and Railings Inc. Building To Step Up To	ALL LANDINGS TO BE SUPPLIED AND SUPPORTED BY OTHERS UNLESS SPECIFIED ABOVE ANY STRAPPING ALLOWANCES TO BE COMPENSATED BY CARPENTERS ALL STAIR DIMENSIONS MAY BE MODIFIED FROM ORIGINAL BLUE PRINTS OR SPECS AS SUPPLIED TO ALPA STAIRS AND RAILINGS INC. MEASUREMENTS SHOWN ON LAYOUTS ARE REQUIRED TO INSTALL OUR STAIRS. ANY PROBLEM WITH HEADROOM OR STRAPPING ALLOWANCES, ALPA STAIRS AND RAILINGS INC. WILL NOT BE RESPONSIBLE. STAIR LAYOUTS SHOULD BE CHECKED BY CARPENTERS OR SITE SUPERS TO MAKE SURE THERE ARE NO DISCREPANCIES BEFORE PROCEEDING WITH CONSTRUCTION		SITE OAKRIDGE MEADOWS RICHMOND HILL		DRAWN BY DHARAV	NAME DHARAV	DATE JULY 07 2021
	ALPA STAIRS AND RAILINGS INC. 3770 NASHUA DRIVE, UNIT 3 MISSISSAUGA, ONTARIO L4V 1M6 TEL: (905) 694-9556 www.alpastairs.com		PHASE N/A		CLIENT Royal Pine Homes		
			Model 2010		LAYOUT # DS07072020020		
					SCALE: 1:40		