






BLK 242

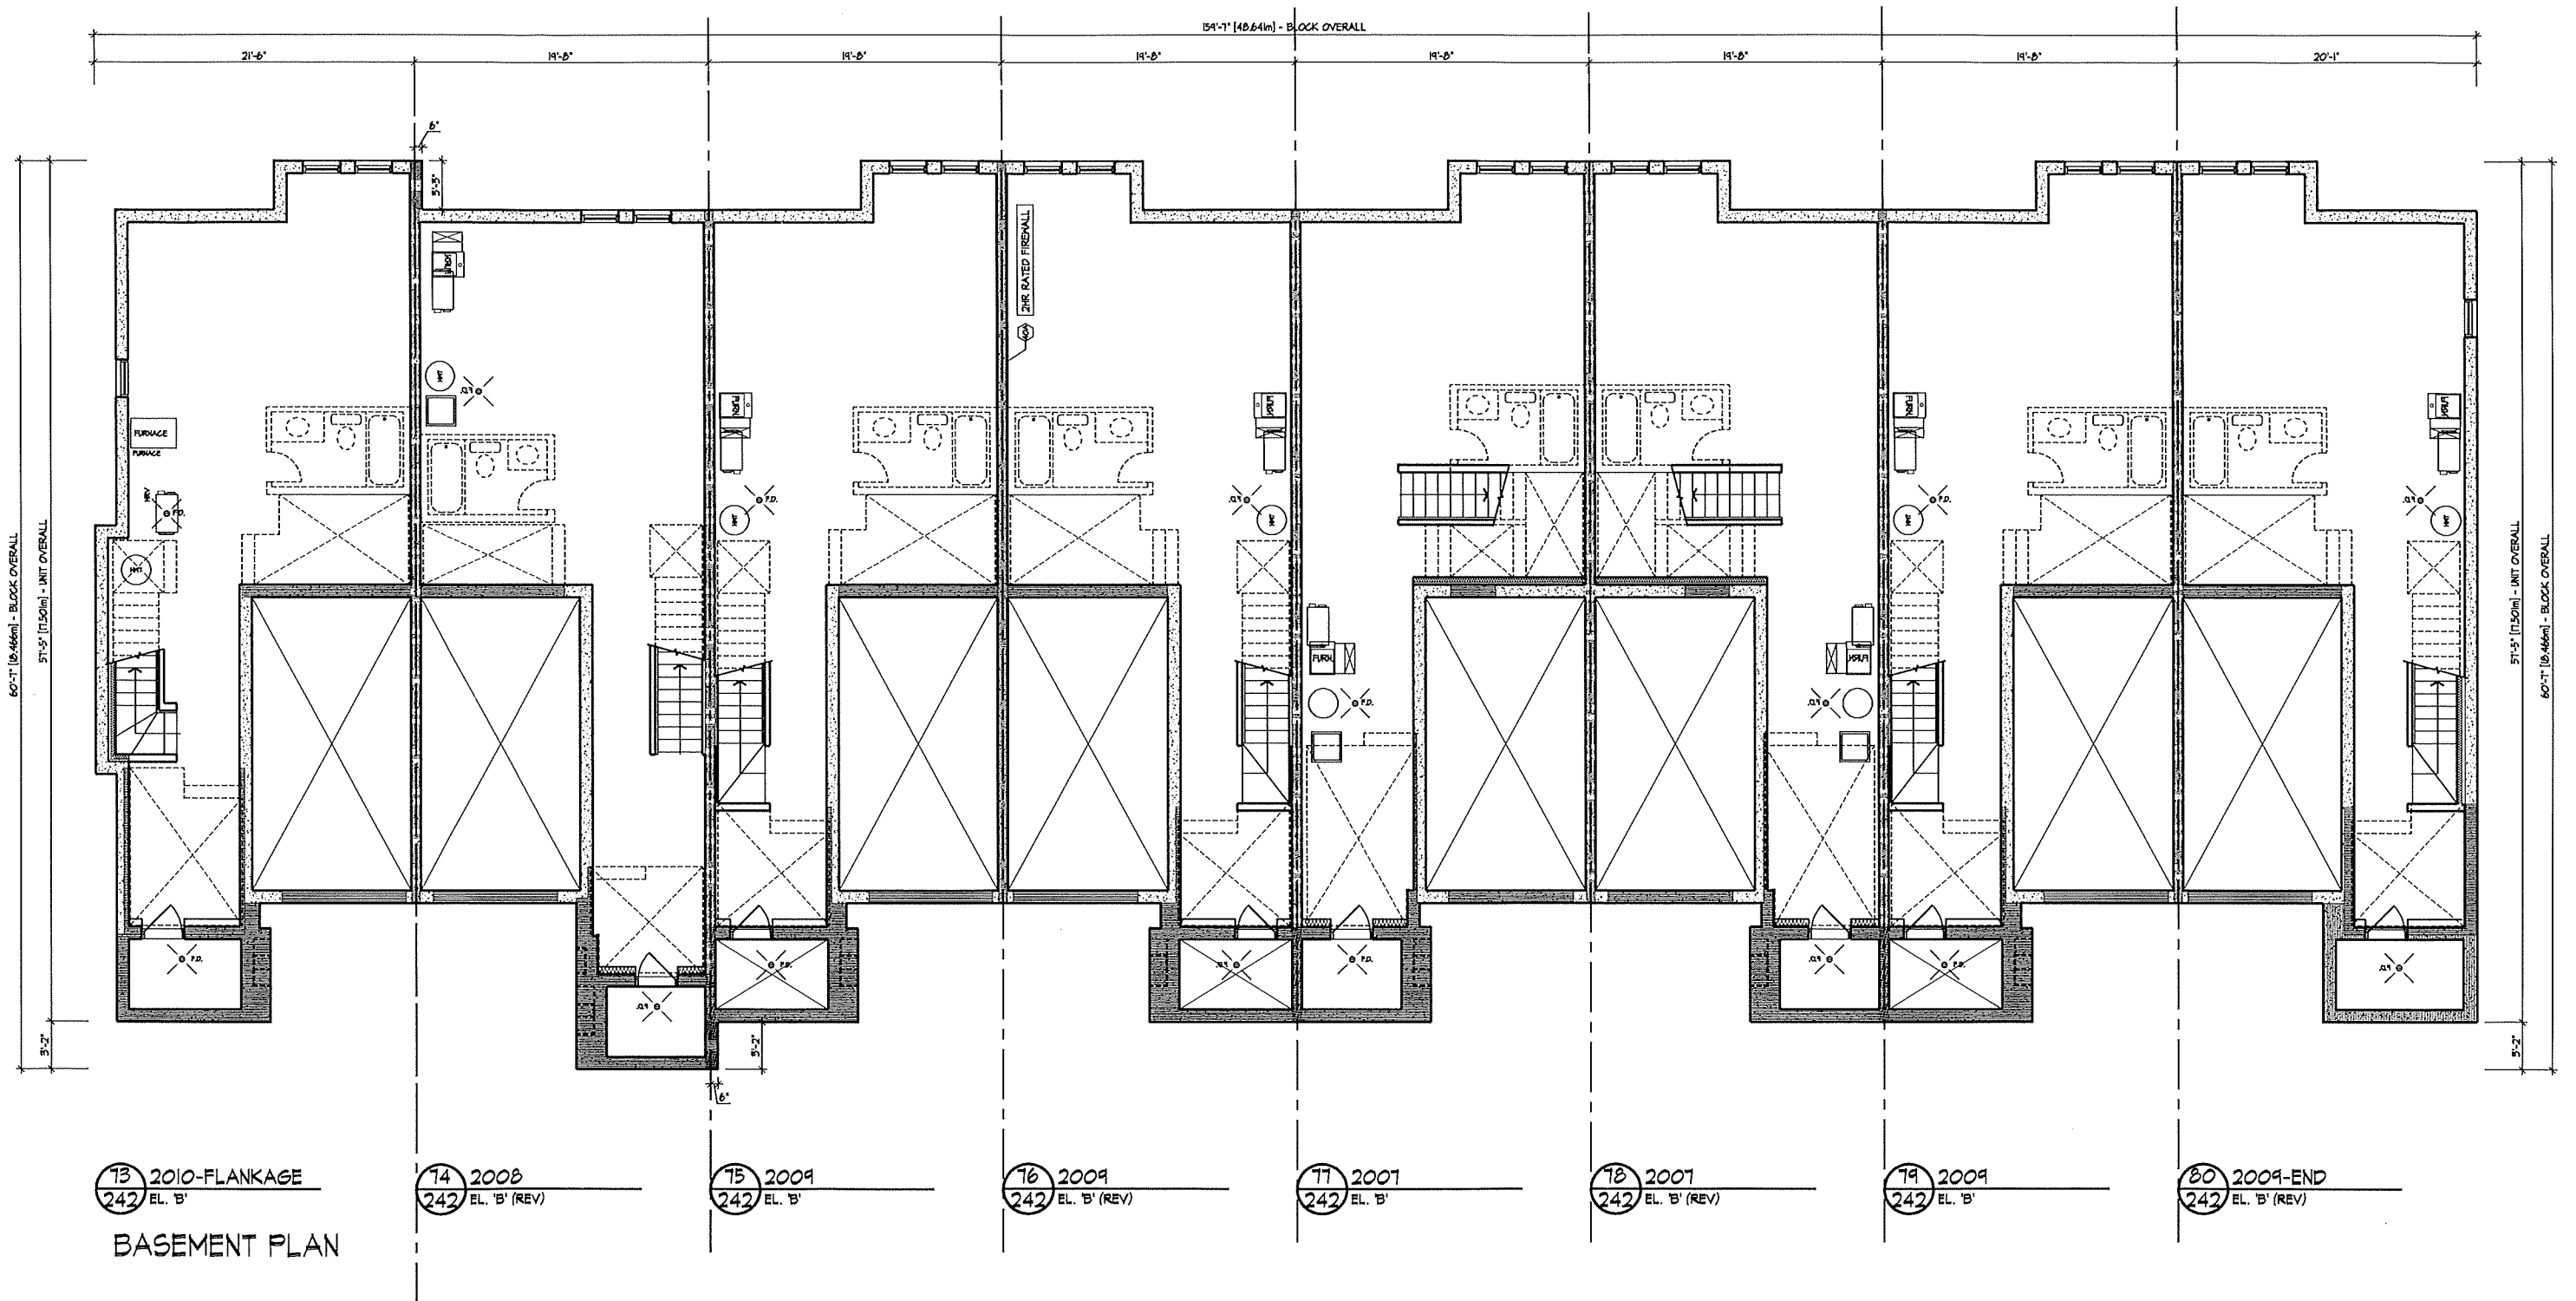

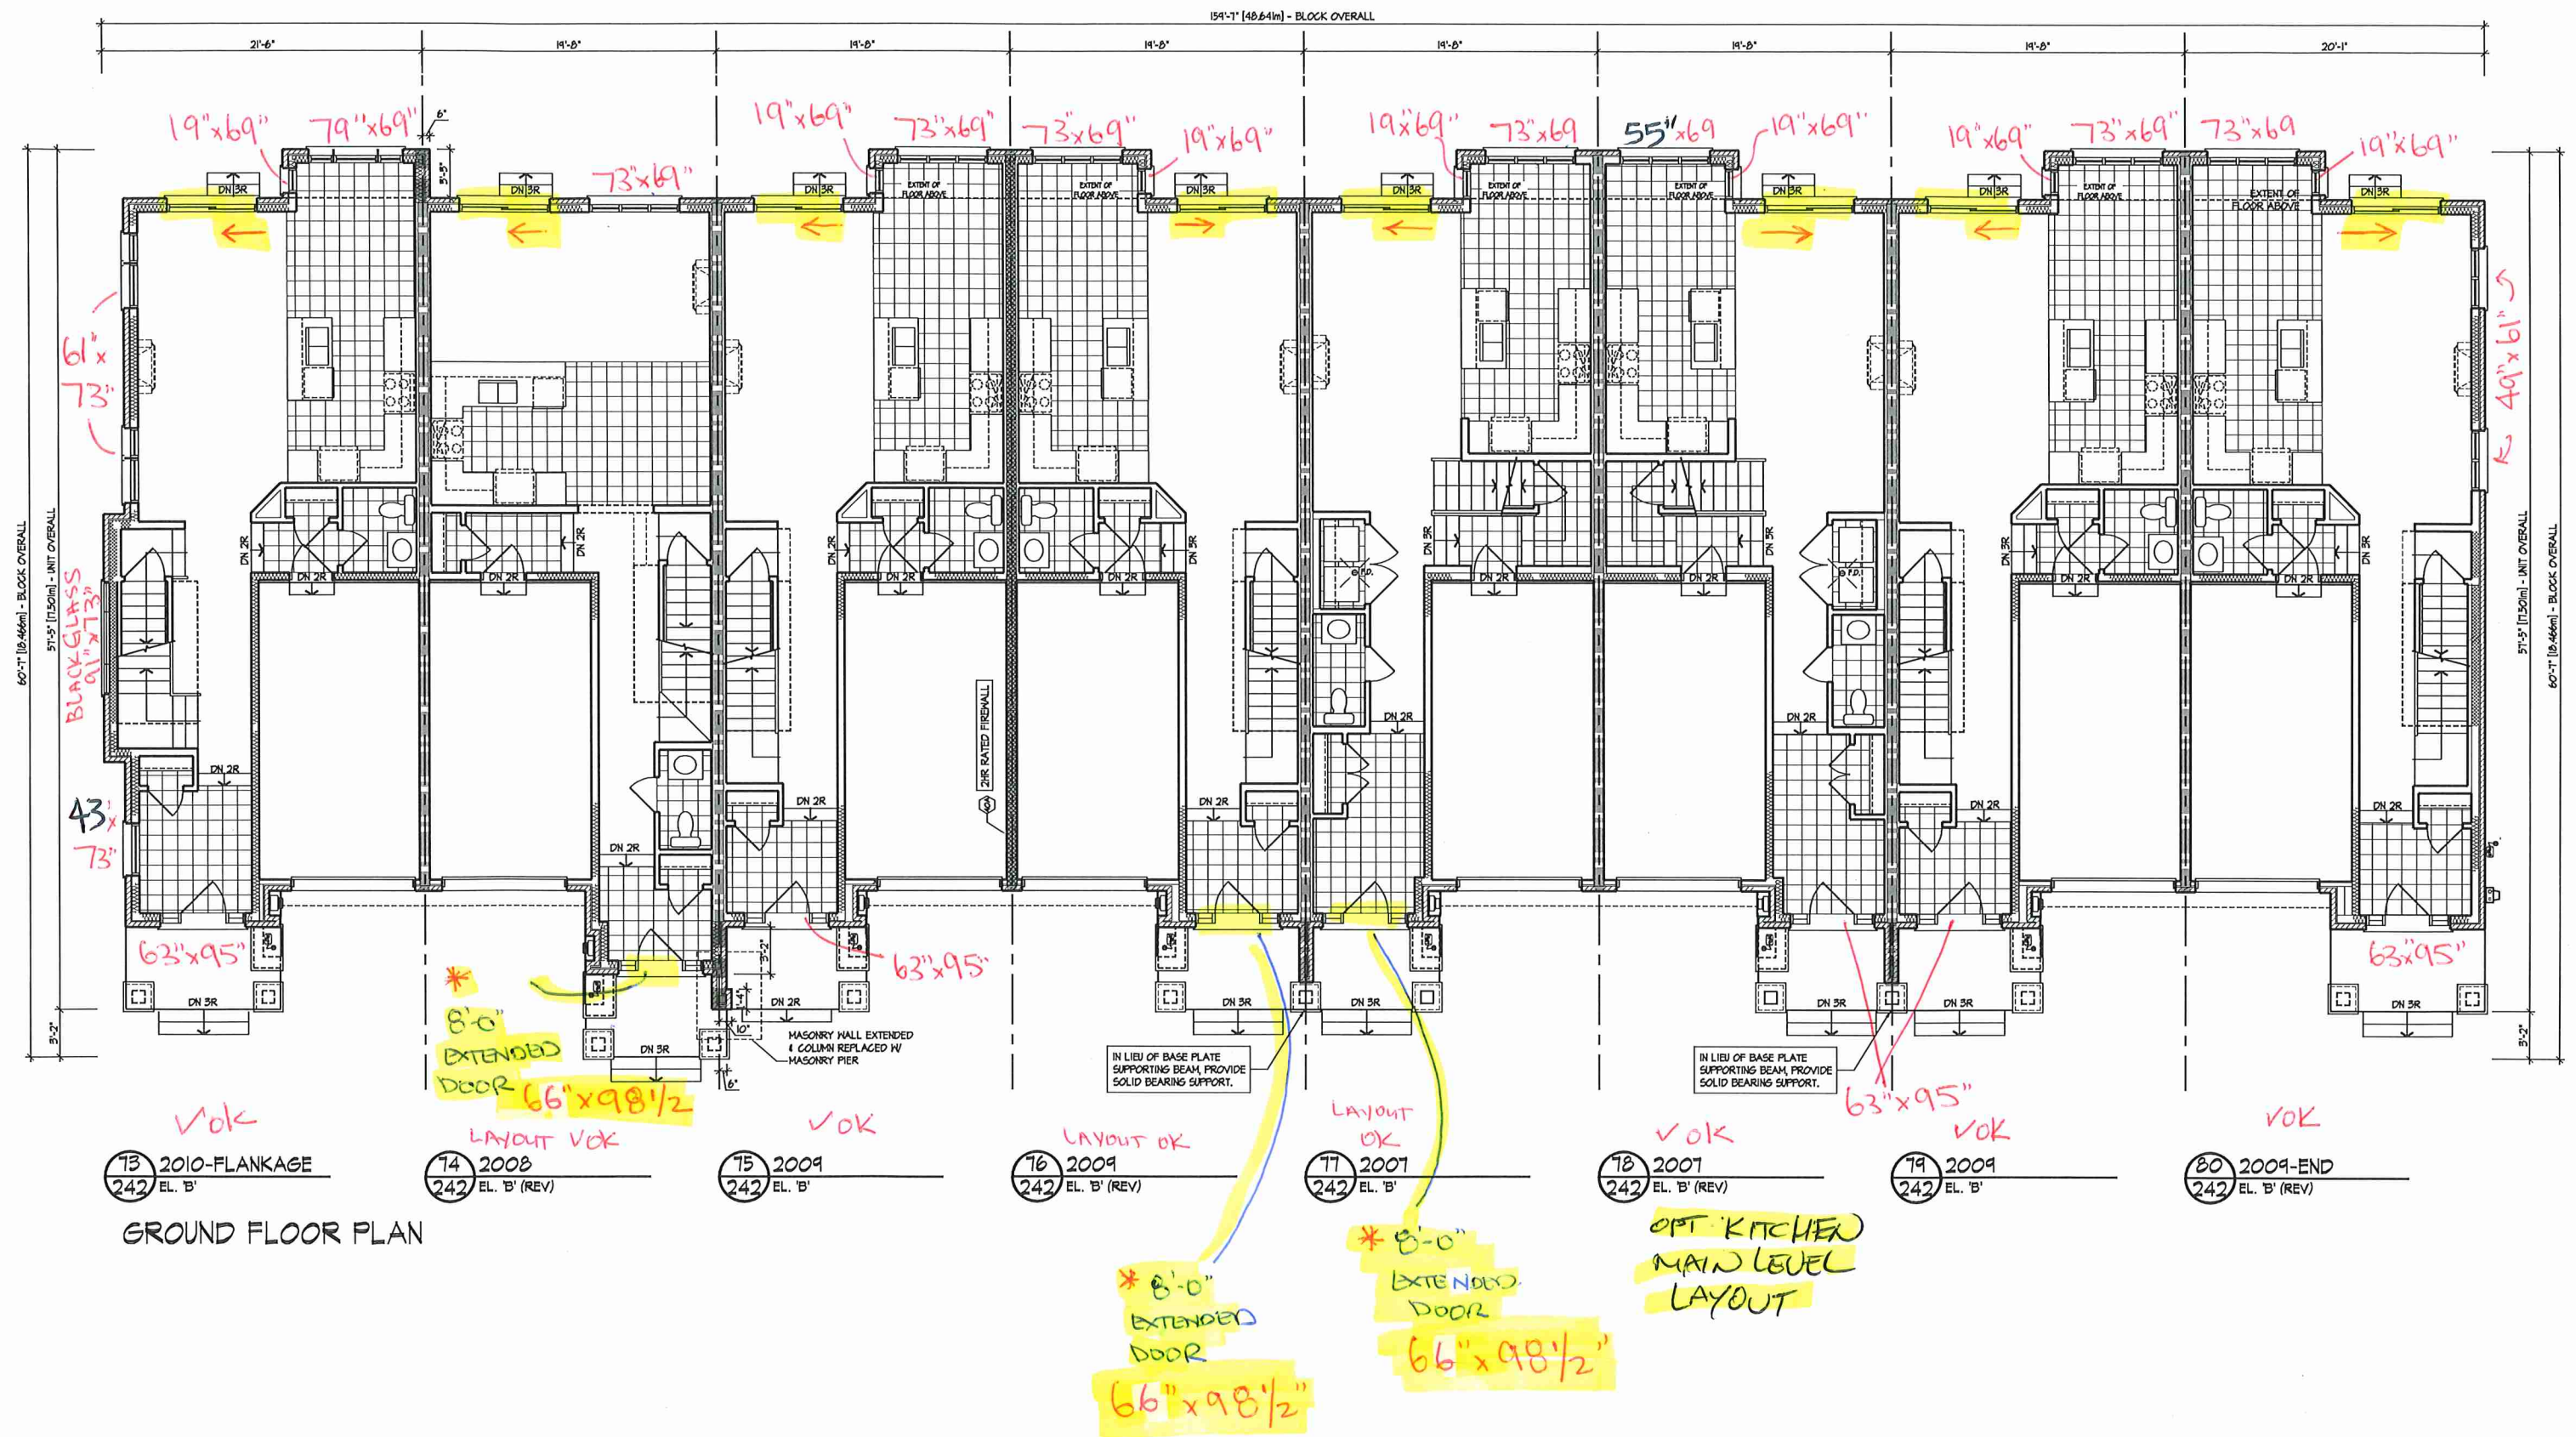

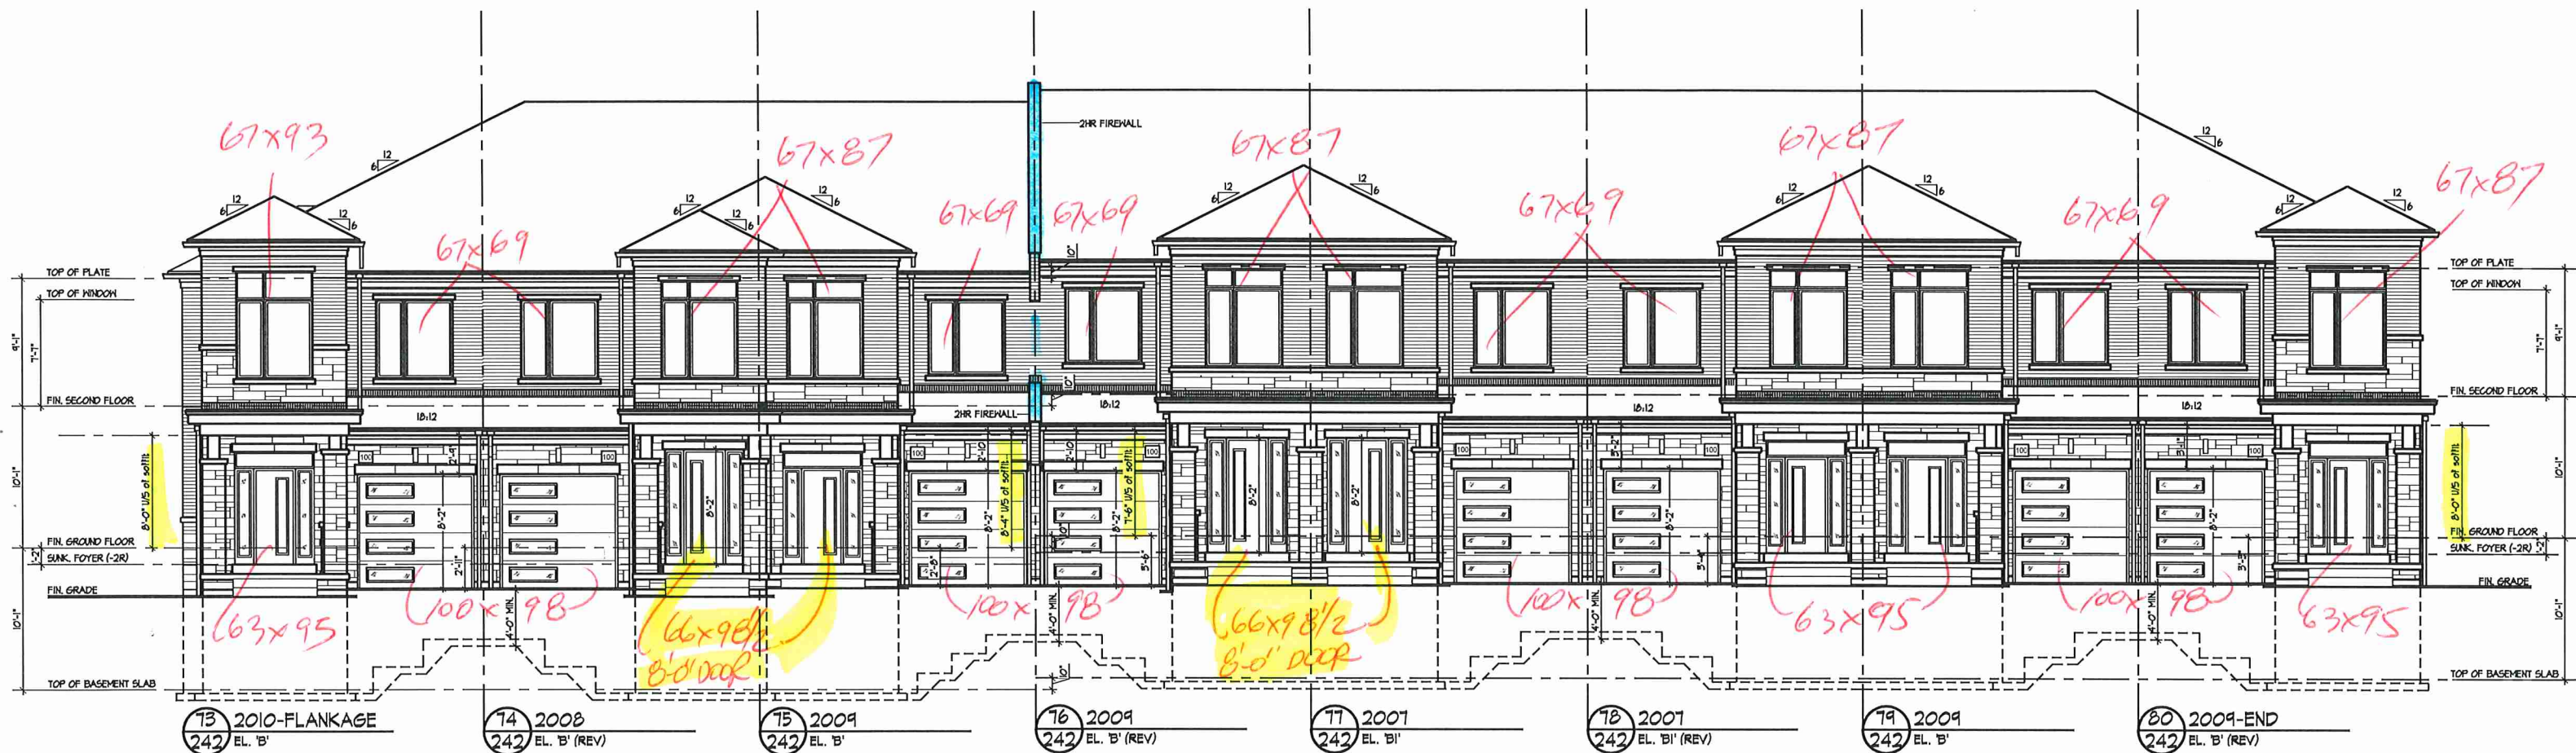



73 2010-FLANKAGE
242 EL. 'B'


FLANKAGE ELEVATION

✓OK



80 2009-END
242 EL. 'B' (REV)

RIGHT SIDE ELEVATION

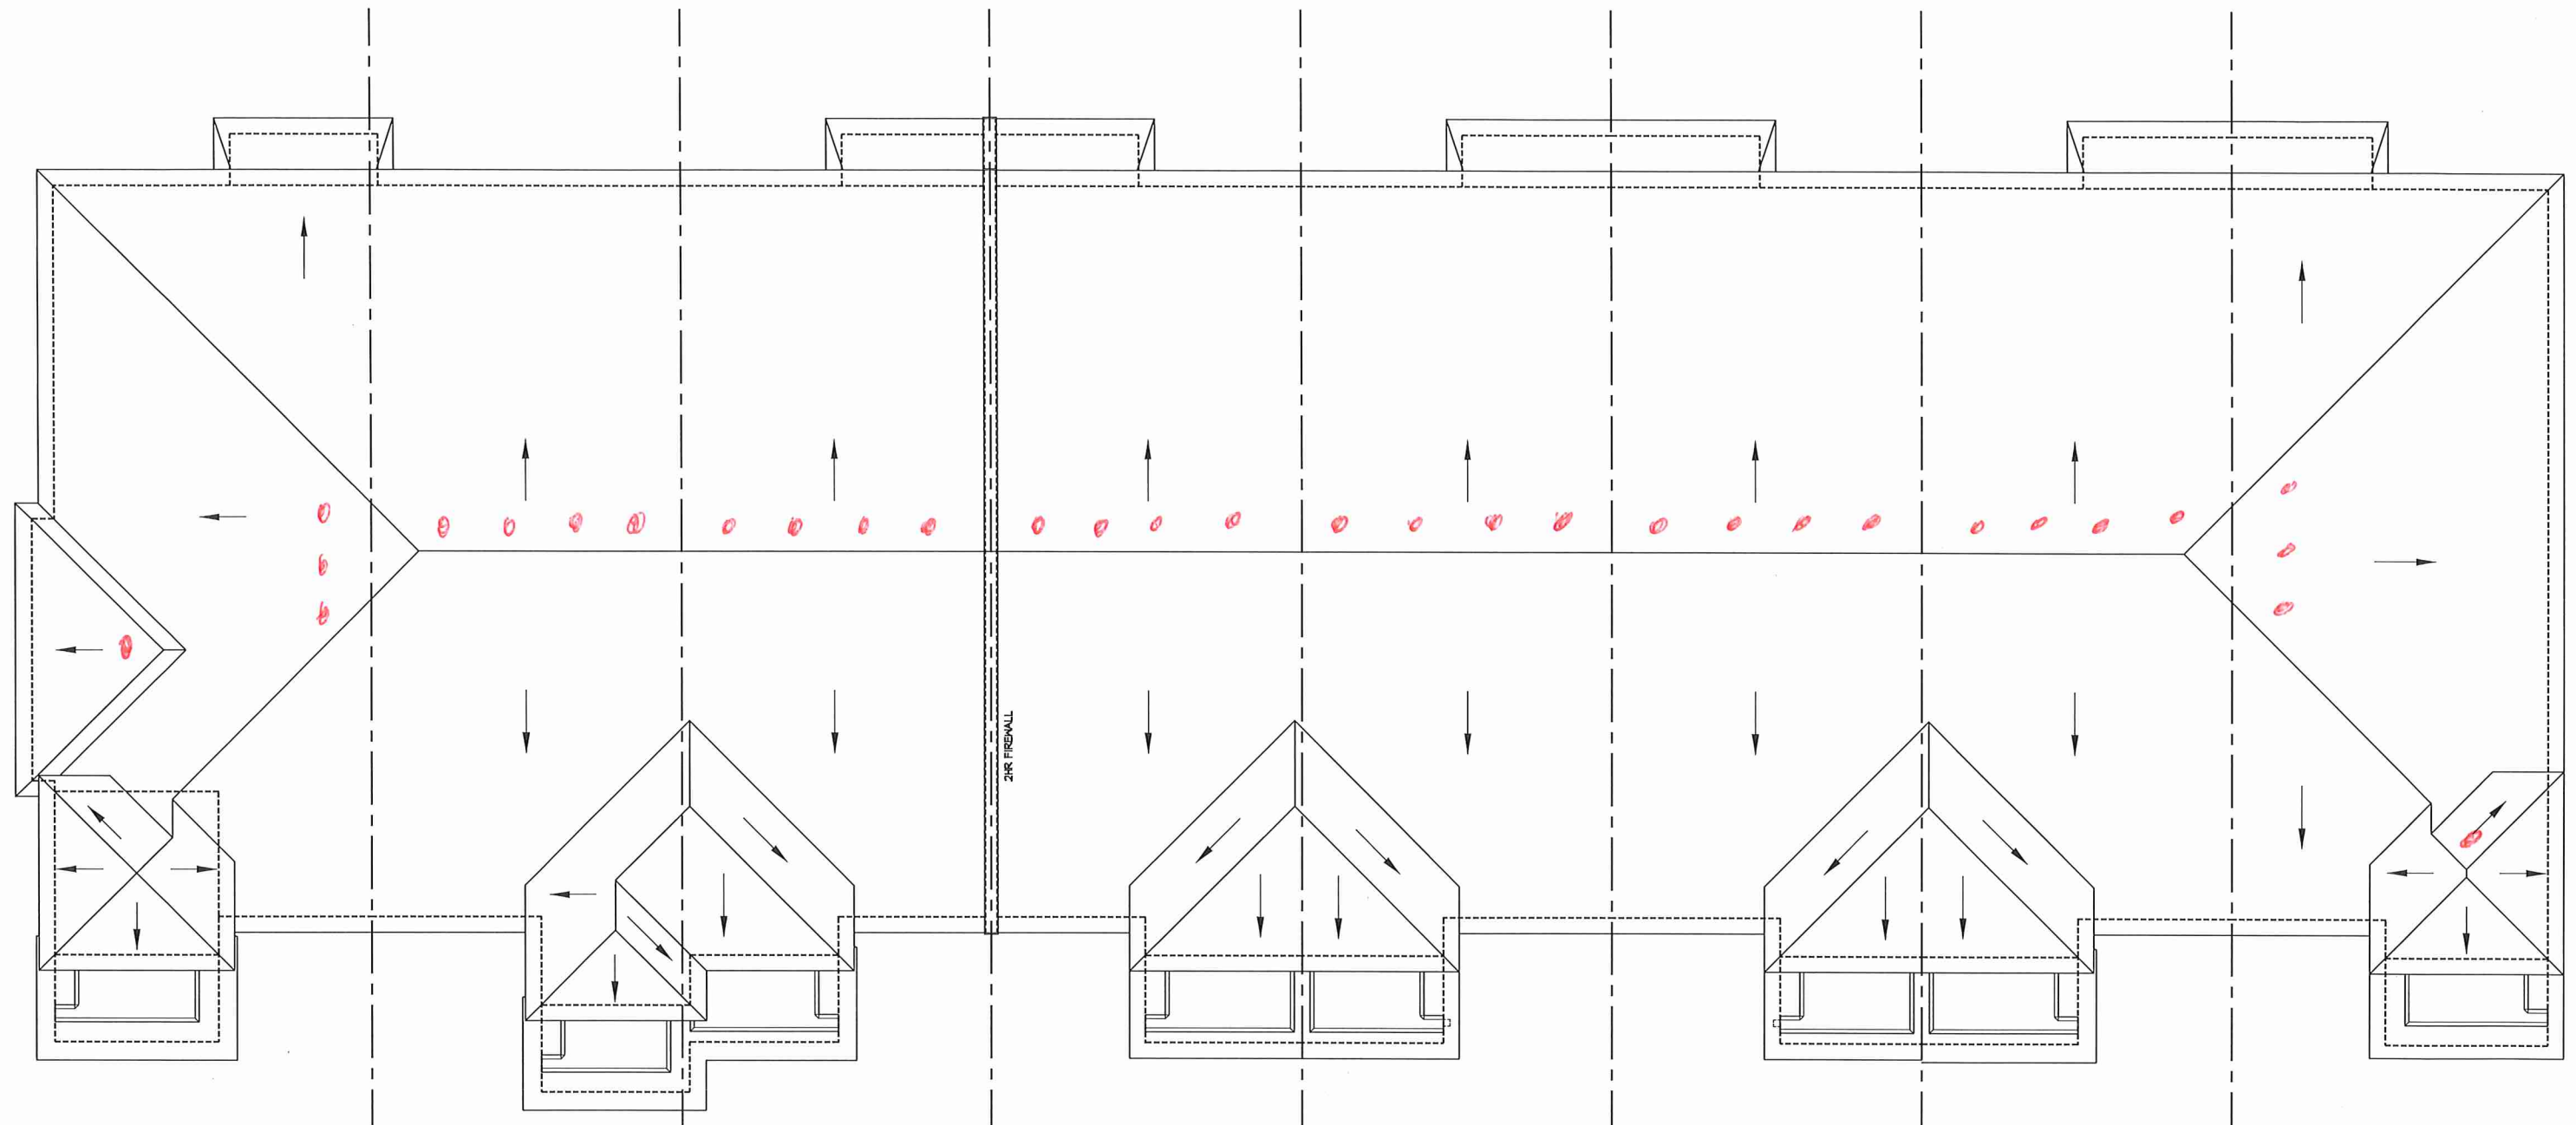

73 2010-FLANKAGE
242 EL. 'B'

74 2008
242 EL. 'B' (REV)

75 2009
242 EL. 'B'

76 2009
242 EL. 'B' (REV)

77 2007
242 EL. 'B1'

78 2007
242 EL. 'B1' (REV)

79 2009
242 EL. 'B'

80 2009-END
242 EL. 'B' (REV)

ROOF PLAN