



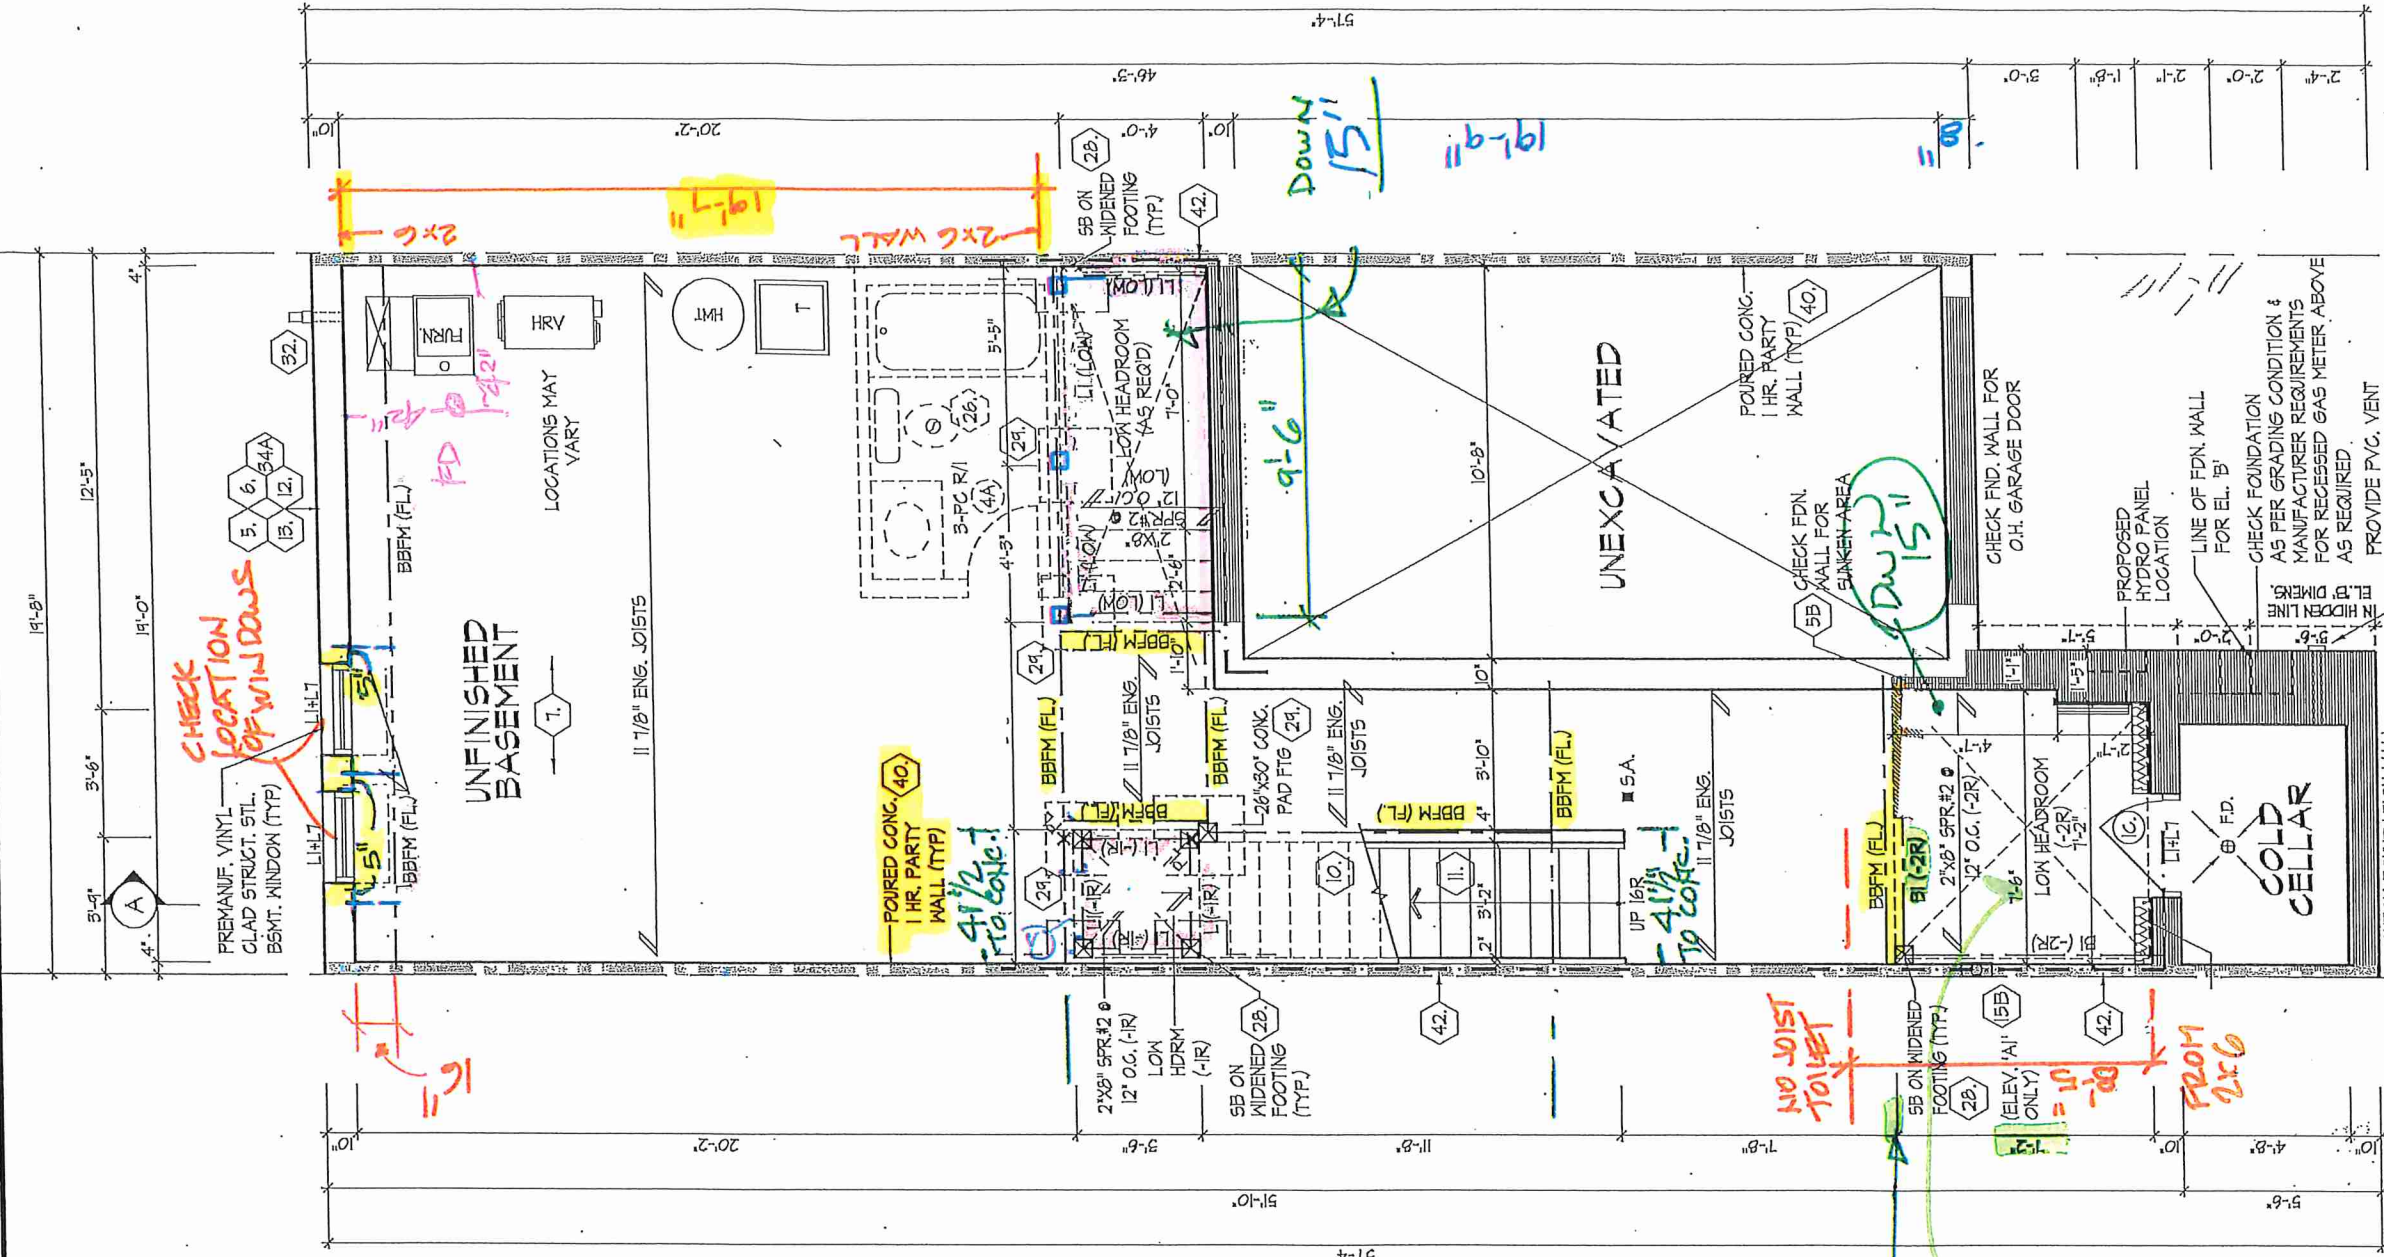

REFER TO FLOOR JOIST MANUFACTURER'S DRAWINGS FOR LAYOUT, SPACING, BLOCKING & STRAPPING REQUIREMENTS, INSTALLATION DETAILS AND HANGER SIZES, & SUBFLOOR THICKNESS	APPROX. LOCATION OF FURNACE AND HOT WATER TANK
	PROVIDE SOLID WOOD BLOCKING @ 24" O.C. FOR FIRST JOIST SPAN WHEN PARALLEL W/ EXTERIOR WALL

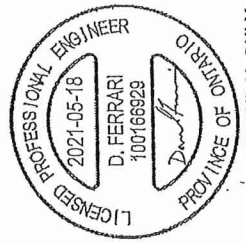

FOR STRUCTURAL ONLY
NOT INCLUDING ENGINEERED
FLOOR OR ROOF SYSTEM

BASEMENT PLAN, EL. 'A' & 'B'

BLK 242-74 PORTAL

BASEMENT PLAN, ELEV. 'A' & 'B'


ROYAL PINE HOMES - 216102
'CENTREFIELD', WEST GORMLEY, RICHMOND HILL, ON. REV. 2021.03.24

HUNT
DESIGN ASSOCIATES INC.
www.huntcdesign.ca

THE UNDERSIGNED HAS REVIEWED AND TAKES RESPONSIBILITY FOR THIS DESIGN AND HAS THE QUALIFICATIONS AND MEETS THE REQUIREMENTS SET OUT IN THE ONTARIO BUILDING CODE TO BE A DESIGNER.
QUALIFICATION INFORMATION
NAME: Derek R. Santos
REGISTRATION INFORMATION: 37308
SIGNATURE: [Signature]
BOCN: 19895

Drawn By: KM
Checked By: DS
Scale: 3/16"=1'-0"
File Number: 216102MT2008
Page Number: 2 of 14

All drawings specifications related documents and design are the copyright property of Hunt Design Associates (H.D.A.). Reproduction of this property in whole or in part is strictly prohibited without H.D.A.'s written permission (H.D.A. assumes no responsibility or liability for this property unless it bears the appropriate BCIN number and original signature).

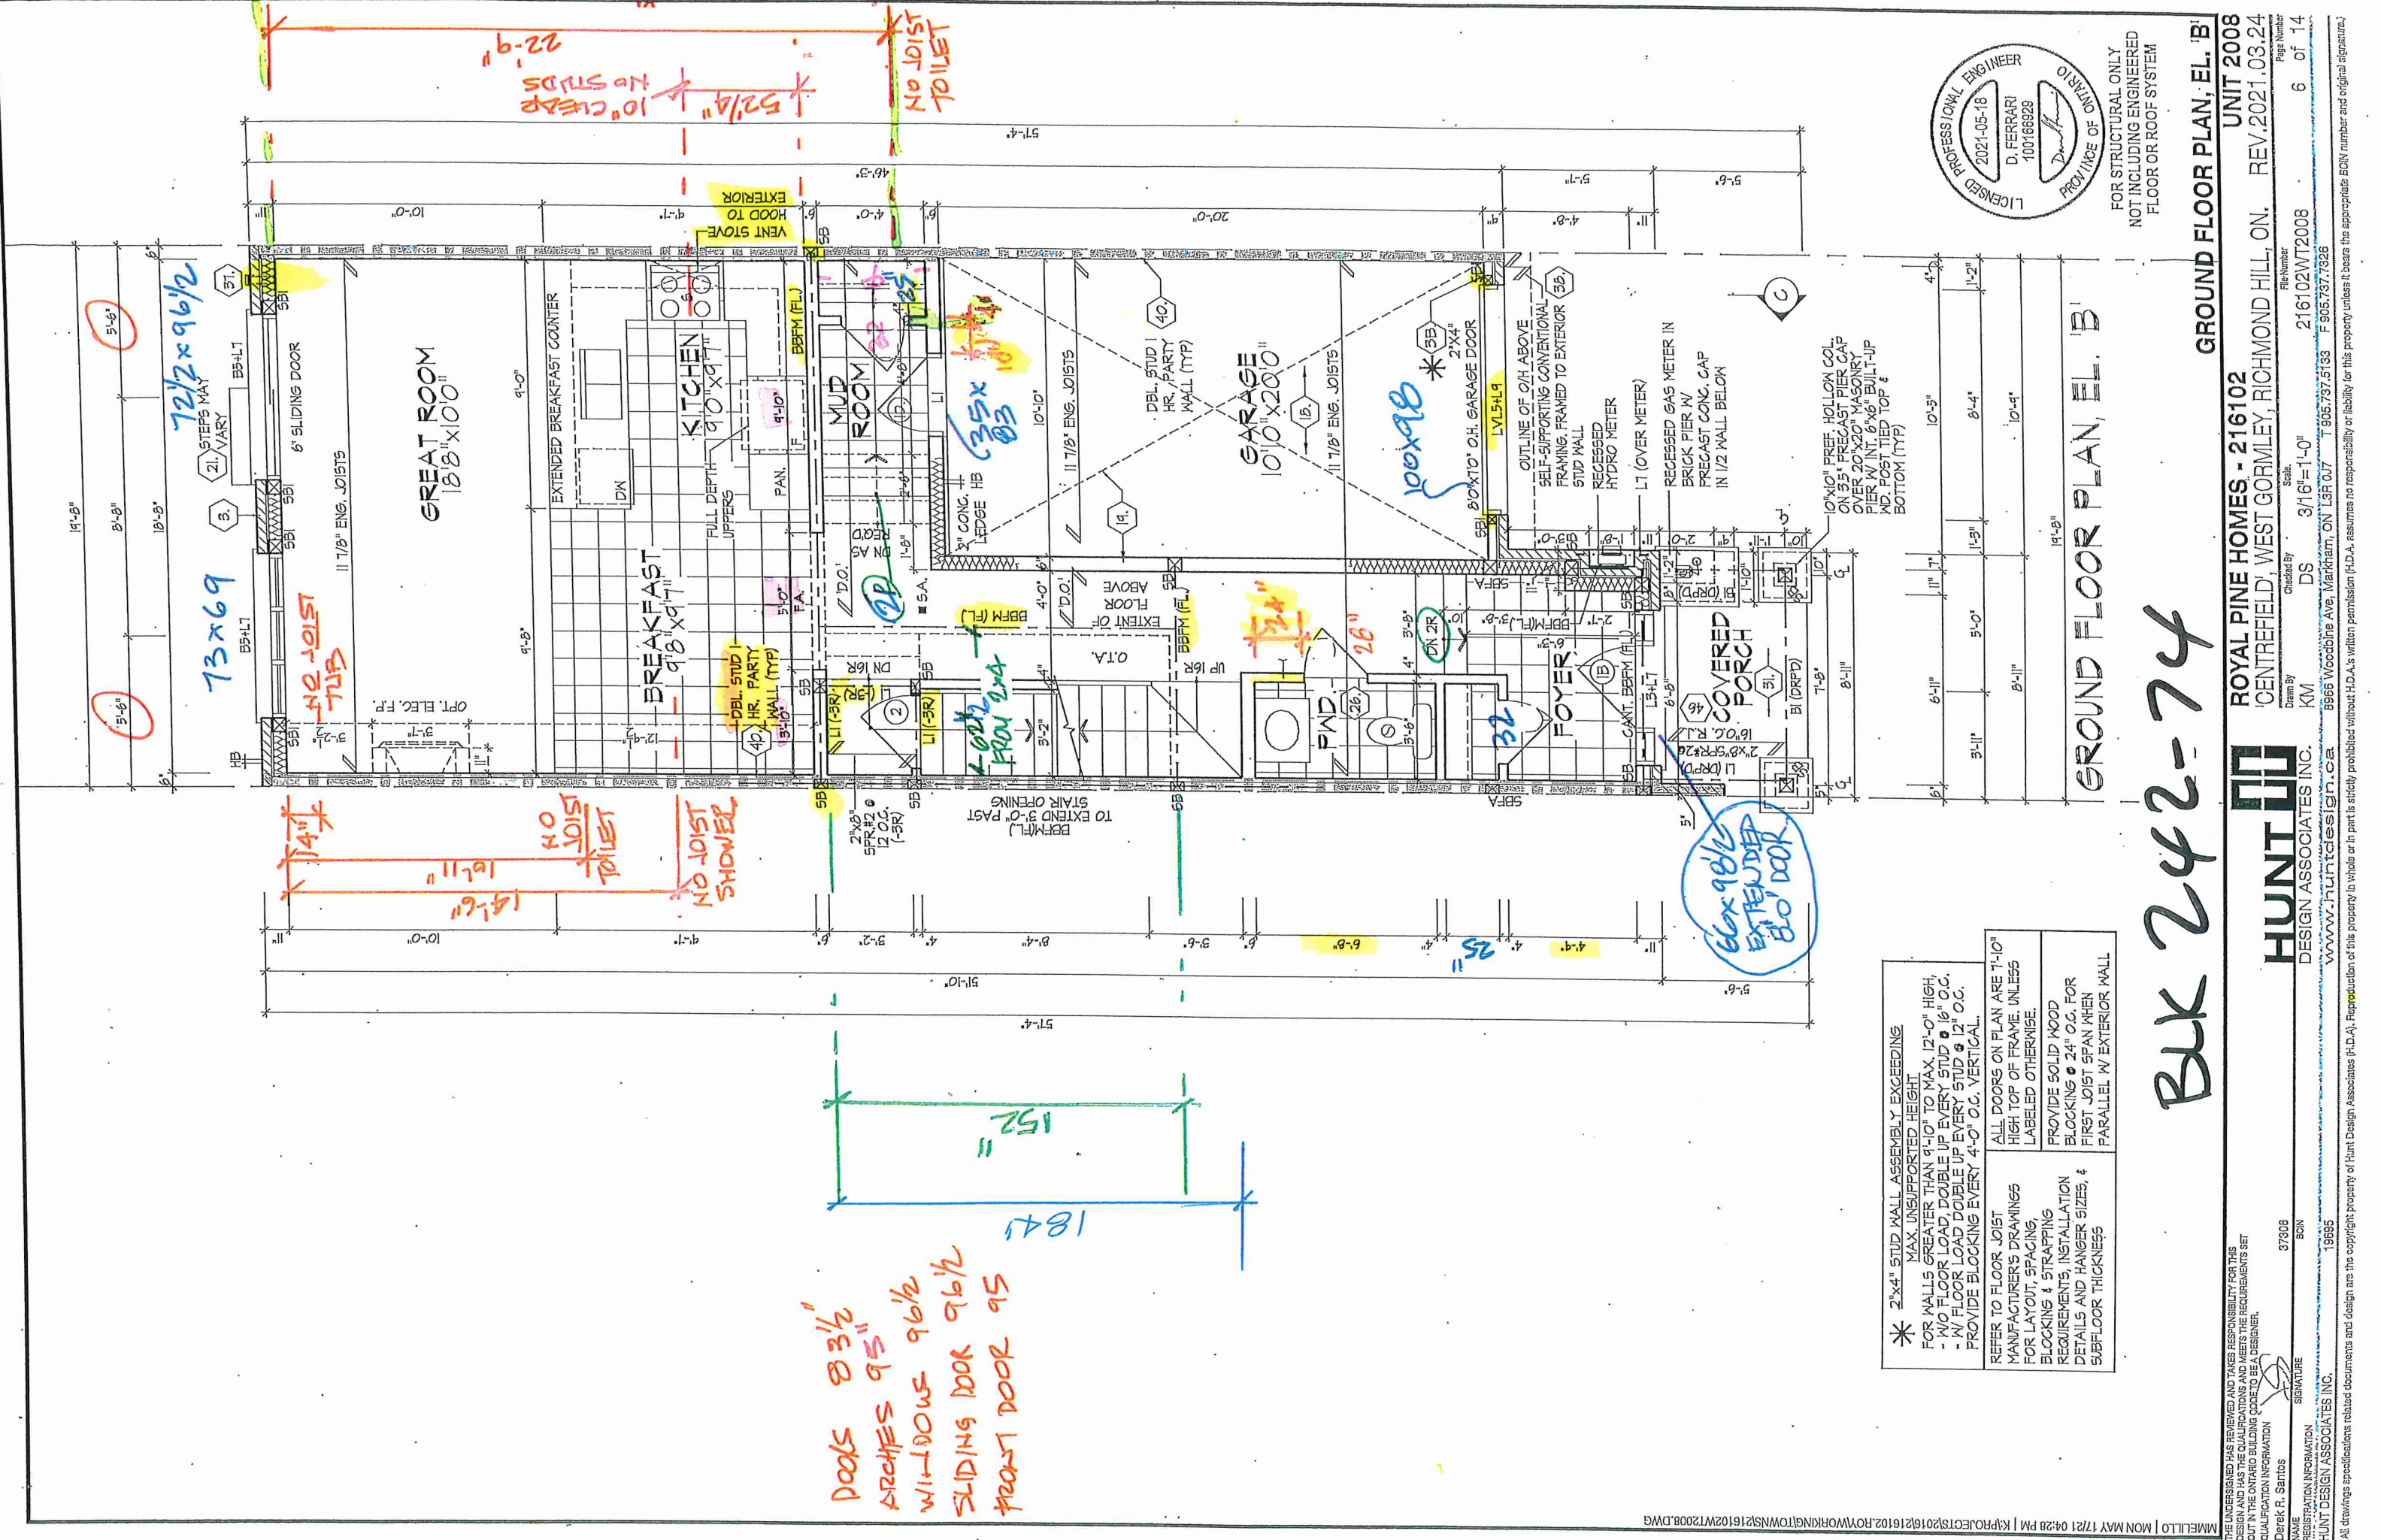

DOORS 83 1/2"
ARCHES 95"
WINDOWS 96 1/2"
SLIDING DOOR 96 1/2"
FRONT DOOR 95"

* 2"x4" STUD WALL ASSEMBLY EXCEEDING MAX. UNSUPPORTED HEIGHT. FOR WALLS GREATER THAN 9'-10" TO MAX. 12'-0" HIGH, - NO FLOOR LOAD, DOUBLE UP EVERY STUD @ 16" O.C. - W/ FLOOR LOAD, DOUBLE UP EVERY STUD @ 12" O.C. PROVIDE BLOCKING EVERY 4'-0" O.C. VERTICAL.	
REFER TO FLOOR JOIST MANUFACTURER'S DRAWINGS FOR LAYOUT, SPACING, BLOCKING & STRAPPING REQUIREMENTS, INSTALLATION DETAILS AND HANGER SIZES, & SUBFLOOR THICKNESS	ALL DOORS ON PLAN ARE 1'-10" HIGH TOP OF FRAME, UNLESS LABELED OTHERWISE.
PROVIDE SOLID WOOD BLOCKING @ 24" O.C. FOR FIRST JOIST SPAN WHEN PARALLEL W/ EXTERIOR WALL	



UNDESIGNED HAS REVIEWED AND TAKES RESPONSIBILITY FOR THIS DRAWING. THE QUALIFICATIONS AND MEETS THE REQUIREMENTS SET OUT IN THE ONTARIO BUILDING CODE TO BE A DESIGNER.

QUALIFICATION INFORMATION

Derek R. Santos

REGISTRATION INFORMATION

NAME

HUNT DESIGN ASSOCIATES INC.

37308

BCIN

19895

ALL drawings specifications related documents and design are the copyright property of Hunt Design Associates (H.D.A.). Reproduction of this property in whole or in part is strictly prohibited without H.D.A.'s written permission (H.D.A. assumes no responsibility or liability for this property unless it bears the appropriate BCIN number and original signature).

DESIGN ASSOCIATES INC.

www.huntassociates.ca

8966 Woodbine Ave, Markham, ON L3R 0J7

T 905.737.5133 F 905.737.7326

Drawn By: KMI

Checked By: DS

3/16"=1'-0"

216102WT2008

6 of 14


ROYAL PINE HOMES - 216102

'CENTREFIELD', WEST GORMLEY, RICHMOND HILL, ON.

REV.2021.03.24

UNIT 2008

GROUND FLOOR PLAN, EL. 'B'

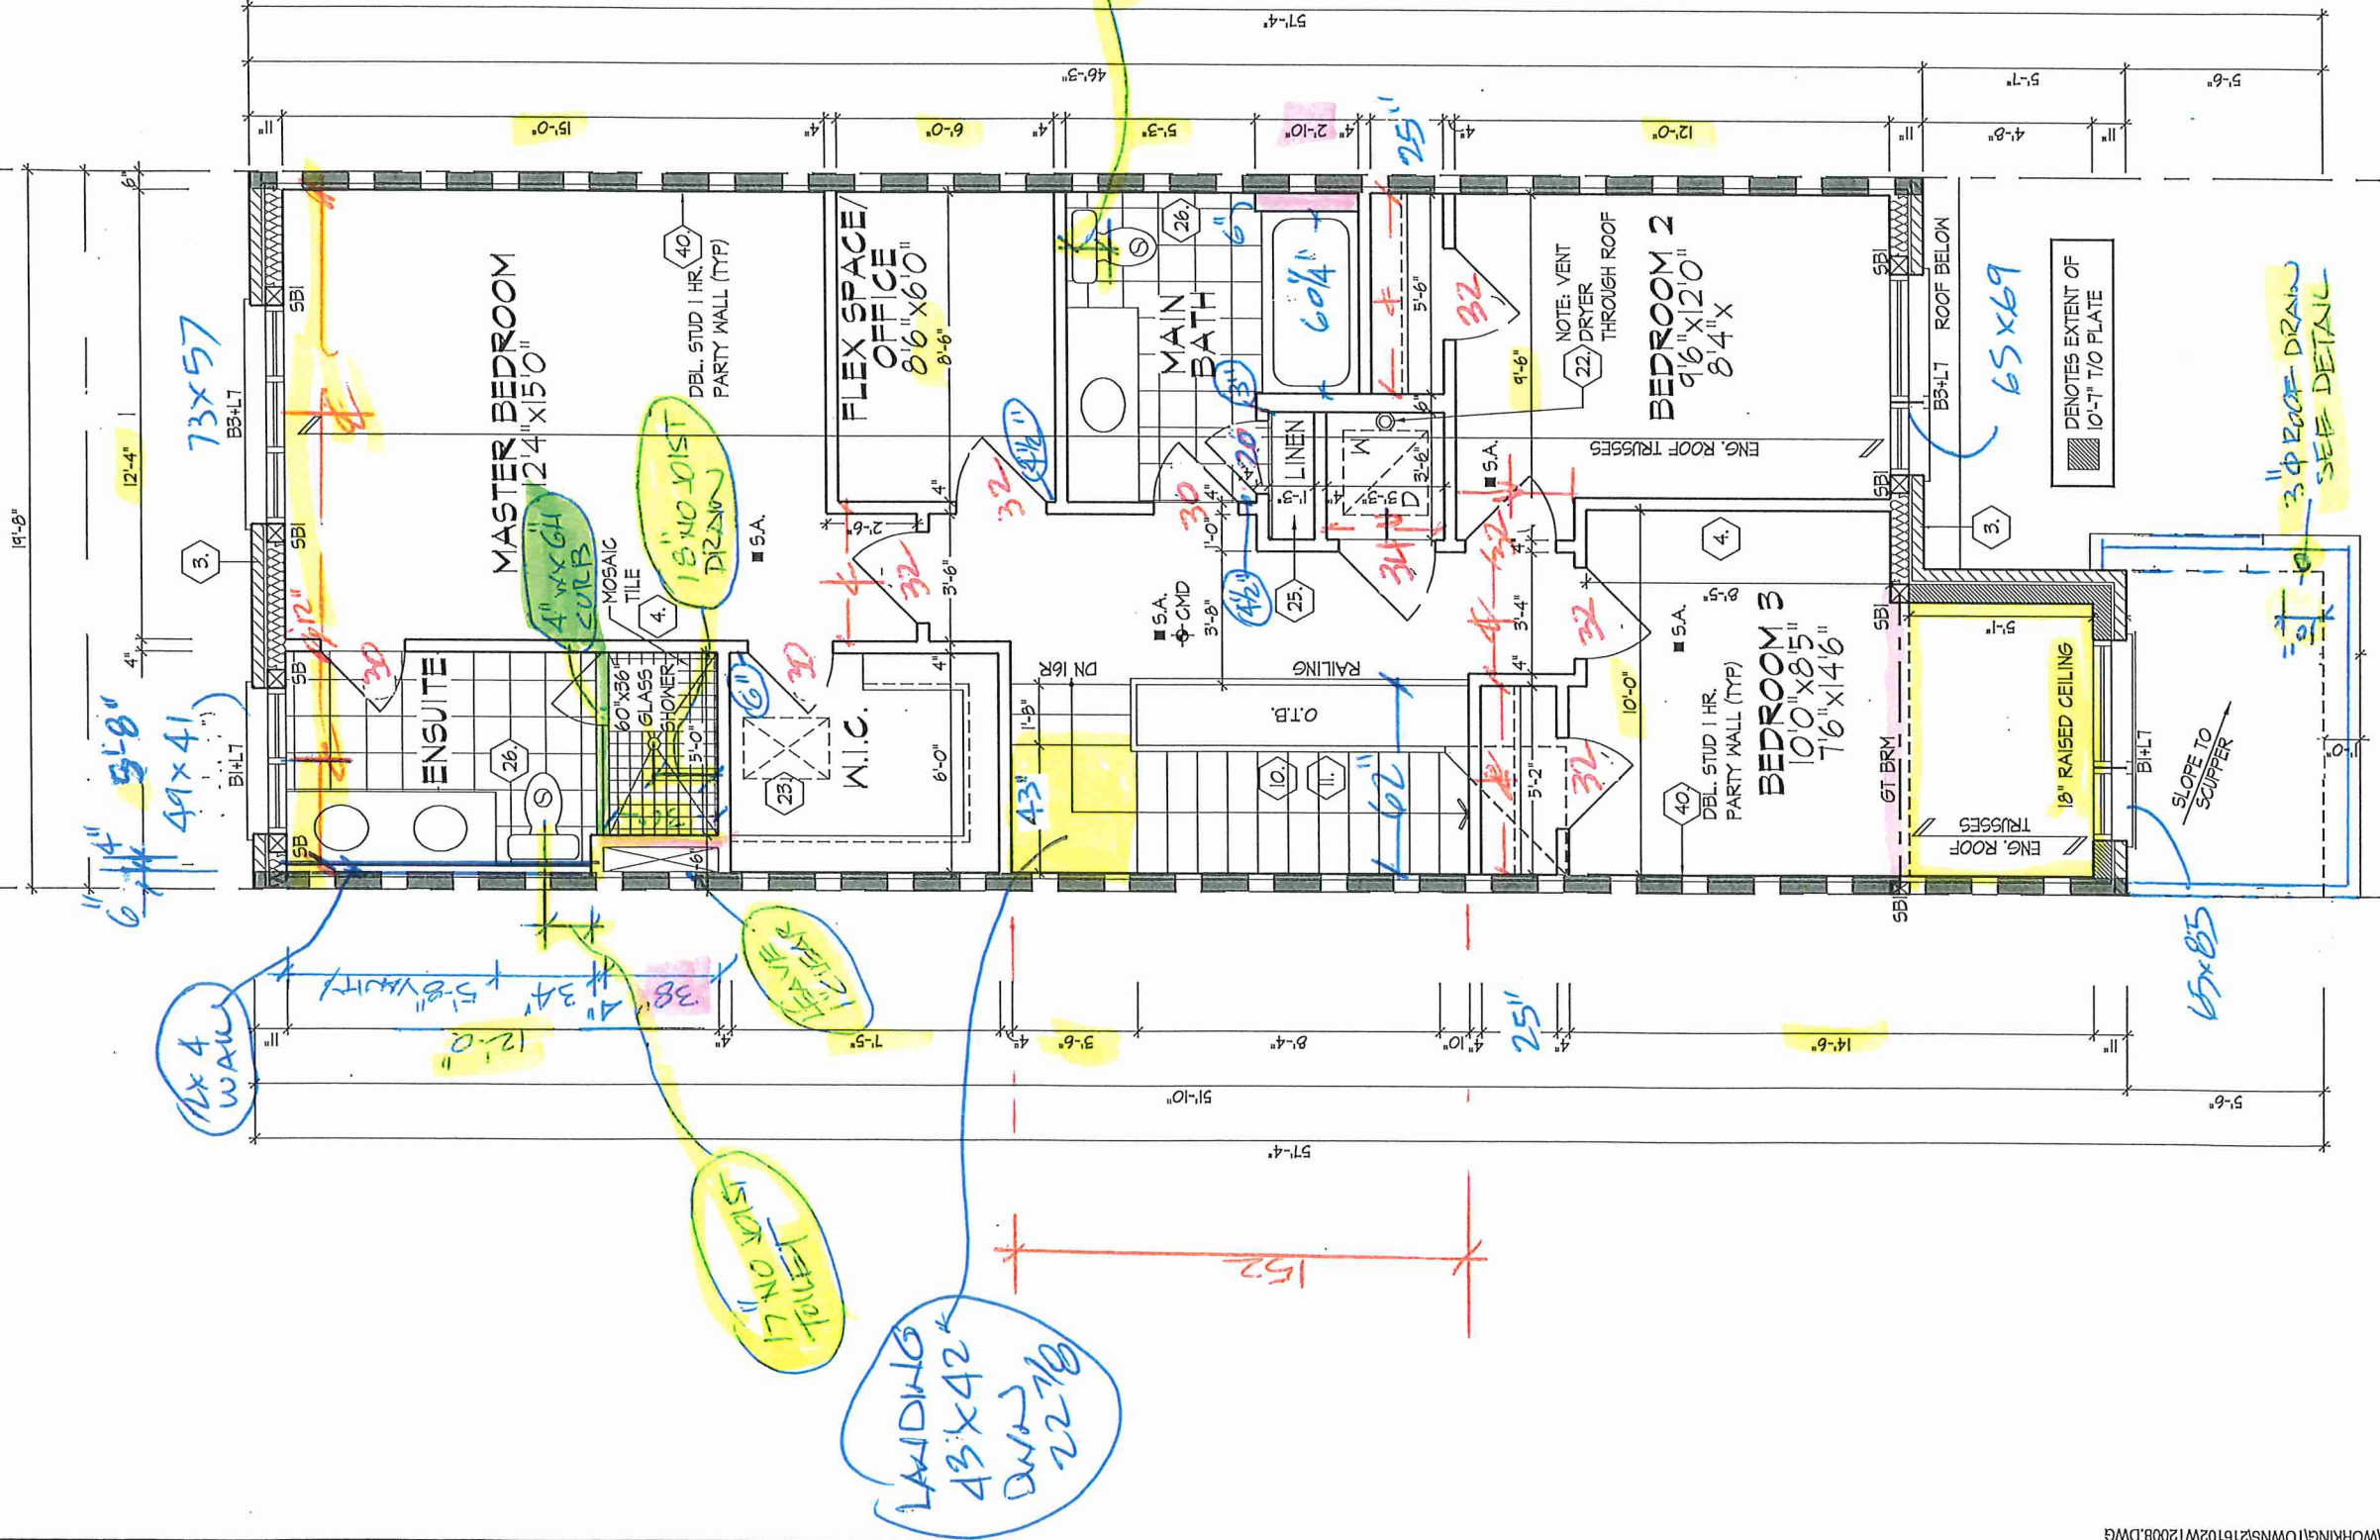

REFER TO ROOF TRUSS
MANUFACTURER'S DRAWINGS
FOR LAYOUT, SPACING,
INSTALLATION DETAILS AND
HANGER SIZES.

SECOND FLOOR PLAN, EL. 'B'
OFFICE / FLEX SPACE LAYOUT
20-08 THE LAWSON

BLC-242-74

DOORS & 3"
WINDOWS SEE ELEV.

opt. SECOND FLOOR PLAN, EL. 'B'

ROYAL PINE HOMES - 216102
'CENTREFIELD', WEST GORMLEY, RICHMOND HILL, ON. REV. 2025.03.13

HUNT
DESIGN ASSOCIATES INC.

Page Number
5b of 14

File Number
216102WT2008

Checked By
DS

Drawn By
KM

www.huntdesign.ca

19995

HUNT DESIGN ASSOCIATES INC.

THE UNDERSIGNED HAS REVIEWED AND TAKES RESPONSIBILITY FOR THIS
DESIGN AND HAS THE QUALIFICATIONS AND MEETS THE REQUIREMENTS SET
OUT IN THE ONTARIO BUILDING CODE TO BE A DESIGNER.

NAME
Derek R. Santos

REGISTRATION INFORMATION
37308 BCIN

SIGNATURE

19995

HUNT DESIGN ASSOCIATES INC.

Page Number
5b of 14

File Number
216102WT2008

Checked By
DS

Drawn By
KM

www.huntdesign.ca

19995

HUNT DESIGN ASSOCIATES INC.

THE UNDERSIGNED HAS REVIEWED AND TAKES RESPONSIBILITY FOR THIS
DESIGN AND HAS THE QUALIFICATIONS AND MEETS THE REQUIREMENTS SET
OUT IN THE ONTARIO BUILDING CODE TO BE A DESIGNER.


NAME
Derek R. Santos

REGISTRATION INFORMATION
37308 BCIN

SIGNATURE

19995


HUNT DESIGN ASSOCIATES INC.

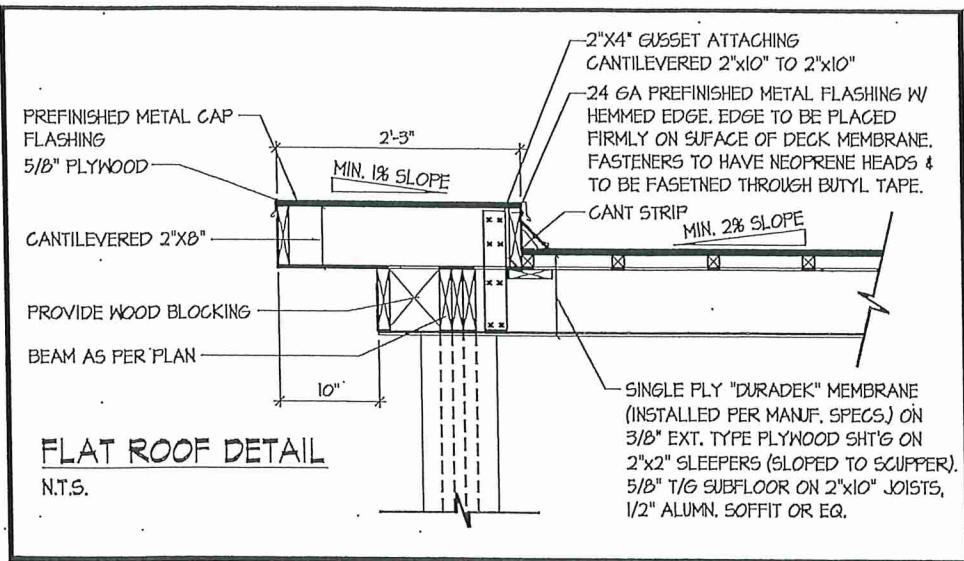

GARAGE ROOF
18'0\"/>


ROOF OVERHANGS TO BE 12\"/>

NOTE:
WHEN UNIT REVERSED KEEP
SIDE 24\"/>

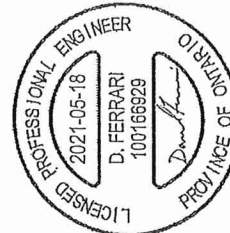


FOR STRUCTURAL ONLY
NOT INCLUDING ENGINEERED
FLOOR OR ROOF SYSTEM

W Architect Inc.
DESIGN CONTROL REVIEW
MAY 31, 2021
FINAL BY: *[Signature]*
This stamp is only for the purposes of design control and carries no other professional obligations.

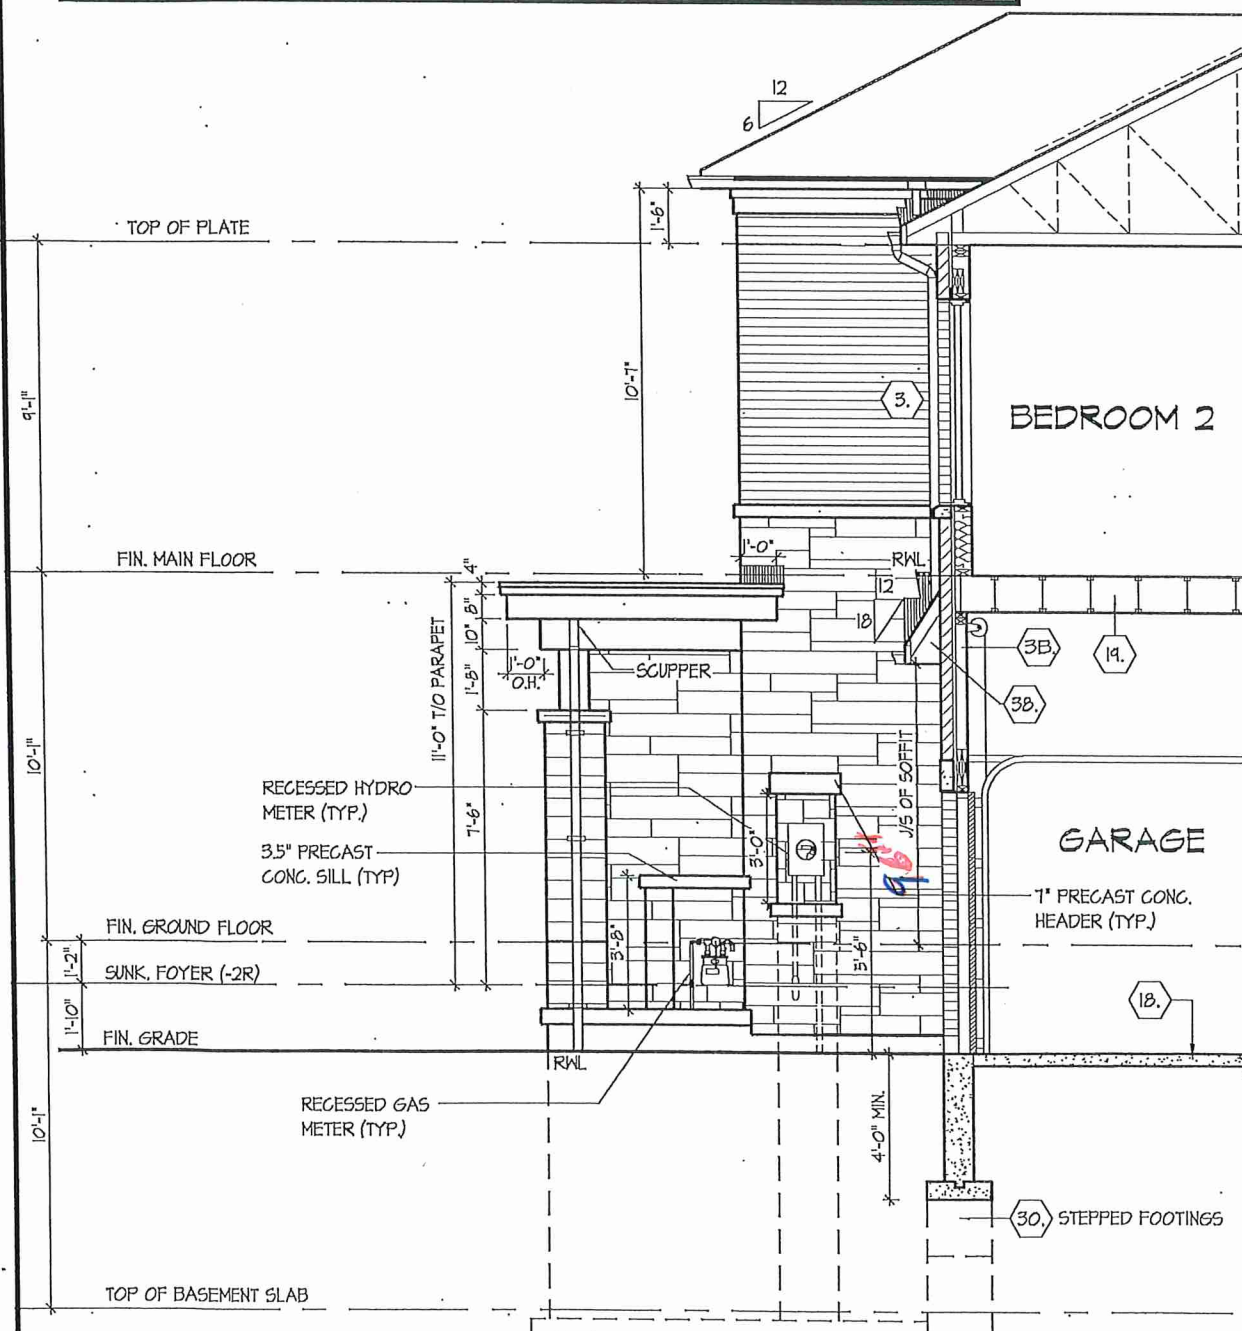

PARTIAL SECTION-C, EL. 'B'

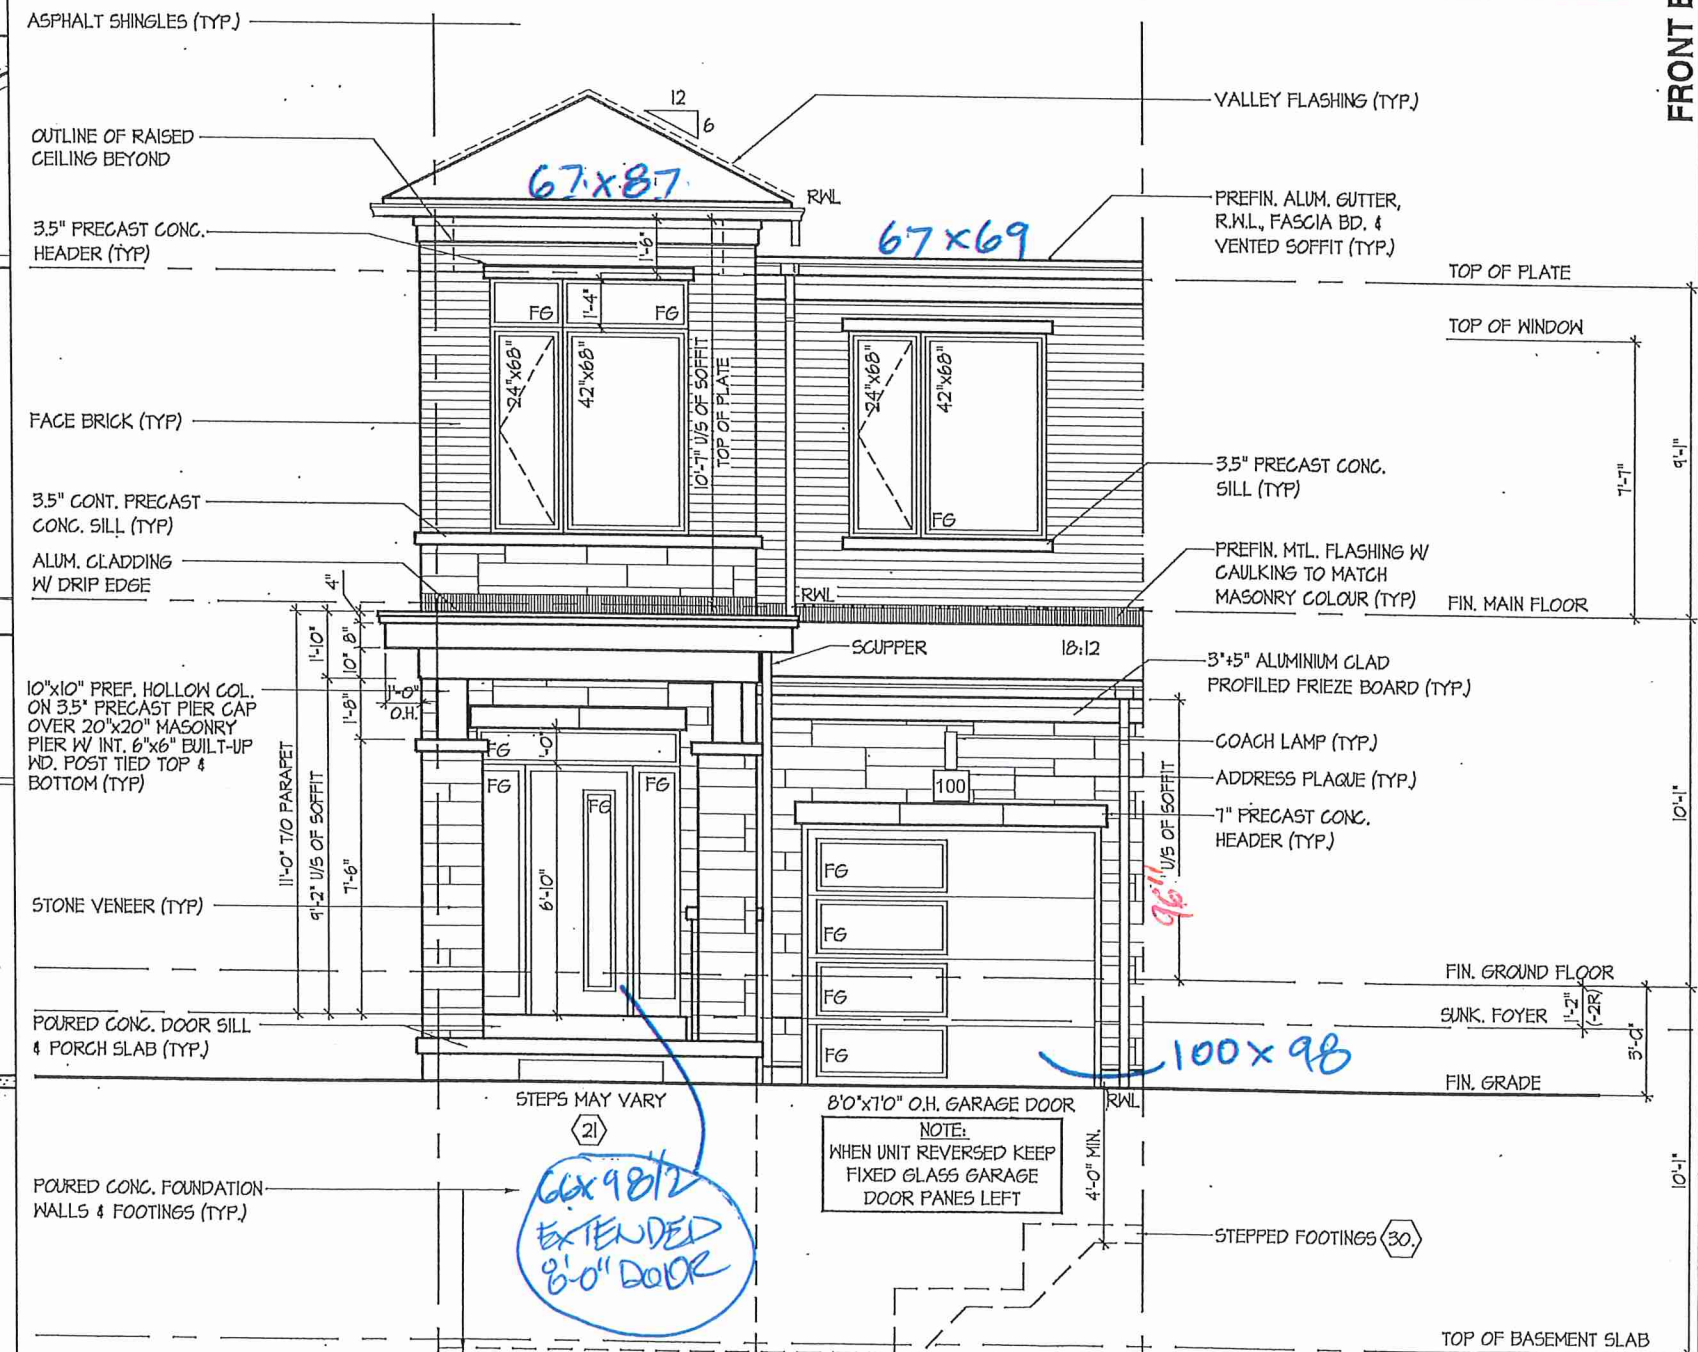

FRONT ELEVATION 'B'


FRONT ELEVATIONS 'B' & PART, SECTION 'C'

ROYAL PINE HOMES - 216102
CENTREFIELD, WEST GORMLEY, RICHMOND HILL, ON. REV. 2021.03.24

DESIGN ASSOCIATES INC.
www.huntassociates.ca

UNDESIGNED HAS REVIEWED AND TAKES RESPONSIBILITY FOR THIS DESIGN AND HAS THE QUALIFICATIONS AND MEETS THE REQUIREMENTS TO DESIGN AND BUILDING CODE TO BE A DESIGNER.
Derek F. Santos
15665

INTERIOR PORCH
SECTION EL. 'A'

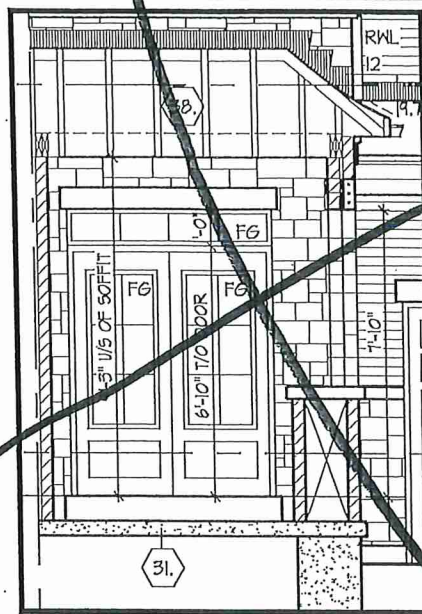

ASPHALT SHINGLES (TYP.)
VALLEY FLASHING (TYP.)
12"x12" PRECAST CONC.
ACCENT (TYP.)
PREFIN. ALUM. GUTTER,
R.W.L., FASCIA BD. &
VENTED SOFFIT (TYP.)

2"x4" ALUMINIUM CLAD
PROFIED FRIEZE BOARD (TYP.)

1" PRECAST CONC. HEADER ON 1"
PRECAST CONC. SURROUND (TYP.)

3.5" PRECAST CONC. SILL
(TYP.)

COACH LAMP (TYP.)

ADDRESS PLAQUE (TYP.)

1" PRECAST CONC.
HEADER (TYP.)

CONT. 3.5" PRECAST
CONC. BAND (TYP.)


FIN. GRADE @ FRONT

STEPPED FOOTINGS (30)

W Architect Inc.
DESIGN CONTROL REVIEW
MAY 31, 2021

FINAL BY: *ALL*

This stamp is only for the purposes of design
control and carries no other professional obligations.

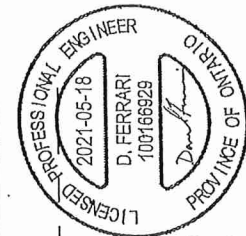

FOR STRUCTURAL ONLY
NOT INCLUDING ENGINEERED
FLOOR OR ROOF SYSTEM

Box 242-74

PART. FRONT
ELEVATION 'A2'

1" SELF SUPPORTING PRECAST
CONC. ARCH & KEYSTONE ON 1"
PRECAST CONC. SURROUND W/ 1/2"
PROJ. (TYP.)

FACE BRICK (TYP.)

PREFIN. MTL. FLASHING W/
CAULKING TO MATCH
MASONRY COLOUR (TYP.)

PREFIN. SEAMED METAL ROOF

1" PRECAST CONC.
HEADER & KEYSTONE
(TYP.)

STONE VENEER (TYP.)

FIN. GROUND FLOOR

SUNK. FOYER (-2R)

POURED CONC. DOOR SILL &
PORCH SLAB (TYP.)

POURED CONC. FOUNDATION
WALLS & FOOTINGS (TYP.)

TOP OF BASEMENT SLAB

FRONT ELEVATION 'A1'

REAR ELEVATION 'A' & 'B'

HUNT
DESIGN ASSOCIATES INC.
www.huntassociatesinc.ca

37308 BCN 19695

NAME: Derek R. Sartor
SIGNATURE: *[Signature]*
REGISTRATION INFORMATION: 37308 BCN 19695


FRONT ELEVATION 'A' & REAR ELEV. 'A' & 'B'

ROYAL PINE HOMES - 216102
'CENTREFIELD' WEST GORMLEY, RICHMOND HILL, ON. REV. 2021.03.24


Unit 2008
Page 8 of 14

Scale: 3/16" = 1'-0"
Drawn By: DS
Checked By: KM
File Number: 216102WT2008
T 905.737.5133 F 905.737.7926

ALL DRAWINGS SPECIFICATIONS RELATED DOCUMENTS AND DESIGN ARE THE COPYRIGHT PROPERTY OF HUNT DESIGN ASSOCIATES INC. (H.D.A.). REPRODUCTION OF THIS PROPERTY IN WHOLE OR IN PART IS STRICTLY PROHIBITED WITHOUT H.D.A.'S WRITTEN PERMISSION. (H.D.A. ASSUMES NO RESPONSIBILITY OR LIABILITY FOR THIS PROPERTY UNLESS IT BEARS THE APPROPRIATE BCN NUMBER AND ORIGINAL SIGNATURE.)

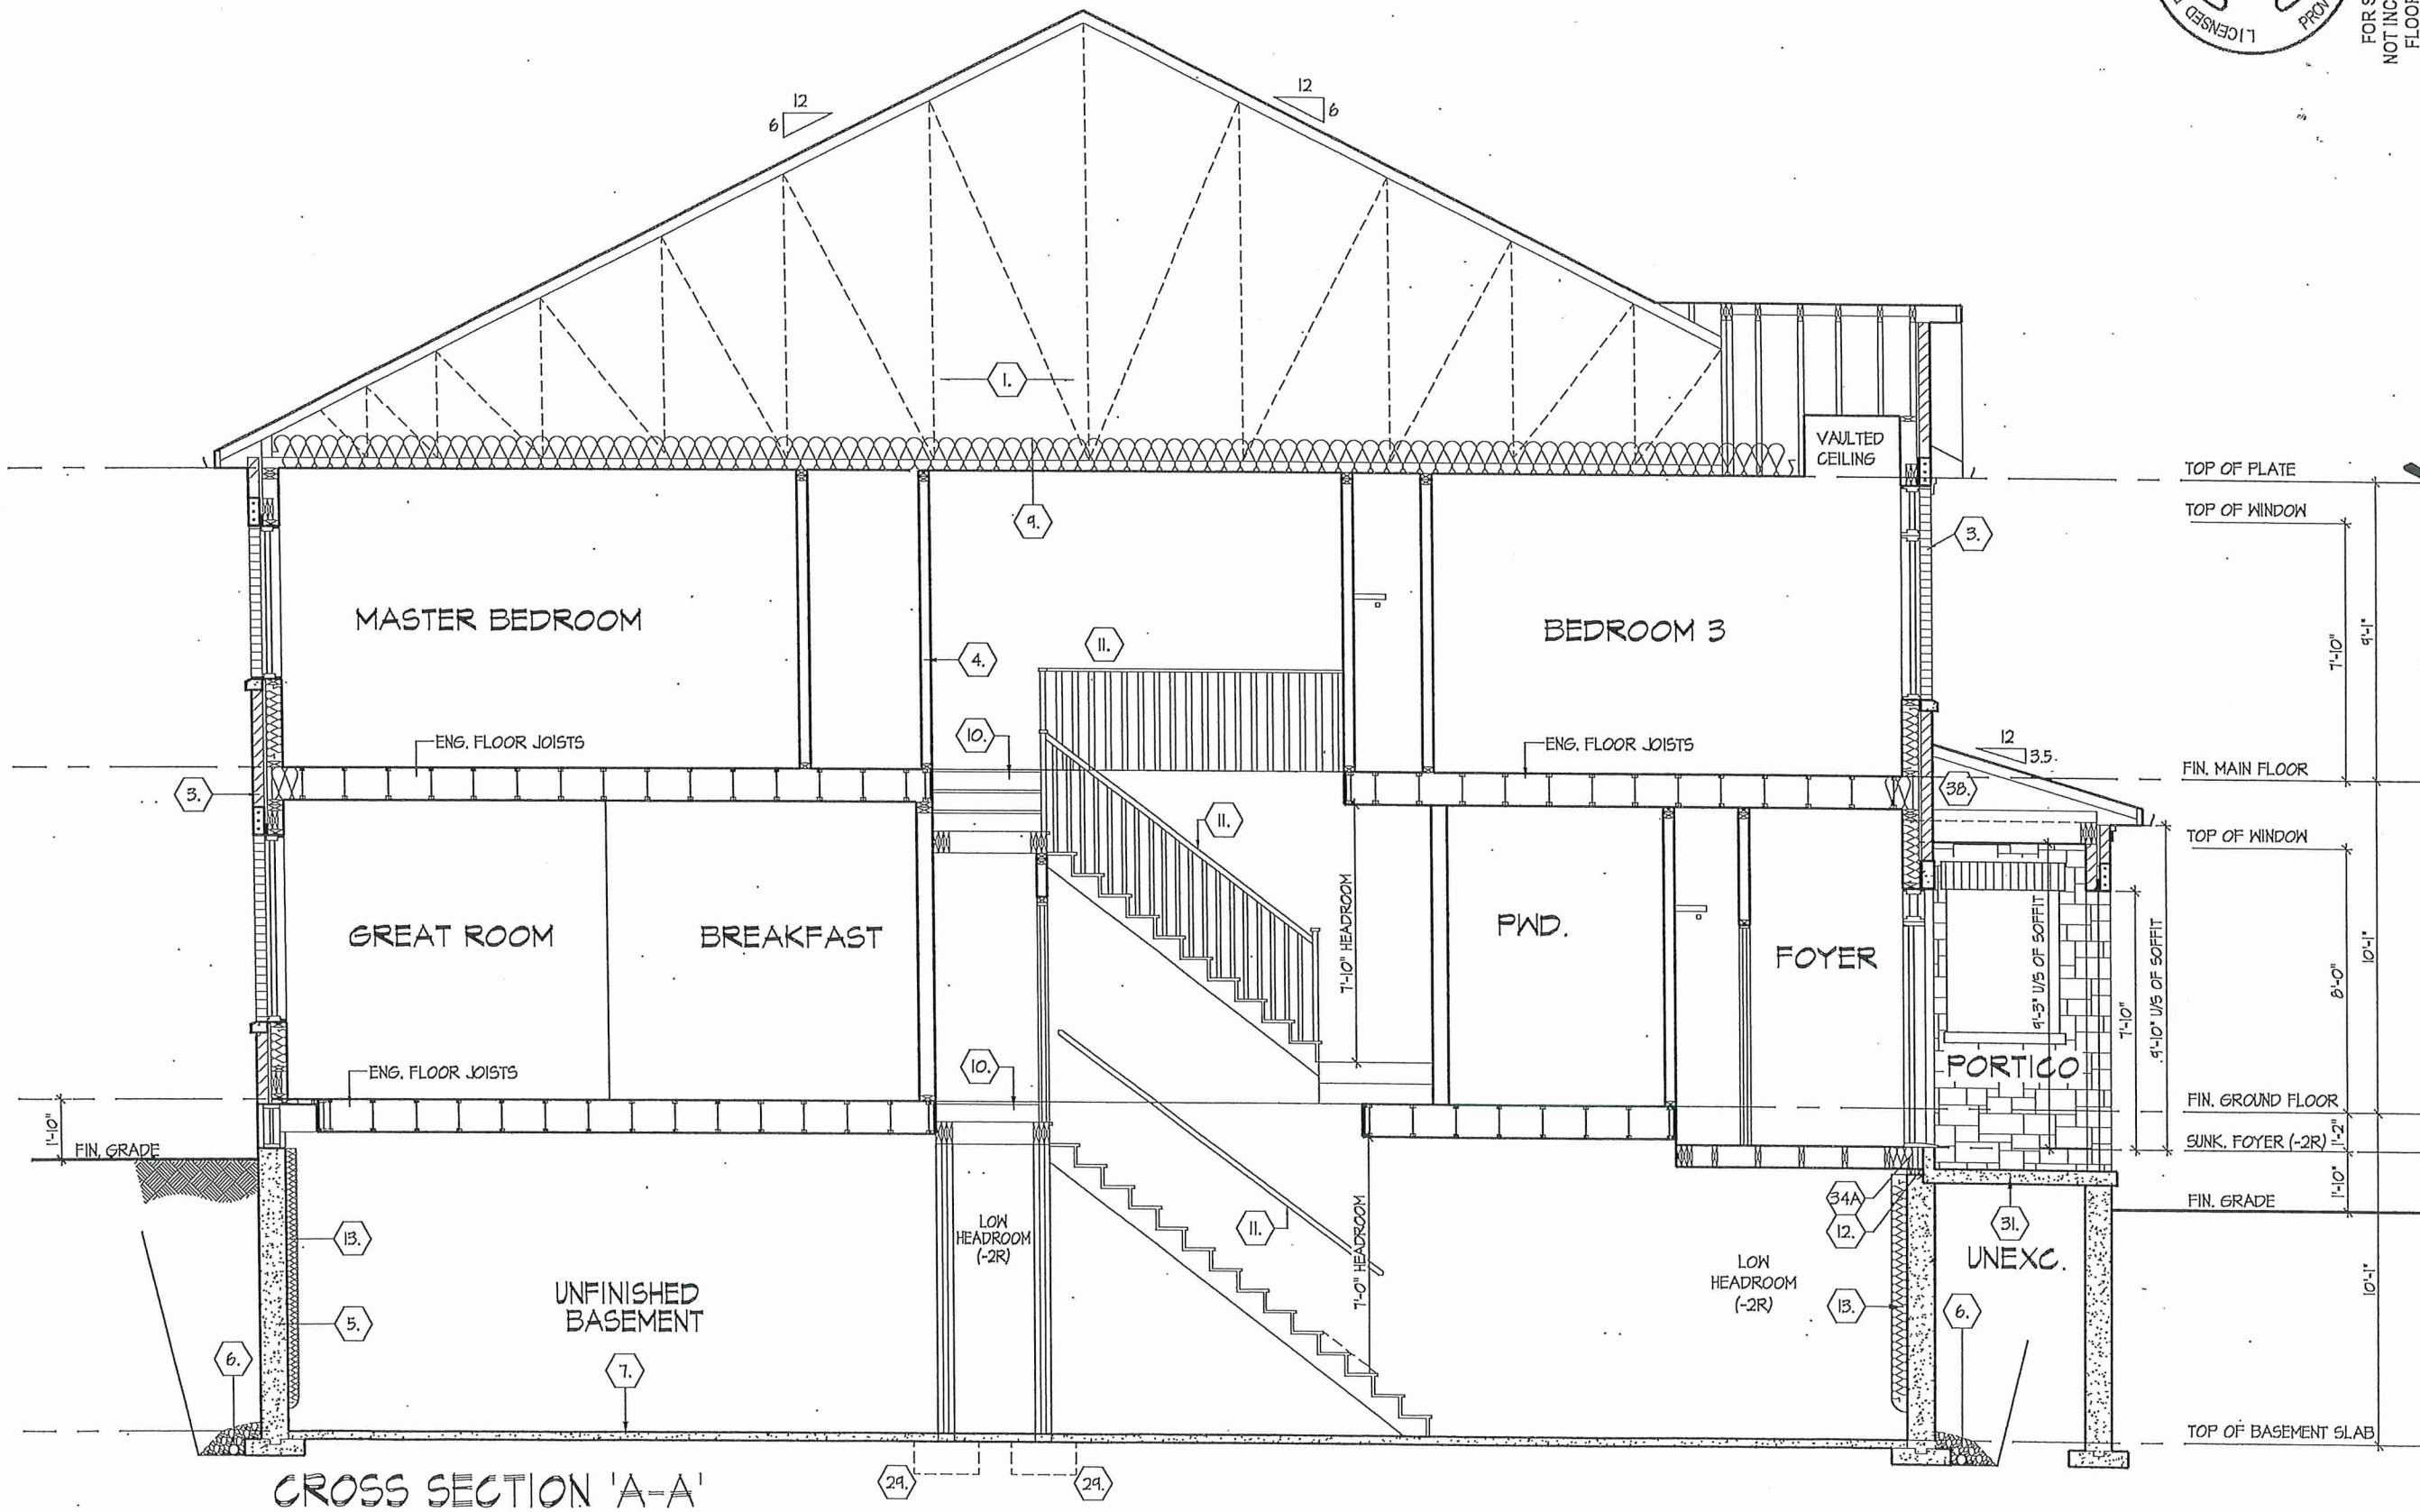

CROSS SECTION 'A-A'

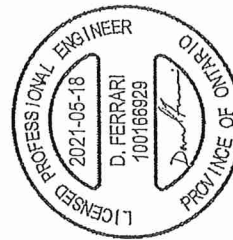

FOR STRUCTURAL ONLY
NOT INCLUDING ENGINEERED
FLOOR OR ROOF SYSTEM

CROSS SECTION 'A-A'

UNIT 2008

ROYAL PINE HOMES - 216102

'CENTREFIELD', WEST GORMLEY, RICHMOND HILL, ON. REV. 2021.03.24

HUNT
DESIGN ASSOCIATES INC.
www.huntassociatesinc.ca

Drawn By: KM DS 3/16"=1'-0"
Checked By: 216102WT2008
File Number: 10 of 14
Scale: 3/16"=1'-0"
T 905.737.5133 F 905.737.7326

8966 Woodbine Ave, Markham, ON L3R 0J7

37308

19895

THE UNDERSIGNED HAS REVIEWED AND TAKES RESPONSIBILITY FOR THIS DESIGN AND HAS THE QUALIFICATIONS AND MEETS THE REQUIREMENTS SET OUT IN THE ONTARIO BUILDING CODE TO BE A DESIGNER.

UNDESIGNED INFORMATION

UNDESIGNED INFORMATION

cont. SECTION 1.0. CONSTRUCTION NOTES

- 40

1 HR. PARTY WALL (CONC. BLOCK) (SB-3) WALL TYPE 96e & 91b)
1/2" (12.7) GYPSUM SHEATHING ON EACH SIDE ON 2x2" (38x38) VERTICAL WD. STRAPPING @ 24" (610) O.C. ON 8" (200) CONC. BLOCK FILL STRAPPING CAVITY EACH SIDE WITH AT LEAST 90% OF ABSORPTIVE MATERIAL PROCESSED FROM ROCK, SLAG OR GLASS. TAPE, FILL & SAND ALL GYPSUM JOINTS. EXPOSED BLOCK MUST BE SEALED W/ 2 COATS OF PAINT OR FURRED WITH 2x2" (38x38) WD. STRAPPING & 1/2" (12.7) GYPSUM SHEATHING.
- 40

1 HR. PARTY WALL (DOUBLE STUD) (SB-3) WALL TYPE W13c)
5/8" (15.9) TYPE X GYPSUM SHEATHING ON EXTERIOR SIDE OF 2 ROWS OF 2x4" (38x89) STUDS @ 16" (406) O.C., MIN. 1" (25) APART ON SEPARATE 2x4" (38x89) SILL PLATES. (2x6" (38x140) AS REQUIRED) FILL ONE SIDE OF STUD CAVITY WITH AT LEAST 90% OF ABSORPTIVE MATERIAL PROCESSED FROM ROCK, SLAG OR GLASS. TAPE FILL AND SAND ALL GYPSUM JOINTS.
- 40A

2 HR. FIREWALL (SB-3) WALL TYPE 96e & 91b)
1/2" (12.7) GYPSUM SHEATHING ON EACH SIDE ON 2x2" (38x38) VERTICAL WD. STRAPPING @ 24" (610) O.C. ON 8" (200) CONC. BLOCK 75% SOLID. FILL STRAPPING CAVITY EACH SIDE WITH AT LEAST 90% OF ABSORPTIVE MATERIAL PROCESSED FROM ROCK, SLAG OR GLASS. TAPE FILL & SAND ALL GYPSUM JOINTS. AT UNFINISHED AREAS, EXTERIOR FACE OF CONC. BLOCK TO BE SEALED WITH 2 COATS OF PAINT. GYPSUM SHEATHING TO BE ATTACHED TO CONC. BLOCK. (REFER TO DETAILS)
- 41

STUCCO WALL CONSTRUCTION (2"x6")
STUCCO FINISH CONFORMING TO O.B.C. SECTION 9.28. AND APPLIED PER MANUFACTURERS SPECIFICATIONS OVER 1 1/2" (38) E.F.F.S. (MINIMUM) ON APPROVED DRAINAGE MAT ON 1/2" (12.7) DENSGLASS GOLD GYPSUM BOARD ON STUDS CONFORMING TO O.B.C (9.23.10.1) & SECTION 1.1., INSULATION, APPROVED 6 MIL. POLYETHYLENE VAPOUR BARRIER, 1/2" (12.7) GYPSUM WALLBOARD INT. FINISH. (REFER TO 35 NOTE AS REQUIRED)
- 41A

STUCCO WALL CONSTRUCTION (2"x6") W/ CONTIN. INSUL.
STUCCO FINISH CONFORMING TO O.B.C. SECTION 9.28. AND APPLIED PER MANUFACTURERS SPECIFICATIONS OVER 1 1/2" (38) E.F.F.S. (MINIMUM) ON APPROVED DRAINAGE MAT ON APPROVED AIRWATER BARRIER AS PER O.B.C. 9.27.3. ON EXTERIOR TYPE RIGID INSULATION (JOINTS UNTAPED) MECHANICALLY FASTENED AS PER MANUFACTURERS SPECIFICATIONS, ON 7/16" EXTERIOR TYPE SHEATHING ON STUDS CONFORMING TO O.B.C (9.23.10.1) & SECTION 1.1., INSULATION, APPROVED 6 MIL. POLYETHYLENE VAPOUR BARRIER, 1/2" (12.7) GYPSUM WALLBOARD INT. FINISH. (REFER TO 35 NOTE AS REQUIRED)
- 41B

STUCCO WALL @ GARAGE CONST.
STUCCO FINISH CONFORMING TO O.B.C. SECTION 9.28. AND APPLIED PER MANUFACTURERS SPECIFICATIONS OVER 1 1/2" (38) E.F.F.S. (MINIMUM) ON APPROVED DRAINAGE MAT ON 1/2" (12.7) DENSGLASS GOLD GYPSUM BRD. ON STUDS CONFORMING TO O.B.C (9.23.10.1) & SECTION 1.1., 1/2" (12.7) GYPSUM WALLBOARD INT. FINISH. (REFER TO 35 NOTE AS REQ.)
*** FOR DWELLINGS USING CONTIN. INSULATION CONSTRUCTION, PROVIDE APPROVED DRAINAGE MAT ON 7/16" (11) EXTERIOR TYPE SHEATHING OVER FURRING (AS REQ.) AND STUDS IN LIEU OF 1 1/2" (38) E.F.F.S (MINIMUM) ON APPROVED DRAINAGE MAT ON 1/2" (12.7) DENSGLASS GOLD GYPSUM BRD.
- 42

UNSUPPORTED FOUNDATION WALLS (9-15.4.2.)
REINFORCING AT STAIRS AND SUNKEN FLOOR AREAS
2-20M BARS IN TOP PORTION OF WALL (UP TO 9-9" OPENING)
3-20M BARS IN TOP PORTION OF WALL (9-9" TO 10-0" OPENING)
4-20M BARS IN TOP PORTION OF WALL (10-0" TO 15-0" OPENING)
- BARS STACKED VERTICALLY AT INTERIOR FACE OF WALL
REINFORCING AT BASEMENT WINDOWS
2-15M HORIZ. REINFORCING ON THE INSIDE AND OUTSIDE FACE OF THE FOUNDATION WALL BELOW THE WIN. SILL. EXTEND BARS 24" (610) BEYOND THE OPENING. 2-15M VERTICAL REINFORCING ON THE INSIDE AND OUTSIDE FACE OF THE FOUNDATION WALL ON EACH SIDE OF THE WINDOW OPENING.
- BARS TO HAVE MIN. 1" (25) CONC. COVER
- BARS TO EXTEND 2-0" (610) BEYOND BOTH SIDES OF OPENING
- 43

STUD WALL REINFORCEMENT
PROVIDE STUD WALL REINFORCEMENT IN MAIN BATHROOM CONFORMING TO O.B.C. (9.5.2.3.(1) AND 3.8.3.8.(6)) (REFER TO DETAILS)
- 44

WINDOW WALLS
WHERE A WINDOW OPENS INTO A WINDOW WELL, A CLEARANCE OF NOT LESS THAN 21 5/8" (550) SHALL BE PROVIDED IN FRONT OF THE WINDOW. EVERY WINDOW WELL SHALL BE DRAINED TO THE FOOTING LEVEL OR OTHER SUITABLE LOCATION WITH A 4" (100) WEeping TILE C/W A FILTER CLOTH WRAP AND FILLED WITH CRUSHED STONE. (9.9.10.1.(5), 9.14.6.3.)
- 45

SLOPED CEILING CONSTRUCTION (SB-12) 2.1.1.7., 9.23.4.2.)
2x12" (38x286) ROOF JOISTS @ 16" (406) O.C. MAX. (UNT LESS OTHERWISE NOTED) W/ 2x2" (38x38) PURLINS @ 16" (406) O.C. PERPENDICULAR TO ROOF JOIST (PURLINS NOT REQ. W/ SPRAY FOAM), W/ INSULATION BETWEEN JOIST, 6 mil POLYETHYLENE VAPOUR BARRIER, 1/2" (12.7) GYPSUM WALLBOARD INT. FINISH OR APPROVED EQ. INSULATION VALUE DIRECTLY ABOVE THE INNER SURFACE OF EXTERIOR WALLS SHALL NOT BE LESS THAN R20 (3.52 RSI).
- 46

FLAT ROOF/BALCONY CONSTRUCTION
WATERPROOFING MEMBRANE (9.26.11, 9.26.15, 9.26.16) FULLY ADHERED TO 5/8" (15.9) T&G EXTERIOR GRADE PLYWOOD SHEATHING ON 2x2" (38x38) PURLINS ANGLED TOWARDS SCUPPER @ 2% MINIMUM LAID PERPENDICULAR TO 2x8" (38x184) FLOOR JOISTS @ 16" (406) O.C. (UNT LESS OTHERWISE NOTED). BUILT UP CURB TO BE 4" (100) MIN. ABOVE FINISHED BALCONY FLOOR. CONTINUOUS L TRIM DRIP EDGE TO BE PROVIDED ON OUTSIDE FACE OF CURB. SCUPPER DRAIN TO BE LOCATED 24" (610) MIN. AWAY FROM HOUSE. PREFINISHED ALUMINUM OR PANEL FOR UNDERSIDE OF SOFFIT (9.23.2.3). REMOVE CURB WHERE REQ.
BALCONY CONDITION
SEE FLAT ROOF/BALCONY CONSTRUCTION NOTE, INCLUDE 2x4" (38x89) PT. DECKING W/ 1/4" (6.4) GAPS LAID FLAT PARALLEL TO JOISTS ON 2x4" (38x89) PT. SLEEPERS @ 12" (305) O.C. LAID FLAT PERPENDICULAR TO JOISTS
- 47

BALCONY OVER HEATED SPACE CONDITION
SEE FLAT ROOF/BALCONY CONSTRUCTION NOTE FOR ASSEMBLY. REFER TO PLANS FOR FLOOR JOIST SIZE & REFER TO HEX NOTE 9 FOR INSULATION AND INTERIOR FINISH
- 47

BARREL VAULT CONSTRUCTION
CANTILEVERED 2x4" (38x89) SPACERS LAID FLAT ON 2"x10" (38x235) SPR. #2 ROOF JOIST NALLED TO BUILT-UP 3-3/4" (19) PLYWOOD HEADER PROFILED FOR BARREL. SPRAY FOAM INSULATION BETWEEN JOISTS W/ GYPSUM BOARD. INTERIOR FIN. (REFER TO DETAILS)
- SECTION 1.1. WALL STUDS
- REFER TO THIS CHART FOR STUD SIZE & SPACING AS REQUIRED FOR EXTERIOR WALLS ONLY. REFER TO SITING & GRADING PLAN OF THIS UNIT FOR CONFIRMATION OF TOP OF FOUNDATION WALL AND ADDITIONAL INFORMATION.
 - IF STUD WALL HEIGHT EXCEEDS MAX. UNSUPPORTED HEIGHT, WALL NEEDS TO BE REVIEWED AND APPROVED BY ENGINEER.
- | SIZE & SPACING OF STUDS: (OBC REFERENCE - TABLE 9.23.10.1.) | | | | |
|---|---|-------------|--------------|-------------|
| MIN. STUD SIZE, in (mm) | SUPPORTED LOADS (EXTERIOR) | | | |
| | ROOF w/OR w/o ATTIC & 1 FLOOR/ATTIC & 2 FLOOR/ATTIC & 3 FLOOR | | | |
| | MAX. STUD SPACING, in (mm) O.C. | | | |
| | MAX. UNSUPPORTED HGT., ft-in (m) | | | |
| 2x4" | 24" (610) | 16" (406) | 12" (305) | N/A |
| 38x89 | 9-10" (3.0) | 9-10" (3.0) | 9-10" (3.0) | N/A |
| 2x6" | - | 24" (610) | 16" (406) | 12" (305) |
| 38x140 | - | 9-10" (3.0) | 11-10" (3.6) | 5-11" (1.3) |
- SECTION 2.0. GENERAL NOTES
- 2.1. WINDOWS

 - 1) EXCEPT WHERE A DOOR ON THE SAME FLOOR LEVEL AS THE BEDROOM PROVIDES DIRECT ACCESS TO THE EXTERIOR, EVERY FLOOR LEVEL CONTAINING A BEDROOM IS TO HAVE AT LEAST ONE OUTSIDE WINDOW W/ MIN. 0.35m² UNOBSTRUCTED OPEN PORTION W/ NO DIMENSION LESS THAN 1'-3" (380), CAPABLE OF MAINTAINING THE OPENING WITHOUT THE NEED FOR ADDITIONAL SUPPORT, CONFORMING TO 9.9.10.
 - 2) WINDOW GUARDS: A GUARD OR A WINDOW ON THE TOP OF THE WINDOW SILL IS OPENING WIDTH OF 4" (100) IS REQUIRED WHERE THE TOP OF THE WINDOW SILL IS LOCATED LESS THAN 1'-7" (480) ABOVE FIN. FLOOR AND THE DISTANCE FROM THE FINISHED FLOOR TO THE ADJACENT GRADE IS GREATER THAN 5'-11" (1800). (9.8.8.1.)
 - 3) WINDOWS IN EXIT STAIRWAYS THAT EXTEND TO LESS THAN 2'-11" (900) (3'-6" (1070) FOR ALL OTHER BUILDINGS) SHALL BE PROTECTED BY GUARDS IN ACCORDANCE WITH NOTE #2 (ABOVE), OR THE WINDOW SHALL BE NON-OPERABLE AND DESIGNED TO WITHSTAND THE SPECIFIED LOADS FOR BALCONY GUARDS AS PROVIDED IN 4.1.5.15 OR 9.8.8.2
 - 4) REFER TO TITLE PAGE FOR MAX. U-VALUE REQUIREMENTS

2.2. CEILING HEIGHTS

THE CEILING HEIGHTS OF ROOMS AND SPACES SHALL CONFORM TO TABLE 9.5.3.1.
- | ROOM OR SPACE | MINIMUM HEIGHTS |
|--------------------------------------|--|
| LIVING ROOM, DINING ROOM AND KITCHEN | 7'-7" OVER 75% OF REQUIRED FLOOR AREA WITH A CLEAR HEIGHT OF 6'-11" AT ANY POINT |
| BEDROOM | 7'-7" OVER 50% OF REQUIRED FLOOR AREA OR 6'-11" OVER ALL OF THE REQUIRED FLOOR AREA |
| BASEMENT | 6'-11" OVER AT LEAST 75% OF THE BASEMENT AREA EXCEPT THAT UNDER BEAMS AND DUCTS THE CLEARANCE IS PERMITTED TO BE REDUCED TO 6'-5". |
| BATHROOM, LAUNDRY AREA ABOVE GRADE | 6'-11" IN ANY AREA WHERE A PERSON WOULD NORMALLY BE STANDING |
| FINISHED ROOM NOT MENTIONED ABOVE | 8'-11" |
| MEZZANINES | 6'-11" ABOVE & BELOW FLOOR ASSEMBLY (9.5.3.2.) |
| STORAGE GARAGE | 6'-7" (9.5.3.3) |
- 2.3. MECHANICAL / PLUMBING

 - 1) MECHANICAL VENTILATION IS REQUIRED TO PROVIDE 0.7 AIR CHANGE PER HOUR IF NOT AIR CONDITIONED 1 PER HOUR IF AIR CONDITIONED AVERAGED OVER 24 HOURS. WHEN A VENTILATION FAN (PRINCIPAL EXHAUST) IS REQUIRED, CONFORM TO OBC 9.32.3.4. WHEN A HRV IS REQUIRED, CONFORM TO 9.32.3.11. REFER TO MECHANICAL DRAWINGS.
 - 2) REFER TO HOT WATER TANK MANUFACTURER SPECS. CONFORM TO OBC 9.31.6.
 - 3) REFER TO TITLE PAGE FOR SPACE HEATING EQUIPMENT, HRV AND DOMESTIC HOT WATER HEATER MINIMUM EFFICIENCIES.
 - 4) DRAIN WATER HEAT RECOVERY UNITS) WILL BE INSTALLED CONFORMING TO THE REQUIREMENTS OF 3.1.1.12. OF THE O.B.C.
- 2.4. LUMBER

 - 1) ALL LUMBER SHALL BE SPRUCE No.2 GRADE OR BETTER, UNLESS NOTED OTHERWISE.
 - 2) STUDS SHALL BE STUD GRADE SPRUCE, UNLESS NOTED OTHERWISE.
 - 3) LUMBER EXPOSED TO THE EXTERIOR TO BE SPRUCE No. 2 GRADE PRESSURE TREATED OR CEDAR, UNLESS NOTED OTHERWISE.
 - 4) ALL LAMINATED VENEER LUMBER (LVL) BEAMS, GIRDER TRUSSES, AND METAL HANGER CONNECTIONS SUPPORTING ROOF FRAMING TO BE DESIGNED & CERTIFIED BY FLOOR AND ROOF TRUSS MANUFACTURER.
 - 5) JOIST HANGERS: PROVIDE APPROVED METAL HANGERS FOR ALL JOISTS AND BUILT-UP WOOD MEMBERS INTERSECTING WITH FLUSH BUILT-UP WOOD MEMBERS.
 - 6) WOOD FRAMING NOT TREATED WITH A WOOD PRESERVATIVE, IN CONTACT WITH CONCRETE, SHALL BE SEPARATED FROM THE CONC. BY AT LEAST 2 mil POLYETHYLENE FILM, No.50 (4568) ROLL ROOFING OR OTHER DAMPROOFING MATERIAL. EXCEPT WHERE THE WOOD MEMBER IS AT LEAST 6" (152) ABOVE THE GROUND.
- 2.5. STEEL (9.23.4.3)

 - 1) STRUCTURAL STEEL SHALL CONFORM TO CAN/CSA-G40-21 GRADE 300W, HOLLOW STRUCT. SECTIONS SHALL CONFORM TO CAN/CSA-G40-21 GRADE 350W CLASS "H".
 - 2) REINFORCING STEEL SHALL CONFORM TO CSA-G30-18M GRADE 400R.
- 2.6. FLAT ARCHES

 - 1) FOR 8'-0" (2440) CEILINGS, FLAT ARCHES SHALL BE 6'-10" (2080) A.F.F.
 - 2) FOR 9'-0" (2740) CEILINGS, FLAT ARCHES SHALL BE 7'-10" (2400) A.F.F.
 - 3) FOR 10'-0" (3040) CEILINGS, FLAT ARCHES SHALL BE 8'-6" (2600) A.F.F..
- 2.7. ROOF OVERHANGS

 - 1) ALL ROOF OVERHANGS SHALL BE 1'-0" (305), UNLESS NOTED OTHERWISE.
- 2.8. FLASHING (9.20.13., 9.26.4, & 9.27.3)

 - 1) FLASHING MATERIALS & INSTALLATION SHALL CONFORM TO O.B.C.
- 2.9. GRADING

 - 1) THE BUILDING SHALL BE LOCATED OR THE BUILDING SITE GRADED SO THE WATER WILL NOT ACCUMULATE AT OR NEAR THE BUILDING AND WILL NOT ADVERSELY AFFECT ADJACENT PROPERTIES. CONFORM TO 9.14.6.
- 2.10. ULC SPECIFIED ASSEMBLIES

ALL REQUIRED INDIVIDUAL COMPONENTS THAT FORM PART OF ANY ULC LISTED ASSEMBLY, SPECIFIED WITHIN THESE DRAWINGS, CANNOT BE ALTERED OR SUBSTITUTED FOR ANY OTHER MATERIAL PRODUCT OR SPECIFIED MANUFACTURER THAT IS IDENTIFIED IN THAT SPECIFIED ULC LISTING. THERE SHALL BE NO DEVIATIONS UNDER ANY CIRCUMSTANCES IN ANY ULC LISTED ASSEMBLY IDENTIFIED IN THESE DRAWINGS.
- SECTION 3.0. LEGEND
- | 3.1. WOOD LINTELS AND BUILT-UP WOOD | | | |
|---|------------------|------------------|------------------|
| (DIVISION B PART 9, TABLES A8 TO A10 AND A12, A15 & A16) | | | |
| FORMING PART OF SENTENCE 9.23.4.2.(3), 9.23.4.2.(4), 9.23.12.3.(1),(3), 9.23.13.8.(2), 9.27.3.1.(1) | | | |
| 2"x8" SPRUCE #2 | 2"x10" SPRUCE #2 | 2"x12" SPRUCE #2 | 2"x12" SPRUCE #2 |
- | L1 | 212x8" (238x184) | L3 | 212x10" (238x235) | L5 | 212x12" (238x286) |
|----|------------------|----|-------------------|----|-------------------|
| B1 | 312x8" (338x184) | B3 | 312x10" (338x235) | B5 | 312x12" (338x286) |
| B2 | 412x8" (438x184) | B4 | 412x10" (438x235) | B6 | 412x12" (438x286) |
| B7 | 512x8" (538x184) | B8 | 512x10" (538x235) | B9 | 512x12" (538x286) |
- | ENGINEERED LUMBER SCHEDULE | | | |
|----------------------------|----------------------|------------------|------------------|
| 1 3/4" x 9 1/2" LVL | 1 3/4" x 11 7/8" LVL | 1 3/4" x 14" LVL | |
| LVL2 | 1-1 3/4"x9 1/2" | LVL3 | 1-1 3/4"x11 7/8" |
| LVL4 | 2-1 3/4"x9 1/2" | LVL6 | 2-1 3/4"x11 7/8" |
| LVL5 | 3-1 3/4"x9 1/2" | LVL7 | 3-1 3/4"x11 7/8" |
| LVL8 | 4-1 3/4"x9 1/2" | LVL9 | 4-1 3/4"x11 7/8" |
- | 3.2. STEEL LINTELS SUPPORTING MASONRY VENEER | | | |
|--|------|-------|-------|
| (DIVISION B PART 9, TABLE 9.20.5.2.B.) | | | |
| FORMING PART OF SENTENCE 9.20.5.2.(2) & 9.20.5.2.(3) | | | |
| CODE | SIZE | BRICK | STONE |
- | | | | |
|-----|--|-----------------|----------------|
| L7 | 3 1/2" x 3 1/2" x 1 1/4" (89 x 89 x 6.4) | 8"-1" (2.47m) | 7'-6" (2.30m) |
| L8 | 4" x 3 1/2" x 1 1/4" (102 x 89 x 6.4) | 8"-9" (2.66m) | 8'-1" (2.48m) |
| L9 | 4 7/8" x 3 1/2" x 5/16" (127 x 89 x 7.9) | 10'-10" (3.31m) | 10'-1" (3.03m) |
| L10 | 4 7/8" x 3 1/2" x 3/8" (127 x 89 x 11) | 11'-5" (3.48m) | 10'-7" (3.24m) |
| L11 | 5 7/8" x 3 1/2" x 3/8" (152 x 89 x 11) | 12'-6" (3.82m) | 11'-7" (3.54m) |
| L12 | 7 1/8" x 4 x 3/8" (178 x 102 x 11) | 14'-1" (4.30m) | 13'-1" (3.99m) |
- REFER TO SB-12 ENERGY EFFICIENCY DESIGN MATRIX ON THE TITLE PAGE FOR ALL VALUES AS REQUIRED PER 3.1.1., 3.1.2., 3.1.3. OF THE OBC.
- 3.3. DOOR SCHEDULE
- | CONFORMING TO SECTIONS 9.5.11, 9.6., 9.7.2.1, 9.7.5.2, & 9.10.13.10 | |
|---|---|
| 1 | EXTERIOR 2'-8" x 6'-8" x 1-3/4" (815 x 2030 x 45) INSULATED MIN. R4 (RSI 0.7) |
| 1A | EXTERIOR 2'-10" x 6'-8" x 1-3/4" (865 x 2030 x 45) INSULATED MIN. R4 (RSI 0.7) |
| 1B | EXTERIOR 3'-0" x 6'-8" x 1-3/4" (915 x 2030 x 45) INSULATED MIN. R4 (RSI 0.7) |
| 1C | EXTERIOR 2'-6" x 6'-8" x 1-3/4" (760 x 2030 x 45) INSULATED MIN. R4 (RSI 0.7) |
| 1D | EXTERIOR 2'-8" x 6'-8" x 1-3/4" (815 x 2030 x 45) INS. MIN. R4 (RSI 0.7) (SEE HEX NOTE 20) |
| 1E | EXTERIOR 3'-0" x 8'-0" x 1-3/4" (915 x 2440 x 45) INSULATED MIN. R4 (RSI 0.7) |
| 1F | EXTERIOR 2'-8" x 8'-0" x 1-3/4" (815 x 2440 x 45) INSULATED MIN. R4 (RSI 0.7) |
| 2A | EXTERIOR 2'-8" x 6'-8" x 1-3/4" (815 x 2030 x 45) 20 MIN. F.R.R. DOOR FRAME WITH APP. SELF CLOSING DEVICE |
| 2 | INTERIOR 2'-8" x 6'-8" x 1-3/8" (815 x 2030 x 35) |
| 3 | INTERIOR 2'-6" x 6'-8" x 1-3/8" (760 x 2030 x 35) |
| 3A | INTERIOR 2'-4" x 6'-8" x 1-3/8" (710 x 2030 x 35) |
| 4 | INTERIOR 2'-4" x 6'-8" x 1-3/8" (610 x 2030 x 35) |
| 4A | INTERIOR 2'-2" x 6'-8" x 1-3/8" (660 x 2030 x 35) |
| 5 | INTERIOR 1'-6" x 6'-8" x 1-3/8" (460 x 2030 x 35) |
- 3.4. ACRONYMS
- | ABOVE FINISHED FLOOR | - JUST | JOIST |
|----------------------|------------------------------|-------|
| BBFM | BEAM BY FLOOR MANUFACTURER | LIN |
| BG | FIXED GLASS W/ BLACK BACKING | LVL |
| BM | BEAM | OTB/A |
| BBFM | BEAM BY ROOF MANUFACTURER | PL |
| CRF | CONVENTIONAL ROOF FRAMING | PLT |
| C/W | COMPLETE WITH | PT |
| DJ/TJ | DOUBLE JOIST/ TRIPLE JOIST | PTD |
| DO | DO OVER | PWD |
| DRP | DROPPED | RWL |
| ENG | ENGINEERED | SB |
| EST | ESTIMATED | SBFA |
| FA | FLAT ARCH | SJ |
| FD | FLOOR DRAIN. | SPR |
| FG | FIXED GLASS | STL |
| FL | FLUSH | T/O |
| FLR | FLOOR | TYP |
| GT | GIRDER TRUSS | U/S |
| HB | HOSE BIB | WD |
| HRV | HEAT RETURN VENTILATION UNIT | WIC |
| HWT | HOT WATER TANK | WP |
| ENG | ENGINEERED | SB |
| EST | ESTIMATED | SBFA |
| FA | FLAT ARCH | SJ |
| FD | FLOOR DRAIN. | SPR |
| FG | FIXED GLASS | STL |
| FL | FLUSH | T/O |
| FLR | FLOOR | TYP |
| GT | GIRDER TRUSS | U/S |
| HB | HOSE BIB | WD |
| HRV | HEAT RETURN VENTILATION UNIT | WIC |
| HWT | HOT WATER TANK | WP |
- 3.5. SYMBOLS
- | ALL ELECTRICAL FACILITIES SHALL BE INSTALLED IN ACCORDANCE WITH SECTION 9.9.4. | |
|--|--|
| CLASS 'B' VENT | EXHAUST VENT |
| DUPLEX OUTLET (12" HIGH) | DUPLEX OUTLET (HEIGHT AS NOTED A.F.F.) |
| HEAVY DUTY OUTLET | SWITCH (2/3/4 WAY) |
| POT LIGHT | LIGHT FIXTURE (CEILING MOUNTED) |
| LIGHT FIXTURE (PULL CHAIN) | LIGHT FIXTURE (WALL MOUNTED) |
| CABLE T.V. JACK | TELEPHONE JACK |
| CENTRAL VACUUM OUTLET | CHANDELER (CEILING MOUNTED) |
- SA SMOKE ALARM (9-10.19)
- PROVIDE ONE PER FLOOR, NEAR THE STAIRS CONNECTING THE FLOOR LEVEL. ALARMS ARE TO BE INSTALLED IN EACH SLEEPING ROOM AND IN A LOCATION BETWEEN SLEEPING ROOMS AND CONNECTING HALLWAYS AND WIRED TO BE INTERCONNECTED TO ACTIVATE ALL ALARMS IF ONE SOUNDS. ALARMS ARE TO BE CONNECTED TO AN ELECTRICAL CIRCUIT AND WITH A BATTERY BACKUP. ALARM SIGNAL SHALL MEET TEMPORAL SOUND PATTERNS MIN. ALARMS SHALL HAVE A VISUAL SIGNALLING COMPONENT AS PER THE NATIONAL FIRE ALARM AND SIGNALING CODE 72.
- CMD CARBON MONOXIDE ALARM (9.33.4.)
- ** CHECK LOCAL BY-LAWS FOR REQUIREMENTS ** A CARBON MONOXIDE ALARM(S) CONFORMING TO CAN/CSA-6.19 SHALL BE INSTALLED ON OR NEAR THE CEILING IN EACH DWELLING UNIT ADJACENT TO EACH SLEEPING AREA. CARBON MONOXIDE ALARM(S) SHALL BE PERMANENTLY WIRED WITH NO DISCONNECT SWITCH, WITH AN ALARM THAT IS AUDIBLE WITHIN SLEEPING ROOMS WHEN THE INTERVENING DOORS ARE CLOSED.
- SB SOLID BEARING (BUILT-UP WOOD COLUMNS AND STUD POSTS)
- THE WIDTH OF A WOOD COLUMN SHALL NOT BE LESS THAN THE WIDTH OF SUPPORTED MEMBER. BUILT-UP WOOD COLUMNS SHALL BE NAILED TOGETHER WITH NOT LESS THAN 3" (76) NAILS SPACED NOT MORE THAN 11 3/4" (300) O.C. THE NUMBER OF STUDS IN A WALL DIRECTLY BELOW A GIRDER TRUSS OR ROOF BEAM SHALL CONFORM TO TABLES A-34 TO A-37. (9-17.4., 9.23.10.7.)
- TWO STOREY VOLUME SPACE. SEE CONSTRUCTION NOTE 39.
- VARYING PLATES, BUILT-OUT FLOORS, BEARING WALLS, ICE & WATER SHIELD
- EXPOSED BUILDING FACE - O.B.C. 9.10.14. OR 9.10.15.
REFER TO HEX NOTE 35. & DETAILS FOR TYPE AND SPECIFICATIONS.
- | | |
|---|--|
| 1 HR. PARTY WALL
REFER TO HEX NOTE 40. | 2 HR. FIREWALL
REFER TO HEX NOTE 40A. |
|---|--|
- SECTION 4.0. CLIMATIC DATA
- | | |
|------------------------------|----------|
| DESIGN SNOW LOAD (9.4.2.2.): | 1.23 kPa |
| WIND LOAD (q50) (SB-1.2.): | 0.44 kPa |
- STAMP
-
- FOR STRUCTURAL ONLY
NOT INCLUDING ENGINEERED
FLOOR OR ROOF SYSTEM
- CONTRACTOR MUST VERIFY ALL DIMENSIONS ON THE OR. REPORT ANY DISCREPANCIES TO HUNT DESIGN ASSOCIATES INC. (H.D.A.) BEFORE PROCEEDING WITH THE WORK. THE DRAWINGS & SPECIFICATIONS ARE THE INSTRUMENTS OF SERVICE AND ARE THE PROPERTY OF H.D.A. ALL CONSTRUCTION TO ADHERE TO THESE PLANS AND SPECIFICATIONS AND TO CONFORM TO THE ONTARIO BUILDING CODE AND ALL OTHER APPLICABLE CODES AND AUTHORITIES HAVING JURISDICTION. THESE REQUIREMENTS ARE TO BE TAKEN AS MINIMUM SPECIFICATIONS. ONT. REG. 332/12.
- CONSTRUCTION NOTES 2
- UNDESIGNED HAS REVIEWED AND TAKES RESPONSIBILITY FOR THIS SET OF DRAWINGS. ANY DISCREPANCIES AND MEETS THE REQUIREMENTS SET OUT IN THE ONTARIO BUILDING CODE AS SET BY A DESIGNER.

37308
BOB

SIGNATURE
GREG R. SANTOS

19655

www.huntassociatesinc.ca

DESIGN ASSOCIATES INC.

ROYAL PINE HOMES - 216102
'CENTREFIELD', WEST GORMLEY, RICHMOND HILL, ON.

UNIT 2008
REV.2021.03.24

216102WT2008
F 905.737.7326

14 of 14
- IMMEDIATELY | MON MAY 17/21 04:28 PM | K:\PROJECTS\2016\12\FLOWWORKING\TOWNSHIP\216102WT2008.DWG

