


Lot 100 - Summer Ridge - Inventory House

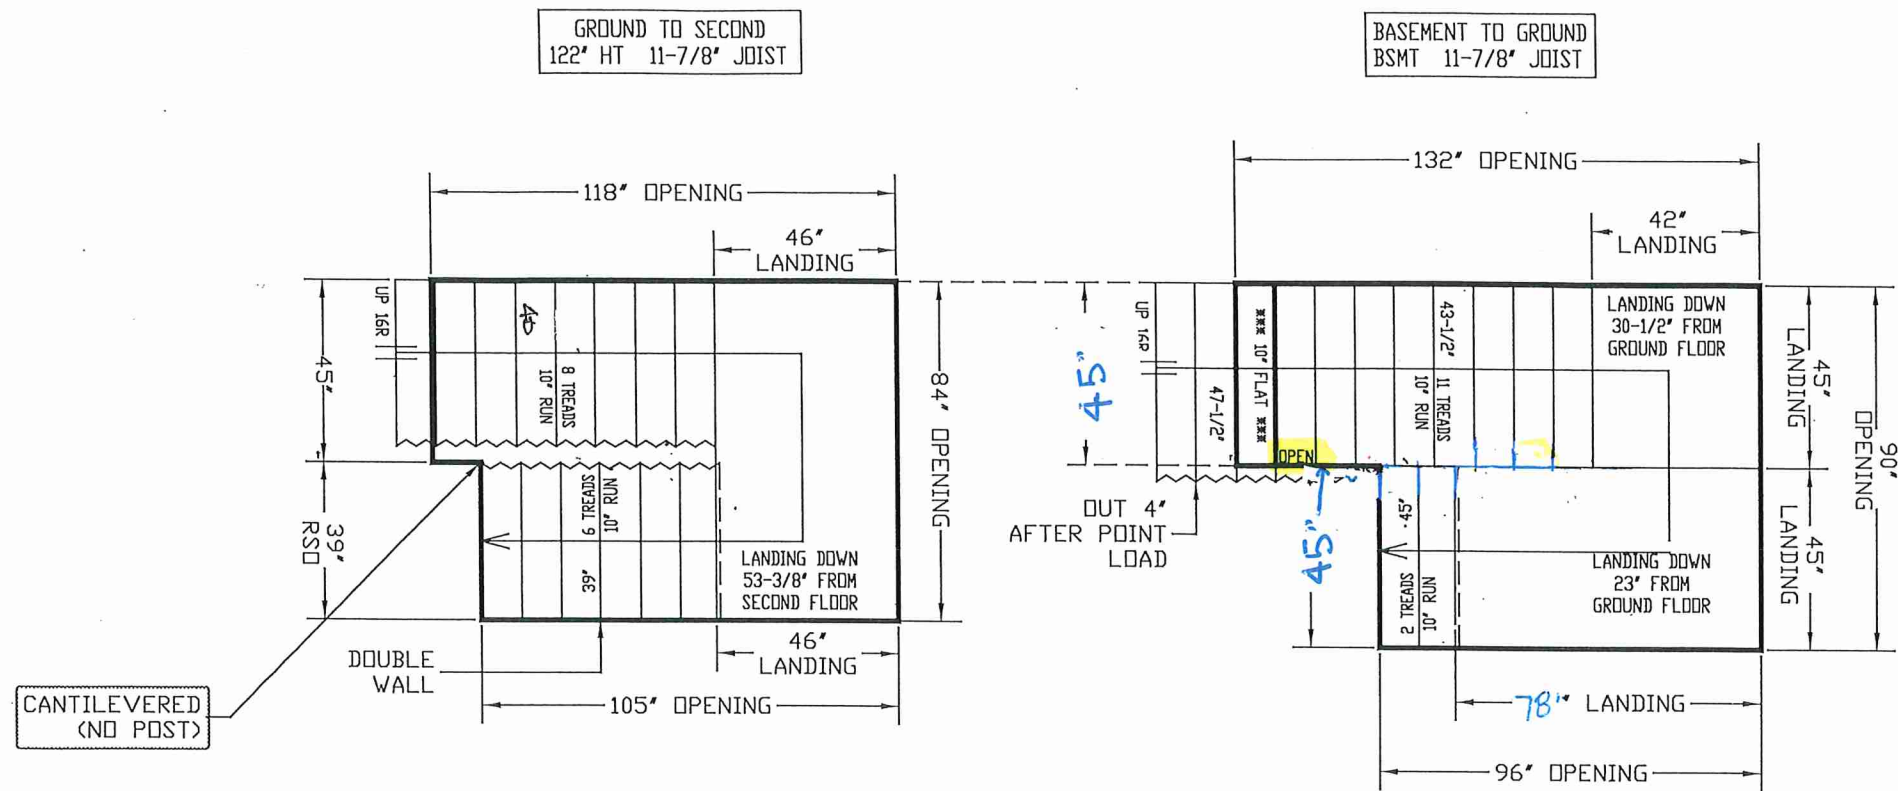

REVISED
MAY 27, 2025

ALL OPENINGS ARE ALLOWED FOR 1 LAYER OF DRY WALL
ANY ADDITIONAL LAYERS MUST BE ALLOWED BY CARPENTERS

STAIRS LINE UP BY
GARAGE WALL

2" CONC. LEDGE
IN GARAGE

GARAGE RIGHT >

NO WALLS UNTIL
STAIRS INSTALLED




ALL LANDINGS TO BE SUPPLIED AND SUPPORTED BY OTHERS UNLESS SPECIFIED ABOVE
ANY STRAPPING ALLOWANCES TO BE COMPENSATED BY CARPENTERS
ALL STAIR DIMENSIONS MAY BE MODIFIED FROM ORIGINAL BLUE PRINTS OR SPECS AS SUPPLIED TO ALPA STAIRS AND RAILINGS INC. MEASUREMENTS SHOWN ON LAYOUTS ARE REQUIRED TO INSTALL OUR STAIRS. ANY PROBLEM WITH HEADROOM OR STRAPPING ALLOWANCES, ALPA STAIRS AND RAILINGS INC. WILL NOT BE RESPONSIBLE. STAIR LAYOUTS SHOULD BE CHECKED BY CARPENTERS OR SITE SUPERS TO MAKE SURE THERE ARE NO DISCREPANCIES BEFORE PROCEEDING WITH CONSTRUCTION

ALPA STAIRS AND RAILINGS INC.
3770 NASHUA DRIVE, UNIT 3 MISSISSAUGA, ONTARIO L4V 1M6
TEL: (905) 694-9556 | www.alpastairs.com



SITE
MAYFIELD
VILLAGE
LOT #
Model
4001
(LOT 100)

NAME	DATE
DRAWN BY PARAMJEET	
CLIENT SUMMER RIDGE EST. INC	
LAYOUT #	
SCALE: 1/35	

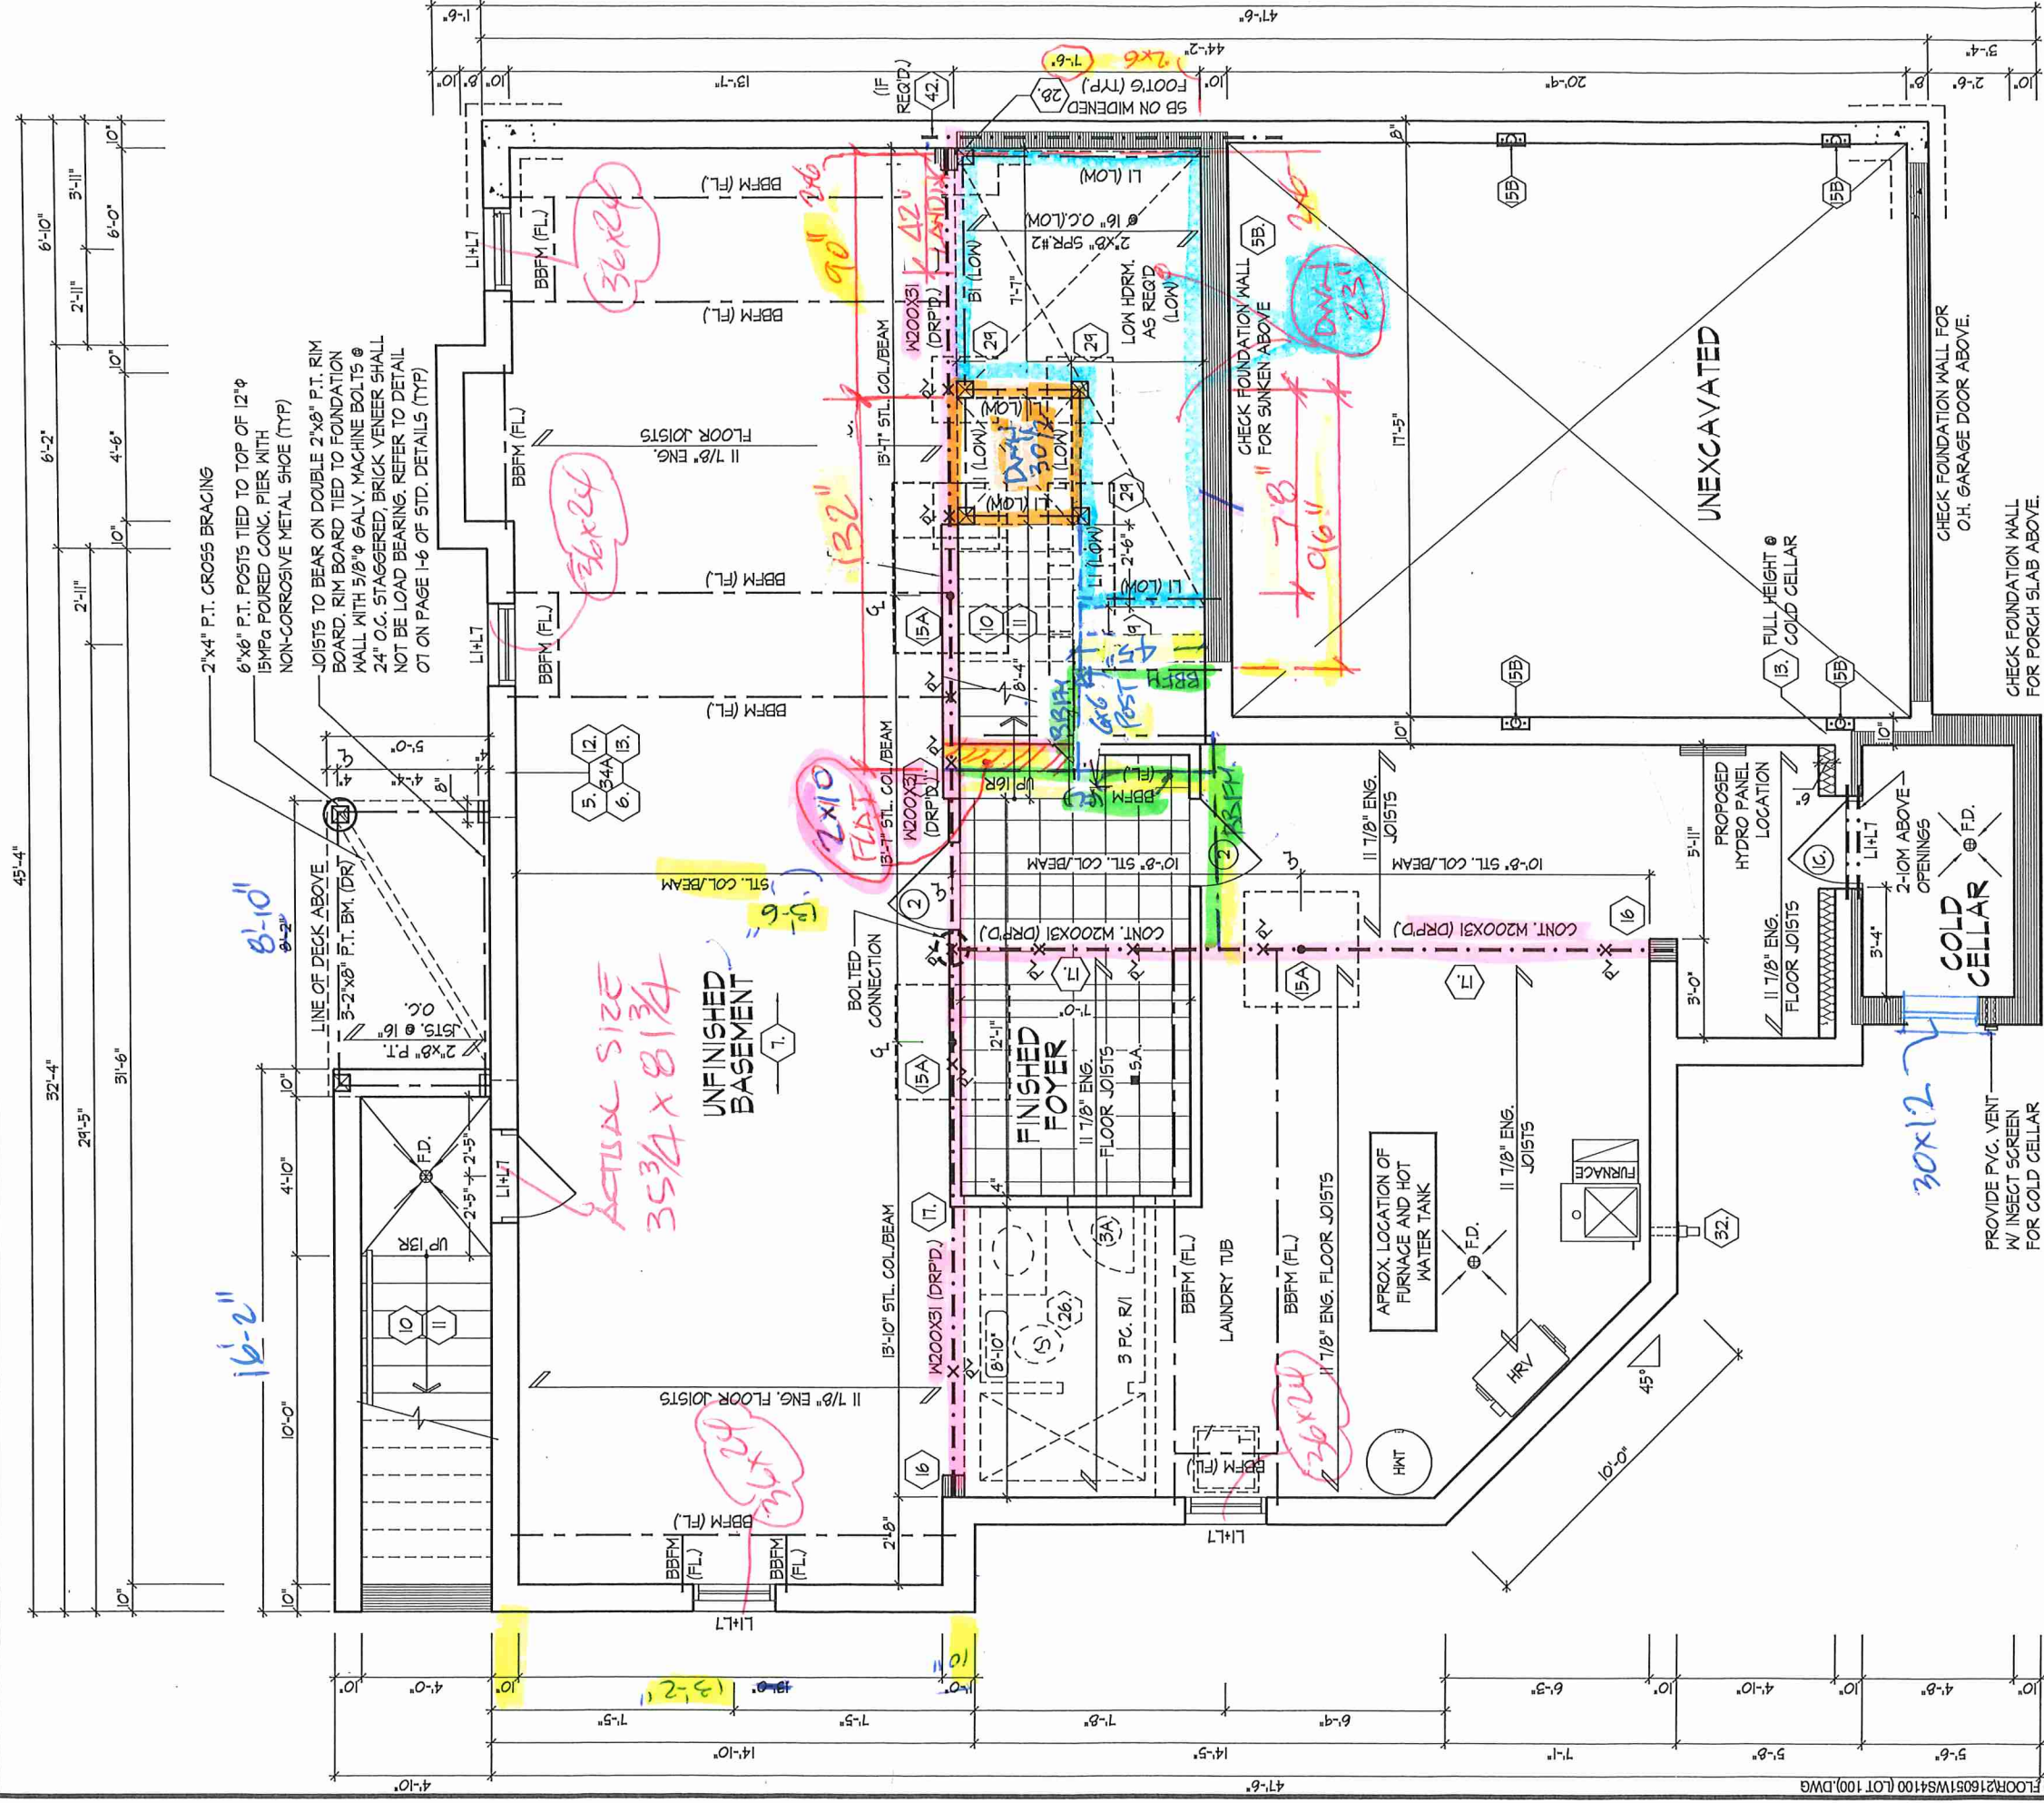

BASEMENT PLAN, EL. 'A'

REFER TO FLOOR JOIST MANUFACTURER'S DRAWINGS FOR LAYOUT, SPACING, BLOCKING & STRAPPING REQUIREMENTS, INSTALLATION DETAILS AND HANGER SIZES, & SUBFLOOR THICKNESS

PROVIDE SOLID WOOD BLOCKING @ 24" O.C. FOR FIRST JOIST SPAN WHEN PARALLEL W/ EXTERIOR WALL

9'-0" Bsmt
9'-0" 1st Floor
8'-0" 2nd Floor

BASEMENT PLAN, EL. 'A'


Royal Pine Homes/Summer Ridge Estates Inc.-216051 UNIT 4100(LOT 100)
"MAYFIELD VILLAGE", BRAMPTON, ON.
REV.2024.07.24



THE UNDERSIGNED HAS REVIEWED AND TAKES RESPONSIBILITY FOR THIS DESIGN AND HAS THE QUALIFICATIONS AND MEETS THE REQUIREMENTS SET OUT IN THE ONTARIO BUILDING CODE TO BE A DESIGNER.

NAME	Shudong Zhao	SIGNATURE		124648	BCN	19695
REGISTRATION INFORMATION						
HUNT DESIGN ASSOCIATES INC.						
Drawn By	WT	Checked By	MM/DS	Scale	3/16"=1'-0"	216051WS4100 (LOT 100)
File Number						2 of 11
Page Number						

8966 Woodbine Ave, Markham, ON L3R 0J7 T 905.737.5133 F 905.737.7326
All drawings specifications related documents and design are the copyright property of Hunt Design Associates (H.D.A.). Reproduction of this property in whole or in part is strictly prohibited without H.D.A.'s written permission (H.D.A. assumes no responsibility or liability for this property unless it bears the appropriate BCN number and original signature.

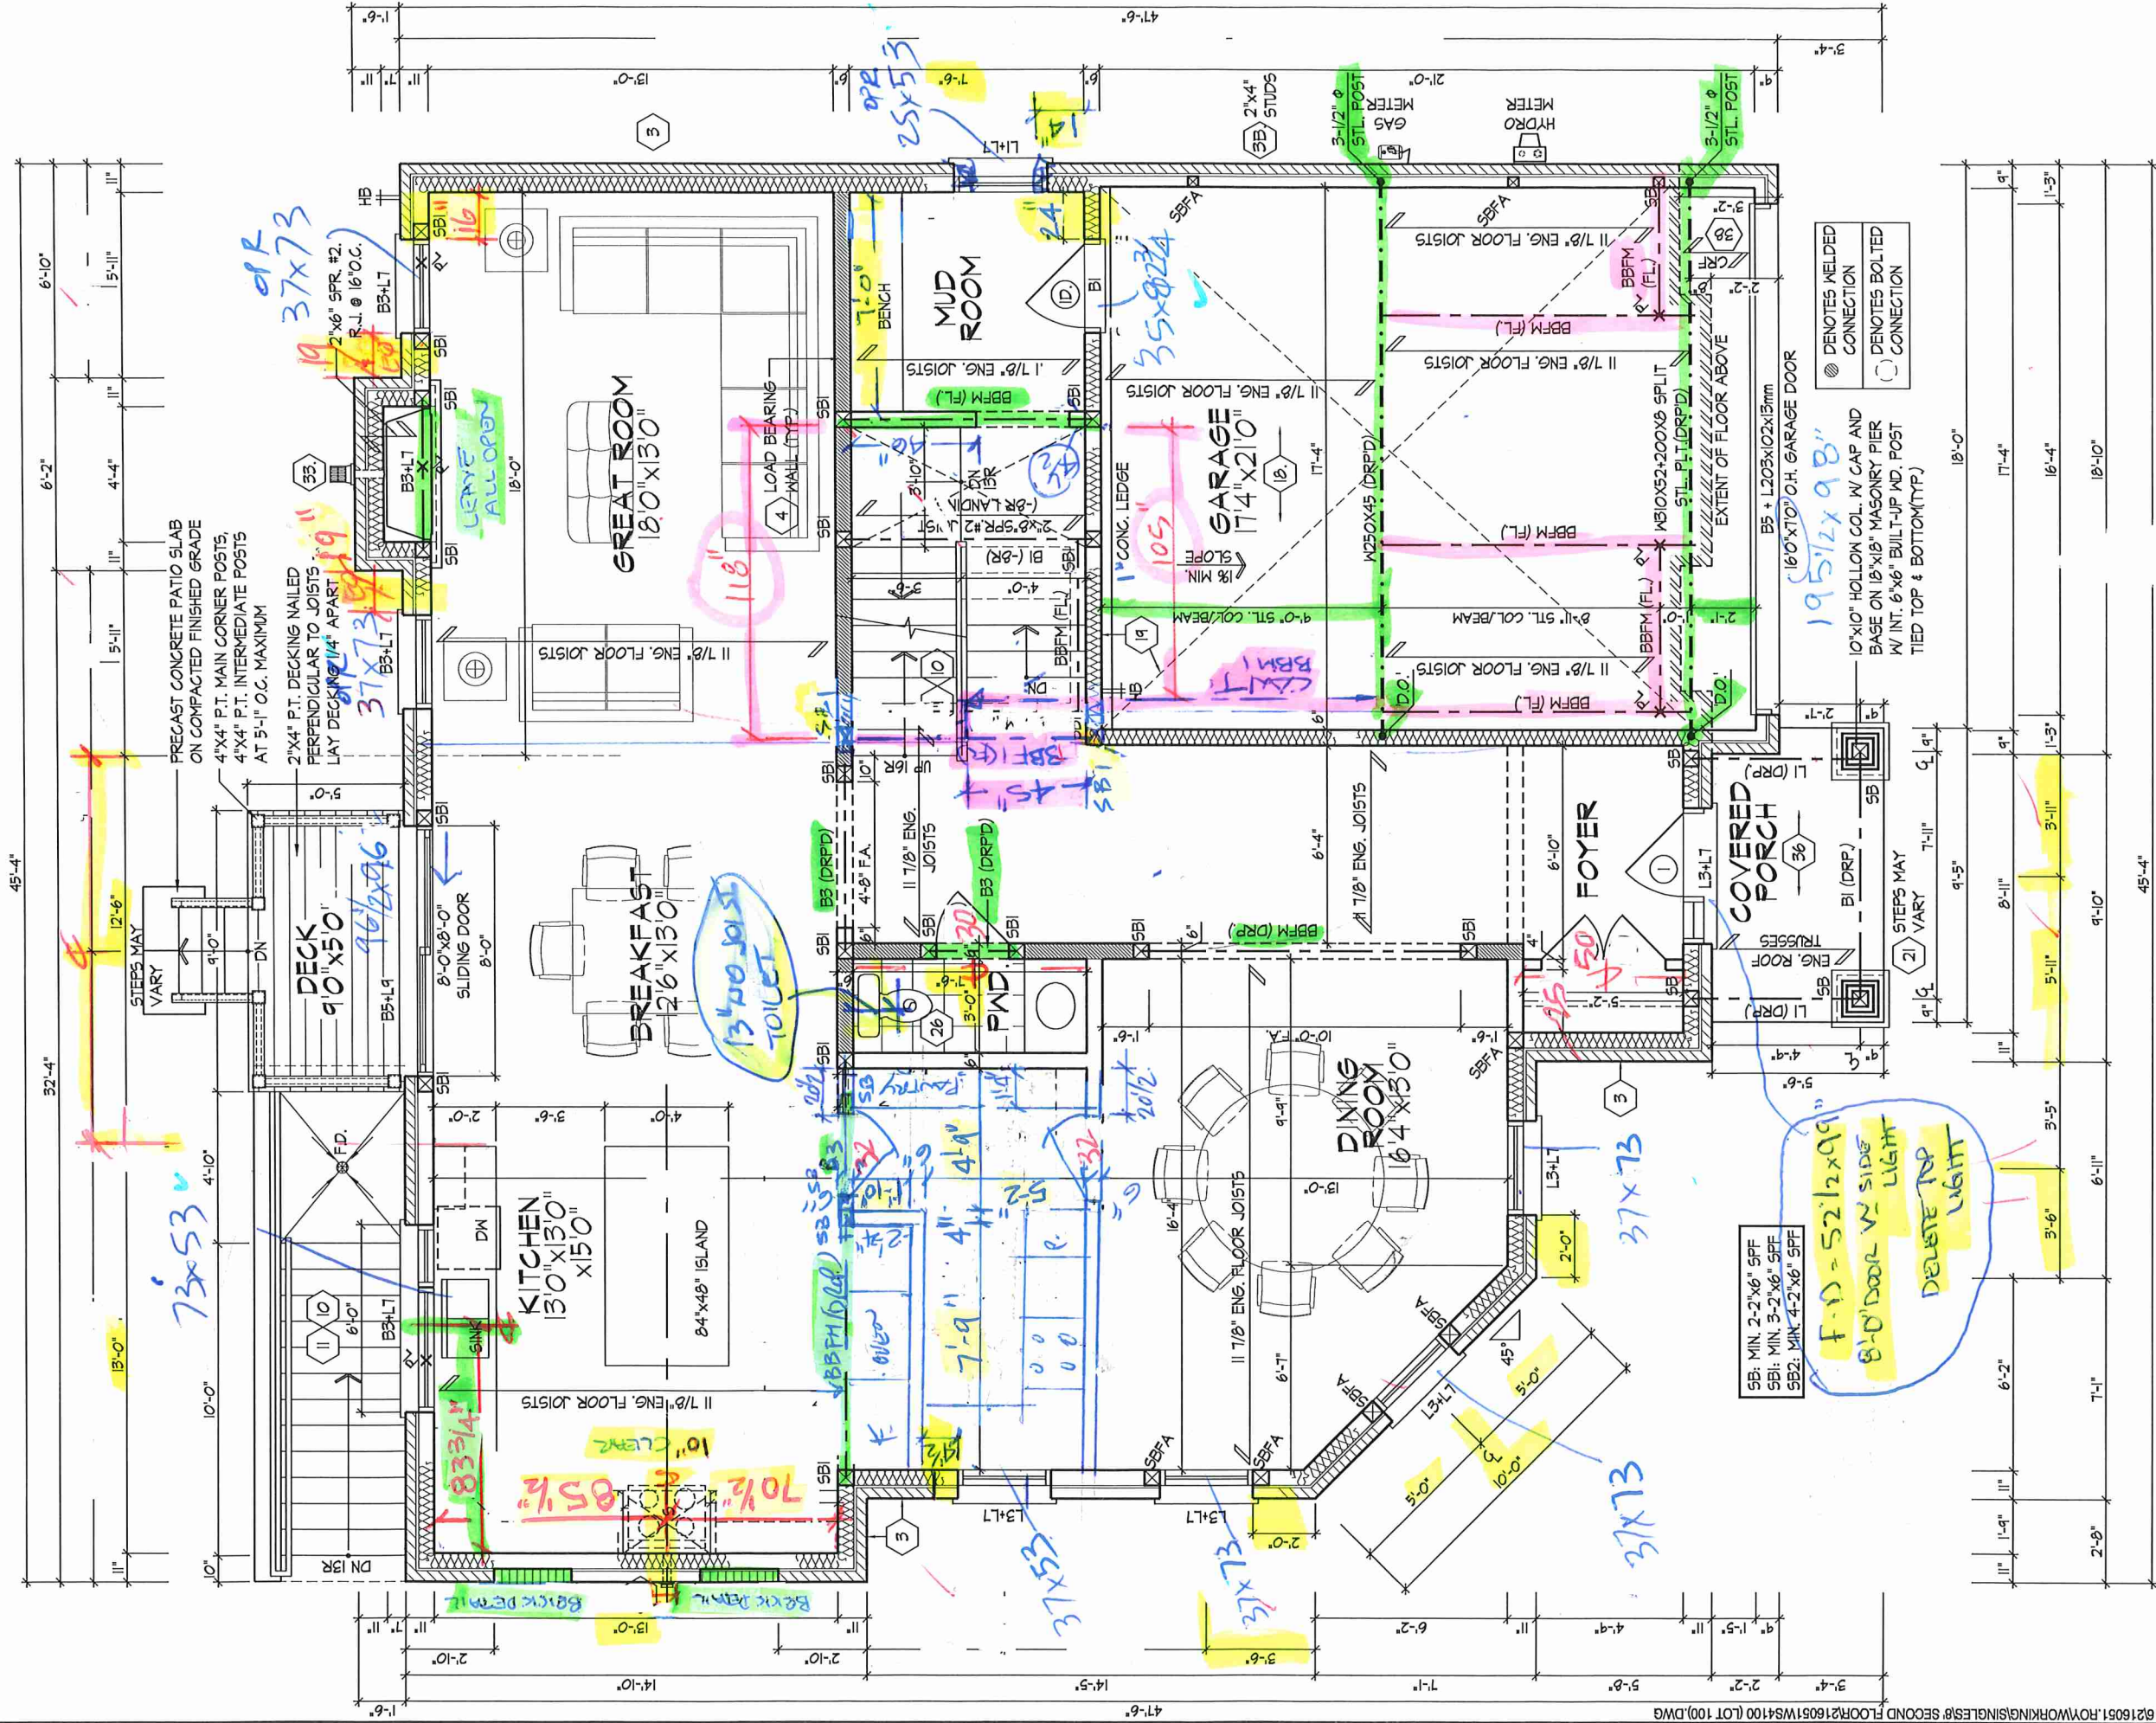



GROUND FLOOR PLAN, EL. 'A'

- Doors = 98 1/2"
- Windows = 96 1/2"
- S/D = 96 1/2"
- Arches = 95"

REFER TO FLOOR JOIST MANUFACTURER'S DRAWINGS FOR LAYOUT, SPACING, BLOCKING & STRAPPING REQUIREMENTS, INSTALLATION DETAILS AND HANGER SIZES, & SUBFLOOR THICKNESS

PROVIDE SOLID WOOD BLOCKING @ 24" O.C. FOR FIRST JOIST SPAN WHEN PARALLEL W/ EXTERIOR WALL



GROUND FLOOR PLAN, EL. 'A'

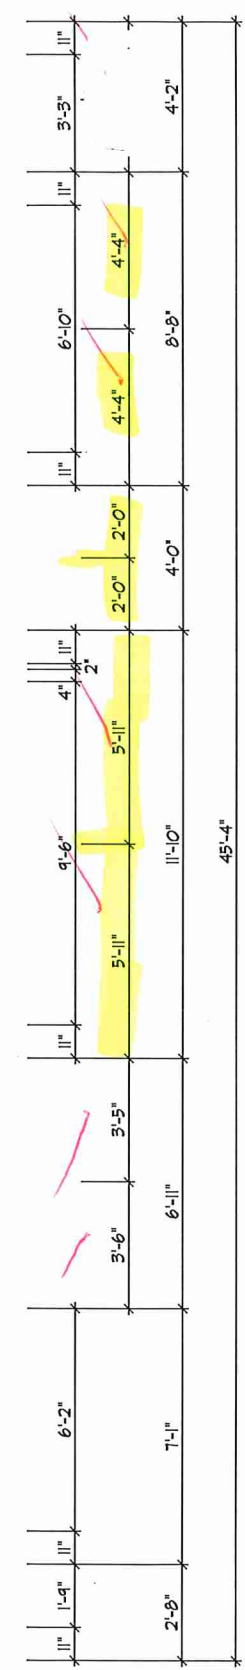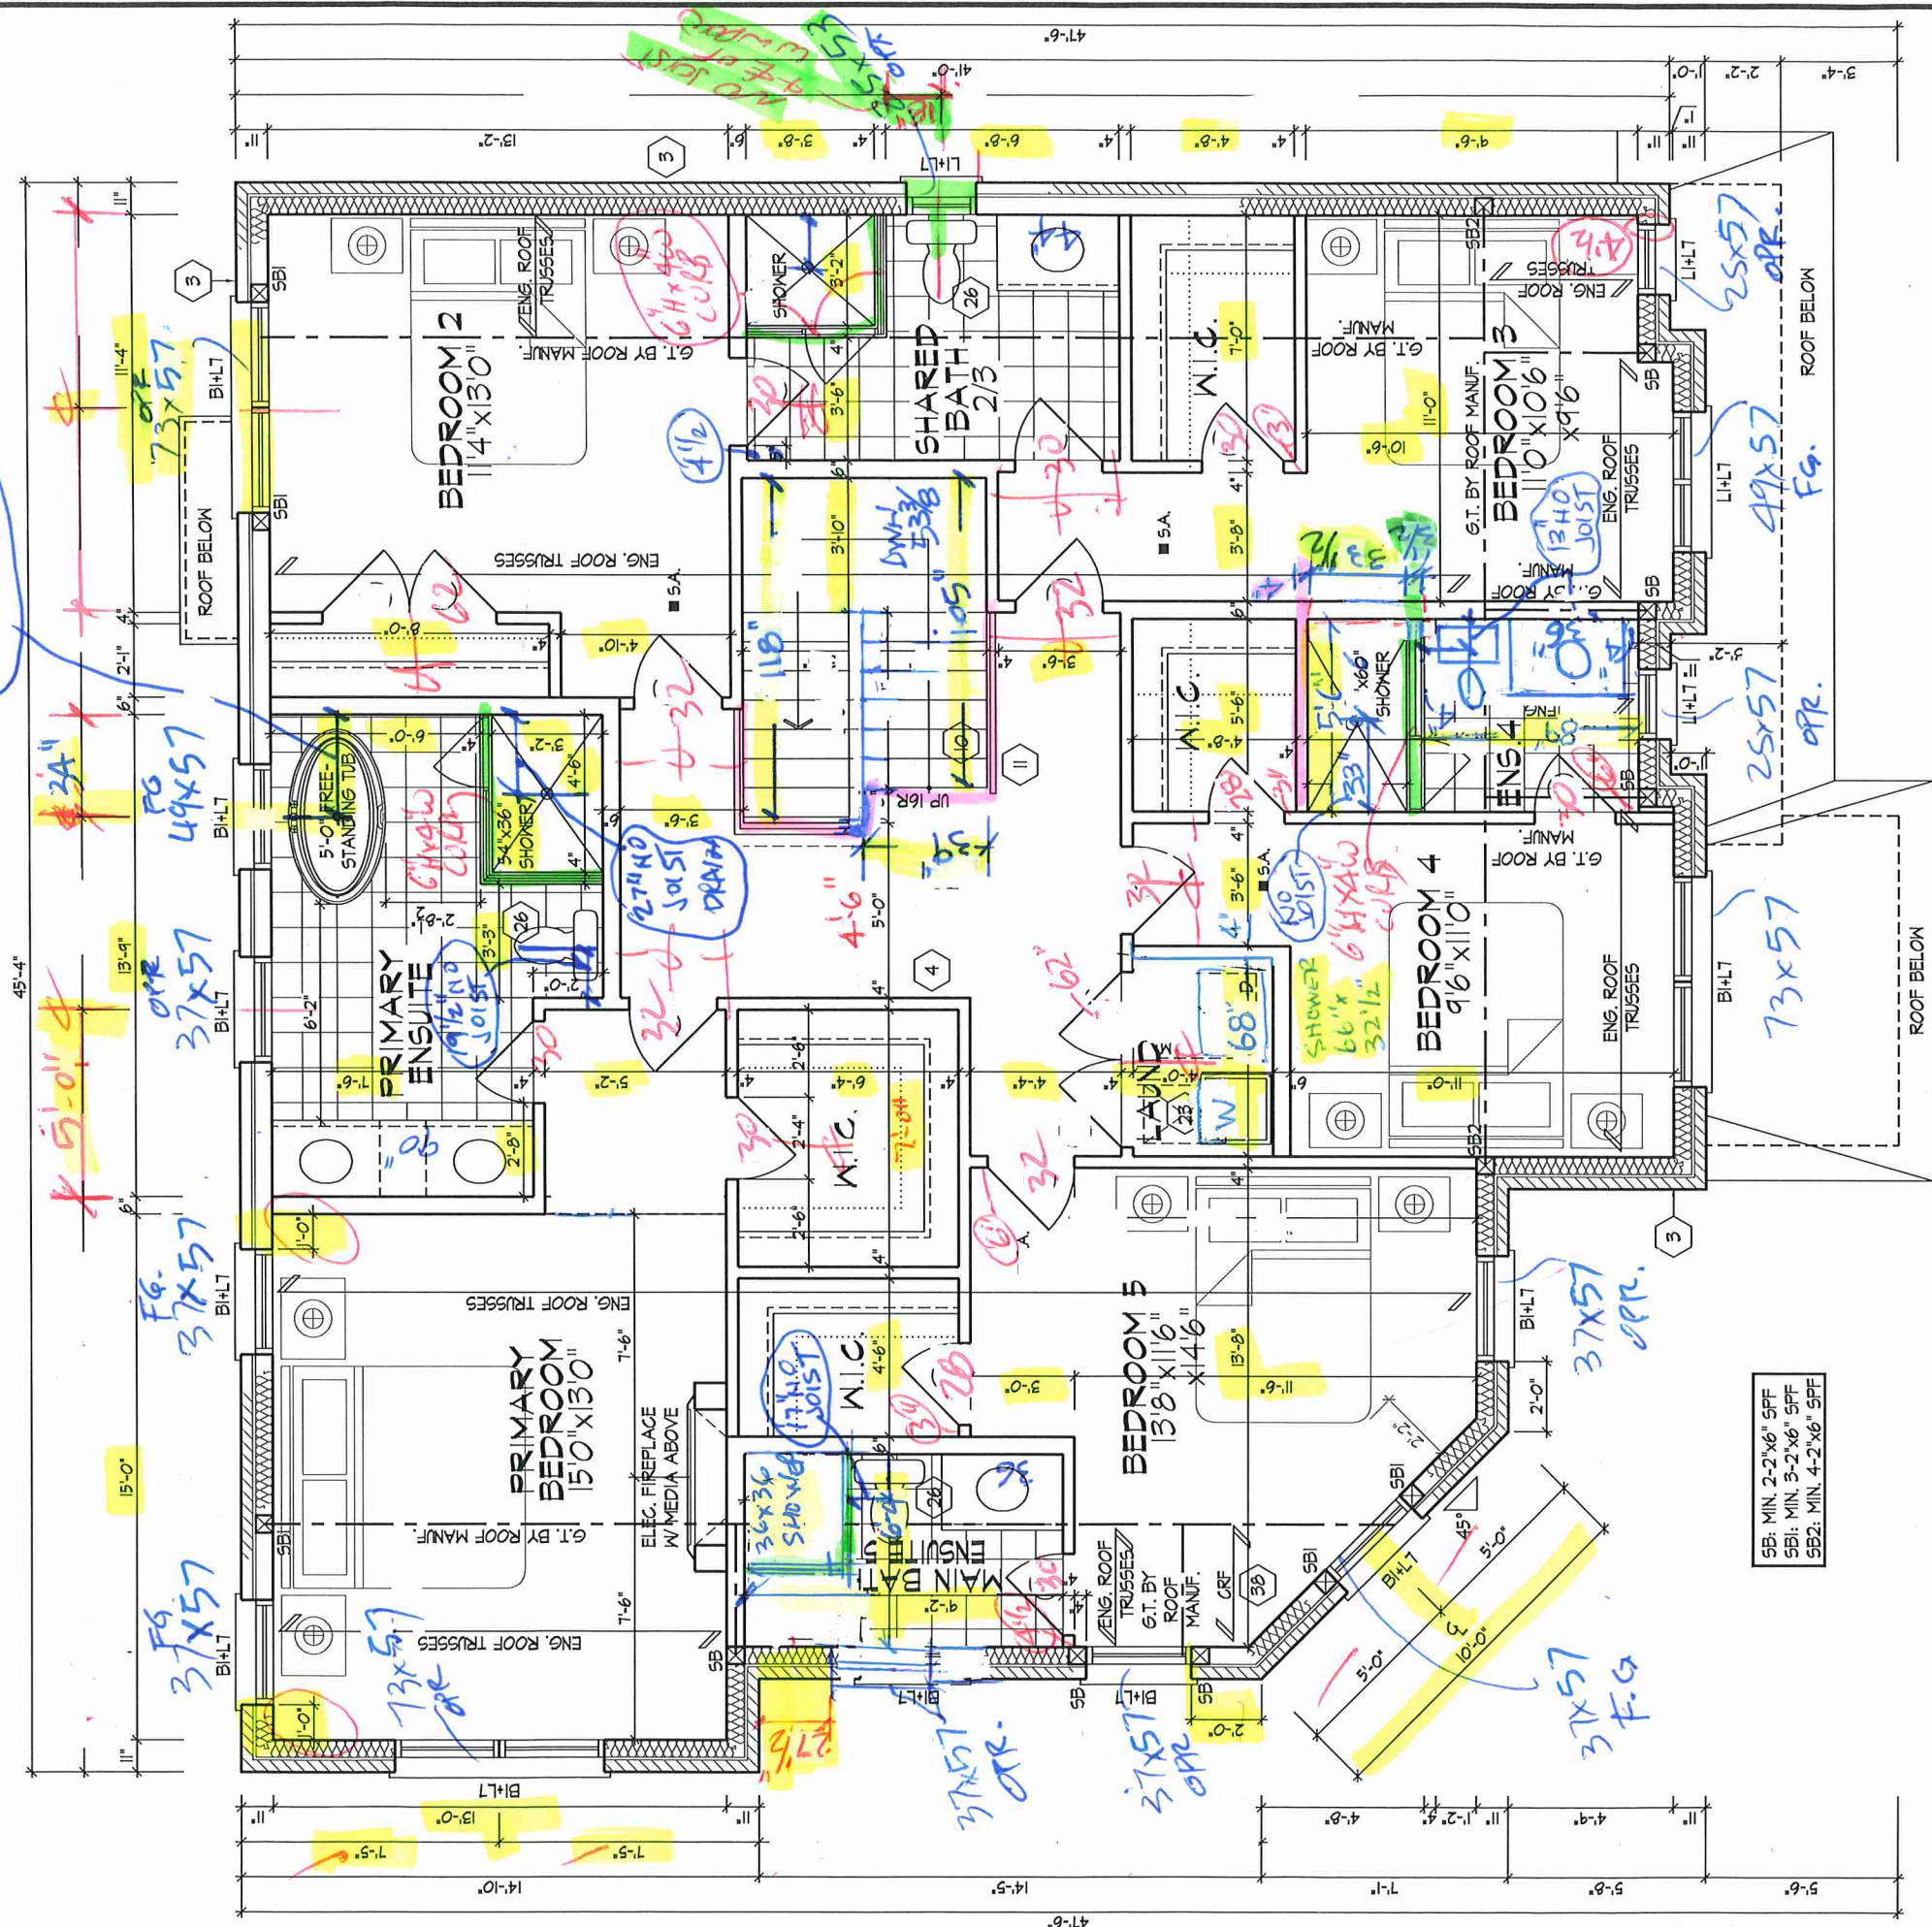


SECOND FLOOR PLAN, EL. 'A'

REFER TO ROOF TRUSS MANUFACTURER'S DRAWINGS FOR LAYOUT, SPACING, INSTALLATION DETAILS AND HANGER SIZES.

NOTE:
STEP TRUSSES @ RAISED / COFFERED CEILINGS

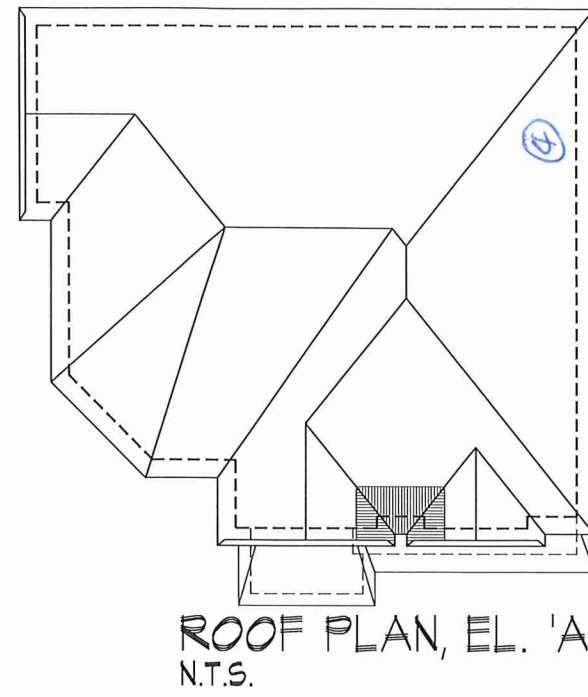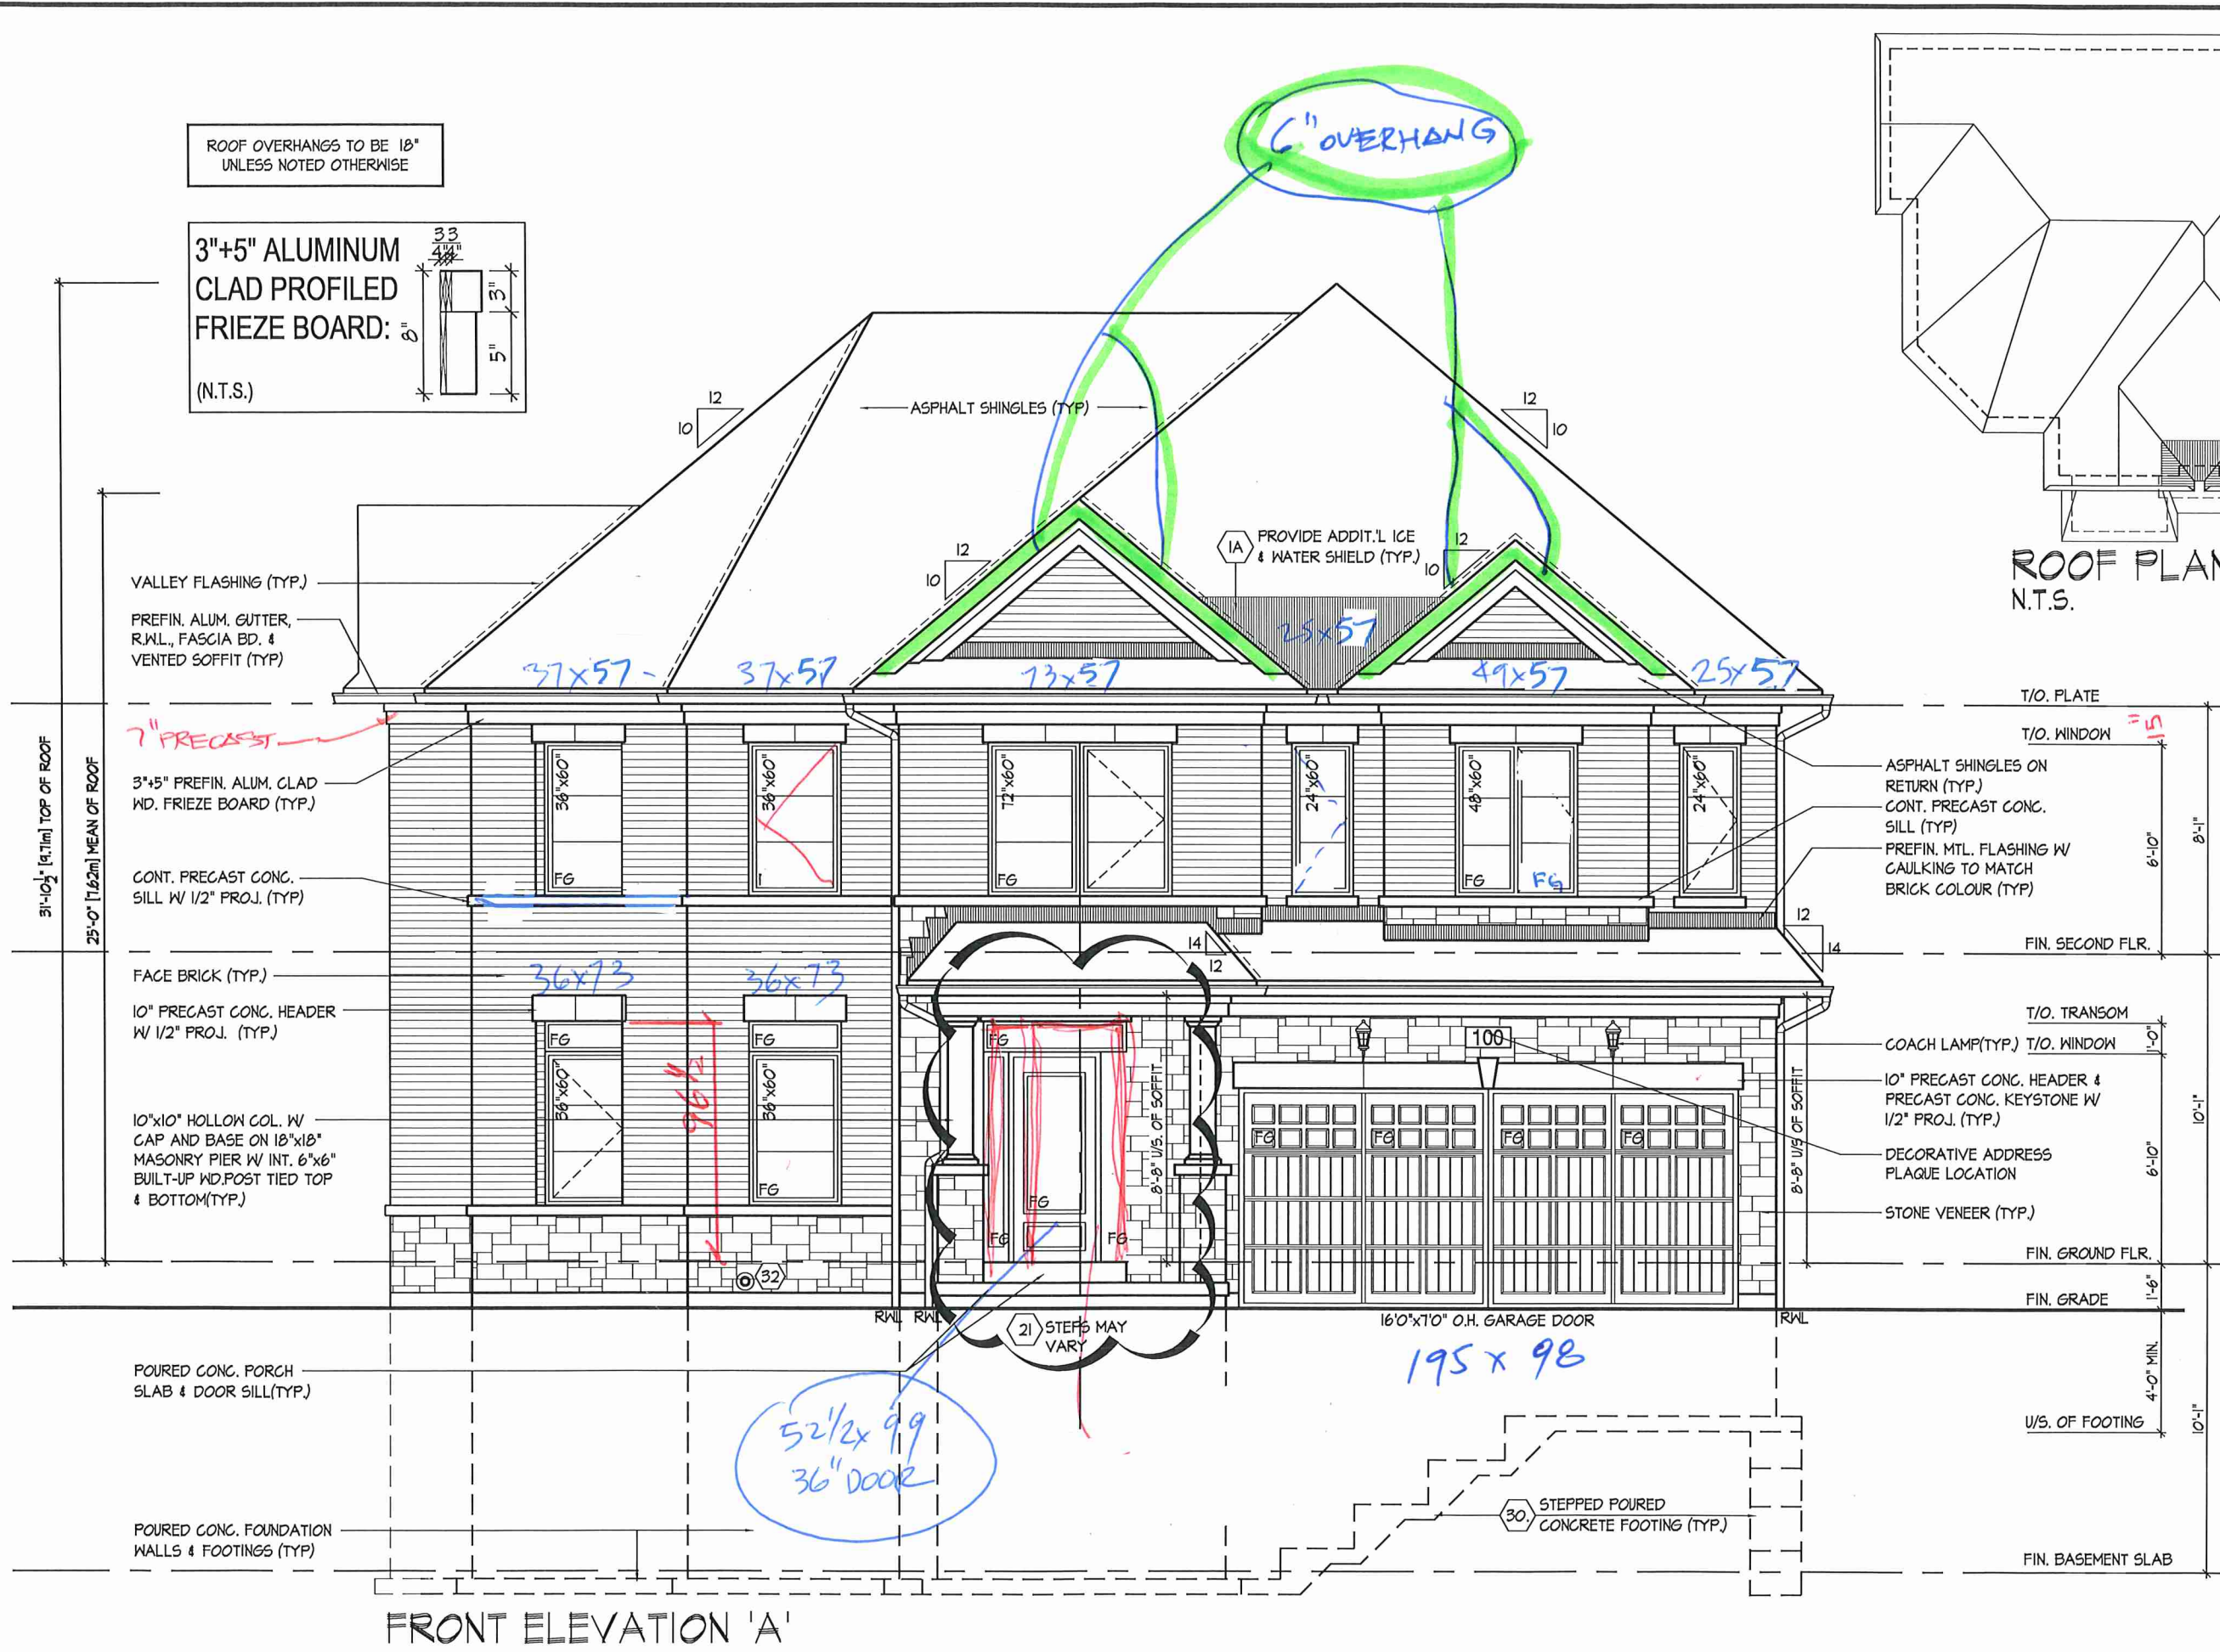

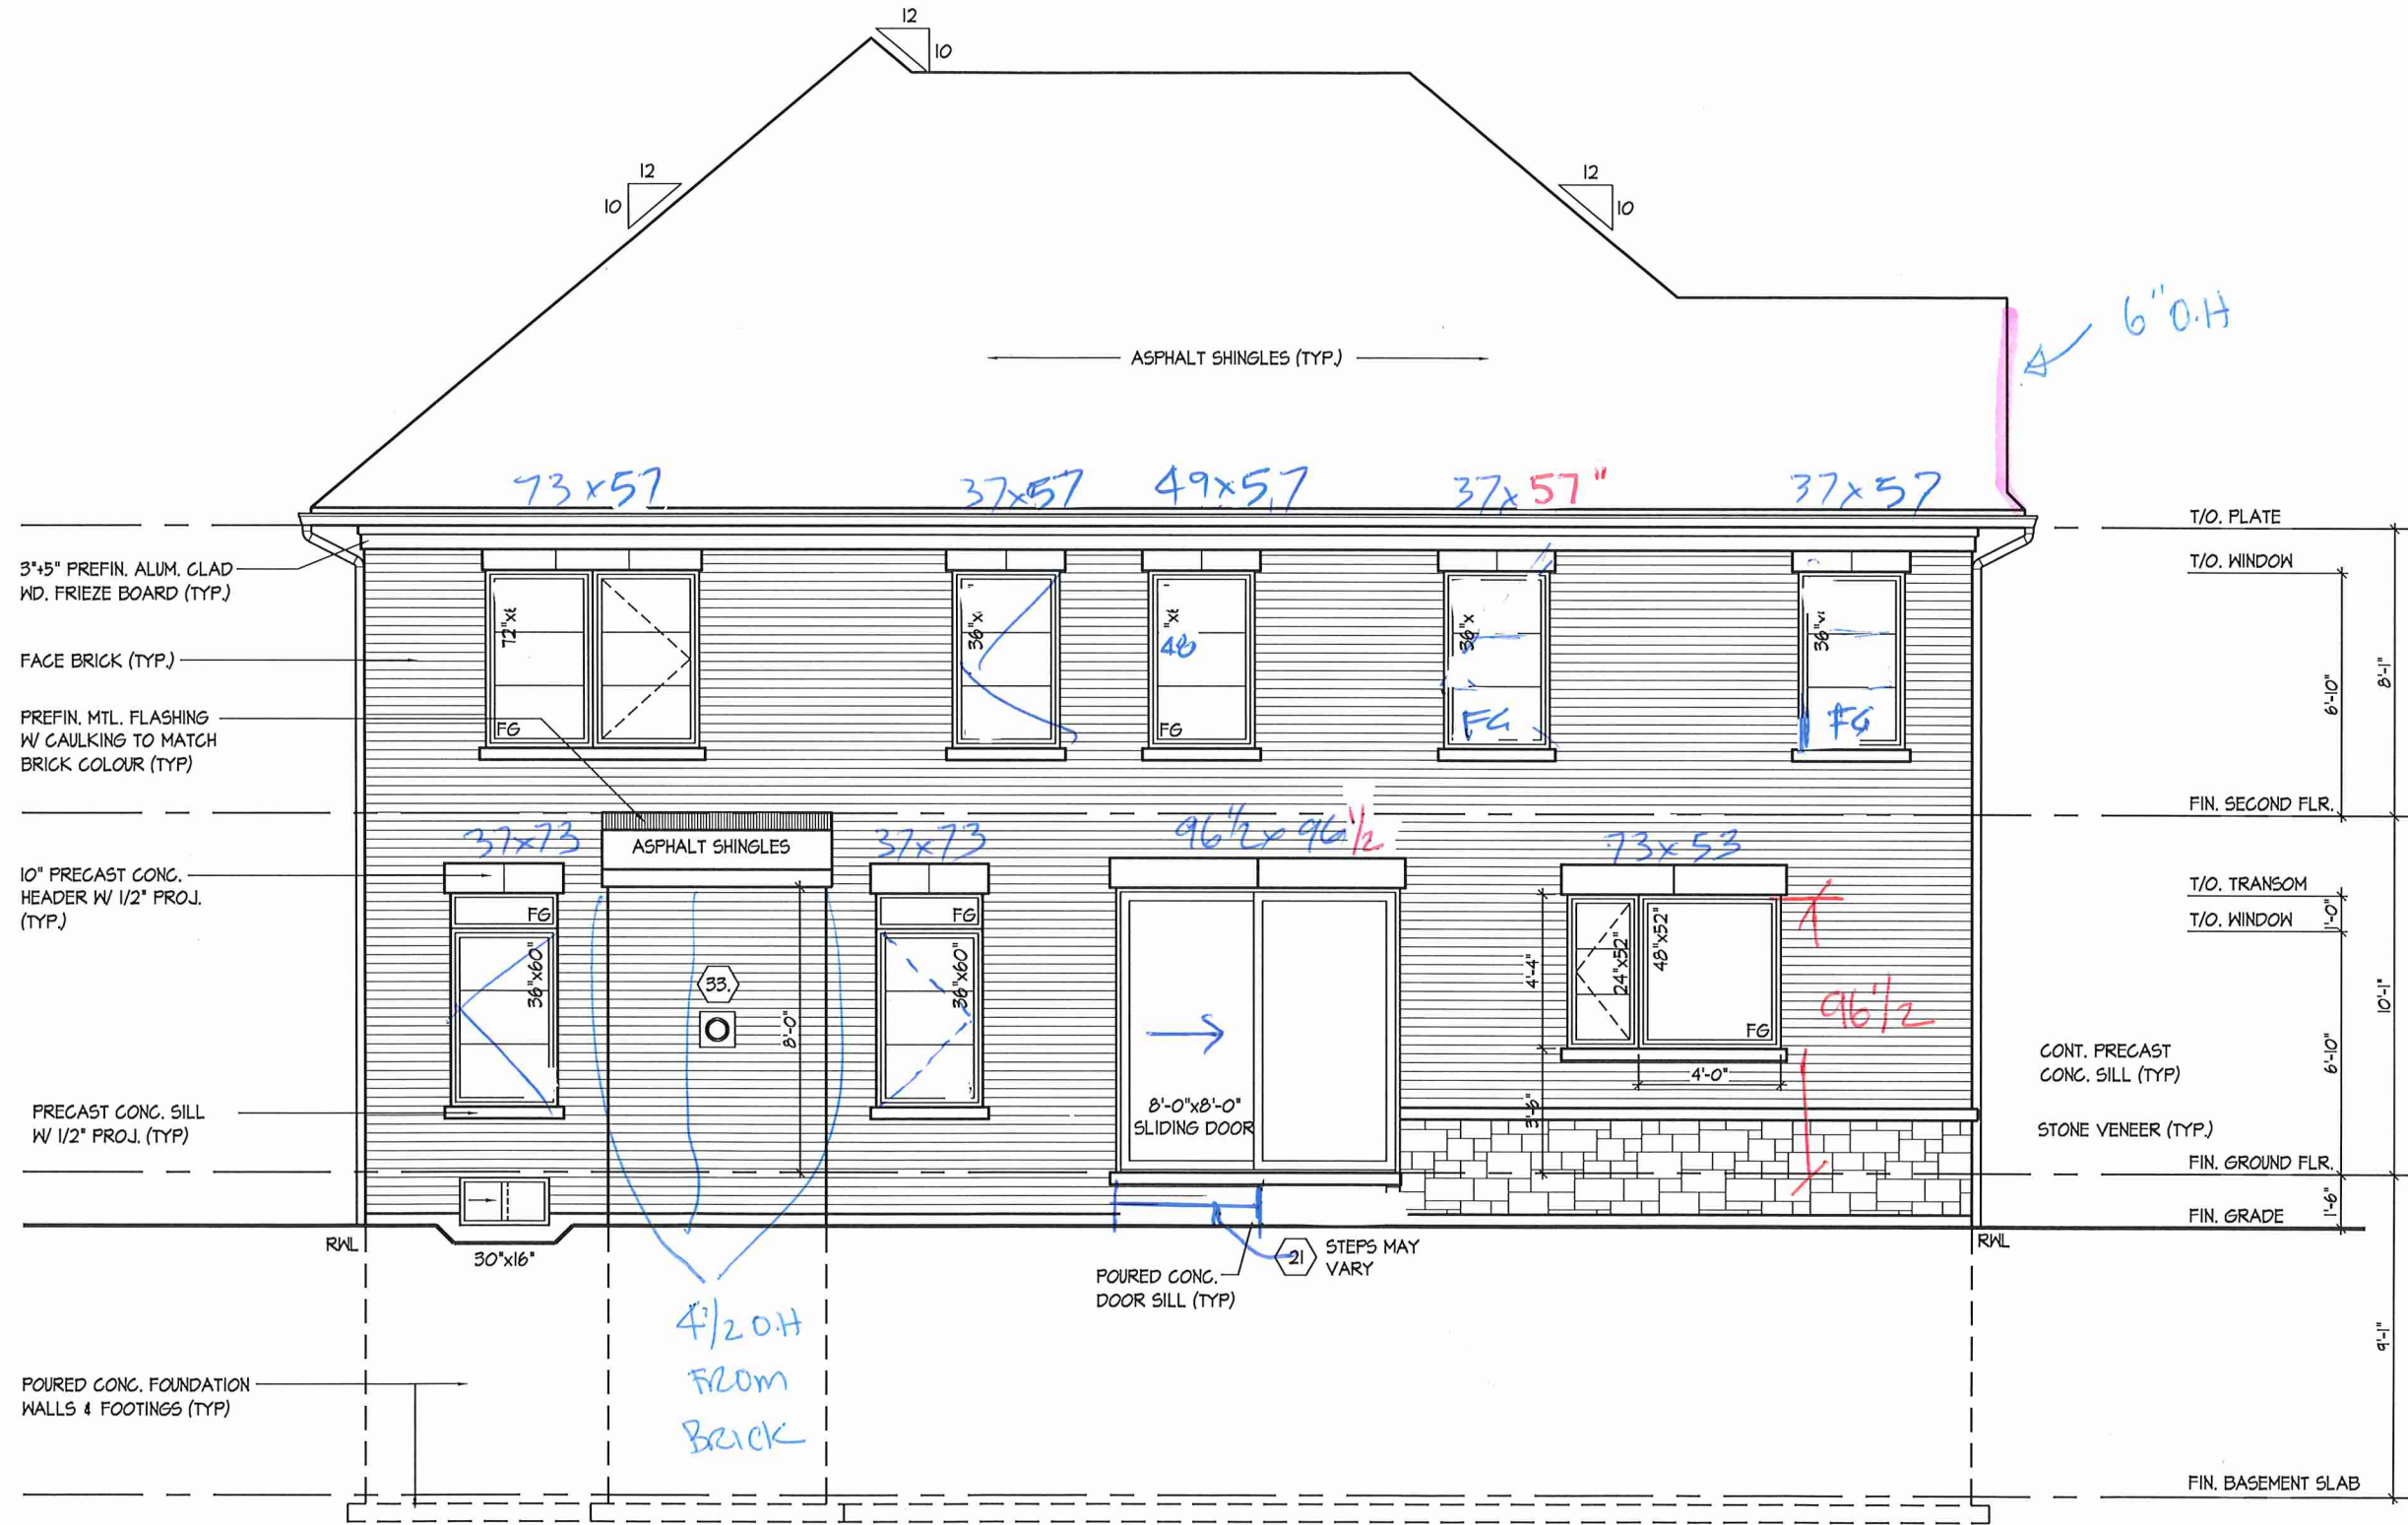

UPGRADED REAR ELEVATION 'A'

UPGRADED REAR ELEVATION 'A'

Royal Pine Homes/Summer Ridge Estates Inc.-216051 UNIT 4100(LOT 100)
"MAYFIELD VILLAGE", BRAMPTON, ON.
REV.2024.07.24

HUNT
DESIGN ASSOCIATES INC.
www.hunt-design.ca

124648
BCN
19695
HUNT DESIGN ASSOCIATES INC.
Shutong Zhao

Checked By: MM/DS
Drawn By: WT
Scale: 3/16"=1'-0"
File Number: 216051WS4100 (LOT 100)
Page Number: 8 of 11

THE UNDERSIGNED HAS REVIEWED AND TAKES RESPONSIBILITY FOR THIS DESIGN AND HAS THE QUALIFICATIONS AND MEETS THE REQUIREMENTS SET OUT IN THE ONTARIO BUILDING CODE TO BE A DESIGNER.
All drawings specifications related documents and design are the copyright property of Hunt Design Associates (H.D.A.). Reproduction of this property in whole or in part is strictly prohibited without H.D.A.'s written permission (H.D.A. assumes no responsibility or liability for this property unless it bears the appropriate BCN number and original signature).

REFER TO FRONT ELEVATION
FOR TYPICAL NOTES & INFO.

ADDITIONAL NOTES
GLAZED AREA CALCULATED W/ FRAME SIZE MINUS 2" AROUND ENTIRE PERIMETER

HUNT
DESIGN ASSOCIATES INC.
www.hunt-design.ca

NAME	SIGNATURE	BCIN
Shudong Zhao		124648
REGISTRATION INFORMATION		
HUNT DESIGN ASSOCIATES INC.		19695



SZHAO | WED JUL 24/24 04:38 PM | K:\PROJECTS\2016\216051.ROY\WORKING\SINGLES\8 SECOND FLOOR\216051WS4100 (LOT 100).DWG

REFER TO FRONT ELEVATION
FOR TYPICAL NOTES & INFO.

STONE VENEER (TYP.)

FIN. BASEMENT SLAB

SZHAO | WED JUL 24/24 04:38 PM | K:\PROJECTS\2016\216051.ROY\WORKING\ANGLES\8 SECOND FLOOR\216051WS4100 (LOT 100).DWG

NAME	SIGNATURE	BCIN
Chutong Zhao		124648
REGISTRATION INFORMATION		
THE UNDERSIGNED HAS REVIEWED AND TAKES RESPONSIBILITY FOR THIS DESIGN AND HAS THE QUALIFICATIONS AND MEETS THE REQUIREMENTS SET OUT IN THE ONTARIO BUILDING CODE TO BE A DESIGNER.		
ANNUAL QUALIFICATION INFORMATION		
HUNT DESIGN ASSOCIATES INC.		
19995		

TWO STOREY VOLUME SPACES (9.23.10.1., 9.23.11., 9.23.16.)			
WALL ASSEMBLY	WIND LOADS		
EXTERIOR	STUDS SPACING MAX HEIGHT	WIND LOADS ≤ 0.5 kPa (g50) > 0.5 kPa (g50)	
BRICK	2-2x8* (2-38x89)	12" (305) O.C. 18-4" (568)	8" (200) O.C. 18-4" (568)
SIDING	SPR. #2	16" (406) O.C. 18-4" (568)	12" (305) O.C. 18-4" (568)
BRICK	2-2x8* (2-38x164)	12" (305) O.C. 21-10" (640)	12" (305) O.C. 21-10" (640)
SIDING	SPR. #2	16" (406) O.C. 21-10" (640)	16" (406) O.C. 21-10" (640)

** STUD SIZE & SPACING TO BE VERIFIED BY STRUCTURAL ENGINEER **

STUDS ARE TO BE CONTINUOUS. C/W 3/8" (9.5) THICK EXTERIOR PLYWOOD SHEATHING. PROVIDE SOLID WOOD BLOCKING BETWEEN WOOD STUDS @ 4'-0" (1220) O.C. VERTICALLY.

- FOR HORIZ. DISTANCES LESS THAN 9'-6" (2896) PROVIDE 2x6* (38x140) STUDS @ 16" (406) O.C. WITH CONTIN. 2-2x6* (2-38x140) TOP PLATE + 1-2x6* (1-38x140) BOTTOM PLATE & MIN. OF 3-2x8* (3-38x184) CONT. HEADER AT GROUND FLOOR CEILING LEVEL TOE-NAILED & GLUED AT TOP. BOTTOM PLATES & HEADERS.

1 HR. PARTY WALL (CONC. BLOCK) (9B-3) WALL TYPE 9B6 & 91b)
1/2" (12.7) GYPSUM SHEATHING ON EACH SIDE ON 2x2" (38x38) VERTICAL WD. STRAPPING @ 24" (610) O.C. ON 8" (200) CONC. BLOCK FILL STRAPPING CAVITY EACH SIDE WITH AT LEAST 90% OF ABSORPTIVE MATERIAL PROCESSED FROM ROCK, SLAG OR GLASS. TAPE, FILL & SAND ALL GYPSUM JOINTS. EXPOSED BLOCK MUST BE SEALED W/ 2 COATS OF PAINT OR FURRED WITH 2x2" (38x38) WD. STRAPPING & 1/2" (12.7) GYPSUM SHEATHING.

1 HR. PARTY WALL (DOUBLE STUD) (9B-3) WALL TYPE W13c)
5/8" (15.9) TYPE X' GYPSUM SHEATHING ON EXTERIOR SIDE OF 2 ROWS OF 2x4* (38x89) STUDS @ 16" (406) O.C., MIN. 1" (25) APART ON SEPARATE 2x4* (38x89) SILL PLATES. (2x6* (38x140) AS REQUIRED) FILL ONE SIDE OF STUD CAVITY WITH AT LEAST 90% OF ABSORPTIVE MATERIAL PROCESSED FROM ROCK, SLAG OR GLASS. TAPE FILL AND SAND ALL GYPSUM JOINTS.

2 HR. FIREWALL (9B-3) WALL TYPE 9B6 & 91b)
1/2" (12.7) GYPSUM SHEATHING ON EACH SIDE ON 2x2" (38x38) VERTICAL WD. STRAPPING @ 24" (610) O.C. ON 8" (200) CONC. BLOCK 75% SOLID. FILL STRAPPING CAVITY EACH SIDE WITH AT LEAST 90% OF ABSORPTIVE MATERIAL PROCESSED FROM ROCK, SLAG OR GLASS. TAPE, FILL & SAND ALL GYPSUM JOINTS. AT UNFINISHED AREAS, EXTERIOR FACE OF CONC. BLOCK TO BE SEALED WITH 2 COATS OF PAINT. GYPSUM SHEATHING TO BE ATTACHED TO CONC. BLOCK. (REFER TO DETAILS)

STUCCO WALL CONSTRUCTION (2x6*)
STUCCO FINISH CONFORMING TO O.B.C. SECTION 9.28. AND APPLIED PER MANUFACTURERS SPECIFICATIONS OVER 1/2" (38) E.F. IS (MINIMUM) ON APPROVED DRAINAGE MAT ON APPROVED AIRWATER BARRIER AS PER O.B.C. 9.27.3. ON EXTERIOR TYPE RIGID INSULATION (JOINTS UNTAPED) MECHANICALLY FASTENED AS PER MANUFACTURERS SPECIFICATIONS. ON 7/16" EXTERIOR TYPE SHEATHING ON STUDS CONFORMING TO O.B.C (9.23.10.1.) & SECTION 1.1., INSULATION, APPROVED 6 MIL. POLYETHYLENE VAPOUR BARRIER, 1/2" (12.7) GYPSUM WALLBOARD INT. FINISH. (REFER TO 35 NOTE AS REQUIRED)

STUCCO WALL CONSTRUCTION (2x6*) W/ CONTIN. INSUL.
STUCCO FINISH CONFORMING TO O.B.C. SECTION 9.28. AND APPLIED PER MANUFACTURERS SPECIFICATIONS OVER 1/2" (38) E.F. IS (MINIMUM) ON APPROVED DRAINAGE MAT ON APPROVED AIRWATER BARRIER AS PER O.B.C. 9.27.3. ON EXTERIOR TYPE RIGID INSULATION (JOINTS UNTAPED) MECHANICALLY FASTENED AS PER MANUFACTURERS SPECIFICATIONS. ON 7/16" EXTERIOR TYPE SHEATHING ON STUDS CONFORMING TO O.B.C (9.23.10.1.) & SECTION 1.1., INSULATION, APPROVED 6 MIL. POLYETHYLENE VAPOUR BARRIER, 1/2" (12.7) GYPSUM WALLBOARD INT. FINISH. (REFER TO 35 NOTE AS REQUIRED)

STUCCO WALL @ GARAGE CONST.
STUCCO FINISH CONFORMING TO O.B.C. SECTION 9.28. AND APPLIED PER MANUFACTURERS SPECIFICATIONS OVER 1/2" (38) E.F. IS (MINIMUM) ON APPROVED DRAINAGE MAT ON 1/2" (12.7) DENSGLASS GOLD GYPSUM BRD. ON STUDS CONFORMING TO O.B.C (9.23.10.1.) & SECTION 1.1., INSULATION, APPROVED 6 MIL. POLYETHYLENE VAPOUR BARRIER, 1/2" (12.7) GYPSUM WALLBOARD INT. FINISH. (REFER TO 35 NOTE AS REQ.)

** FOR DWELLINGS USING CONTIN. INSULATION CONSTRUCTION, PROVIDE APPROVED DRAINAGE MAT ON 7/16" (11) EXTERIOR TYPE SHEATHING OVER FURRING (AS REQ.) AND STUDS IN LIEU OF 1/2" (38) E.F. IS (MINIMUM) ON APPROVED DRAINAGE MAT ON 1/2" (12.7) DENSGLASS GOLD GYPSUM BRD.

UNSUPPORTED FOUNDATION WALLS (9.15.4.2.)
REINFORCING AT STAIRS AND SUNKEN FLOOR AREAS
2-20M BARS IN TOP PORTION OF WALL (UP TO 8'-0" OPENING)
3-20M BARS IN TOP PORTION OF WALL (8'-0" TO 10'-0" OPENING)
4-20M BARS IN TOP PORTION OF WALL (10'-0" TO 15'-0" OPENING)
- BARS STACKED VERTICALLY AT INTERIOR FACE OF WALL
REINFORCING AT BASEMENT WINDOWS
2-15M HORIZ. REINFORCING ON THE INSIDE AND OUTSIDE FACE OF THE FOUNDATION WALL BELOW THE WIN. SILL. EXTEND BARS 24" (610) BEYOND THE OPENING. 2-15M VERTICAL REINFORCING ON THE INSIDE AND OUTSIDE FACE OF THE FOUNDATION WALL ON EACH SIDE OF THE WINDOW OPENING.
- BARS TO HAVE MIN. 1' (25) CONC. COVER
- BARS TO EXTEND 2'-0" (610) BEYOND BOTH SIDES OF OPENING

WINDOW WALLS
WHERE A WINDOW OPENS INTO A WINDOW WELL, A CLEARANCE OF NOT LESS THAN 21 5/8" (550) SHALL BE PROVIDED IN FRONT OF THE WINDOW. EVERY WINDOW WELL SHALL BE DRAINED TO THE FOOTING LEVEL OR OTHER SUITABLE LOCATION WITH A 4" (100) WEEPING TILE C/W A FILTER CLOTH WRAP AND FILLED WITH CRUSHED STONE. (9.10.1.1, 9.14.6.3.)

2x12" CEILING CONSTRUCTION (9B-12) 3.1.1.8., 9.23.4.2.)
SLOPED ROOF/CEILING CONSTRUCTION (9B-12) 3.1.1.8., 9.23.4.2.)
NOTED W/ 2x2" (38x38) PURLINS @ 16" (406) O.C. PERPENDICULAR TO ROOF JOIST (PURLINS NOT REQ. W/ SPRAY FOAM), W/ INSULATION BETWEEN JOIST, 6 MIL POLYETHYLENE VAPOUR BARRIER, 1/2" (12.7) GYPSUM WALLBOARD INT. FINISH OR APPROVED EQ. INSULATION VALUE DIRECTLY ABOVE THE INNER SURFACE OF EXTERIOR WALLS SHALL NOT BE LESS THAN R20 (3.52 RSI).

FLAT ROOF/BALCONY CONSTRUCTION
WATERPROOFING MEMBRANE (9.26.11., 9.26.15., 9.26.16) FULLY ADHERED TO 5/8" (15.9) T&G EXTERIOR GRADE PLYWOOD SHEATHING ON 2x2" (38x38) PURLINS ANGLED TOWARDS SCUPPER @ 2% MINIMUM LAID PERPENDICULAR TO 2x8* (38x184) FLOOR JOISTS @ 16" (406) O.C. (UNLESS OTHERWISE NOTED). BUILT UP TRIM DRIP EDGE TO BE PROVIDED ON OUTSIDE FACE OF CURB. SCUPPER DRAIN TO BE LOCATED 24" (610) MIN. AWAY FROM HOUSE. PREFINISHED ALUMINUM OR PANEL FOR UNDERSIDE OF SOFFIT (9.23.2.3). REMOVE CURB WHERE REQ.

BALCONY CONDITION
SEE FLAT ROOF/BALCONY CONSTRUCTION NOTE. INCLUDE 2x4* (38x89) PT. DECKING W/ 1/4" (6.4) GAPS LAID FLAT PARALLEL TO JOISTS ON 2x4* (38x89) PT. SLEEPERS @ 12" (305) O.C. LAID FLAT PERPENDICULAR TO JOISTS

BALCONY OVER HEATED SPACE CONDITION
SEE FLAT ROOF/BALCONY CONSTRUCTION NOTE FOR ASSEMBLY. REFER TO PLANS FOR FLOOR JOIST SIZE & REFER TO HEX NOTE 9 FOR INSULATION AND INTERIOR FINISH

BARREL VAULT CONSTRUCTION
CANTILEVERED 2x4* (38x89) SPACERS LAID FLAT ON 2x10* (38x235) SPR. #2 ROOF JOIST NAILED TO BUILT-UP 3-3/4" (91) PLYWOOD HEADER PROFILED FOR BARREL. SPRAY FOAM INSULATION BETWEEN JOISTS W/ GYPSUM BOARD. INTERIOR FIN. (REFER TO DETAILS)

City of Brampton
Building Division
Building Reviewed

2024/09/18
Chris Erzek

ALL WORK SHALL CONFORM TO THE ONTARIO
BUILDING CODE 0 REG.332/12 AS AMENDED

REFER TO SB-12 ENERGY EFFICIENCY DESIGN MATRIX ON THE TITLE PAGE FOR ALL VALUES AS REQUIRED PER 3.1.1., 3.1.2., 3.1.3. OF THE OBC.

SECTION 1.1. WALL STUDS

- REFER TO THIS CHART FOR STUD SIZE & SPACING AS REQUIRED FOR EXTERIOR WALLS ONLY. REFER TO SITING & GRADING PLAN OF THIS UNIT FOR CONFORMATION OF TOP OF FOUNDATION WALL AND ADDITIONAL INFORMATION.

- IF STUD WALL HEIGHT EXCEEDS MAX. UNSUPPORTED HEIGHT, WALL NEEDS TO BE REVIEWED AND APPROVED BY ENGINEER.

SIZE & SPACING OF STUDS: (OBC REFERENCE - TABLE 9.23.10.1.)	
MIN. STUD SIZE, in (mm)	SUPPORTED LOADS (EXTERIOR)
	ROOF w/ OR w/o ROOF w/ OR w/o
	ATTIC & 1 FLOOR ATTIC & 2 FLOOR ATTIC & 3 FLOOR
	MAX. STUD SPACING, in (mm) O.C.
2x4* (38x89)	16" (406) 12" (305) N/A
2x6* (38x140)	9" (200) 9" (200) 16" (406) 12" (305)
	9" (200) 11" (280) 5" (110) 5" (110)

SECTION 2.0. GENERAL NOTES

2.1. WINDOWS
1) EXCEPT WHERE A DOOR ON THE SAME FLOOR LEVEL AS THE BEDROOM PROVIDES DIRECT ACCESS TO THE EXTERIOR, EVERY FLOOR LEVEL CONTAINING A BEDROOM IS TO HAVE AT LEAST ONE OUTSIDE WINDOW W/ MIN. 0.35m² UNOBSTRUCTED OPEN PORTION W/ NO DIMENSION LESS THAN 1'3" (380). CAPABLE OF MAINTAINING THE OPENING WITHOUT THE NEED FOR ADDITIONAL SUPPORT. CONFORMING TO 9.9.10.

2) WINDOW GUARDS: A GUARD OR A WINDOW WITH A MAXIMUM RESTRICTED OPENING WIDTH OF 4" (100) IS REQUIRED WHERE THE TOP OF THE WINDOW SILL IS LOCATED LESS THAN 1'5" (480) ABOVE FIN. FLOOR AND THE DISTANCE FROM THE FINISHED FLOOR TO THE ADJACENT GRADE IS GREATER THAN 5'11" (1800). (9.8.8.1.)

3) WINDOWS IN EXT. STAIRWAYS THAT EXTEND TO LESS THAN 2'11" (900) [3'6" (1070) FOR ALL OTHER BUILDINGS] SHALL BE PROTECTED BY GUARDS IN ACCORDANCE WITH NOTE #2 (ABOVE). OR THE WINDOW SHALL BE NON-OPERABLE AND DESIGNED TO WITHSTAND THE SPECIFIED LOADS FOR BALCONY GUARDS AS PROVIDED IN 4.1.5.15 OR 9.8.8.2

4) REFER TO TITLE PAGE FOR MAX. U-VALUE REQUIREMENTS

2.2. CEILING HEIGHTS
THE CEILING HEIGHTS OF ROOMS AND SPACES SHALL CONFORM TO TABLE 9.5.3.1.

ROOM OR SPACE	MINIMUM HEIGHTS
LIVING ROOM, DINING ROOM AND KITCHEN	7'-7" OVER 75% OF REQUIRED FLOOR AREA WITH A CLEAR HEIGHT OF 6'-11" AT ANY POINT
BEDROOM	7'-7" OVER 50% OF REQUIRED FLOOR AREA OR 6'-11" OVER ALL OF THE REQUIRED FLOOR AREA.
BASEMENT	6'-11" OVER AT LEAST 75% OF THE BASEMENT AREA EXCEPT THAT UNDER BEAMS AND DUCTS THE CLEARANCE IS PERMITTED TO BE REDUCED TO 6'-5".
BATHROOM, LAUNDRY AREA ABOVE GRADE	6'-11" IN ANY AREA WHERE A PERSON WOULD NORMALLY BE STANDING
FINISHED ROOM NOT MENTIONED ABOVE	6'-11"
MEZZANINES	6'-11" ABOVE & BELOW FLOOR ASSEMBLY (9.5.3.2.)
STORAGE GARAGE	6'-7" (9.5.3.3.)

2.3. MECHANICAL / PLUMBING
1) MECHANICAL VENTILATION IS REQUIRED TO PROVIDE 0.7 AIR CHANGE PER HOUR IF NOT AIR CONDITIONED 1 PER HOUR F.A.R. EXHAUST IS REQUIRED OVER 24 HOURS. WHEN A VENTILATION FAN (PRINCIPAL EXHAUST) IS REQUIRED, CONFORM TO OBC 9.32.3.4. WHEN A HRV IS REQUIRED, CONFORM TO 9.32.3.11. REFER TO MECHANICAL DRAWINGS.

2) REFER TO HOT WATER TANK MANUFACTURER SPECS. CONFORM TO OBC 9.31.6.

3) REFER TO TITLE PAGE FOR SPACE HEATING EQUIPMENT. HRV AND DOMESTIC HOT WATER HEATER MINIMUM EFFICIENCIES.

4) DRAIN WATER HEAT RECOVERY UNIT(S) WILL BE INSTALLED CONFORMING TO THE REQUIREMENTS OF SB-12 - 3.1.1.12. OF THE O.B.C.

2.4. LUMBER
1) ALL LUMBER SHALL BE SPRUCE No.2 GRADE OR BETTER, UNLESS NOTED OTHERWISE.
2) STUDS SHALL BE STUD GRADE SPRUCE, UNLESS NOTED OTHERWISE.
3) LUMBER EXPOSED TO THE EXTERIOR TO BE SPRUCE No. 2 GRADE PRESSURE TREATED OR CEDAR, UNLESS NOTED OTHERWISE.
4) ALL LAMINATED VENEER LUMBER (LVL) BEAMS, GIRDER TRUSSES, AND METAL HANGER CONNECTIONS SUPPORTING ROOF FRAMING TO BE DESIGNED & CERTIFIED BY FLOOR AND ROOF TRUSS MANUFACTURER
5) JOIST HANGERS: PROVIDE APPROVED METAL HANGERS FOR ALL JOISTS AND BUILT-UP WOOD MEMBERS INTERSECTING WITH FLUSH BUILT-UP WOOD MEMBERS.
6) WOOD FRAMING NOT TREATED WITH A WOOD PRESERVATIVE, IN CONTACT WITH CONCRETE, SHALL BE SEPARATED FROM THE CONC. BY AT LEAST 2 mil POLYETHYLENE FILM No.50 (45lb) ROOFING OR OTHER DAMPROOFING MATERIAL EXCEPT WHERE THE WOOD MEMBER IS AT LEAST 6" (152) ABOVE THE GROUND.

2.5. STEEL (9.23.4.3.)
1) STRUCTURAL STEEL SHALL CONFORM TO CAN/CSA-G40-21 GRADE 350W. HOLLOW STRUCT. SECTIONS SHALL CONFORM TO CAN/CSA-G40-21 GRADE 350W CLASS "H".
2) REINFORCING STEEL SHALL CONFORM TO CSA-G30-18M GRADE 400R.

2.6. FLAT ARCHES
1) FOR 8'-0" (2440) CEILINGS, FLAT ARCHES SHALL BE 6"-10" (2080) A.F.F.
2) FOR 9'-0" (2740) CEILINGS, FLAT ARCHES SHALL BE 7"-10" (2400) A.F.F.
3) FOR 10'-0" (3040) CEILINGS, FLAT ARCHES SHALL BE 8'-6" (2600) A.F.F.

2.7. ROOF OVERHANGS
1) ALL ROOF OVERHANGS SHALL BE 1'-0" (305), UNLESS NOTED OTHERWISE.

2.8. FLASHING (9.20.13., 9.26.4. & 9.27.3.)
1) FLASHING MATERIALS & INSTALLATION SHALL CONFORM TO O.B.C.

2.9. GRADING
1) THE BUILDING SHALL BE LOCATED OR THE BUILDING SITE GRADED SO THE WATER WILL NOT ACCUMULATE AT OR NEAR THE BUILDING AND WILL NOT ADVERSELY AFFECT ADJACENT PROPERTIES. CONFORM TO 9.14.6.

2.10. ULC SPECIFIED ASSEMBLIES
ALL REQUIRED INDIVIDUAL COMPONENTS THAT FORM PART OF ANY ULC LISTED ASSEMBLY, SPECIFIED WITHIN THESE DRAWINGS, CANNOT BE ALTERED OR SUBSTITUTED FOR ANY OTHER MATERIAL/PRODUCT OR SPECIFIED MANUFACTURER THAT IS IDENTIFIED IN THAT SPECIFIED ULC LISTING. THERE SHALL BE NO DEVIATIONS UNDER ANY CIRCUMSTANCES IN ANY ULC LISTED ASSEMBLY IDENTIFIED IN THESE DRAWINGS.

SECTION 3.0. LEGEND

3.1. WOOD LINTELS AND BUILT-UP WOOD (DIVISION B PART 9, TABLES A8 TO A10 AND A12, A15 & A16) FORMING PART OF SENTENCE 9.23.4.2 (3), 9.23.4.2 (4), 9.23.12.3 (1), (3), 9.23.13.8 (2), 9.37.3.1 (1)									
2x8" SPRUCE #2			2x10" SPRUCE #2			2x12" SPRUCE #2			
L1	212x8" (2/38x184)	L3	212x10" (2/38x235)	L5	212x12" (2/38x286)				
B1	312x8" (3/38x184)	B3	312x10" (3/38x235)	B5	312x12" (3/38x286)				
B2	412x8" (4/38x184)	B4	412x10" (4/38x235)	B6	412x12" (4/38x286)				
B7	512x8" (5/38x184)	B8	512x10" (5/38x235)	B9	512x12" (5/38x286)				
ENGINEERED LUMBER SCHEDULE									
1 3/4"x 9 1/2" LVL			1 3/4"x 11 7/8" LVL			1 3/4"x 14" LVL			
LVL2	1-1 3/4"x9 1/2"	LVL3	1-1 3/4"x11 7/8"	LVL10	1-1 3/4"x14"				
LVL4	2-1 3/4"x9 1/2"	LVL6	2-1 3/4"x11 7/8"	LVL12	2-1 3/4"x14"				
LVL5	3-1 3/4"x9 1/2"	LVL7	3-1 3/4"x11 7/8"	LVL11	3-1 3/4"x14"				
LVL8	4-1 3/4"x9 1/2"	LVL9	4-1 3/4"x11 7/8"	LVL13	4-1 3/4"x14"				
3.2. STEEL LINTELS SUPPORTING MASONRY VENEER (DIVISION B PART 9, TABLE 9.20.5.2.B.) FORMING PART OF SENTENCE 9.20.5.2 (2) & 9.20.5.2 (3)									
CODE	SIZE	BRICK			STONE				
L7	3 1/2"x 3 1/2"x 1/4" (89 x 89 x 6.4)	8-1" (2.47m)			7-6" (2.30m)				
L8	4"x 3 1/2"x 1/4" (102 x 89 x 6.4)	8-9" (2.66m)			8-1" (2.48m)				
L9	5"x 3 1/2"x 5/16" (127 x 89 x 7.9)	10-10" (3.31m)			10-1" (3.03m)				
L10	5"x 3 1/2"x 7/16" (127 x 89 x 11)	11-5" (3.48m)			10-7" (3.24m)				
L11	6"x 3 1/2"x 7/16" (152 x 89 x 11)	12-6" (3.82m)			11-7" (3.54m)				
L12	7"x 4"x 7/16" (178 x 102 x 11)	14-1" (4.30m)			13-1" (3.99m)				

HUNT DESIGN ASSOCIATES INC.
www.huntdesign.ca
8666 Woodbine Ave, Markham, ON L3R 0J7
T 905.737.5133 F 905.737.7326

Drawn By: WT
Checked By: MM/MS
Scale: 3/16"=1'-0"

Page Number: 11 of 11

Royal Pine Homes/Summer Ridge Estates Inc.-216051
"MAYFIELD VILLAGE", BRAMPTON, ON.

UNIT 4100(LOT 100)
REV.2024.07.24

3.3. DOOR SCHEDULE

CONFORMING TO SECTIONS 9.5.11, 9.6., 9.7.2.1, 9.7.5.2, 9.8.10.13.10

1 EXTERIOR 2'6" x 6'8" x 1-3/4" (815 x 2030 x 45) INSULATED MIN. R4 (RS10.7)

1A EXTERIOR 2'10" x 6'8" x 1-3/4" (865 x 2030 x 45) INSULATED MIN. R4 (RS10.7)

1B EXTERIOR 3'0" x 6'8" x 1-3/4" (915 x 2030 x 45) INSULATED MIN. R4 (RS10.7)

1C EXTERIOR 2'6" x 6'8" x 1-3/4" (760 x 2030 x 45) INSULATED MIN. R4 (RS10.7)

1D EXTERIOR 2'6" x 6'8" x 1-3/4" (815 x 2030 x 45) INS. MIN. R4 (RS10.7) (SEE HEX NOTE 20)

1E EXTERIOR 3'0" x 8'0" x 1-3/4" (915 x 2440 x 45) INSULATED MIN. R4 (RS10.7)

1F EXTERIOR 2'6" x 8'0" x 1-3/4" (815 x 2440 x 45) INSULATED MIN. R4 (RS10.7)

2A EXTERIOR 2'6" x 8'0" x 1-3/4" (815 x 2030 x 45) 20 MIN. F.A.R. DOORFRAME WITH APP. SELF CLOSING DEVICE

2 INTERIOR 2'6" x 6'8" x 1-3/8" (815 x 2030 x 35)

3 INTERIOR 2'6" x 6'8" x 1-3/8" (760 x 2030 x 35)

3A INTERIOR 2'4" x 6'8" x 1-3/8" (710 x 2030 x 35)

4 INTERIOR 2'4" x 6'8" x 1-3/8" (610 x 2030 x 35)

4A INTERIOR 2'2" x 6'8" x 1-3/8" (660 x 2030 x 35)

5 INTERIOR 1'6" x 6'8" x 1-3/8" (460 x 2030 x 35)

3.4. ACRONYMS

AFF ABOVE FINISHED FLOOR

BBFM BEAM BY FLOOR MANUFACTURER

BG FKED GLASS W/ BLACK BACKING

BM BEAM

BBRM BEAM BY ROOF MANUFACTURER

CRF CONVENTIONAL ROOF FRAMING

C/W COMPLETE WITH

DJ/TJ DOUBLE JOIST / TRIPLE JOIST

DO DO OVER

DRP DROPPED

ENG ENGINEERED

EST ESTIMATED

FA FLAT ARCH

FD FLOOR DRAIN

FG FKED GLASS

FL FLUSH

FLR FLOOR

GT GIRDER TRUSS

HB HOSE BIB

HRV HEAT RETURN VENTILATION UNIT

HWT HOT WATER TANK

CLASS 8 VENT

EXHAUST VENT

DUPLEX OUTLET (12" HIGH)

SWITCH (2/84 WAY)

POT LIGHT

LIGHT FIXTURE (CEILING MOUNTED)

LIGHT FIXTURE (PULL CHAIN)

LIGHT FIXTURE (WALL MOUNTED)

CABLE T.V. JACK

TELEPHONE JACK

CENTRAL VACUUM OUTLET

CHANDLER (CEILING MOUNTED)

SA SMOKE ALARM (9.10.19)

PROVIDE ONE PER FLOOR NEAR THE STAIRS CONNECTING THE FLOOR LEVEL. ALARMS ARE TO BE INSTALLED IN EACH SLEEPING ROOM AND IN A LOCATION BETWEEN SLEEPING ROOMS AND CONNECTING HALLWAYS AND WIRE TO BE INTERCONNECTED TO ACTIVATE ALL ALARMS IF ONE SOUNDS. ALARMS ARE TO BE CONNECTED TO AN ELECTRICAL CIRCUIT AND WITH A BATTERY BACKUP. ALARM SIGNAL SHALL MEET TEMPORAL SOUND PATTERNS MIN. ALARMS SHALL HAVE A VISUAL SIGNALING COMPONENT AS PER THE NATIONAL FIRE ALARM AND SIGNALING CODE 72.

CMD CARBON MONOXIDE ALARM (9.33.4.)

CHECK LOCAL BY-LAWS FOR REQUIREMENTS ** A CARBON MONOXIDE ALARM(S) CONFORMING TO CAN/CGA-6.19 SHALL BE INSTALLED ON OR NEAR THE CEILING IN EACH DWELLING UNIT ADJACENT TO EACH SLEEPING AREA. CARBON MONOXIDE ALARM(S) SHALL BE PERMANENTLY WIRED WITH NO DISCONNECT SWITCH, WITH AN ALARM THAT IS AUDIBLE WITHIN SLEEPING ROOMS WHEN THE INTERVENING DOORS ARE CLOSED.

SB SOLID BEARING (BUILT-UP WOOD COLUMNS AND STUD POSTS)

THE WIDTH OF A WOOD COLUMN SHALL NOT BE LESS THAN THE WIDTH OF SUPPORTED MEMBER. BUILT-UP WOOD COLUMNS SHALL BE NAILED TOGETHER WITH NOT LESS THAN 3" (76) NAILS SPACED NOT MORE THAN 11 3/4" (300) O.C. THE NUMBER OF STUDS IN A WALL DIRECTLY BELOW A GIRDER TRUSS OR ROOF BEAM SHALL CONFORM TO TABLES A-34 TO A-37. (9.17.4., 9.23.10.7.)

TWO STOREY VOLUME SPACE. SEE CONSTRUCTION NOTE 39.

VARYING PLATES, BUILT-OUT FLOORS, BEARING WALLS, ICE & WATER SHIELD

EXPOSED BUILDING FACE - O.B.C. 9.10.14. OR 9.10.15.

REFER TO HEX NOTE 35 & DETAILS FOR TYPE AND SPECIFICATIONS.

1 HR. PARTY WALL

REFER TO HEX NOTE 40A.

SECTION 4.0. CLIMATIC DATA

DESIGN SNOW LOAD (9.4.2.2.): 1.23 kPa

<

GABLE END:
3/12" MASONRY VENEER TIED TO FRAMING MEMBERS WITH 1/8"x1"x03"
GALV. METAL TIES @ 16" O.C. AND 24" VERTICAL, 1" AIR SPACE,
APPROVED AIRWATER BARRIER ON 3/8" EXTERIOR TYPE SHEATHING
ON 2"x4" SPRUCE STUDS @ 16" O.C. (PROVIDE 1/2" TYPE 'X' GYPSUM BRD.
ON INSIDE WHEN LIMITING DISTANCE IS LESS THAN 3'-11" (1.20m))

NO. 210 ASPHALT SHINGLES 3/8" EXTERIOR TYPE SHEATHING
WITH 1" CLIPS, APPROVED WOOD TRUSSES @ 24" O.C. MAX.
APPROVED EAVES PROTECTION TO EXTEND 3'-0" FROM EDGE
OF ROOF AND MIN. 12" BEYOND INNER FACE OF EXTERIOR
WALL, 2"x4" TRUSS BRACING 6'-0" O.C. AT BOTTOM CHORD.

PRE-MANUFACTURED ALUM. FLASHING

AIR BAFFLE TIED TO UNDERSIDE OF ROOF SHEATHING
WITH 2 1/2" MIN. VOID AREA

2"x6" SPRUCE FASCIA BOARD

PRE-FINISHED ALUMINUM FASCIA, RAINWATER LEADER AND VENTED
SOFFIT TIED TO EXTERIOR FINISH, PROVIDE ATTIC VENTILATION -
1/5000 OF INSULATED CEILING AREA WITH 50% AT THE EAVES

PRE-FINISHED FRIEZE BOARD, VARIES PER ELEVATION

LIMITING DISTANCE GREATER THAN 3'-11" (1.20m)			
3 1/2" MASONRY VENEER TIED TO FRAMING MEMBERS WITH 1/8"x1"x03" GALV. METAL TIES @ 16" O.C. AND 24" VERTICAL, 1" AIR SPACE, APPROVED AIRWATER BARRIER ON 3/8" EXTERIOR TYPE SHEATHING ON 2"x6" SPRUCE STUDS SPACED PER O.B.C. 4.23101, INSULATION W/ REQUIRED WALLS ABOVE GRADE R-VALUE, APPROVED 6 MIL POLY VAPOUR BARRIER, 1/2" GYPSUM WALLBOARD INTERIOR FINISH.			
LIMITING DISTANCE LESS THAN 3'-11" (1.20m) (45 MIN. FRF)			
3 1/2" MASONRY VENEER TIED TO FRAMING MEMBERS WITH 1/8"x1"x03" GALV. METAL TIES @ 16" O.C. AND 24" VERTICAL, 1" AIR SPACE, APPR. AIRWATER BARRIER ON 3/8" EXTERIOR TYPE SHEATHING ON 2"x6" SPRUCE STUDS SPACED PER O.B.C. 4.23101, INSULATION W/ REQUIRED WALLS ABOVE GRADE R-VALUE CONFORMING TO CANULC-5102 AND HAVING A MASS OF NOT LESS THAN 122 kg/m2 OF WALL SURFACE, APPROVED 6 MIL POLY VAPOUR BARRIER, 1/2" TYPE 'X' GYPSUM WALLBOARD INTERIOR FINISH.			

LIMITING DISTANCE LESS THAN 3'-11" (1.20m)			
FIRE RATINGS: (OBC REFERENCE - SB-2.3)			
COMPONENT	FIRE RATING	CODE REFERENCE	
1/2" (12.7mm) TYPE 'X' GYPSUM WALL BOARD	25 min.	O.B.C. SB-2.3.4(2) (TABLE 2.3.4.A)	
WOOD STUDS @ 406mm O.C. MAXIMUM	20 min.	O.B.C. SB-2.3.4(3) (TABLE 2.3.4.E)	
TOTAL FIRE RATING	45 min.	O.B.C. SB-2.3.4(1)	

PROVIDE CONTINUOUS APPROVED AIRWATER BARRIER AROUND
HEADERS, UNDER BOTTOM PLATE AND UP STUD WALL BEHIND GYPSUM
WALLBOARD, PROVIDE CAULKING AT JOINTS, AIRWATER BARRIER
SHALL EXTEND UNDER SILL PLATE TO OUTSIDE FACE OF INSULATION
UNDER 6 MIL POLY VAPOUR BARRIER.

BASE FLASHING CONFORMING TO TABLE 4.20131 TO EXTEND 3/16"
BEYOND OUTER FACE OF FOUNDATION WALL, TIED TO EXT. SHEATHING
UNDER AIRWATER BARRIER, PROVIDE 6" MINIMUM LAP JOINT.

KEEP HOLES @ 32" O.C. AT BASE FLASHING AND OVER ALL OPENINGS.
PROVIDE P.V.C. BRICK VENTILATOR @ ALL KEEP HOLE LOCATIONS.

FINISHED GRADE

PROVIDE MASONRY PARPING FROM TOP OF FOUNDATION
WALL TO 2" BELOW FINISHED GRADE

UNREINFORCED SOLID CONCRETE FOUNDATION WALLS (4.15.4.2)			
FLOOR LEVEL	MAX. HEIGHT FROM FIN. SLAB TO GRADE	SUPPORTED AT TOP	
		AT TOP	12.5m & 42.15m (42.15m & 59.0m)
1	8' 3'-11" (1.20m)	1'-0" (2.15m)	6'-10" (2.10m)
2	10' 4'-7" (1.40m)	1'-6" (2.30m)	8'-6" (2.60m)
3	12' 4'-11" (1.50m)	1'-6" (2.30m)	8'-6" (2.60m)
4	8' 3'-11" (1.20m)	1'-6" (2.30m)	8'-6" (2.60m)
5	10' 4'-7" (1.40m)	1'-6" (2.30m)	8'-6" (2.60m)
6	12' 4'-11" (1.50m)	1'-6" (2.30m)	8'-6" (2.60m)

MINIMUM STRIP FOOTING SIZES (4.15.3)			
NUMBER FLOORS SUPPORTED	LOAD BEARING PARTIAL WALL	SUPPORTING EXTERIOR PARTIAL WALL	
		16" X 6" D	16" X 6" D
2	24" X 6" D	20" X 6" D	24" X 6" D
3	36" X 6" D	28" X 6" D	36" X 6" D

NOTE: FOOTING SIZE SUBJECT TO
CERTIFICATION BY A SOIL CONSULTANT

FOUNDATION WALLS SHALL NOT EXCEED 9'-10" (3.0m) IN UNSUPPORTED
HEIGHT UNLESS OTHERWISE NOTED. (4.15.4.2.1) POURED CONC. FDN. WALL
WITH BITUMINOUS DAMPROOFING AND DRAINAGE LAYER. REFER TO
CHART FOR MAXIMUM UNSUPPORTED HEIGHT AND EARTH RETENTION FROM
BASEMENT SLAB TO FINISHED GRADE, ON CONTINUOUS KEYED CONC. FTG.
BRACE FOUNDATION WALL PRIOR TO BACKFILLING. ALL FOOTINGS SHALL
REST ON NATURAL UNDISTURBED SOIL OR COMPACTED ENGINEERED FILL.

CONTINUOUS KEY IN CONCRETE
4" @ KEEPING TILE 6" CRUSHED STONE
COVER OVER AND AROUND KEEPING TILES.
POURED CONC. FOOTINGS SEE MINIMUM STRIP
FOOTING SIZES FOR EXTERIOR WALLS CHART

NOTE: POURED CONC. FOOTING ON NATURAL UNDISTURBED SOIL OF
15KPa OR COMPACTED ENGINEERED FILL WITH MIN. BEARING CAPACITY
OF 150KPa. FOOTING SIZE SHOWN FOR 16'-0" (4.9m) MAXIMUM JOIST
SPAN ONLY. JOIST SPAN EXCEEDING 16'-0" (4.9m) SHALL BE
ENGINEERED. IF JOIST BEARING DOES NOT MEET MINIMUM CAPACITY,
ENGINEERED FOOTINGS ARE REQUIRED. ACTUAL SOIL BEARING
CAPACITY TO BE VERIFIED WITH SOIL ENGINEERING REPORT.

FLOOR & ROOF CONSTRUCTION
REFER TO FLOOR & ROOF TRUSS MANUFACTURERS DRAWINGS FOR
SPECIFICATION DETAILS, LAYOUT, SPACING, INSTALLATION,
HANDLING AND HANGER SIZES.

OBC REFERENCES
4.10.3.3(2). - EXTERIOR WALLS SHALL BE RATED TO EXPOSURE TO
FIRE FROM INSIDE THE BUILDING
SB 2.3.5(2). - WHEN AN EXTERIOR WALL ASSEMBLY IS RATED FROM
THE INTERIOR SIDE THE SPACES BETWEEN THE STUDS ARE TO BE
FILLED WITH INSULATION CONFORMING TO CANULC-5102 AND
HAVING A MASS OF NOT LESS THAN 122 kg/m2 OF WALL SURFACE.

REFER TO SB-12 ENERGY EFFICIENCY DESIGN
MATRIX ON THE TITLE PAGE FOR ALL VALUES AS
REQUIRED PER 3.1.1, 3.1.2, 3.1.3, OF THE OBC.

1 MASONRY VENEER, 2"x6" STUDS, 2 STOREY WALL SECTION

01 1/2" = 1'-0"

City of Brampton
Building Division
Building Reviewed

2024/09/18
Chris Erzek

ALL WORK SHALL CONFORM TO THE ONTARIO
BUILDING CODE O. REG.332/12 AS AMENDED

PROVIDE ADEQUATE SPACE FOR INSULATION DIRECTLY ABOVE THE INNER
SURFACE OF EXTERIOR WALLS. INSULATION VALUE SHALL NOT BE LESS
THAN R20 (552 BSI) AS PER O.B.C. SB-12 3.1.1.8.

1/2" GYPSUM CEILING BOARD INTERIOR FINISH ON 6 MIL POLY
VAPOUR BARRIER ON BOTTOM CHORD OF ROOF TRUSSES,
INSULATION W/ REQUIRED CEILING W/ ATTIC SPACE R-VALUE

2-2"x6" TOP PLATE

SECOND FLOOR

2"x6" BASE PLATE

MIN. 1 1/2" THICK HEADER AS PER JOIST DEPTH - REFER TO ENG.
FLOOR JOIST MANUF. FOR RIMBOARD OR HEADER SIZE.

T/6 SUBFLOOR ON FLOOR JOISTS. FOR CERAMIC TILE APPLICATION
REFER TO O.B.C. 4.306.6. ALL JOISTS TO BE BRIDGED WITH 2"x2"
CROSS BRACING OR SOLID BLOCKING @ 6'-11" O.C. MAX. ALL JOISTS
TO BE STRAPPED WITH 1"x3" @ 6'-11" O.C. UNLESS A PANEL TYPE
CEILING FINISH IS APPLIED. REFER TO ENG. FLOOR JOIST MANUF. FOR
BRACING SPECIFICATIONS.

INSULATION W/ REQUIRED EXPOSED FLOOR R-VALUE
IN HEADERS SPACE.

ONE LAYER 5/8" TYPE 'X' GYPSUM WALLBOARD
FOR LIMITING DISTANCE LESS THAN 3'-11" (1.20m)

2-2"x6" TOP PLATE

PROVIDE CONTINUOUS APPROVED AIRWATER BARRIER AROUND
HEADERS, UNDER BASE PLATES AND UP STUD WALL BEHIND GYPSUM
WALLBOARD, PROVIDE CAULKING AT JOINTS.

FIRST FLOOR

2"x6" BASE PLATE

MIN. 1 1/2" THICK HEADER AS PER JOIST DEPTH - REFER TO ENG.
FLOOR JOIST MANUF. FOR RIMBOARD OR HEADER SIZE.

T/6 SUBFLOOR ON FLOOR JOISTS. FOR CERAMIC TILE APPLICATION
REFER TO O.B.C. 4.306.6. ALL JOISTS TO BE BRIDGED WITH 2"x2"
CROSS BRACING OR SOLID BLOCKING @ 6'-11" O.C. MAX. ALL JOISTS
TO BE STRAPPED WITH 1"x3" @ 6'-11" O.C. UNLESS A PANEL TYPE
CEILING FINISH IS APPLIED. REFER TO ENG. FLOOR JOIST MANUF. FOR
BRACING SPECIFICATIONS.

INSULATION W/ REQUIRED EXPOSED FLOOR R-VALUE
IN HEADERS SPACE.

ONE LAYER 5/8" TYPE 'X' GYPSUM WALLBOARD
FOR LIMITING DISTANCE LESS THAN 3'-11" (1.20m)

MINIMUM 2"x4" SILL PLATE (2"x6" AS REQ.) TIED TO TOP OF POURED
CONC. FND. WALL WITH 8" LONG 1/2" @ ANCHOR BOLTS 6M NUT AND
WASHER WITH 2 1/2" HOOK. ANCHOR BOLTS TO BE SPACED NOT
MORE THAN 7'-10" O.C. AND EMBEDDED NOT LESS THAN 4" INTO
CONC. PROVIDE SILL GASKET BETWEEN PLATE AND FOUNDATION
WALL. PROVIDE NON-SHRINK GROUT TO LEVEL PLATE.

INSULATION BLANKET OR BATTS W/ REQUIRED BASEMENT WALL R-VALUE,
6 MIL POLYETHYLENE VAPOUR BARRIER DAMPROOF WITH AIRWATER
BARRIER BETWEEN THE FOUNDATION WALL AND INSULATION UP TO
GRADE LEVEL. TERMINATE BLANKETS ABOVE SLAB AS REQUIRED BY
O.B.C. OR ENERGY DESIGN CONSULTANT

TAPE AND SEAL BLANKETS AT ALL JOINTS

UNFINISHED BASEMENT

SECURE METAL BLANKET TIE TO FOUNDATION
WALL AS PER MANUF. INSTRUCTIONS

1/2" IMPERVIOUS BOARD FOR BOND BREAK

3" MIN. 25 MPa CONC. SLAB ON 4" COARSE CLEAN GRANULAR FILL
OR 20 MPa CONC. WITH DAMPROOFING BELOW SLAB.

BUILDING COMPONENT	INSULATION VALUE	PROPOSED
CEILING W/ ATTIC SPACE		10.56 (R60)
CEILING W/O ATTIC SPACE		5.46 (R31)
EXPOSED FLOOR		5.46 (R31)
WALLS ABOVE GRADE		R22+R1.5ci
BASEMENT WALLS		R20ci (RSI 3.52ci) R12+R10ci
BELOW GRADE SLAB ENTIRE SURFACE > 600mm BELOW GRADE		-
EDGE OF BELOW GRADE SLAB ≤ 600mm BELOW GRADE		-
HEATED SLAB OR CONC. SLAB ≤ 600mm BELOW GRADE		-

ROYAL PINE HOMES - PACKAGE A1 (PERFORMANCE)

THE UNDERSIGNED HAS REVIEWED AND TAKES RESPONSIBILITY FOR THIS
DESIGN AND HAS THE QUALIFICATIONS AND MEETS THE REQUIREMENTS SET
OUT IN THE ONTARIO BUILDING CODE TO BE A DESIGNER.

QUALIFICATION INFORMATION

NAME Tony Dearth
REGISTRATION INFORMATION BCN 19258
HUNT DESIGN ASSOCIATES INC. 19695



DESIGN ASSOCIATES INC.

www.huntdesign.ca

Dead/Division Number and Title

DIVISION 1

BRICK VENEER WALL DETAILS

Revision

REV.2022.01.01

8966 Woodbine Ave, Markham, ON L3R 0J7 // T 905.737.5133

Page Number

1-1

All drawings specifications related documents and design are the copyright property of Hunt Design Associates (H.D.A.). Reproduction of this property in whole or in part is strictly prohibited without H.D.A.'s written permission (H.D.A. assumes no responsibility or liability for this property unless it bears the appropriate BCN number and original signature).