




BAYVIEW HEIGHTS


RICHMOND HILL




ELEVATION A

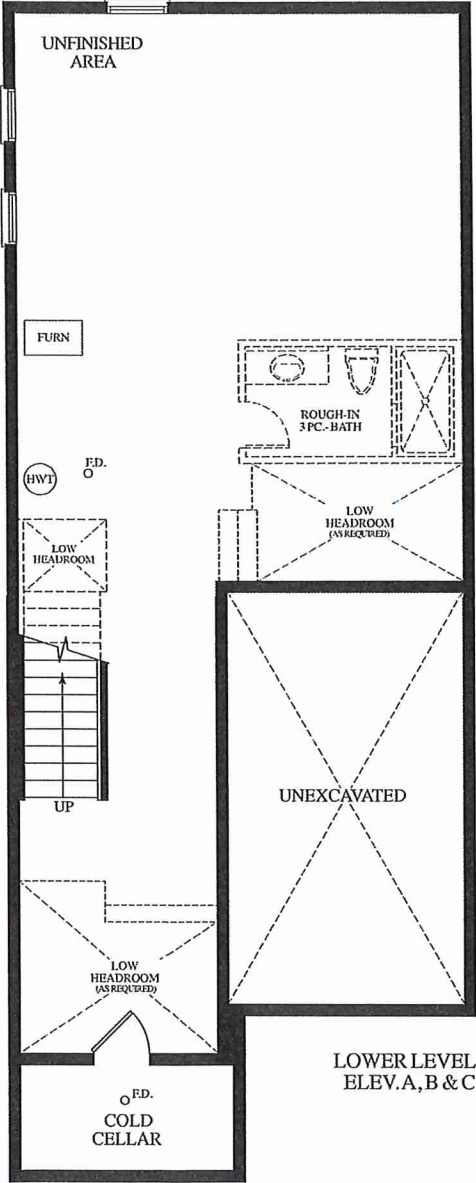

LOWER LEVEL
ELEV. A, B & C

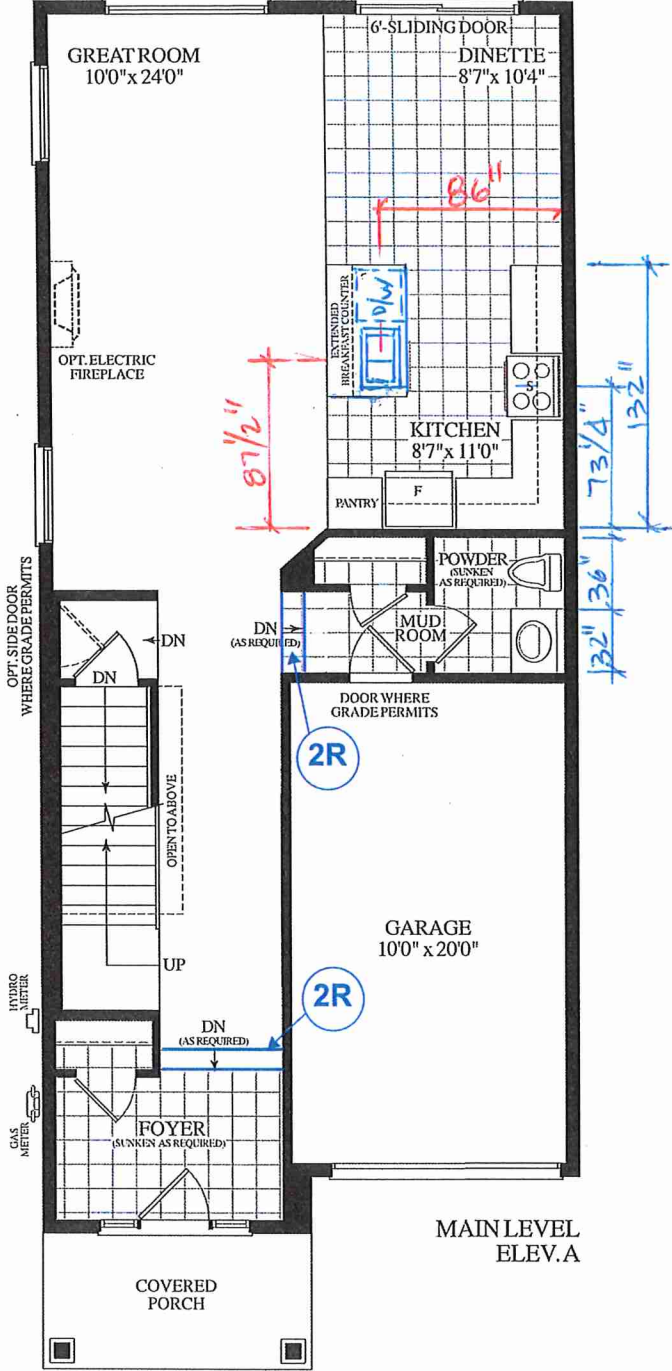

MAIN LEVEL
ELEV. A

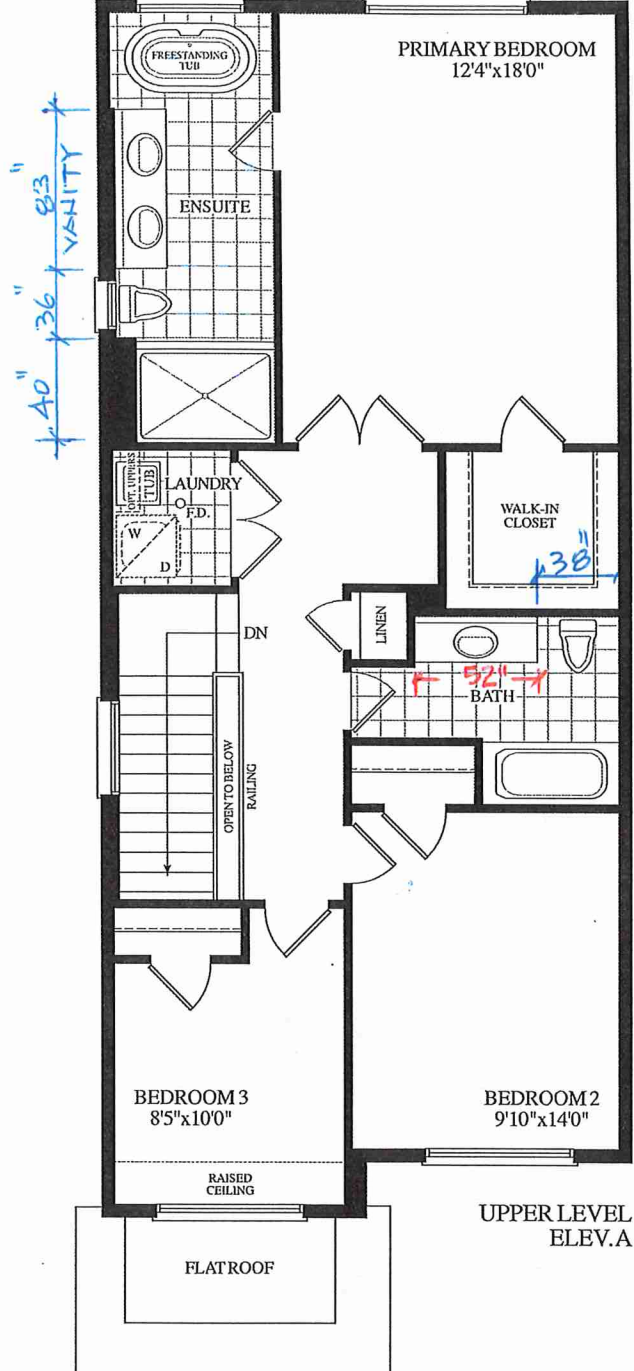

Materials, specifications and floor plans are subject to change without notice. All renderings are artist's concept. All floor plans are approximate dimensions. Actual usable floor space may vary from the stated floor area. E.&O.E.

BLK. 19 TH. 119 20-18 THE KATHERINE (END) EL. A 3 BDRM 2 BATH 1815 SQ.FT.