



Structural

CONSTRUCTION SUMMARY
EARLGLEN INVESTMENTS INC.

PURCHASERS: YU-WAI LO and ANGELA MIU TING LO

TEL: RES.: 416-315-8218

LOT NUMBER	PHASE	HOUSE TYPE	CLOSING DATE
050 BLOCK 008	1	THE CHARLOTTE-ELEV C-STD MAIN-3 BDRM-3 BATHS	05-May-26

Date Added: 24-Jun-25 Invoice Number: 8812

1 - PRIMARY ENSUITE- Purchaser accepts and acknowledges the change made to teh Primary Ensuite reloaction of the vanity, toilet and door relocation (See Sketch)
Note:

1 - PURCHASER HAS DECLINED ALL STRUCTURALS OPTIONS FROM THE DESIGN STUDIO
Note:

1 - PURCHASER AWARE AND ACCEPTS THAT ANY CHANGES MADE TO UPGRADES AFTER SIGNING THIS PURCHASERS EXTRA FORM ARE SUBJECT TO A MINIMUM ADMINISTRATION FEE OF \$1,000
Note:

Date Added: Invoice Number: 8847

1 - Install standard Cable / Cat 6, Telephone (See Sketch)
Note:

1 - GARAGE DOOR- Install the builders standard garage door handle with lock
Note:

1 - APPLIANCE PACKAGE- Install the Standard Appliance Package throughout the home, where applicable.
Note:

1 - KITCHEN & BATHROOMS - Purchaser has DECLINED All Upgrades offered during decor appointment at the decor centre for kitchen & bathroom cabinetry. Standard Kitchen Layout & Standard Bathroom Vanities to be installed as per standard plan. (See Sketch)
Note:

1 - CLARIFICATION- KITCHEN/ MASTER ENSUITE / ENSUITE #2/ MAIN BATH/POWDER ROOM- Install the builders standard Plumbing Fixtures throughout all bathrooms, where applicable.
Note:

1 - COUNTER TOPS
Purchaser accepts & acknowledges that the Stone slabs vary in size & all seams are visible & the fabricator reserves the right to position the seams as necessary
Note:



1 - KITCHEN-Install the builders standard Everest VANILLA WHITE with Standard "A" Edge
Note:

1 - POWDER ROOM-Install the builders standard Everest MAPLE WHITE with Standard "A" Edge
Note:

1 - PRIMARY ENSUITE-Install the builders standard Everest MAPLE WHITE with Standard "A" Edge
Note:

1 - ENSUITE#2-Install the builders standard Everest MAPLE WHITE with Standard "A" Edge
Note:

1 - MAIN BATHROOM-Install the builders standard Everest MAPLE WHITE with Standard "A" Edge
Note:

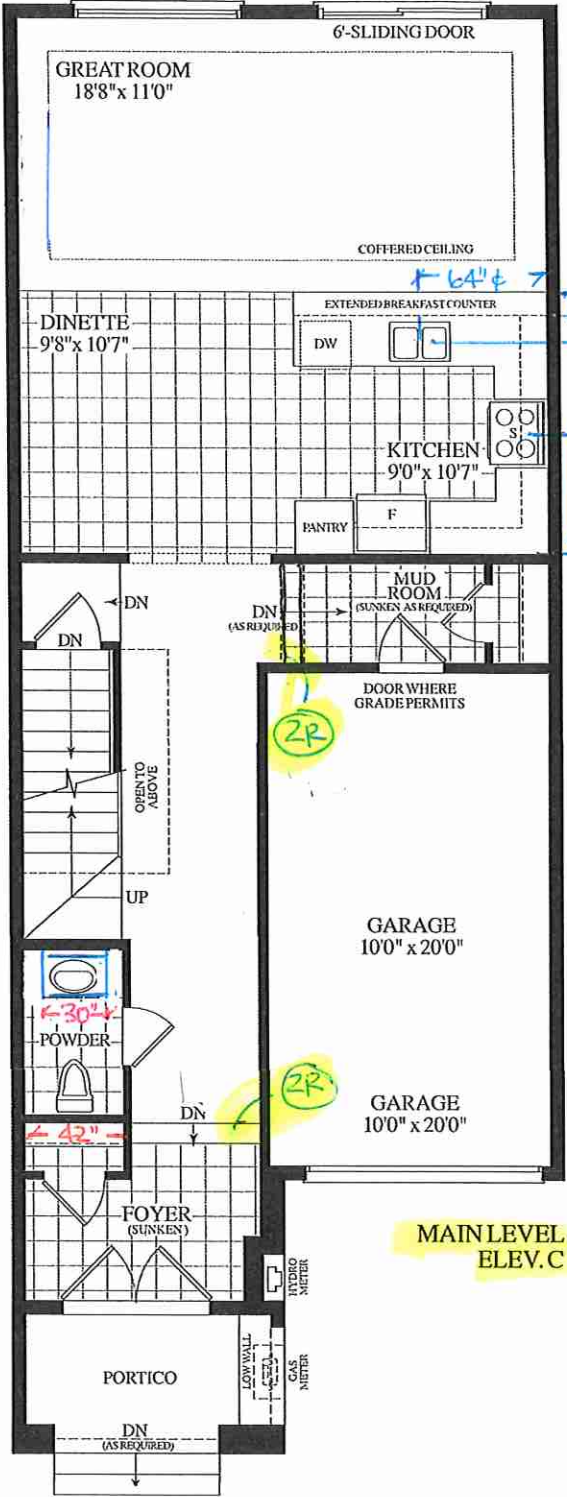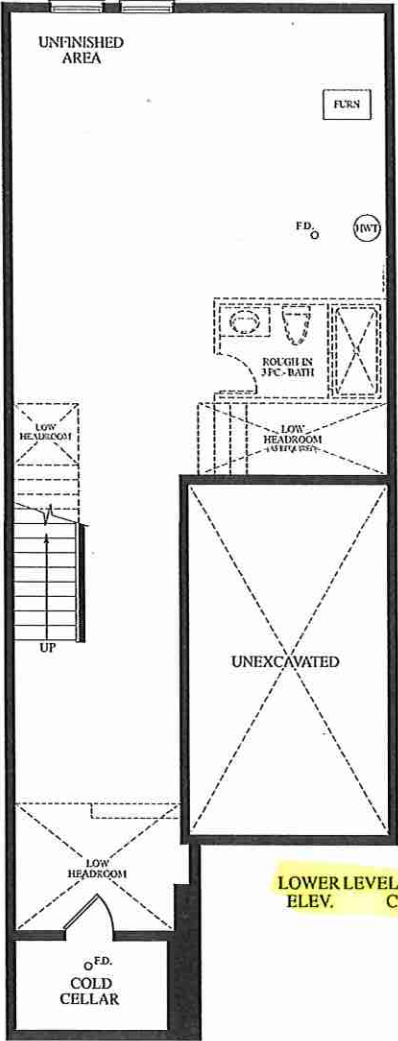

Materials, specifications and floor plans are subject to change without notice. All renderings are artist's concept. All floor plans are approximate dimensions. Actual usable floor space may vary from the stated floor area. E.&O.E.

