



INVENTORY

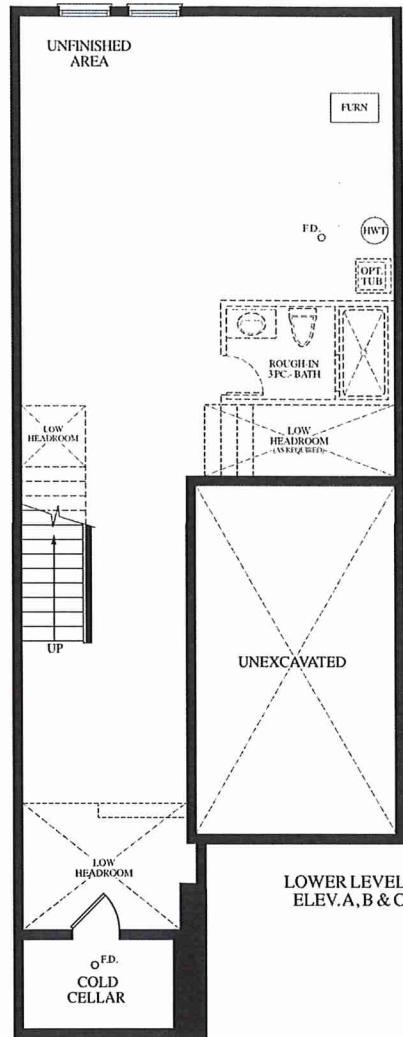


LOWER LEVEL
ELEV. A, B & C

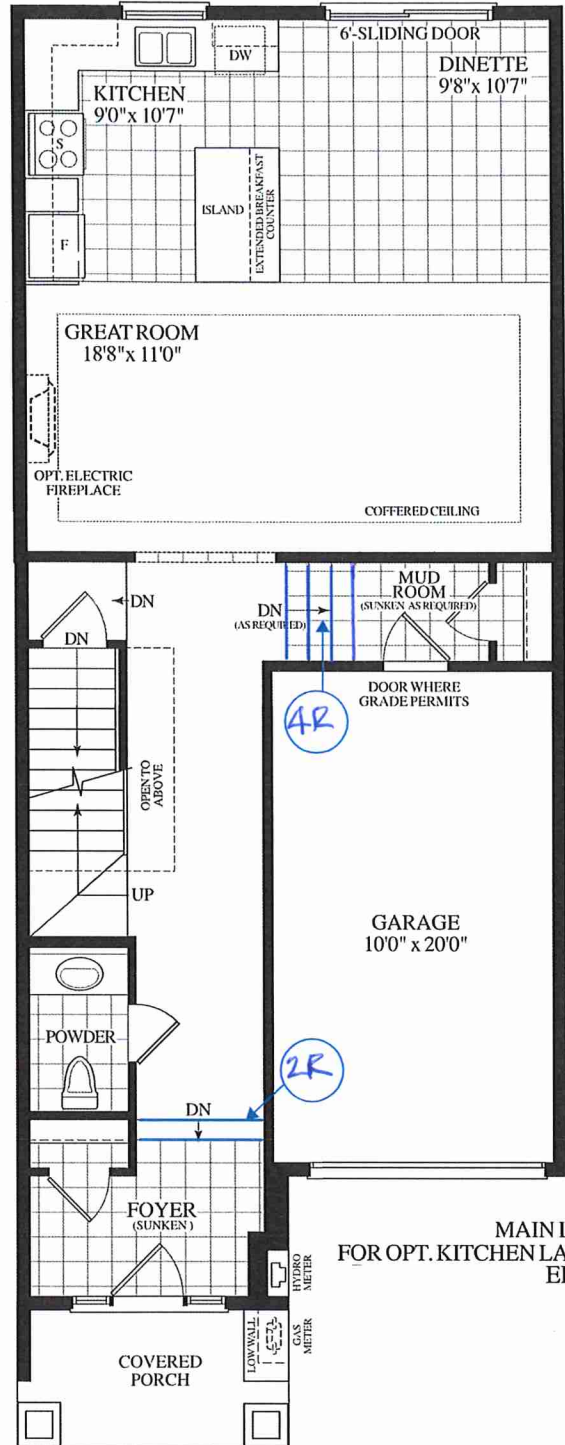

MAIN LEVEL
FOR OPT. KITCHEN LAYOUT
ELEV. A

Materials, specifications and floor plans are subject to change without notice. All renderings are artist's concept. All floor plans are approximate dimensions. Actual usable floor space may vary from the stated floor area. E.&O.E.

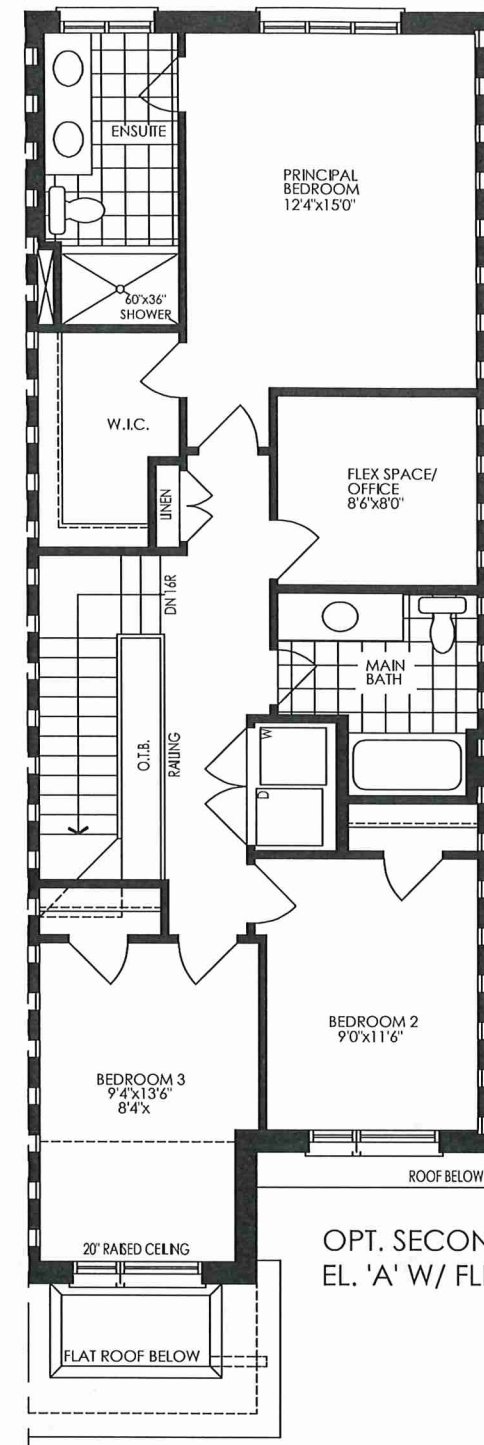

OPT. SECOND FLOOR PLAN,
EL. 'A' W/ FLEX SPACE

BLK.19	TH.24	20-16 THE CHARLOTTE	EL. A OPT. MAIN	4 BDRM.	2 BATH.	1795 SQ.FT
--------	-------	---------------------	-----------------	---------	---------	------------



ELEVATION A
THE CHARLOTTE
20-16
1,795 SQ. FT.
BLK.19 TH.124