



CONSTRUCTION SUMMARY
EARLGLEN INVESTMENTS INC.

PURCHASER: BOEUN PARK TEL: RES.: 647-609-6550

LOT NUMBER	PHASE	HOUSE TYPE	CLOSING DATE	
105 BLOCK 017	1	THE CHARLOTTE-ELEV A-OPT MAIN-3 BDRM-2 BATHS	08-Sep-26	

Offer	BONUS PACKAGE: PURCHASER TO RECEIVE \$10,000 (INCLUSIVE OF TAXES) WORTH OF UPGRADES AT DECOR CENTER AT TIME OF COLOUR CHART.
Worksheet	Note:

Offer	APPLIANCE PACKAGE: PURCHASER TO RECEIVE 5 APPLIANCES TO INCLUDE FRIDGE, STOVE, DISHWASHER WITH STAINLESS STEEL FINISH AND WHITE WASHER & DRYER AS PER VENDORS SAMPLES.
Worksheet	Note:

Offer	COMPLETE CENTRAL AIR CONDITIONING SYSTEM, AS PER VENDORS STANDARD SAMPLES.
Worksheet	Note:

Offer	VENDOR AGREES TO SUPPLY AND INSTALL 7 1/2inch LAMINATE FLOORING ON UPPER HALLWAY, AS PER PLAN AND AS PER VENDORS STANDARD SAMPLES.
Worksheet	Note:



CONSTRUCTION SUMMARY
EARLGLEN INVESTMENTS INC.

PURCHASER: BOEUN PARK TEL: RES.: 647-609-6550

LOT NUMBER	PHASE	HOUSE TYPE	CLOSING DATE
105 BLOCK 017	1	THE CHARLOTTE-ELEV A-OPT MAIN-3 BDRM-2 BATHS	08-Sep-26

Date Added: 25-Jun-25 Invoice Number: 8840

1 - Install Standard Cable Rough-Ins (x2) and Install Standard Telephone Rough-Ins (x2) (See Sketch) Note:
1 - KITCHEN - In addition to builders standard ceiling light, Install ONE (1) ADDITIONAL CEILING LIGHT with One (1) Seperate Switch - To be installed centred above kitchen island (See Sketch) Note:
1 - GREAT ROOM - In addition to builders standard ceiling light, Install FOUR (x4) LED POT LIGHTS Controlled by ONE (1) Seperate Switch - To be installed at great room (See Sketch) Note:
1 - 2ND FLOOR BEDROOMS - FLOORING - Install UPGRADE Laminate Flooring - 7 1/2" TORLYS RED OAK NAUTRAL EEH-N-240 in lieu of builder standard broadloom. To be installed throughout 2nd floor bedrooms, where applicable. Note: To Include; Primary Bedroom, Bedroom #2 and Bedroom #3 (See Sketch)
1 - STAIRCASE VS FLOORING WOOD SPECIES DIFFERENCE: STAIRCASE - The purchaser was advised and therefore accepts and acknowledges that the wood species of the staircase and flooring chosen do not match. This difference may result in a stain colour variance. Note: The purchaser agrees that the vendor is to be exempt from any and all claims by the purchaser regarding this colour variance.
1 - KITCHEN & BATHROOMS - Purchaser has DECLINED All Upgrades offered during decor appointment at the decor centre for kitchen & bathroom cabinetry. Standard Kitchen Layout & Standard Bathroom Vanities to be installed as per standard plan. (See Sketch) Note:
1 - APPLIANCES - KITCHEN - Install STANDARD Fridge, Stove, and Diswasher at Kitchen from builders standard appliance package (See Attached) Note: Install Builders Standard Exhaust Fan at kitchen, above stove
1 - APPLIANCES - LAUNDRY - Install UPGRADE WASHING MACHINE - Whirlpool Front Load Washer - Model # WFW560CHW - White (See Attached) Note:
1 - APPLIANCES - LAUNDRY - Install UPGRADE DRYER - Whirlpool Front Load Dryer - Model # YWED5620HW - White (See Attached) Note:
1 - APPLIANCES - LAUNDRY - Install UPGRADE STACKING KIT for Upgrade Washer & Dryer - Whirlpool Stack Kit Model # W10869845 - White (See Attached) Note:
1 - KITCHEN - COUNTERTOP - Install Builders Standard Stone Countertop – EVEREST WHITE GALAXY with STANDARD " A " EDGE PROFILE - To be installed throughout kitchen, where applicable (does not include stone backsplash) (See Sketch) Note:
1 - DISCLAIMER - STONE COUNTERTOP; KITCHEN - Due to the many variables that can affect the pattern, colour and/or design and “pitting” of stone products, stone installed will not be identical to the samples displayed. Note: Every effort is made to provide stone countertops as close as possible but the vendor is not responsible for results which differ from the sample displayed. All countertop surfaces may have seams, and product pattern and shade can change in areas containing seams.
1 - DISCLAIMER - STONE COUNTERTOP; KITCHEN - Stone slabs vary in size & all seams are visible & the fabricator reserves the right to position the seams as necessary. Note:
1 - KITCHEN - KITCHEN SINK - Install Builders Standard Undermount Sink – Kindred Undermount Sink – Model #RDU 1831/7 Note:



CONSTRUCTION SUMMARY
EARLGLEN INVESTMENTS INC.

PURCHASER: BOEUN PARK TEL: RES.: 647-609-6550

LOT NUMBER	PHASE	HOUSE TYPE	CLOSING DATE
105 BLOCK 017	1	THE CHARLOTTE-ELEV A-OPT MAIN-3 BDRM-2 BATHS	08-Sep-26

Date Added: 25-Jun-25 Invoice Number: 8840

1 - KITCHEN - KITCHEN FAUCET - Install Builders Standard Faucet - MOEN Method Single Handle Pull-Out (Single Hole) Kitchen Faucet - Model # 7585 – Chrome
Note:

1 - KITCHEN - BACKSPLASH TILE - Install UPGRADE Kitchen Backsplash Tile - 3x6 SUBWAY SILVER GREY BRIGHT - To be installed throughout kitchen backsplash area, where applicable. (does not include behind the fridge or stove)
Note: To be Installed STRAIGHT/STACKED (See Sketch)

1 - POWDER ROOM - COUNTERTOP - Install Builders Standard Stone Countertop – EVEREST MAPLE WHITE with STANDARD " A " EDGE PROFILE - To be installed throughout powder room vanity, where applicable (Includes Applicable Splash) (See Sketch)
Note:

1 - PRIMARY ENSUITE - COUNTERTOP - Install Builders Standard Stone Countertop – EVEREST MAPLE WHITE with STANDARD " A " EDGE PROFILE - To be installed throughout primary ensuite vanity, where applicable (Includes Applicable Splash) (See Sketch)
Note:

1 - MAIN BATH - COUNTERTOP - Install Builders Standard Stone Countertop – EVEREST MAPLE WHITE with STANDARD " A " EDGE PROFILE - To be installed throughout main bath vanity, where applicable (Includes Applicable Splash) (See Sketch)
Note:

1 - DISCLAIMER - STONE COUNTERTOP;
ALL BATHROOMS - Due to the many variables that can affect the pattern, colour and/or design and “pitting” of stone products, stone installed will not be identical to the samples displayed.
Note: Every effort is made to provide stone countertops as close as possible but the vendor is not responsible for results which differ from the sample displayed. All countertop surfaces may have seams, and product pattern and shade can change in areas containing seams.

1 - CLARIFICATION - PLUMBING FXTURES & PLUMBING FAUCETS;
ALL BATHROOMS - Install Builders Standard Plumbing Fixtures and Install Builders Standard Plumbing Faucets throughout all bathrooms, where applicable.
Note: To Include; Powder Room, Primary Ensuite and Main Bath (See Sketch)

1 - PRIMARY ENSUITE - Purchaser has DECLINED Upgrade to Install tiles on Primary Ensuite shower ceiling.
Purchaser accepts and acknowledges NO TILES will be installed on primary ensuite shower stall ceiling.
Note:

1 - MAIN BATH - Purchaser has DECLINED Upgrade to Install tiles on Main Bath tub/shower ceiling.
Purchaser accepts and acknowledges NO TILES will be installed on main bath tub/shower stall ceiling.
Note:

1 - BONUS PACKAGE - REFER TO PE #8839 ITEM #3 - PURCHASER HAS APPLIED REMAINING \$9,435.00 (Incudes Taxes) WORTH OF UPGRADE PROMOTIONAL PACKAGE TOWARDS THE PURCHASE OF DECOR UPGRADES COMPLETED AT THE DECOR CENTRE
Note:

1 - PURCHASER HAS ATTENDED A DECOR APPOINTMENT AT THE DESIGN STUDIO AND HAS DECLINED ANY ADDITIONAL UPGRADES. Purchaser accepts and acknowledges that there will be no further changes/additions/deletions to be made upon signing on JUNE 20,2025
Note:

1 - PURCHASER AWARE AND ACCEPTS THAT ANY CHANGES MADE TO UPGRADES AFTER SIGNING THIS PURCHASERS EXTRA FORM ARE SUBJECT TO A MINIMUM ADMINISTRATION FEE OF \$1,000
Note:

Date Added: 20-Jun-25 Invoice Number: 8839

1 - BASEMENT - WINDOWS - Delete Two Standard Windows 30 IN (W) x 16 IN (H) Install ONE (1) LARGER WINDOW 36 IN (W) x 24 IN (H) (with Possible Window Well) at Basement (See Sketch)
Note: As per Fonzie C.



CONSTRUCTION SUMMARY
EARLGLEN INVESTMENTS INC.

PURCHASER: BOEUN PARK

TEL: RES.: 647-609-6550

LOT NUMBER	PHASE	HOUSE TYPE	CLOSING DATE	
105 BLOCK 017	1	THE CHARLOTTE-ELEV A-OPT MAIN-3 BDRM-2 BATHS	08-Sep-26	

Date Added: 20-Jun-25 Invoice Number: 8839

1 - CLARIFICATION:
PRIMARY ENSUITE - Purchaser Accepts & Acknowledges revision made to primary ensuite vanity and toilet locations (As per Fonzie C.) (See Sketch)
Note:

1 - BONUS PACKAGE - PURCHASER HAS APPLIED \$10,000.00 (Incudes Taxes) WORTH OF UPGRADE PROMOTIONAL PACKAGE TOWARDS THE PURCHASE OF STRUCTURAL UPGRADES COMPLETED AT THE DECOR CENTRE
Note: **Remaining Bonus Package of \$9,435.00(Includes Taxes) will be applied to upgrades completed during decor appointment**

1 - PURCHASER HAS ATTENDED A STRUCTURAL APPOINTMENT AT THE DESIGN STUDIO AND HAS DECLINED ANY ADDITIONAL UPGRADES. Purchaser accepts and acknowledges that there will be no further structural changes/additions/deletions to be made upon signing on JUNE 20,2025
Note:

1 - PURCHASER AWARE AND ACCEPTS THAT ANY CHANGES MADE TO UPGRADES AFTER SIGNING THIS PURCHASERS EXTRA FORM ARE SUBJECT TO A MINIMUM ADMINISTRATION FEE OF \$1,000
Note:

This Document is Extremely Time Sensitive - Printed 2 Jul 25 at 10:53



Page 1 of 3

Page 1 of 3		Wall Tile				Plumbing	
	<u>Description</u>	<u>Main</u>	<u>Accent/Insert</u>	<u>Border / Listello</u>	<u>Pattern</u>		
Primary Ensuite	✓ 13x13 NEW BYZANTINE AZZURO (STD)	✓ 8x10 Uniwall Tender Grey Glossy (STD)	NONE	NONE	NONE	WHITE	
Main Bath	✓ 13x13 NEW BYZANTINE AZZURO (STD)	✓ 8x10 Uniwall Tender Grey Glossy (STD)	NONE	NONE	NONE	WHITE	
Laundry (2nd Floor)	✓ 13x13 NEW BYZANTINE AZZURO (STD)	N/A	N/A	N/A	NONE	STD	
Powder Room	✓ 13x13 NEW BYZANTINE AZZURO (STD)	N/A	N/A	N/A	NONE	WHITE	
Mud Room	✓ 13x13 NEW BYZANTINE AZZURO (STD)	N/A	N/A	N/A	NONE	N/A	
Kitchen/Dinette	✓ 13x13 NEW BYZANTINE AZZURO (STD)	✓ 3x6 Silver Grey Bright (Straight) (UPG)	NONE	NONE	NONE	STD	
Foyer	✓ 13x13 NEW BYZANTINE AZZURO (STD)	Railings and Stairs Railings STD - OVAL - Vintage Red Oak Natural Pickets STD - Steel 1/2" Sqaure, Plain - Flat Black Posts STD-3/12" Sqaure w/Cap Vint.RedOakNatural Stringers ✓ STD - VINTAGE RED OAK NATURAL Treads ✓ STD - VINTAGE RED OAK NATURAL Risers ✓ STD - VINTAGE RED OAK NATURAL Runner NONE Trim Baseboard & Casing STANDARD - MODERN Front Door Glass STANDARD Interior Doors STANDARD - CARRARA,SMOOTH Landing - Upper 7 1/2" Torlys RedOak Natural (STD) Landing - Lower 7 1/2" Torlys RedOak Natural (STD) Ledge - Upper N/A Ledge - Lower N/A Knobs ✓ STANDARD Hinges ✓ STANDARD Grip Set ✓ STANDARD Cornice Moulding / Medalion Foyer NONE Living Room NONE Dining Room NONE Family Room NONE Main Hall NONE Kitchen NONE 2nd Floor Hall NONE					
Main Hall	✓ 7 1/2" Torlys Red Oak Natural EEHN-240 (STD)						
Great Room	✓ 7 1/2" Torlys Red Oak Natural EEHN-240 (STD)						
Upper Hall	✓ 7 1/2" Torlys Red Oak Natural EEHN-240 (STD)						
Primary Bedroom	✓ 7 1/2" Torlys Red Oak Natural EEHN-240 (UPG)						
Bedroom 2	✓ 7 1/2" Torlys Red Oak Natural EEHN-240 (UPG)						
Bedroom 3	✓ 7 1/2" Torlys Red Oak Natural EEHN-240 (UPG)						

Page 1 of 3

Consultant: Melissa Di Marino

Purchaser: _____
BOEUN PARK

Vendor: EARL GLEN INVESTMENTS INC.



* INTERIOR COLOUR SCHEME *

Purchaser
BOEUN PARK

Decor Consultant
Melissa Di Marino

Model and Elevation
20-16 CHARLOTTE-ELEV A-OPT MAIN-3 BDRM-2 BA1

Telephone Res. / Bus
(647) 609-6550 /

Project
EARLGLEN INVESTMENTS INC.

Closing Date
08/09/2026

Property
105 BLOCK 017

Page 2 of 3

Interior Paint
Description
Primary Ensuite
STANDARD - SILVER BIRCH
Main Bath
STANDARD - SILVER BIRCH
Laundry (2nd Floor)
STANDARD - SILVER BIRCH
Powder Room
STANDARD - SILVER BIRCH
Mud Room
STANDARD - SILVER BIRCH
Kitchen/Dinette
STANDARD - SILVER BIRCH
Foyer
STANDARD - SILVER BIRCH
Main Hall
STANDARD - SILVER BIRCH
Great Room
STANDARD - SILVER BIRCH
Upper Hall
STANDARD - SILVER BIRCH
Primary Bedroom
STANDARD - SILVER BIRCH
Bedroom 2
STANDARD - SILVER BIRCH
Bedroom 3
STANDARD - SILVER BIRCH
Basement Landing

Cabinet	Countertop	Counter Edge	Handle / Knob
Style			
CATEGORY 1 - LP LAMINATE WILLOW GREY (SM) - QTC 1622 (STD)	✓ EVEREST MAPLE WHITE (STD)	✓ "A " EDGE (STD)	DH01010
CATEGORY 1 - LP LAMINATE WILLOW GREY (SM) - QTC 1622 (STD)	✓ EVEREST MAPLE WHITE (STD)	✓ "A " EDGE (STD)	DH01010
NONE	NONE	NONE	NONE
CATEGORY 1 - LP LAMINATE WILLOW GREY (SM) - QTC 1622 (STD)	✓ EVEREST MAPLE WHITE (STD)	✓ "A " EDGE (STD)	DH01010
N/A	N/A	N/A	N/A
CATEGORY 1 - LP LAMINATE FROSTING (SM) - QTC 1622 (STD)	✓ EVEREST WHITE GALAXY (STD)	✓ "A " EDGE (STD)	DH01010

Appliance Opening/Dimension

Fridge Size Range

Built-Ins Microwave

Hood Fan Exhaust Opening ☒ 6" ☐ 8"

Dishwasher Cabinet


Fireplace

Fireplace	N/A	Fireplace	N/A
Location Flooring	N/A	Location Flooring	N/A
Style	N/A	Style	N/A
Finish	N/A	Finish	N/A
Marble	N/A	Marble	N/A
Hearth	N/A	Hearth	N/A


Notes

**Kitchen Sink - Install Standard Undermount Sink - Kindred F Undermount Sink -
Model #RDU1831/7**Kitchen Faucet - Install Standard Faucet - MOEN Method Single Handle
Pull-Out (Single Hole) Kitchen Faucet - Model # 7585 - Chrome **APPLIANCES (See
Attached)

Page 2 of 3

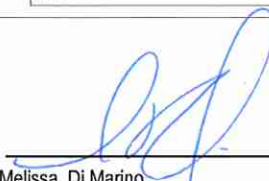Decor Consultant: 
Melissa Di Marino


Purchaser: 
BOEUN PARK

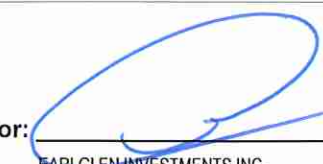Vendor: 
EARLGLEN INVESTMENTS INC.




June 20, 2025

BE

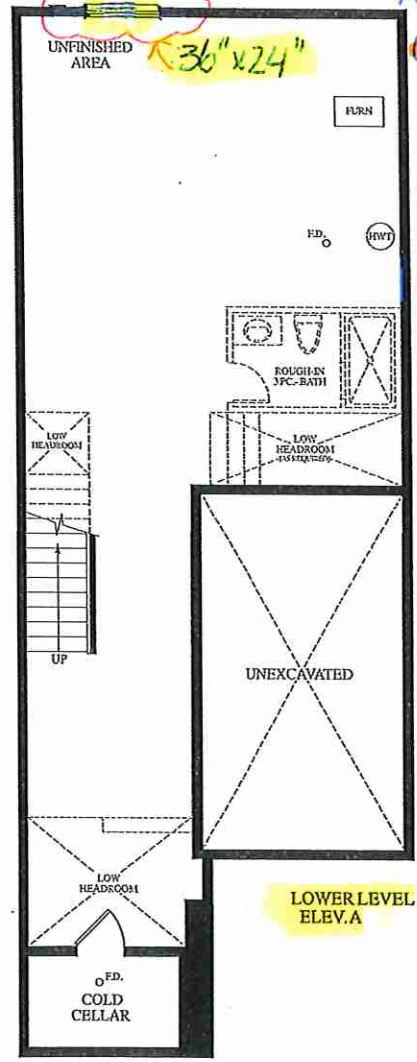


LOWER LEVEL ELEV. A

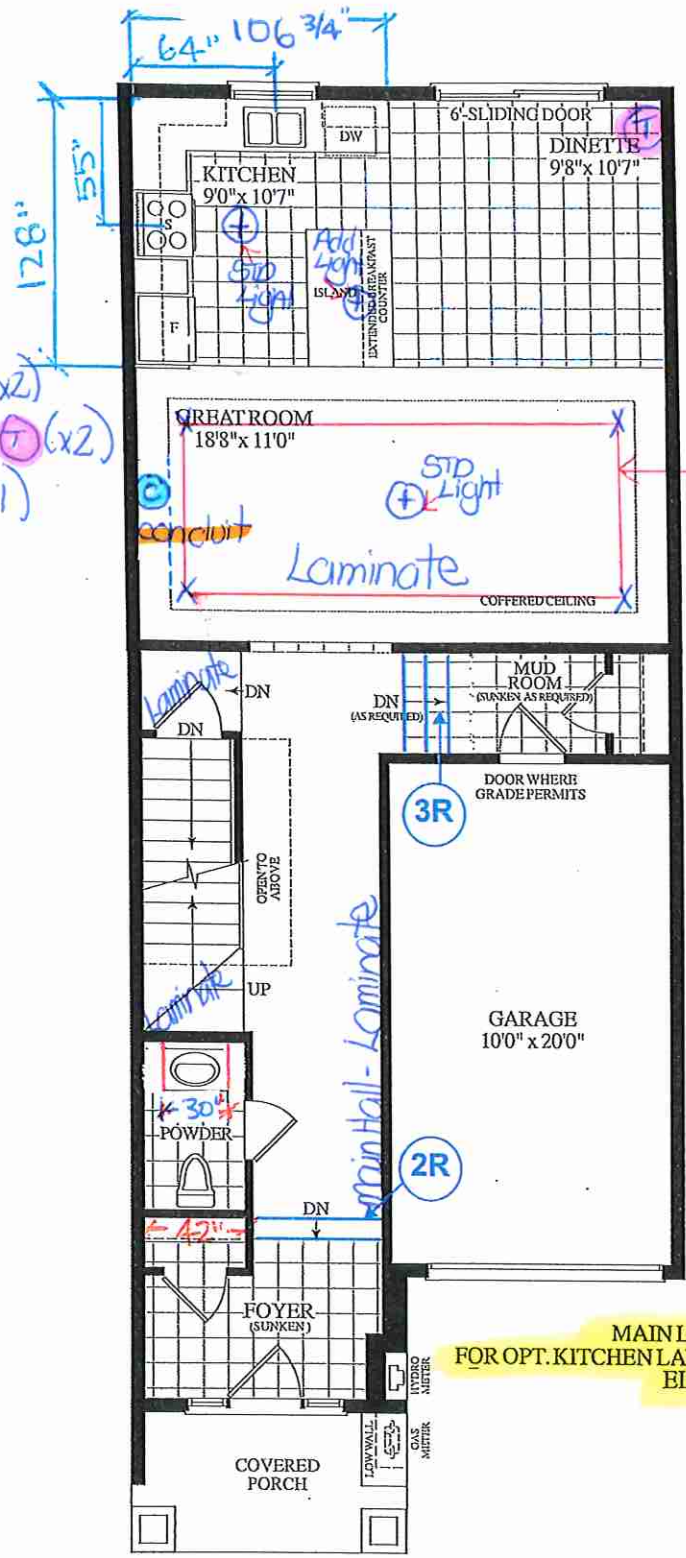

MAIN LEVEL FOR OPT. KITCHEN LAYOUT ELEV. A

Materials, specifications and floor plans are subject to change without notice. All renderings are artist's concept. All floor plans are approximate dimensions. Actual usable floor space may vary from the stated floor area, E.&O.E.

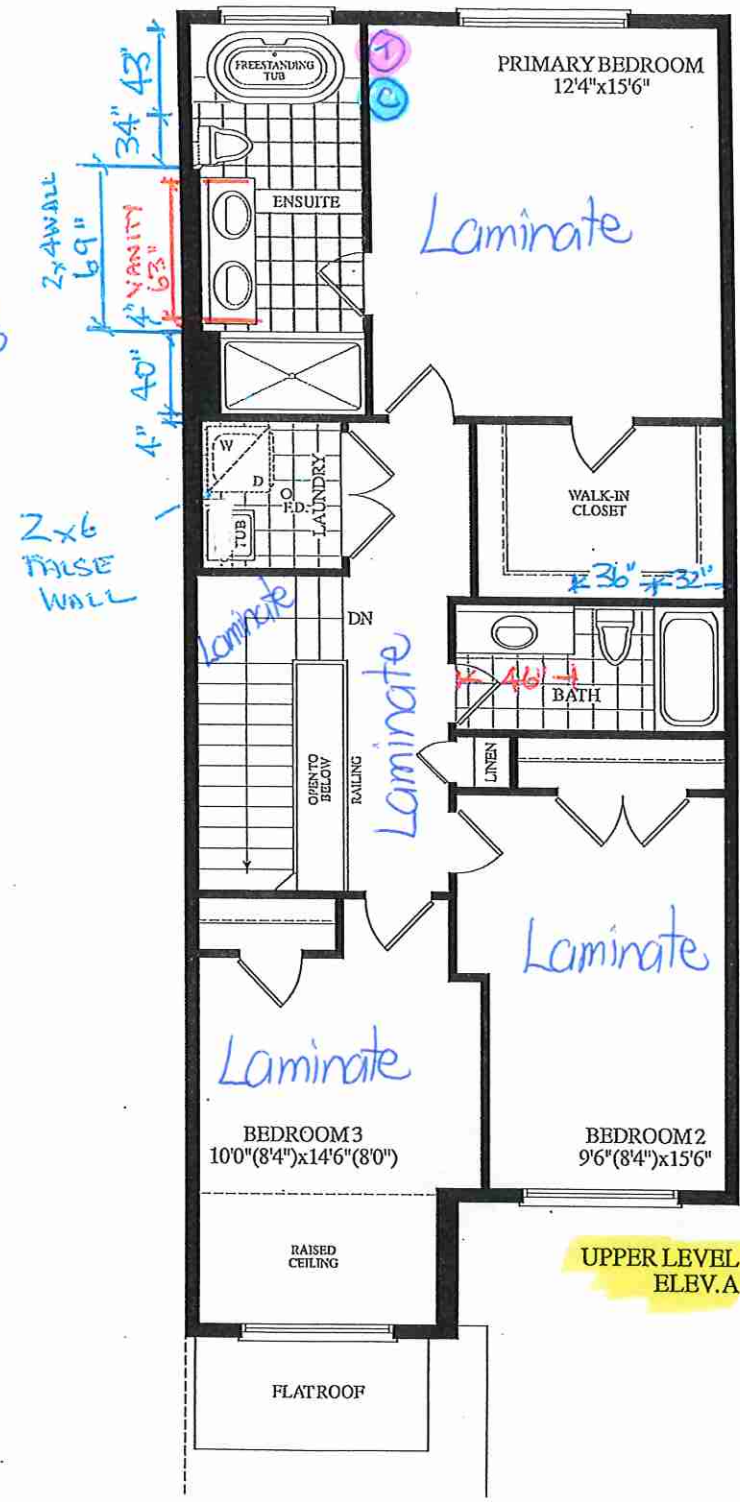

UPPER LEVEL ELEV. A

BLK.17 TH. 105 20-16 THE CHARLOTTE EL. A OPT. MAIN 3 BDRM. 2 BATH. 1795 SQ.FT

Standard



WRT318FZDM

Whirlpool®

30-inch Wide Top Freezer Refrigerator - 18 cu. ft.

<http://www.whirlpool.com>

Key Features:

- Electronic Temperature Controls
- Freezer Temperature Controls
- Optional Icemaker Kit
- Frameless Glass Shelves
- Dairy Bin
- Incandescent Lighting
- Fingerprint resistant

Product Dimensions:

Height: 65 7/8

Width: 29 3/4

Depth: 33 1/2

Electrical Requirements:

6.5. 115V.

Additional Information:


[Owners Manual](#)

[Dimension Guide](#)

[Installation Guide](#)

[Energy Guide](#)

[Warranty Certificate](#)

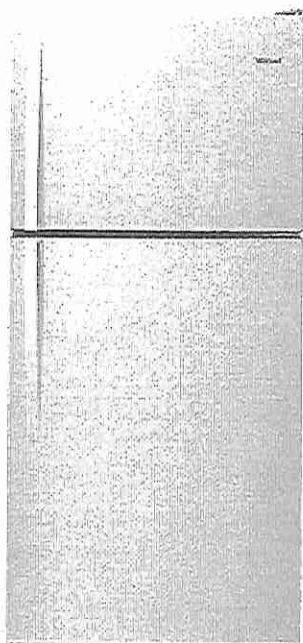

Available in:

- Black
- Monochromatic
- Stainless Steel
- White



©Registered trademark/TM Trademark of Whirlpool, U.S.A. © 2023 Whirlpool Corporation. All Rights Reserved.
All other trademarks are owned by their respective companies.
Because Whirlpool Corporation policy includes a continuous commitment to improve our products, we reserve the right to change materials and specifications without notice. We also reserve the right to discontinue or transition products without notice.
Manufacturer's Suggested Retail Price (MSRP) and Minimum Advertised Price (MAP) provided for reference purposes only. Dealer alone determines advertised and retail prices.
Created On: Friday, January 26, 2024 17:34:55

Standard



5.3 cu. ft. Whirlpool® electric range with Frozen Bake™ technology

YWFE515S0JS

Available Finishes/Colours



YWFE515S0JB
Black

YWFE515S0JW
White



YWFE515S0JS
Stainless Steel

Dimensions	
Depth	27 3/4
Height	36
Width	29 7/8

Features	
Heating Element On Indicator Light	Yes
Power On Indicator Light	No
Griddle	NA
Automatic Convection Conversion Temperature Adjust	No
Power Outage Compatible	No

Configuration and Overview	
Range Type	Freestanding
Fuel Type	Electric
Size (IN, inches)	30

Oven Details	
Door Removable	Yes
Drawer Type	Storage Drawer
Power On Indicator Light	No
Automatic Convection Conversion Temperature Adjust	No
Automatic Shut-Off	No

This Whirlpool® electric range with a dual element stove top helps you get dinner to the table. Skip preheating for favorites like pizza with Frozen Bake™ technology. This self cleaning oven also prevents cooked food from getting cold with the Keep Warm setting. Closed door broiling helps keep the kitchen comfortable.

Top Features
FlexHeat™ Dual Radiant Element
Frozen Bake™ technology
Keep Warm setting

Manuals & Literature:

- [Installation Guide](#)
- [Use and Care Guide](#)
- [Warranty Information](#)

Exterior	
Door Removable	Yes
Drawer Type	Storage Drawer
Oven Door	Glass Window
Oven Window Size	Extra Large
Handle Color	Stainless Steel
Handle Material	Metal
Handle Type	Reach-Through Handle

Features	
Hot Surface Indicator Light	Yes



Because Whirlpool Corporation policy includes a continuous commitment to improve our products, we reserve the right to change materials and specifications without notice. Dimensions are for planning purposes only. For complete details, see Installation Instructions packed with product. Specifications subject to change without notice.

Standard



Whirlpool® Quiet Dishwasher with Boost Cycle

WDF341PAPM

Available Finishes/Colours

☐ WDF341PAPM
Stainless Steel

☐ WDF341PAPB
Black

☐ WDF341PAPW
White

Dimensions		Specifications	
Depth	24.5	Required Accessories	W10685193
Height	33.5	Cycles and Options	
Width	23.88		

Clean dishes with a 57 dBA quiet dishwasher. A Boost Cycle provides extra effort for stubborn messes while an Extended Dry Option elevates drying performance. This fast dishwasher includes a Quick Wash Cycle that cleans dishes quickly and a Triple Filtration Wash System that filters food particles and cleans the water between wash stages.

Top Features

57 dBA

Heavy cycle

Boost Cycle

Manuals & Literature:

[Dimension Guide](#)

[Energy Guide](#)

[Installation Guide](#)

[Owner Manual](#)

[Warranty Information](#)

Compatibility		Dishwasher Cycle Selections	
Connectivity	No	Heavy; Normal; Quick Wash; Boost	

Controls		Cycles	
Automatic Temperature Controls	Yes	Number Of Wash Cycles	4


Control Location		Details	
Control Type	Electronic	Drying System Type	Recessed Heating Element
End Of Cycle Signal	Yes	Hoses Included	Drain Hose
Last Cycle Recall	Yes	Interior Light	No
Status Light	Yes, Blue	Number Of Racks	2

Specifications		Number Of Washarms	
Country Of Origin	USA	Number Of Washarms	2
Quick Wash	Yes	Rack Material	PVC
Optional Accessories	W11365014	Tub Material	Plastic
		Tub Style	Built-in Tall Tub 24in.



Because Whirlpool Corporation policy includes a continuous commitment to improve our products, we reserve the right to change materials and specifications without notice. Dimensions are for planning purposes only. For complete details, see Installation Instructions packed with product. Specifications subject to change without notice.

Upgrade

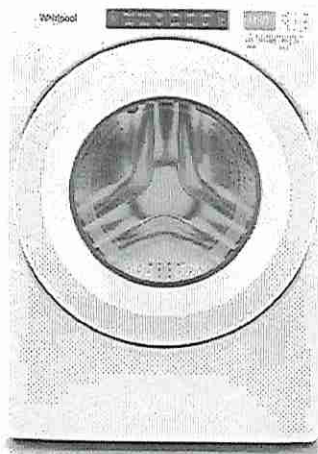

5.0 cu.ft I.E.C. Closet-Depth Front Load Washer with Intuitive Controls

WFW560CHW

Available Finishes/Colours

☐ WFW560CHW
White

Dimensions	
Depth	31 9/16
Width	27

Exterior	
Lid/Door Lock	Yes
Lid/Door Swing	Left
Window	Yes

Controls	
Automatic Temperature Controls	Yes
Control Type	Tap Touch
Control Location	Front
Electronic Display Type	Cycle Indicator Lights with Digital Time Remaining
End of Cycle Signal	Yes

Controls	
LCD Touch Screen	No
LED Color	Blue

Compatibility	
Connectivity	No
Works With	No

Appearance	
Window	Yes
LCD Touch Screen	No

Details	
Advanced Vibration Control™	No
Automated Dispenser	N/A
Automatic Load Size Sensing Technology	Yes

Match your family's routines and your space with a closet-depth front load washing machine that still offers plenty of room for bulky items at 5.0 cu. ft. I.E.C. capacity. Let the ENERGY STAR® certified washer guide you to the right cycle combinations, like the Sanitize cycle with Oxi, or customize up to 35 of your own with Intuitive Controls.


Top Features
5.0 cu. ft. I.E.C. Capacity
ENERGY STAR® Certified
Intuitive Controls

Manuals & Literature:	
Energy Guide	Installation Guide
Use and Care Guide	Warranty Information



Because Whirlpool Corporation policy includes a continuous commitment to improve our products, we reserve the right to change materials and specifications without notice. Dimensions are for planning purposes only. For complete details, see Installation Instructions packed with product. Specifications subject to change without notice.

Upgrade

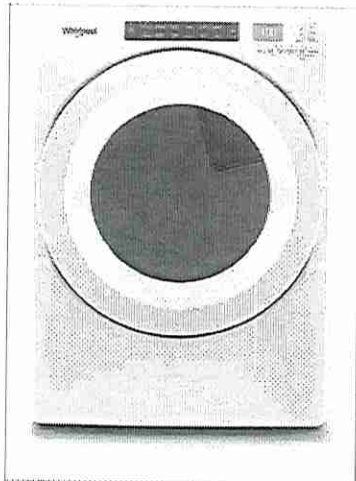

7.4 cu. ft. Front Load Electric Dryer with Intuitive Touch Controls

YWED5620HW

Available Finishes/Colours

☐ YWED5620HW
White

Dimensions	
Depth	31
Height	38 3/4
Width	27

Configuration and Overview	
Fuel Type	Electric

Appearance	
Door Style	Side Swing
Window	Yes
Reversible Door	Yes

Controls	
Control Type	Electronic
Feedback-Status Indicators	Check Vent, Cool Down, Damp, Sensing, Wet
Control Location	Front Panel
End of Cycle Signal	Yes

Exterior	
Door Style	Side Swing
Window	Yes
Door Opening	Right
Reversible Door	Yes

Misc.	
Accessory Relationships	Yes
Home Delivery	Yes
Will Call	Yes

Details	
Eco Monitor/Efficiency Monitor	No
Maytag Commercial Components	No
Automatic Dry Control	Yes
Moisture Sensor	Yes

Let the front load electric dryer guide you to the right cycle combinations for whatever you're drying with Intuitive Controls. Advanced Moisture Sensing uses three moisture sensors to help prevent overdrying. The ENERGY STAR® certified electric dryer helps keep wrinkles from setting after the cycle with the Wrinkle Shield™ option.

Top Features

Wrinkle Shield™ Option

7.4 cu. ft. Capacity

Intuitive Controls

Manuals & Literature:

[Installation Guide](#) [Use and Care Guide](#)
 [Warranty Information](#)

Whirlpool®

Because Whirlpool Corporation policy includes a continuous commitment to improve our products, we reserve the right to change materials and specifications without notice. Dimensions are for planning purposes only. For complete details, see Installation Instructions packed with product. Specifications subject to change without notice.

Upgrade




Stack Kit for HYBRIDCARE™ & Long Vent / Standard Dryer

W10869845

Available Finishes/Colours

W10869845
Other

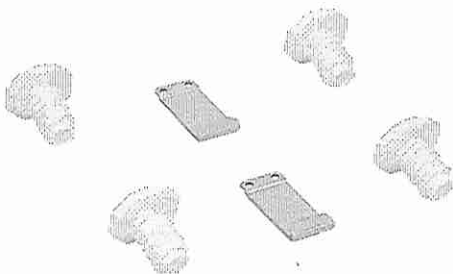

Misc.	
UPS Shippable	UPS1
Home Delivery	Yes
Will Call	Yes

We all seem to need a little more space, especially in the laundry room. This authentic Stack Kit can easily maximize your laundry space allowing you to stack your dryer on top of your washer. Designed for Hybridcare, Long Vent and Standard Dryers-Kit includes 2 brackets, 4 washer feet and instructions.

Top Features

This product is a Factory Certified Accessory. These three words represent quality parts and accessories designed specifically for your appliance. Time tested engineering that meets our strict quality specifications

No tools required for installation

Package contains (1) 27" Front Load Stack Kit

Manuals & Literature:

[Installation Guide](#)

Because Whirlpool Corporation policy includes a continuous commitment to improve our products, we reserve the right to change materials and specifications without notice. Dimensions are for planning purposes only. For complete details, see Installation Instructions packed with product. Specifications subject to change without notice.

Lot 105 / BIK 17




80 Sante Drive, Vaughan, ON L4K 3C4
T 416.746.1811 F 905.761.5901
www.QTK.ca info@qtk.ca

CLIENT: ROYAL PINE HOMES	JOB NAME: 2016 (OPT KITCHEN)	ROOM: KITCHEN	DRAWN BY: PS
SITE: EARLGLEN	DOOR STYLE: —	DOOR HANDLE: —	SCALE: 1/2" = 1'-0"
PHONE: —	FINISH: —	DRW HANDLE: —	DATE: 03 APRIL 2015
EMAIL: —	SPECIES: —	TOP: —	PAGE: 1 OF 1
COMMENTS:	CUSTOMER INITIALS:  CUSTOMER INITIALS:		

Customer Agrees and Accepts the following conditions: 1. The Drawing is a representation only and the installed cabinetry may vary slightly in product size, measurements, handle appearance and location and other details. Although Quality Tops & Kitchens Ltd. (QTK) does it's best to manufacture exactly what is shown here outside factors may prevent that and some variance is to be expected and accepted by the customer. 2. These drawings represent the intellectual property of QTK and as such the customer understands and accepts that all deposits given by the customer to QTK are non-refundable after QTK has supplied drawings (either physically or electronically) to the customer. If the customer decides to cancel the order after QTK has submitted drawings to the customer, the deposit will then be considered a design fee and no money will be returned to the customer. Door/drawer fronts with inner profiles may receive slab fronts due to rail size restrictions based on width/height of the panels or site conditions.

KITCHEN PLAN

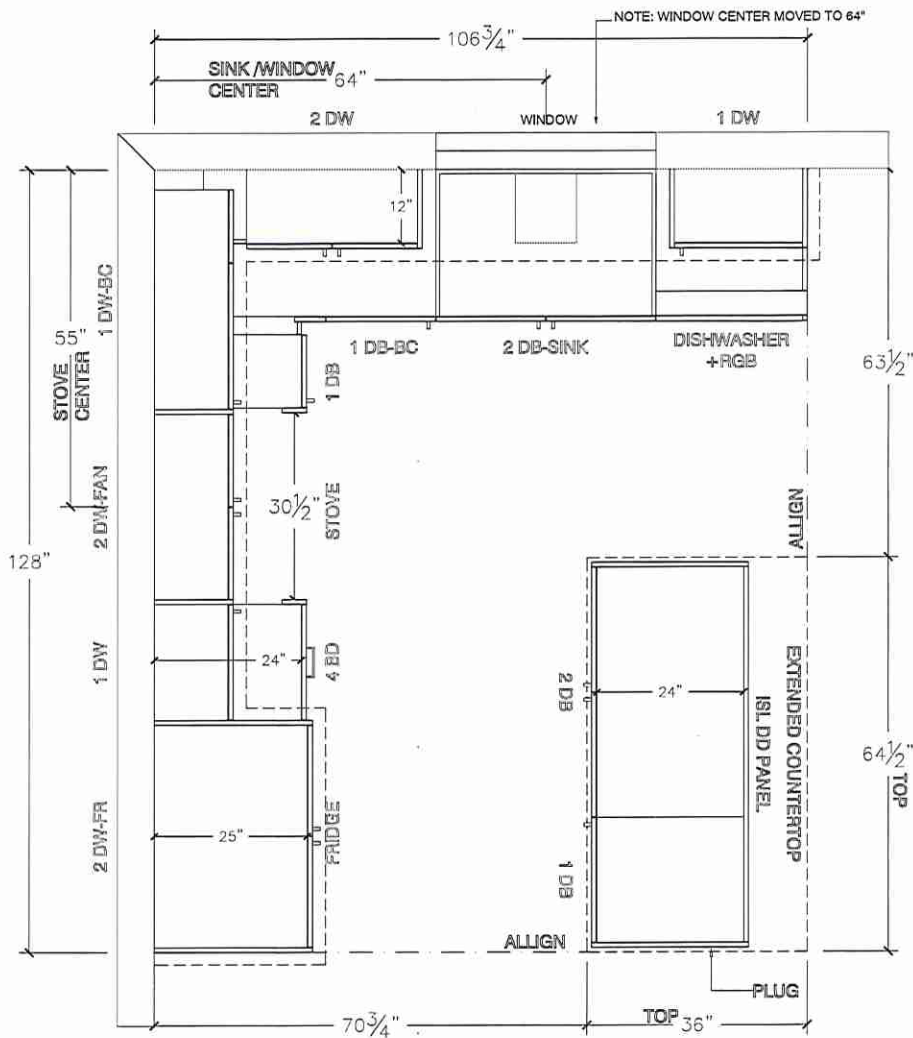

Lot 105/BIK 17




80 Sante Drive, Vaughan, ON L4K 3C4
T 416.746.1811 F 905.761.5901
www.QTK.ca info@qtk.ca


CLIENT: ROYAL PINE HOMES	JOB NAME: 2016 (OPT KITCHEN)	ROOM: KITCHEN	DRAWN BY: PS
SITE: EARLGLEN	DOOR STYLE: _	DOOR HANDLE: _	SCALE: 3/8" = 1'-0"
PHONE: _	FINISH: _	DRW HANDLE: _	DATE: 03 APRIL 2015
EMAIL: _	SPECIES: _	TOP: _	PAGE: 1 OF 1
COMMENTS:	CUSTOMER INITIALS: _____		

Customer Agrees and Accepts the following conditions: 1. The Drawing is a representation only and the installed cabinetry may vary slightly in product size, measurements, handle appearance and location and other details. Although Quality Tops & Kitchens Ltd. (QTK) does it's best to manufacture exactly what is shown here outside factors may prevent that and some variance is to be expected and accepted by the customer. 2. These drawings represent the intellectual property of QTK and as such the customer understands and accepts that all deposits given by the customer to QTK are non-refundable after QTK has supplied drawings (either physically or electronically) to the customer. If the customer decides to cancel the order after QTK has submitted drawings to the customer, the deposit will then be considered a design fee and no money will be returned to the customer. Door/drawer fronts with inner profiles may receive slab fronts due to rail size restrictions based on width/height of the panels or site conditions.

STOVE WALL ELEVATION

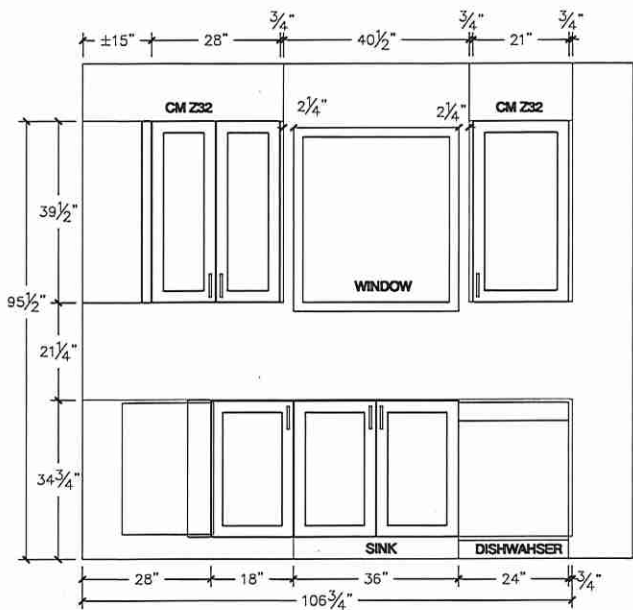

FRIDGE WALL ELEVATION

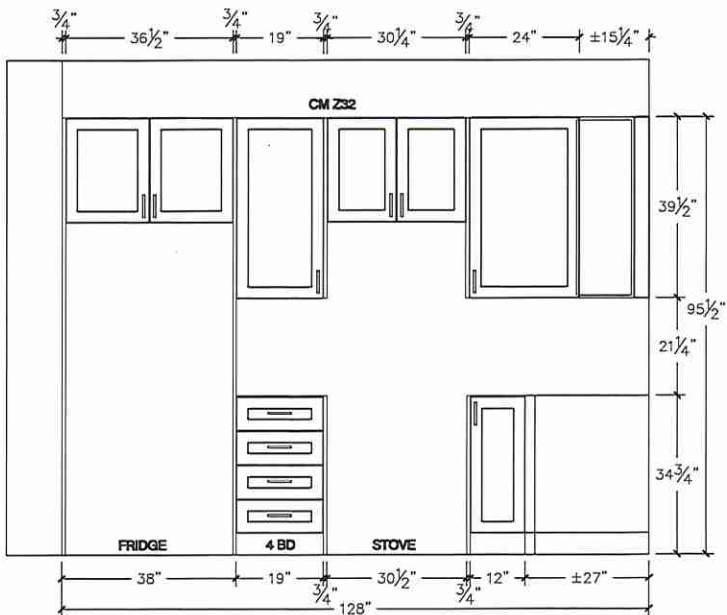

Lot 105/B1K17




80 Sante Drive, Vaughan, ON L4K 3C4
T 416.746.1811 F 905.761.5901
www.QTK.ca info@qtk.ca


CLIENT: ROYAL PINE HOMES	JOB NAME: 2016 (OPT KITCHEN)	ROOM:	DRAWN BY: PS
SITE: EARLGLEN	DOOR STYLE: —	DOOR HANDLE: —	SCALE: 1/2" = 1'-0"
PHONE: —	FINISH: —	DRW HANDLE: —	DATE: 03 APRIL 2015
EMAIL: —	SPECIES: —	TOP: —	PAGE: 1 OF 1
COMMENTS:	CUSTOMER INITIALS:	CUSTOMER INITIALS:	

Customer Agree and Accepts the following conditions: 1. The Drawing is a representation only and the installed cabinetry may vary slightly in product size, measurements, handle appearance and location and other details. Although Quality Tops & Kitchens Ltd. (QTK) does it's best to manufacture exactly what is shown here outside factors may prevent that and some variance is to be expected and accepted by the customer. 2. These drawings represent the intellectual property of QTK and as such the customer understands and accepts that all deposits given by the customer to QTK are non-refundable after QTK has supplied drawings (either physically or electronically) to the customer. If the customer decides to cancel the order after QTK has submitted drawings to the customer, the deposit will then be considered a design fee and no money will be returned to the customer. Door/drawer fronts with inner profiles may receive slab fronts due to rail size restrictions based on width/height of the panels or site conditions.


ISLAND FRONT ELEVATION

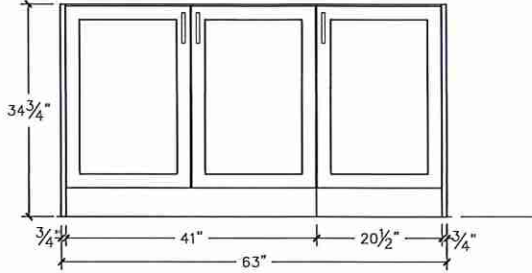

ISLAND REAR ELEVATION

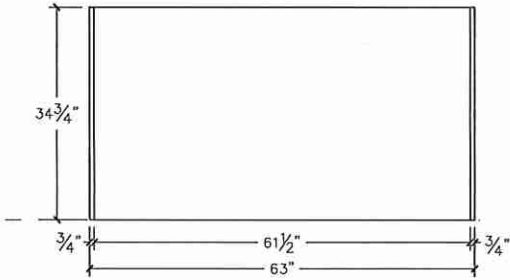

ISLAND SIDE ELEVATION

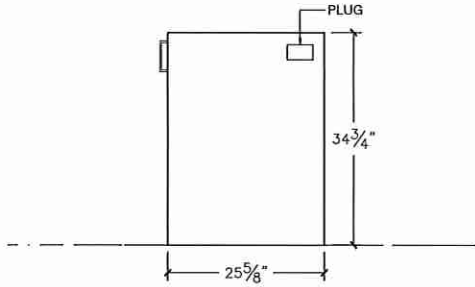

Lot 105/BIK 17




your kitchen, your taste.

80 Sante Drive, Vaughan, ON L4K 3C4
T 416.746.1811 F 905.761.5901
www.QTK.ca info@qtk.ca

CLIENT: ROYAL PINE HOMES	JOB NAME: 2016 (OPT KITCHEN)	ROOM:	DRAWN BY: PS
SITE: EARLGLEN	DOOR STYLE: —	DOOR HANDLE: —	SCALE: 1/2" = 1'-0"
PHONE: —	FINISH: —	DRW HANDLE: —	DATE: 03 APRIL 2015
EMAIL: —	SPECIES: —	TOP:	PAGE: 1 OF 1
COMMENTS:	CUSTOMER INITIALS:	CUSTOMER INITIALS:	

Customer Agrees and Accepts the following conditions: 1. The Drawing is a representation only and the installed cabinetry may vary slightly in product size, measurements, handle appearance and location and other details. Although Quality Tops & Kitchens Ltd. (QTK) does it's best to manufacture exactly what is shown here outside factors may prevent that and some variance is to be expected and accepted by the customer. 2. These drawings represent the intellectual property of QTK and as such the customer understands and accepts that all deposits given by the customer to QTK are non-refundable after QTK has supplied drawings (either physically or electronically) to the customer. If the customer decides to cancel the order after QTK has submitted drawings to the customer, the deposit will then be considered a design fee and no money will be returned to the customer. Door/drawer fronts with inner profiles may receive slab fronts due to mill size restrictions based on width/height of the panels or site conditions.

3D VIEW

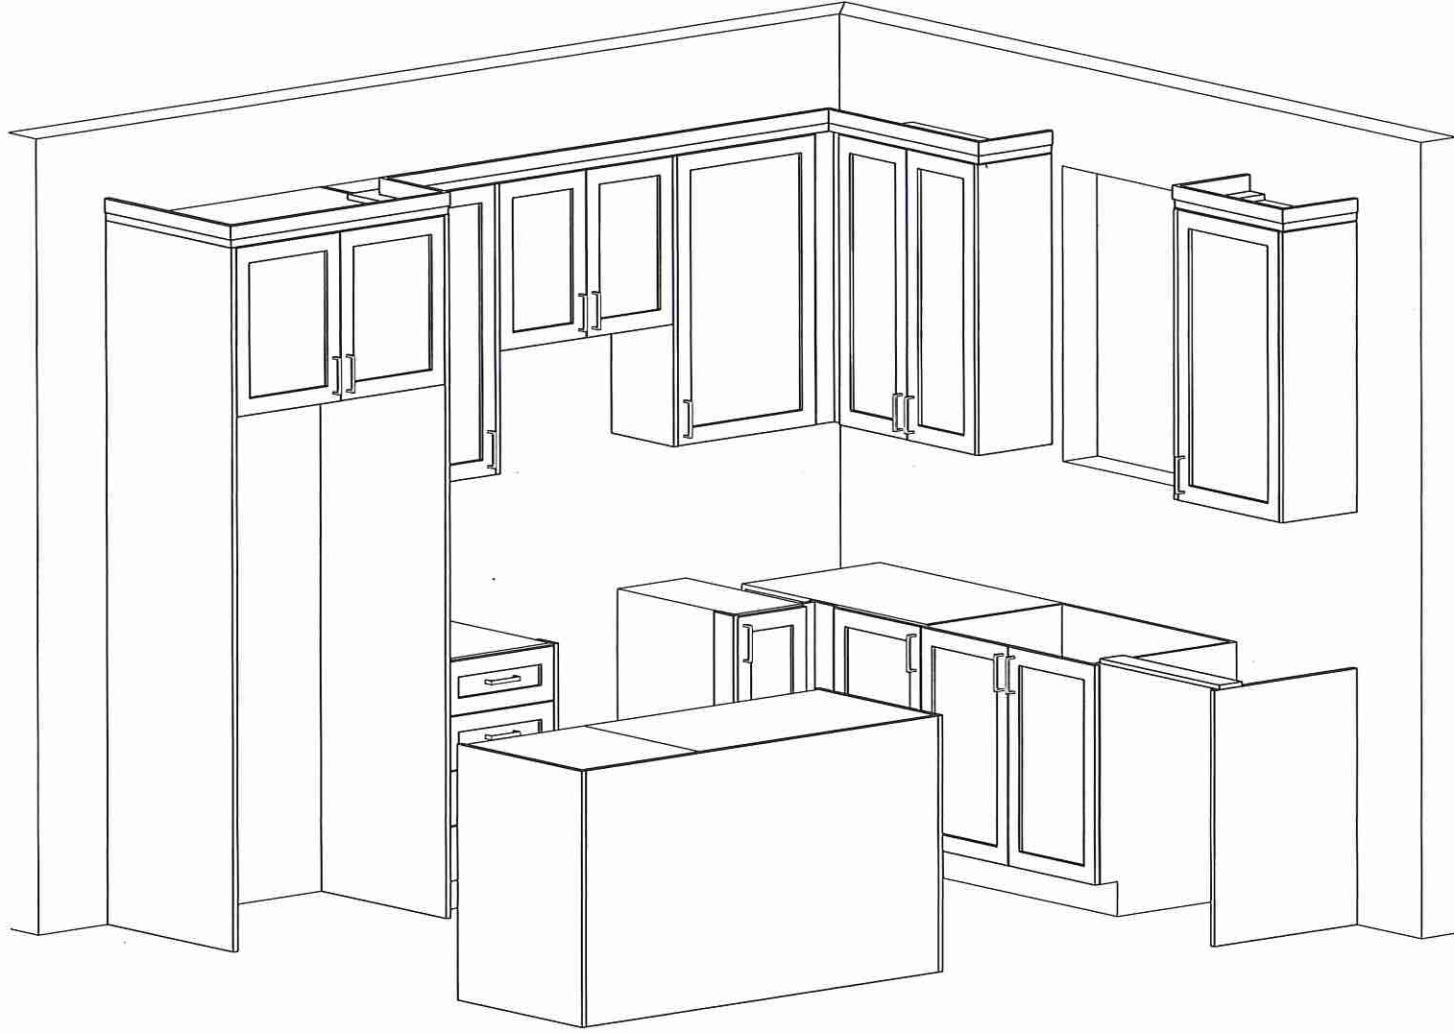



Lot 105/B1K17



80 Sante Drive, Vaughan, ON L4K 3C4
T 416.746.1811 F 905.761.5901
www.QTK.ca info@qtk.ca

CLIENT: ROYAL PINE HOMES	JOB NAME: BLK 17-105 EG (2016)	ROOM: VANITIES	DRAWN BY: PS
SITE: EARLGLEN	DOOR STYLE: —	DOOR HANDLE: —	SCALE: 1/2" = 1'-0"
PHONE: —	FINISH: —	DRW HANDLE: —	DATE: JUNE 26 2025
EMAIL: —	SPECIES: —	TOP: —	PAGE: 1 OF 1
COMMENTS:	CUSTOMER INITIALS:		

Customer Agrees and Accepts the following conditions: 1. The Drawing is a representation only and the installed cabinetry may vary slightly in product size, measurements, handle appearance and location and other details. Although Quality Tops & Kitchens Ltd. (QTK) does it's best to manufacture exactly what is shown here outside factors may prevent that and some variance is to be expected and accepted by the customer. 2. These drawings represent the intellectual property of QTK and as such the customer understands and accepts that all deposits given by the customer to QTK are non-refundable after QTK has supplied drawings (either physically or electronically) to the customer. If the customer decides to cancel the order after QTK has submitted drawings to the customer, the deposit will then be considered a design fee and no money will be returned to the customer. Door/drawer fronts with inner profiles may receive slab fronts due to rail size restrictions based on width/height of the panels or site conditions.

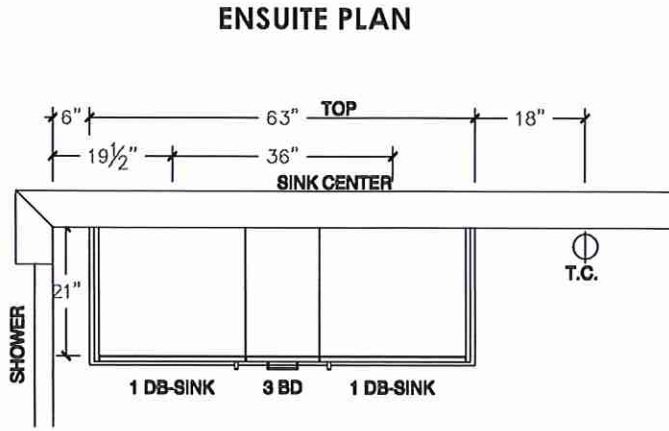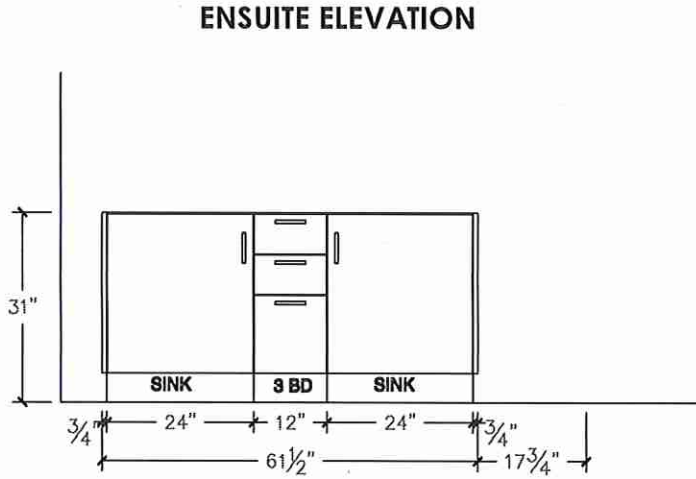

Lot 105/BIK 17




80 Sante Drive, Vaughan, ON L4K 3C4
T 416.746.1811 F 905.761.5901
www.QTK.ca info@qtk.ca


CLIENT: ROYAL PINE HOMES	JOB NAME: 2016	ROOM: VANITIES	DRAWN BY: PS
SITE: EARLGLEN	DOOR STYLE: —	DOOR HANDLE: —	SCALE: 1/2" = 1'-0"
PHONE: —	FINISH: —	DRW HANDLE: —	DATE: 02 APRIL 2025
EMAIL: —	SPECIES: —	TOP: —	PAGE: 1 OF 1
COMMENTS:	CUSTOMER INITIALS: 		

Customer Agrees and Accepts the following conditions: 1. The Drawing is a representation only and the installed cabinetry may vary slightly in product size, measurements, handle appearance and location and other details. Although Quality Tops & Kitchens Ltd. (QTK) does it's best to manufacture exactly what is shown here outside factors may prevent that and some variance is to be expected and accepted by the customer. 2. These drawings represent the intellectual property of QTK and as such the customer understands and accepts that all deposits given by the customer to QTK are non-refundable after QTK has supplied drawings (either physically or electronically) to the customer. If the customer decides to cancel the order after QTK has submitted drawings to the customer, the deposit will then be considered a design fee and no money will be returned to the customer. Door/drawer fronts with inner profiles may receive slab fronts due to rail size restrictions based on width/height of the panels or site conditions.


MAIN BATH PLAN

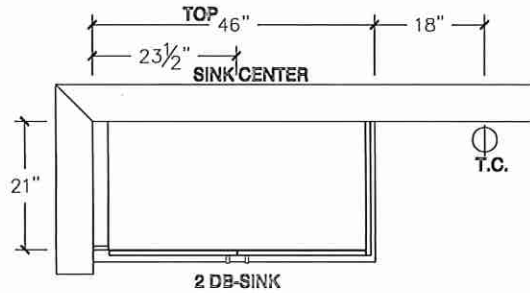


MAIN BATH PLAN (OPT W/FLEX SPACE)

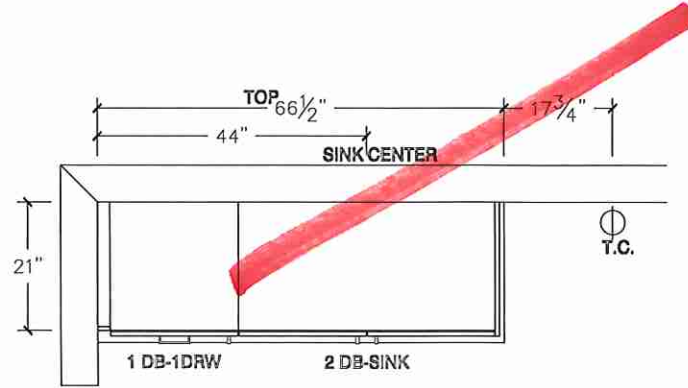

MAIN BATH ELEVATION

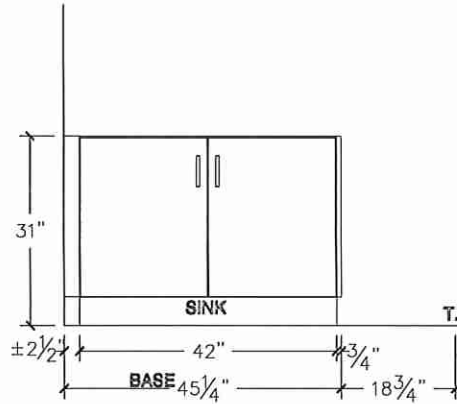

MAIN BATH ELEVATION (OPT W/FLEX SPACE)

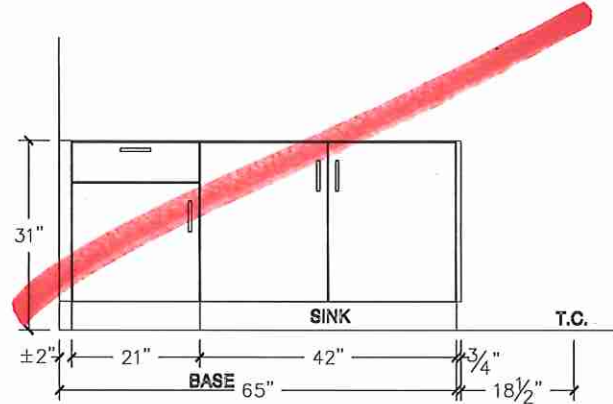

Lot 105/131K17




80 Sante Drive, Vaughan, ON L4K 3C4
T 416.746.1811 F 905.761.5901
www.QTK.ca info@qtk.ca


CLIENT: ROYAL PINE HOMES	JOB NAME: 2016	ROOM: VANITIES	DRAWN BY: PS
SITE: EARLGLEN	DOOR STYLE: —	DOOR HANDLE: —	SCALE: 1/2" = 1'-0"
PHONE: —	FINISH: —	DRW HANDLE: —	DATE: 02 APRIL 2025
EMAIL: —	SPECIES: —	TOP: <i>PS</i>	PAGE: 1 OF 1
COMMENTS:	CUSTOMER INITIALS:		

Customer Agrees and Accepts the following conditions: 1. The Drawing is a representation only and the installed cabinetry may vary slightly in product size, measurements, handle appearance and location and other details. Although Quality Tops & Kitchens Ltd. (QTK) does it's best to manufacture exactly what is shown here outside factors may prevent that and some variance is to be expected and accepted by the customer. 2. These drawings represent the intellectual property of QTK and as such the customer understands and accepts that all deposits given by the customer to QTK are non-refundable after QTK has supplied drawings (either physically or electronically) to the customer. If the customer decides to cancel the order after QTK has submitted drawings to the customer, the deposit will then be considered a design fee and no money will be returned to the customer. Door/drawer fronts with inner profiles may receive slab fronts due to rail size restrictions based on width/height of the panels or site conditions.


BATH 2 PLAN (OPT W/ 3 BATH)

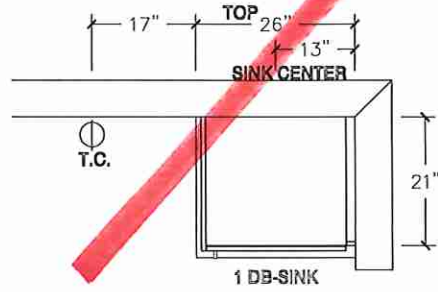


OPT BSMT BATH PLAN

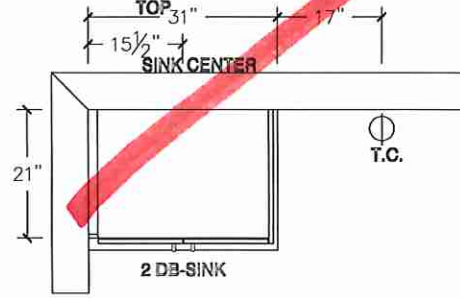


POWDER ROOM PLAN

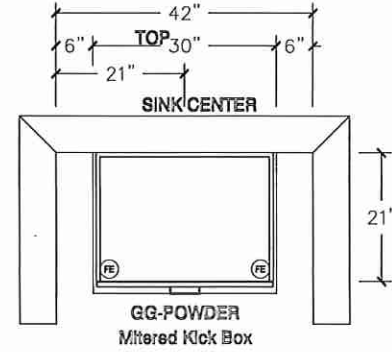


BATH 2 ELEVATION (OPT W/ 3 BATH)

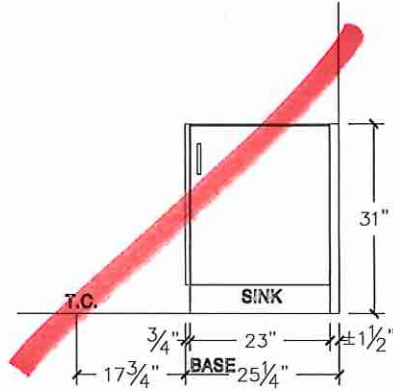

OPT BSMT BATH ELEVATION

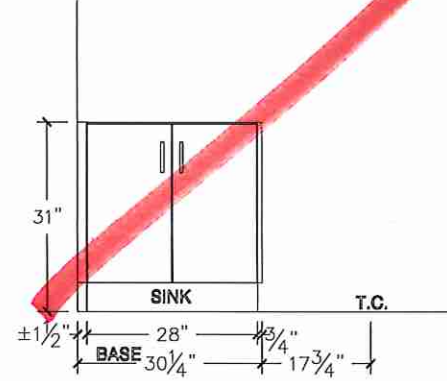

POWDER ROOM ELEVATION

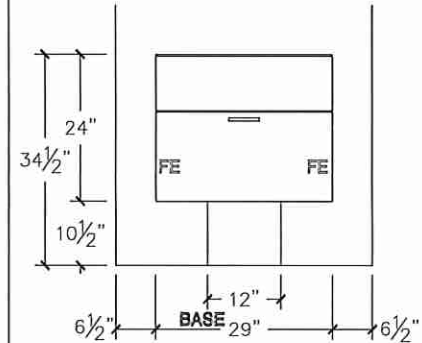

67