





DECK CONDITION




ELEVATION C

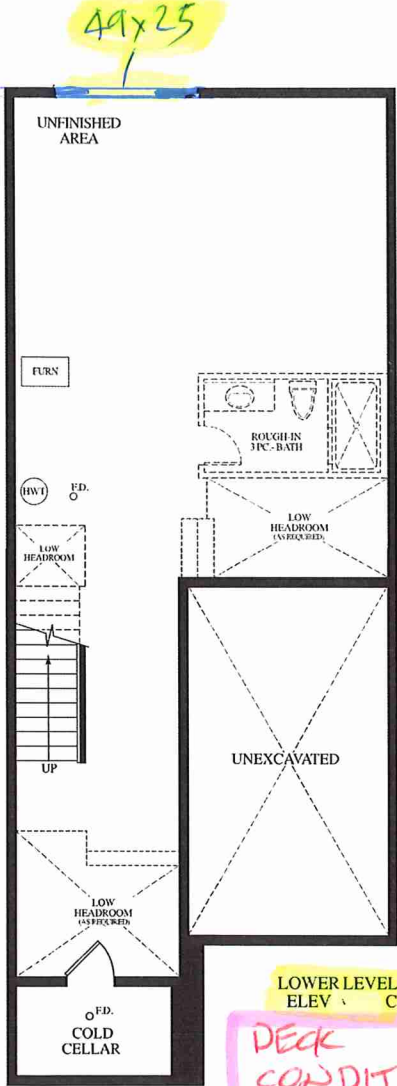

LOWER LEVEL
ELEV. C
DECK
CONDITION

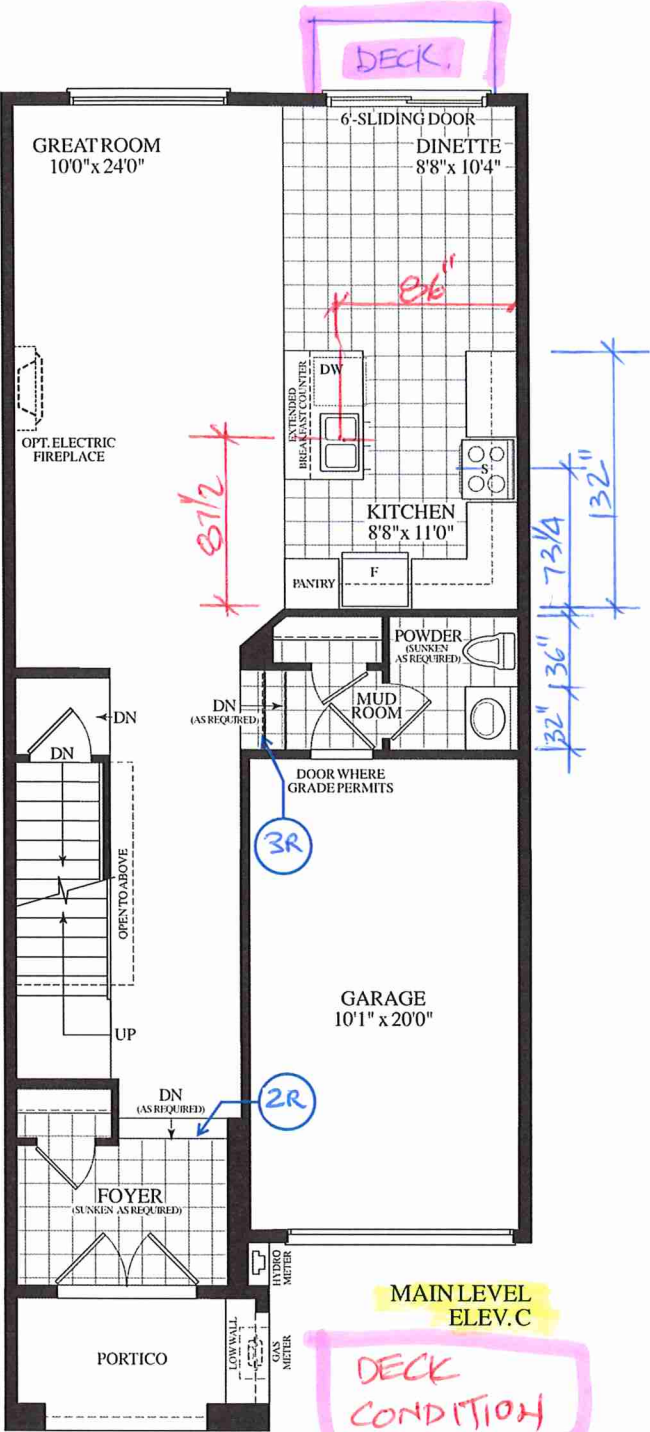

MAIN LEVEL
ELEV. C
DECK
CONDITION

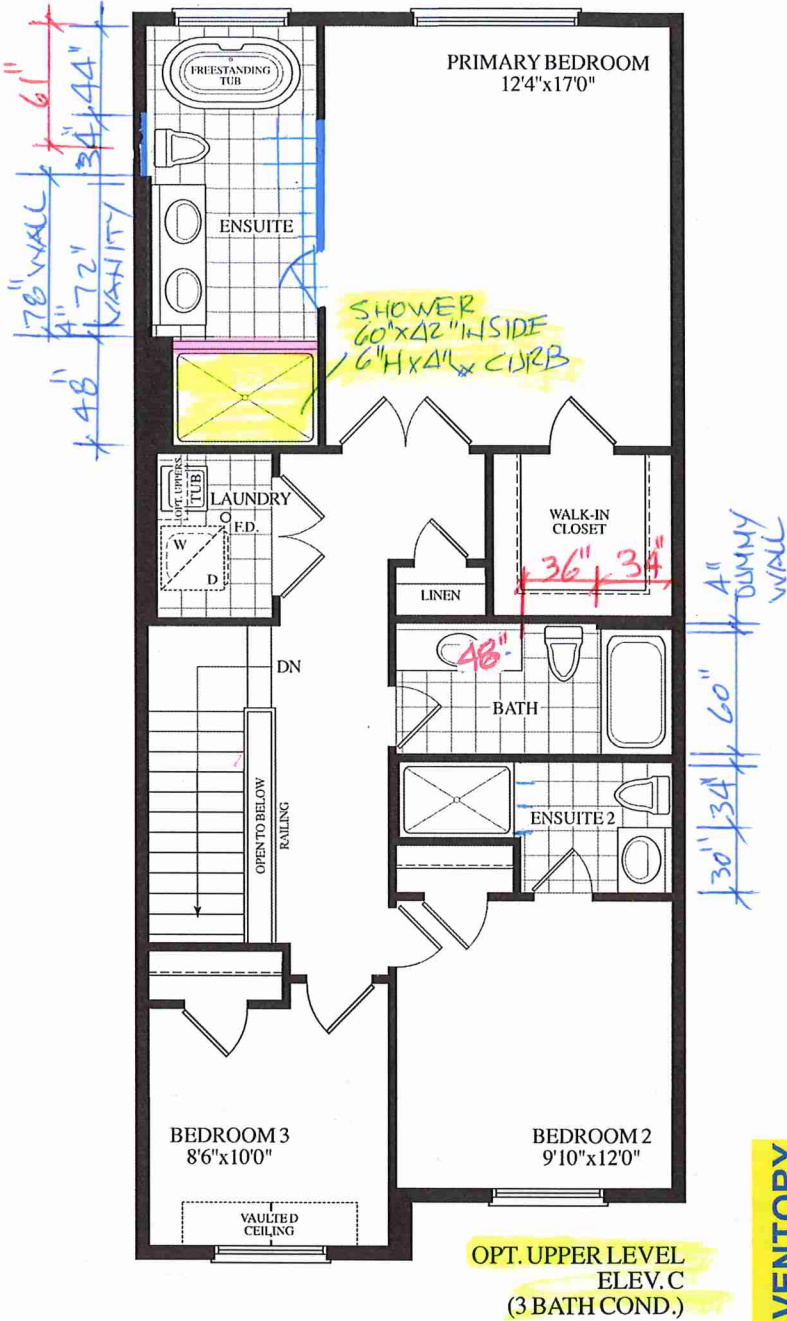

OPT. UPPER LEVEL
ELEV. C
(3 BATH COND.)

INVENTORY

DECK CONDITION
3 BDRM. 3 BATH.

20-17 THE DIANA EL. C

BLK.8 TH.46

1780 SQ.FT.

Materials, specifications and floor plans are subject to change without notice. All renderings are artist's concept. All floor plans are approximate dimensions. Actual usable floor space may vary from the stated floor area. E.&O.E.