




THE BRADLEY

MODEL 825


2183 sq.ft. or 2376 sq.ft.

Site:	Place St. Thomas 5	Purchaser:	Model Home
Plan No.:	50M-348		
Lot:	8 - Phase 5	Purchaser:	
Date:	December 14, 2020		


Schedule "H"

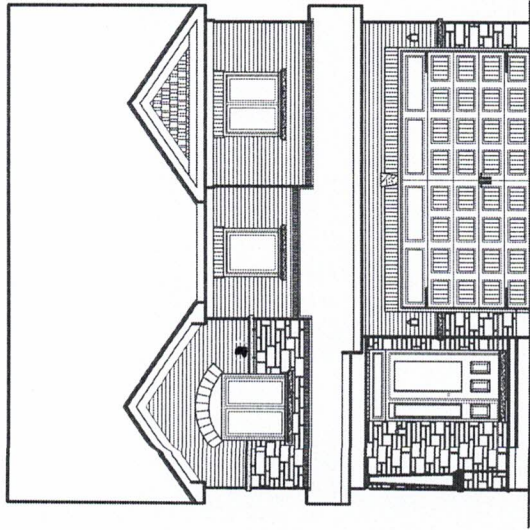

ELEVATION ~~A~~

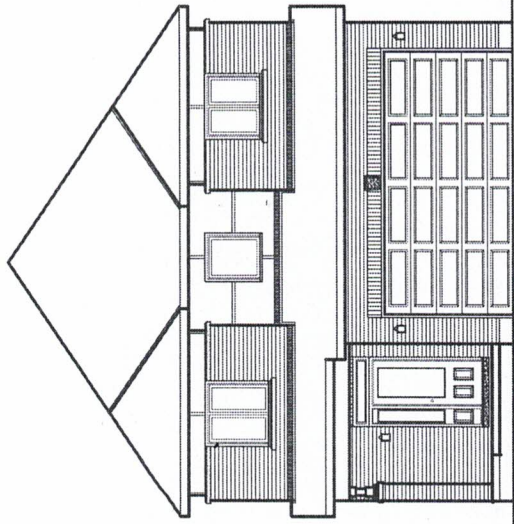

ELEVATION B

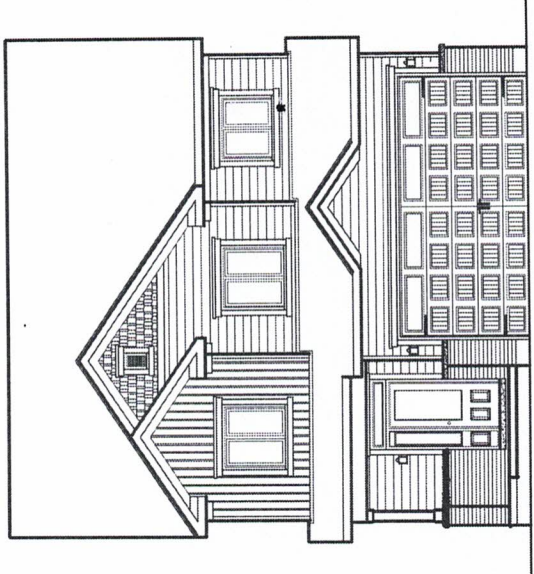


ELEVATION ~~C~~




Valecraft.com

*Rendering is an artist concept only. Not to scale and may vary from finished community. Dimensions, specifications and landscaping are approximate and are subject to change without notice. E & O E 02/20/2019 N


SCHEDULE H

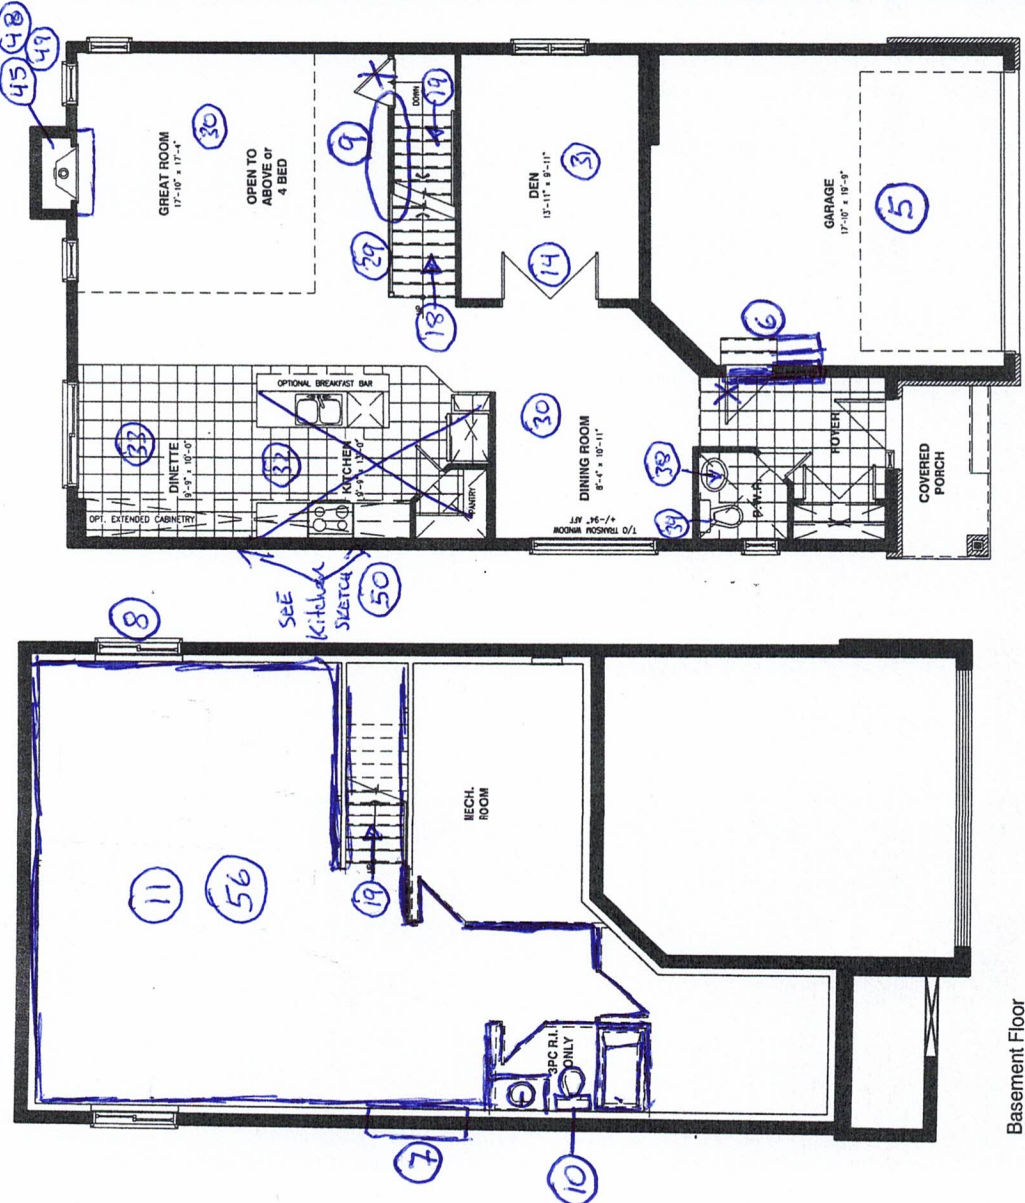


Basement Floor

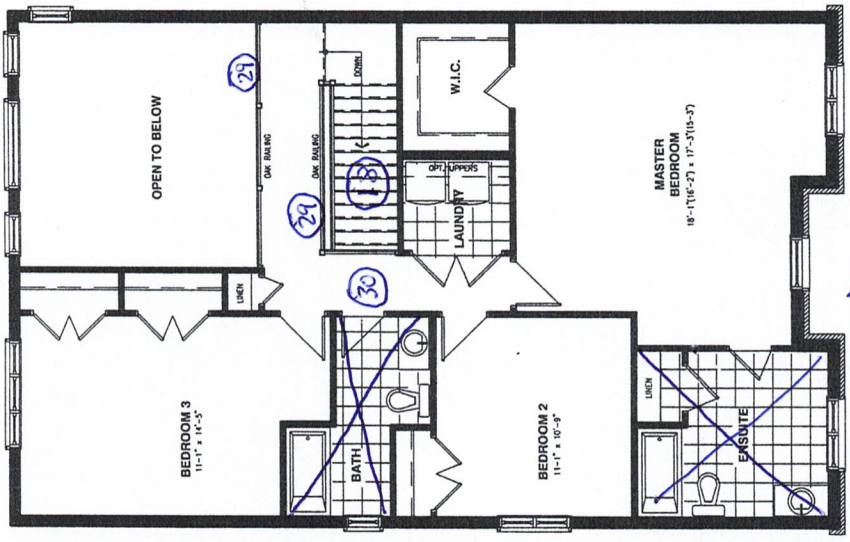


Second Floor - 3 Bed - Elev. A

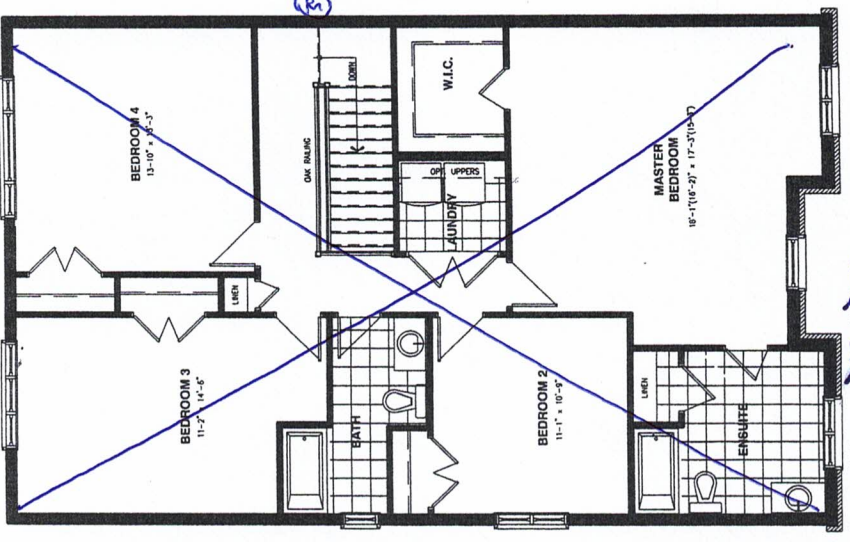


Second Floor - 4 Bed - Elev. A

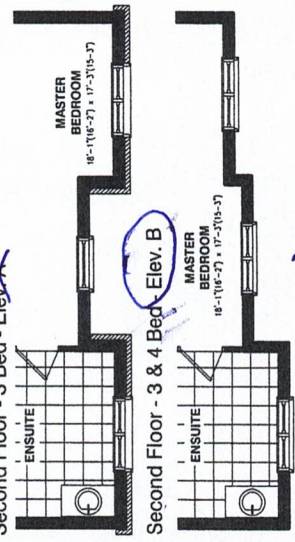

Second Floor - 3 & 4 Bed - Elev. B

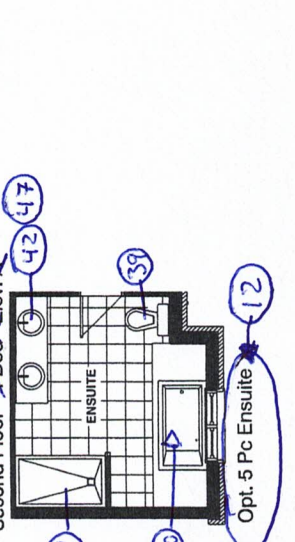

Second Floor - 4 Bed - Elev. C

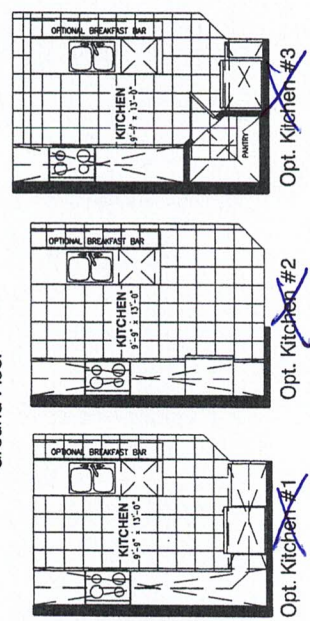

Ground Floor

#50

B:\Private\Designers\Dominique Fortin\ Projects\2020 - RETAIL\VALECRAFT MODEL HOME\B25 BRADLEY (MODEL HOME).cvi






CLIENT: VALECRAFT
ADDR.: PLACE ST-THOMAS PH X,
SL. #: SL106XXXX
Phone: Mobile:
Email :

* These plans are intended for production of cabinets ONLY. Potvin is not liable if they are used for other purposes.
* Construction lines on plans are subjective and are drawn for representation only. Their dimensions are approximate and may vary due to site conditions.
* Appliances in elevations and plans are generic templates and may not reflect actual selections.

PG#
1 of 2
Sheet 1

**potvin**
KITCHENS & CABINETS

PRELIMINARY DRAWINGS
LOT # TO BE DETERMINED, MAY BE REVERSED

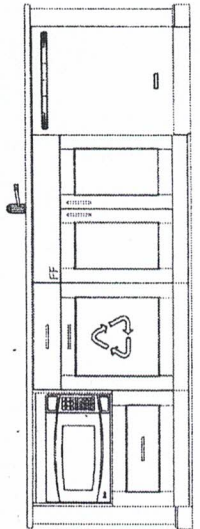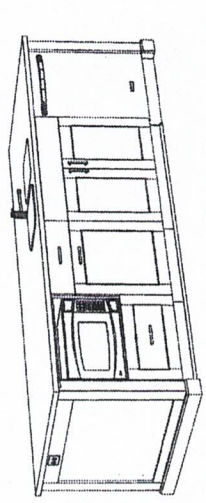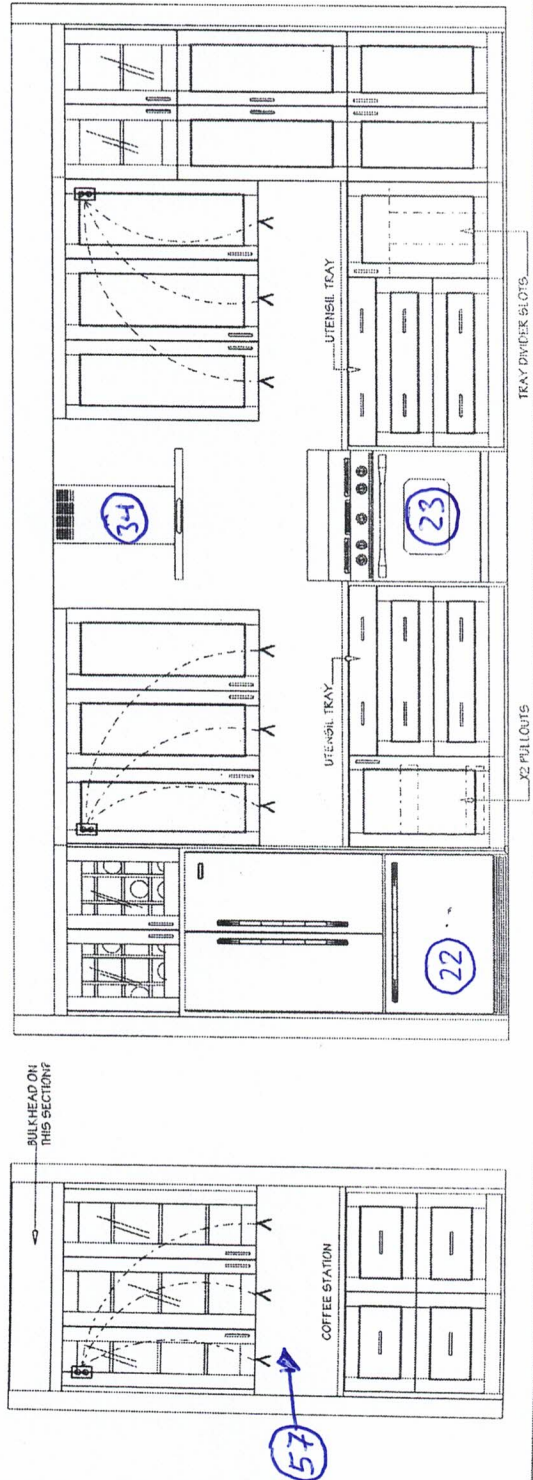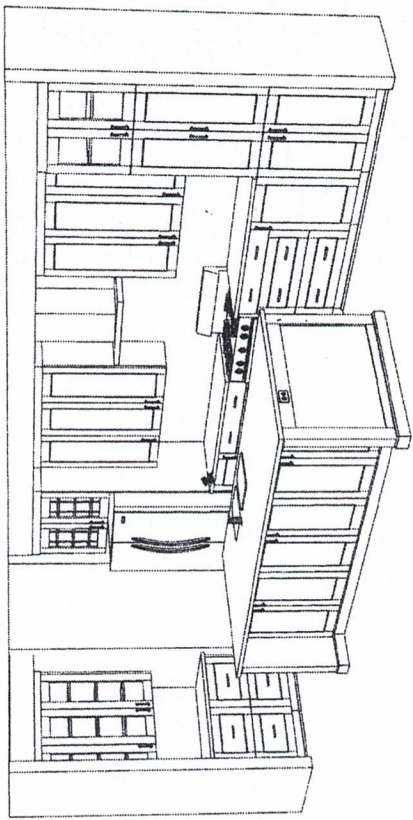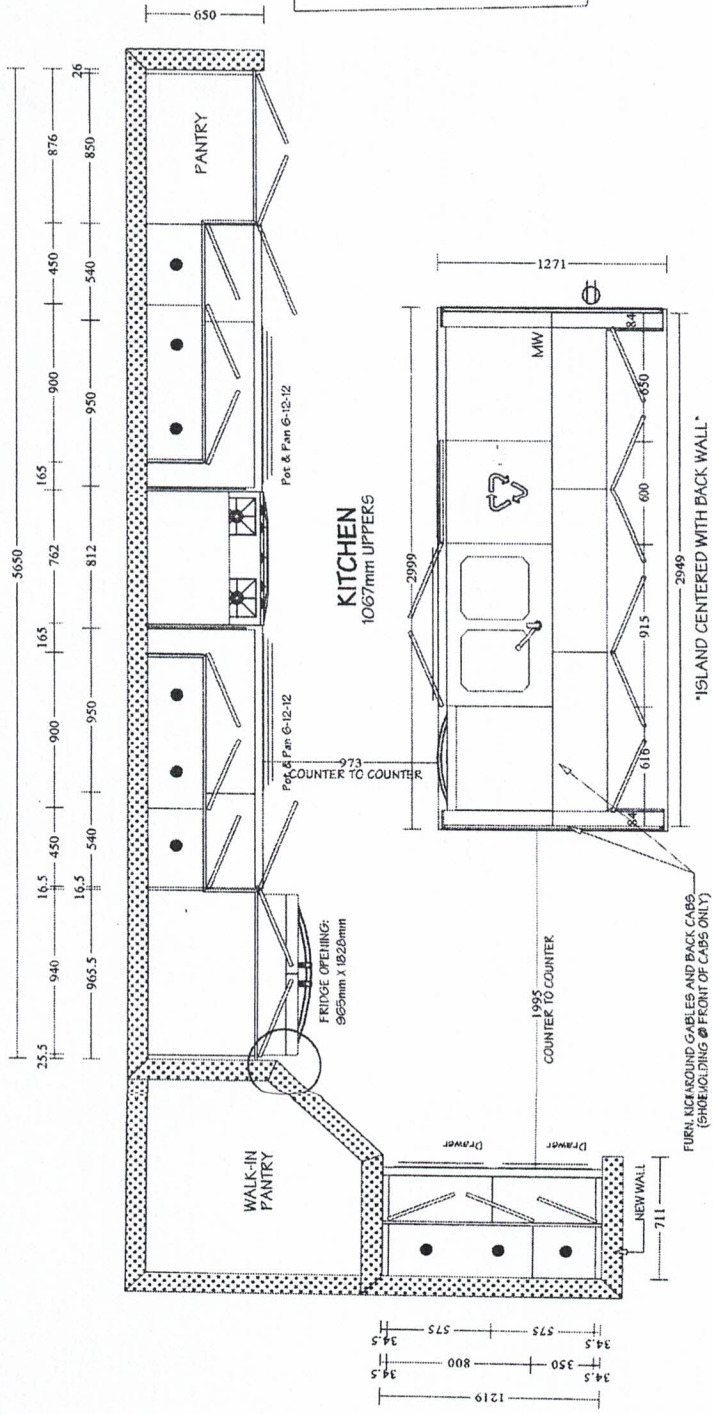



D:\Private\Designers\Dominique Fortin\ Projecte\2020 - RETAIL\VALECRAFT MODEL HOME\025 BRADLEY (MODEL HOME).cvi

CLIENT: VALECRAFT	LOT:PSTX-XX (MODEL)	
ADDR.: PLACE ST-THOMAS PH X.		
SL #: SL106XXXX		
Phone:	OUT BY: DOMINIQUE FORTIN	DATE: 07/10/20
Mobile:	PSTX-XX	
Email :		

• These plans are intended for production of cabinets ONLY. Potvin is not liable if they are used for other purposes.
• Construction lines on plans are subjective and are drawn for representation only. Their dimensions are approximate and may vary due to site conditions.
• Appliances in elevations and plans are generic templates and may not reflect actual selections.

PG#
2 of 2
Sheet 2



potvin
KITCHENS & CABINETS

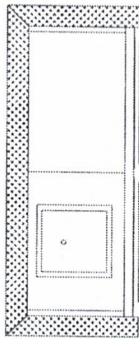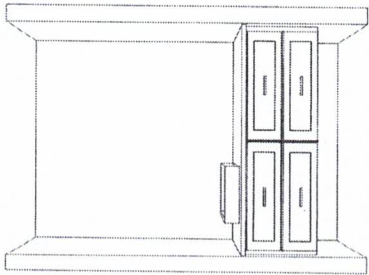

OPT. JACK & JILL


CONFIRM IF PLUMBING WILL WORK *****

#52

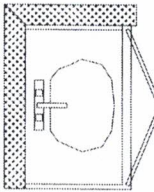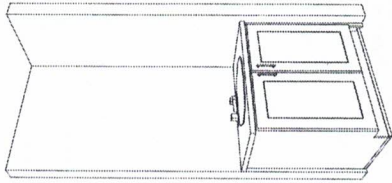


OPT. BASEMENT

#10

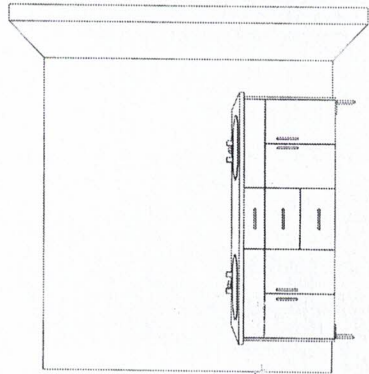




CONFIRM VANITY SIZE ***

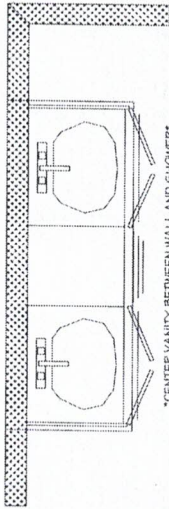

CENTER VANITY BETWEEN WALL AND SHOWER

OPT. 5PC ENSUITE

#51

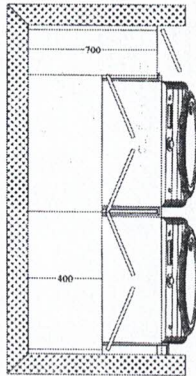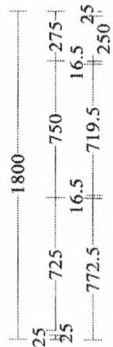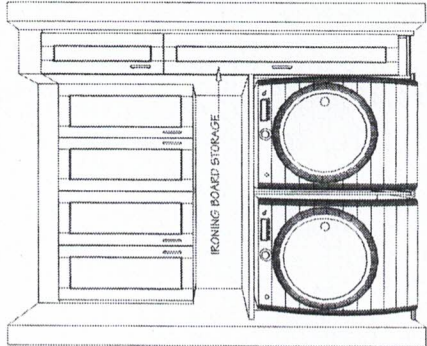

LAUNDRY ROOM

914mm UPPERS
(FILLER TO CEILING)

#53

SITE PLAN

E & OE July 24, 2020

NOTE:
HOUSE REPRESENTATION ON LOTS ARE ARTIST CONCEPT ONLY. FINAL BUILDING LOCATION AND ORIENTATION MAY NOT BE AS SHOWN.

*LOCATION OF SERVICE UTILITIES TO BE DETERMINED

**PLEASE CONFIRM WITH HEAD OFFICE TO ENSURE SPECIFIC HOUSE MODEL FITS ON CHOSEN LOT

Place St. Thomas – Phase 5
Lot: 8 - Phase 5

Model: #825 "B" Std Bradley 3Bed

Purchasers: Model Home

LEGEND:

 SERVICE EASEMENT

 CATCH BASIN

 HYDRO TRANSFORMER



*LOCATION OF SERVICE UTILITIES TO BE DETERMINED

**PLEASE CONFIRM WITH HEAD OFFICE TO ENSURE SPECIFIC HOUSE MODEL FITS ON CHOSEN LOT

SALES LEGEND:

 ***MODEL HOME***

 ***SOLD***

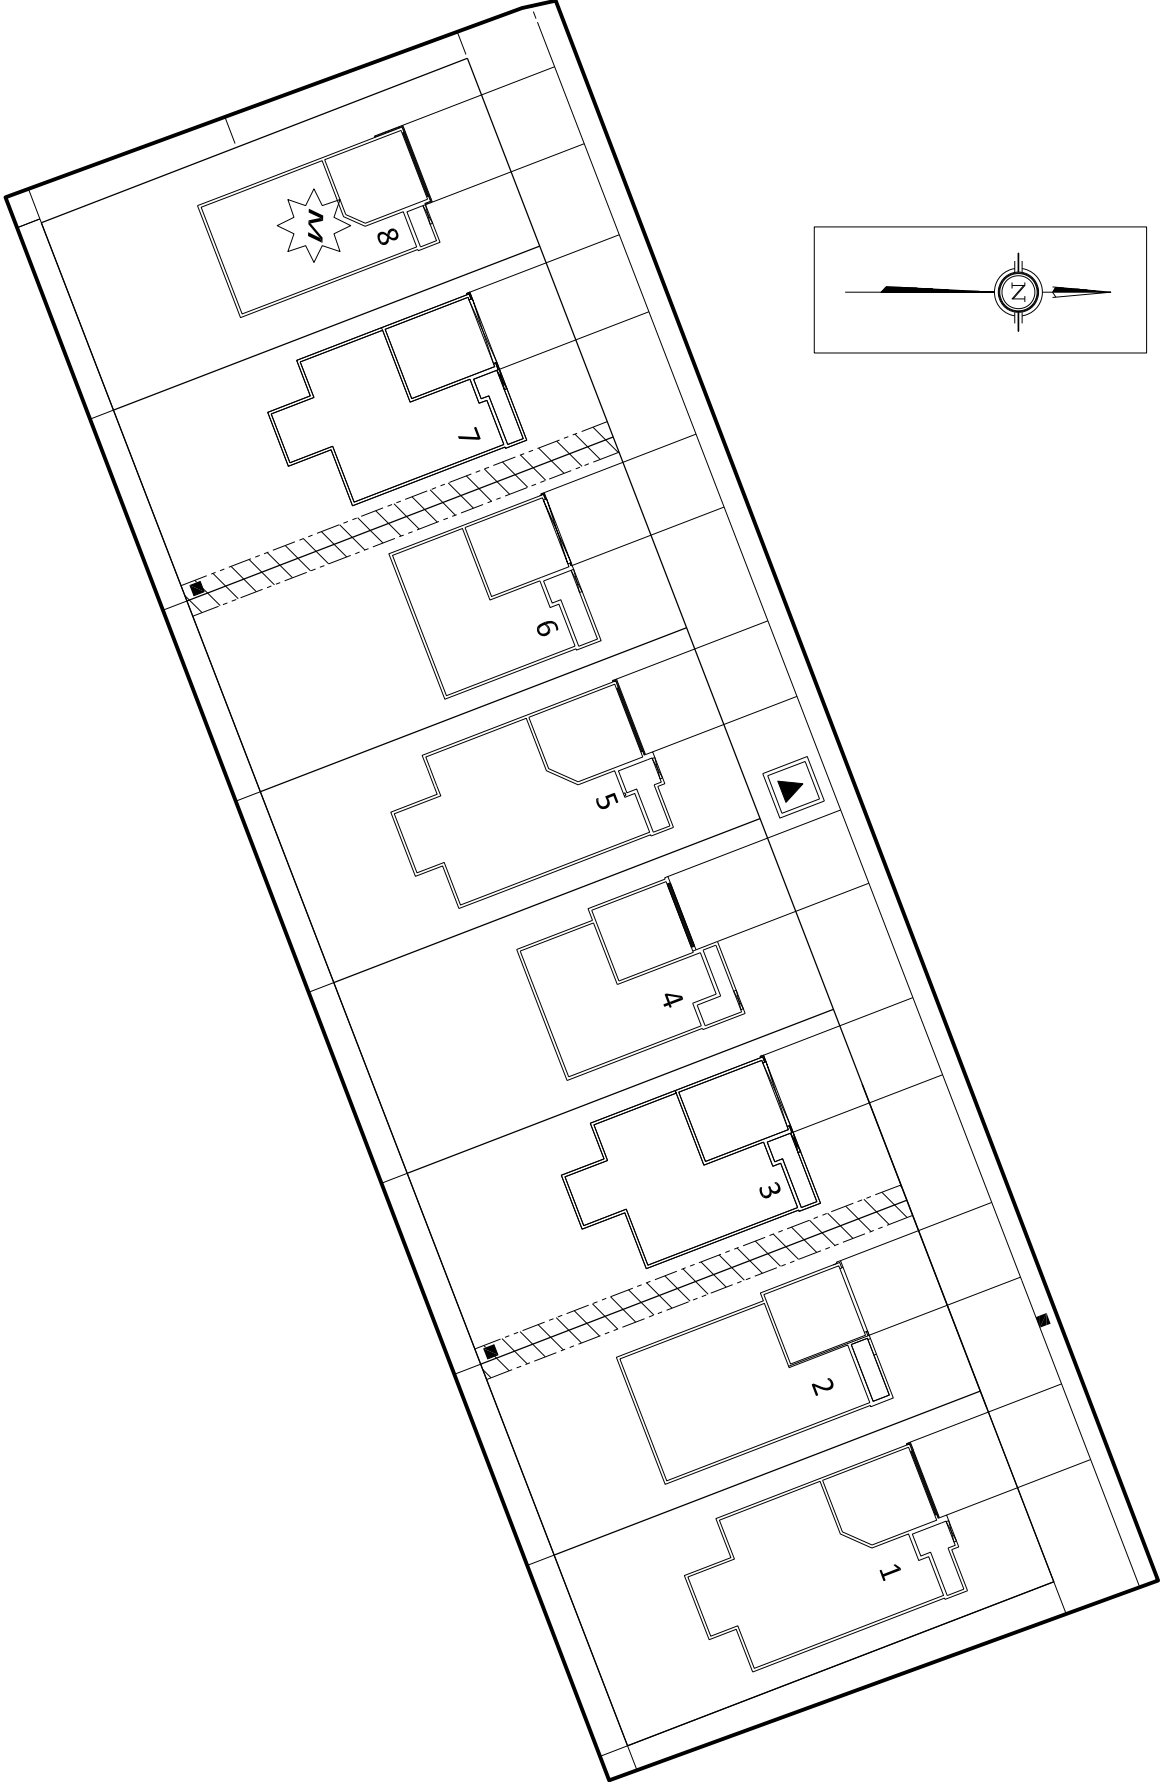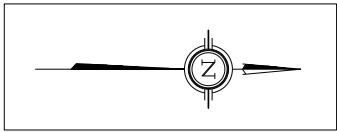

SCHEDULE

” ”
D ”



Valecraft
Homes (2019) Limited

