
WASAGA - PHASE 2

	Lot 83 - WASAGA PHASE 2 Model & Elevation: 50-03 MAYFLOWER ELEVATION A WITH OPT LOFT Purchasers Names: FERNANDO AND EFROSYNI CORSETTI		The Village of Trillium Forest
Item #		DATE	NOTE
	3 STAINLESS STEEL APPLIANCES WITH WHITE WASHER AND DRYER		INCL. IN OFFER
1/	SHIFT DOOR AT MASTER BEDROOM CLOSET (SEE SKETCH) INCREASE CLOSET AT MASTER BEDROOM INCLUDING WIRE SHELVING	2-Mar-17	STRUCTURALS
2/	ADD OPTIONAL CATHEDRAL CEILING WITH CURVED FEATURE WINDOW ABOVE BRICK SHOLIDER COURSE IN LIEU OF 2 STANDARD WINDOWS AT LOFT LEVEL (SEE SKETCH)	2-Mar-17	STRUCTURALS
3/	DELETE LINEN CLOSET	2-Mar-17	STRUCTURALS
4/	INSTALL CAPPED HALF WALL WITH 2 ROUND COLUMNS IN LIEU OF FULL WALL BETWEEN LIBRARY AND FOYER. DELETE DOOR AND NIB WALLS IN LIBRARY (SEE SKETCH)	2-Mar-17	STRUCTURALS
	RECESS CLOSET AT GARAGE FURTHER IONTO GARAGE (SEE SKETCH)	2-Mar-17	STRUCTURALS
6/	ELECTRICAL - ADD 15 AMP SEPARATE CIRCUIT FOR OTR MICROWAVE	2-Mar-17	STRUCTURALS
7/	CABINETS - ADD EXTENDED UPPERS IN KITCHEN 39-1/2"	2-Mar-17	STRUCTURALS
8/	CABINETS - ALLOW FOR OTR MICROWAVE OVER RANGE	2-Mar-17	STRUCTURALS
9/	PAINTING - STAIN INTERIOR OAK STAIRS FROM BASEMENT TO LOFT	2-Mar-17	STRUCTURALS
10/	LATE CHANGE - CURVED RAILING AT LOFT OVER LOOKING FAMILY ROOM **APPROVED AS PER DD	11-May-17	LATE CHANGE
11/	RESELECTION - STAIN STAIRS AS PER NEW SELECTION ON COLOUR CHART ***COLOUR TO BE DETERMINED	11-May-17	LATE CHANGE
12/	HOMEONWER ACCEPTS FAMILY ROOM FEATURE WINDOW AND WINDOWS ON EITHER SIDE OF FIREPLACE AS BUILT	11-May-17	ACKNOWLEDGEMENT

Ground Floor Elev. 'B' Library / Opt. Bedroom 2 11'8" x 11'8" Master Bedroom 12'1" x 17'5" Family Room 14'2" x 21'0" Open To Above Lote Cray Open Costrocinal Coaling Wood Deck 10'0" x 7'0" Family Room
14'0" x 21'0"

19 Open To Above (Lott Cray)

Opt. Cathedral Caling Ski And Bike Area Garage 18'8" x 23'3" Wood Deck 10"0" x 7'0"

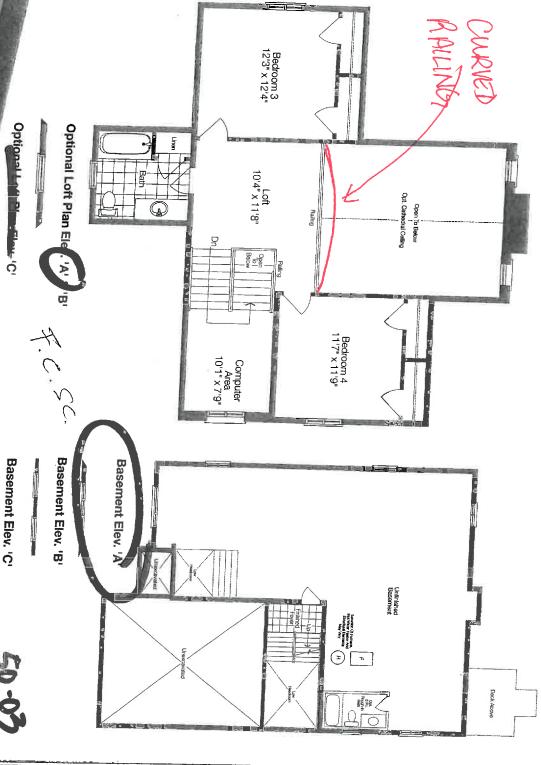

Ground Floor Elev. 'C'

Basement Elev. 'C'

Prices and specifications are subject to change without notice. E.&O.E. Tile patterns may vary. Window size and location may vary. Approx. location of furnace and water tank, actual usable floor space may vary from the stated floor area. All stated dimensions are approximate. 'A' Elevation may include portions of the house constructed in vinyl siding or other materials. All renderings are artist's concept.

ANCOR HOMES COLOUR CH T

	STAIRS, R	STAIRS, RAILING & PICKETS & STAIR STAIN	& STAIR STAIN		
Stair Stain / Species:	STAIN C	STAIN OAK STAIRS TO MATCH STAIN 6001	CH STAIN GROWING		Berross
White Paint Region Main to Loft Railing Details:			NA		
Main to Foyer/Laundry Railing Details:			SPANIONED		
Casing/Baseboards	R	TRUM	STANIDABD		
Interior Doors			STANDARD		
Interior Door Hardware			STANDARD		
Exterior Door Hardware		TAIAT	STANDARD	1 Hilman	
Kitchen/Breakfast	WARM GREY	GREY	Master Beds	WARM GREY	
Living Room	NA		Bedroom 2	WARM GREY	
Dining Room	WARM GREY	GREY	Bedroom 3	WARM GREY	
Family/Great room	WARM GREY	GREY	Bedroom 4	WARM GREY	
Library Main / Hatt	WARM GREY	GREY	Master Ens.	WARM GREY	
Laundry	WARM GREY	GARY	Main	WARM GREY	
IOFT /Computer	WARM GREY	GREY	Racement Force	WARM GREY	
	PLUMBING	PLUMBING- UPGRADES TO BE DETAILED ON PES	DETAILED ON PES	WARIN GREY	
	FIXTURES	FAUCETS		NOTES	
Kitchen	STANDARD	STANDARD			
	STANDARD	STANIDARD			
	STANDARD	STANDARD			
	STANDARD	STANDARD			
BASEMENT	NA				
Other	APPLIANCE REC	ZANCOR APPLIANCE REQUIREMENTS-HIPGRADES TO BE DETAILED ON DES	ADES TO BE DETAIL	ED ON BEC	
Appliance Package received in 'Schedule E'	edule E'	YES / NO Package Name:	Name:		4
	UPG (SEE PES)		DECLINED	NOTES	
WATERLINE to Fridge	NA	AND			
Hood Fan Venting SIZE	6" STANDARD	IDARD			
ELECTRICAL for Built-in Oven	NA				
ELECTRICAL for Built-in Micro / OTR	-1) dr	UPG-RADE.			
ELECTRICAL for Bar Fridge	NA S				
	DISCLAIMER	MER		INITIALS	ALS
Colours of all materials are as close as possible to Builders selection but not necessarily identical due to dye lot varian manufacturing/manufacturers. Due to construction progress some items may have been pre-selected or installed. In	ilders selection but not progress some items n	t necessarily identical due to	dye lot variances in	N N	2
selection must be accepted by the purchaser	Ċ.			9 _))
Purchaser has checked and acknowledged accuracy of colour and selections before signing.	of colour and selection	s before signing.		4 4) ;
SITE: WASAGA 50-3-A	50-3-A MAYFLOWER	LOT: 83			;
PURCHASER(S):	OPTIONAL LOFT	LLOFT	7 8 COM		Mars/2-8
	EFROSYNI CORSETTI	ORSETTI	Purchas	Purchaser Signature	Daye
HOME #/CELL#	905 426 3880'	3880'	20 C	L	
DÉCOR NOTES			Purcha	haser Signature	Date
FOR TRADE USE		,,,,,,		X.	
Any upgrades in the colour chart must be accompanied with a PES.	be accompanied	N A N C O N	Décor Con	purfant Signature	Date
It is the responsibility of all Trades to inform the builder	form the builder	STREET			*
charts PRIOR to installation.	llation.	1) ima	71/4 N
*** PAGE 2	2 OF 2 ***	*	Vendo	Vendor Signature	Date