

SITE NAME: MINNISALE HOMES CORP  
 BUILDER: GREENPARK HOMES

TYPE: MILLWOOD 2

GFA: 2654

 DATE: Aug-18  
 LOW 79581

 WINTER NATURAL AIR CHANGE RATE 0.354  
 SUMMER NATURAL AIR CHANGE RATE 0.115

 HEAT LOSS AT °F. 74  
 HEAT GAIN AT °F. 11

 CSA-F280-12  
 SB-12 PACKAGE A1

| ROOM USE                      | EXP. WALL | CLG. HT. | MBR  | ENS  | BED-2 | BED-3 | BED-4 | BATH | ENS-2 |
|-------------------------------|-----------|----------|------|------|-------|-------|-------|------|-------|
| 34                            | 10        | 9        | 29   | 9    | 10    | 9     | 10    | 9    | 15    |
| FACTORS                       |           |          |      |      |       |       |       |      |       |
| GRS.WALL AREA                 | LOSS      | GAIN     | 340  | 281  | 234   | 330   | 99    | 90   | 135   |
| GLAZING                       | LOSS      | GAIN     |      |      |       |       |       |      |       |
| NORTH                         | 20.8      | 15.5     | 0    | 0    | 0     | 0     | 0     | 0    | 0     |
| EAST                          | 20.8      | 41.0     | 0    | 0    | 0     | 0     | 0     | 0    | 0     |
| SOUTH                         | 20.8      | 24.4     | 0    | 0    | 0     | 0     | 12    | 249  | 293   |
| WEST                          | 20.8      | 41.0     | 32   | 665  | 1314  | 12    | 249   | 493  | 0     |
| SKYL.T.                       | 36.4      | 106.7    | 0    | 0    | 0     | 0     | 0     | 0    | 0     |
| DOORS                         | 24.7      | 3.7      | 0    | 0    | 0     | 0     | 0     | 0    | 0     |
| NET EXPOSED WALL              | 4.4       | 0.6      | 308  | 1342 | 199   | 249   | 1085  | 161  | 135   |
| NET EXPOSED BMT WALL ABOVE GR | 3.5       | 0.5      | 0    | 0    | 0     | 0     | 0     | 0    | 0     |
| EXPOSED CLG                   | 1.3       | 0.6      | 280  | 351  | 156   | 204   | 256   | 114  | 168   |
| NO ATTIC EXPOSED CLG          | 2.7       | 1.2      | 0    | 0    | 0     | 0     | 0     | 0    | 0     |
| EXPOSED FLOOR                 | 2.5       | 0.4      | 0    | 0    | 0     | 0     | 0     | 0    | 0     |
| BASEMENT/CRAWL HEAT LOSS      |           |          | 0    | 0    | 0     | 0     | 0     | 0    | 0     |
| SLAB ON GRADE HEAT LOSS       |           |          | 0    | 0    | 0     | 0     | 0     | 0    | 0     |
| SUBTOTAL HT LOSS              |           |          | 2358 | 1590 | 1965  | 2282  | 904   | 744  | 1217  |
| SUB TOTAL HT GAIN             |           |          |      | 1669 |       | 1112  |       | 472  |       |
| LEVEL FACTOR / MULTIPLIER     | 0.20      | 0.28     |      | 0.20 | 0.28  |       | 0.20  | 0.28 |       |
| AIR CHANGE HEAT LOSS          |           |          | 653  |      | 440   |       |       |      |       |
| AIR CHANGE HEAT GAIN          |           |          |      | 133  |       | 61    |       |      |       |
| DUCT LOSS                     |           |          | 0    |      | 0     |       |       |      |       |
| DUCT GAIN                     |           |          | 0    |      | 0     |       |       |      |       |
| HEAT GAIN PEOPLE              | 240       | 2        | 480  | 0    | 0     |       |       |      |       |
| HEAT GAIN APPLIANCES/LIGHTS   |           |          | 627  |      | 627   |       |       |      |       |
| TOTAL HT LOSS BTU/H           |           |          | 3010 | 2030 | 2761  | 2914  | 1154  | 950  | 1709  |
| TOTAL HT GAIN x 1.3 BTU/H     |           |          | 3781 | 1892 | 2957  | 3347  | 1789  | 1301 | 375   |

| ROOM USE                      | EXP. WALL | CLG. HT. | LIV  | KT/DM | LAUN | WIR  | FOY  | MUD  | WOD  | BAS   |
|-------------------------------|-----------|----------|------|-------|------|------|------|------|------|-------|
| 38                            | 10        | 9        | 78   | 10    | 8    | 12   | 27   | 17   | 50   | 154   |
| FACTORS                       |           |          |      |       |      |      |      |      |      |       |
| GRS.WALL AREA                 | LOSS      | GAIN     | 380  | 780   | 72   | 132  | 270  | 187  | 450  | 1224  |
| GLAZING                       | LOSS      | GAIN     |      |       |      |      |      |      |      |       |
| NORTH                         | 20.8      | 15.5     | 0    | 0     | 0    | 0    | 0    | 0    | 0    | 0     |
| EAST                          | 20.8      | 41.0     | 0    | 0     | 0    | 0    | 0    | 0    | 0    | 0     |
| SOUTH                         | 20.8      | 24.4     | 40   | 831   | 976  | 0    | 0    | 0    | 0    | 0     |
| WEST                          | 20.8      | 41.0     | 0    | 0     | 0    | 0    | 0    | 0    | 0    | 0     |
| SKYL.T.                       | 36.4      | 106.7    | 0    | 0     | 0    | 0    | 0    | 0    | 0    | 0     |
| DOORS                         | 24.7      | 3.7      | 0    | 0     | 0    | 0    | 0    | 0    | 0    | 0     |
| NET EXPOSED WALL              | 4.4       | 0.6      | 340  | 1481  | 220  | 688  | 2995 | 444  | 0    | 0     |
| NET EXPOSED BMT WALL ABOVE GR | 3.5       | 0.5      | 0    | 0     | 0    | 0    | 0    | 0    | 0    | 0     |
| EXPOSED CLG                   | 1.3       | 0.6      | 0    | 0     | 0    | 0    | 0    | 0    | 0    | 0     |
| NO ATTIC EXPOSED CLG          | 2.7       | 1.2      | 0    | 0     | 0    | 0    | 0    | 0    | 0    | 0     |
| EXPOSED FLOOR                 | 2.5       | 0.4      | 0    | 0     | 0    | 0    | 0    | 0    | 0    | 0     |
| BASEMENT/CRAWL HEAT LOSS      |           |          | 0    | 0     | 0    | 0    | 0    | 0    | 0    | 0     |
| SLAB ON GRADE HEAT LOSS       |           |          | 0    | 0     | 0    | 0    | 0    | 0    | 0    | 0     |
| SUBTOTAL HT LOSS              |           |          | 2312 | 1195  | 5083 | 3516 |      |      |      |       |
| SUB TOTAL HT GAIN             |           |          |      | 0.30  | 0.44 |      |      |      |      |       |
| LEVEL FACTOR / MULTIPLIER     | 0.30      | 0.44     |      | 0.30  | 0.44 |      |      |      |      |       |
| AIR CHANGE HEAT LOSS          |           |          | 1023 |       | 2240 |      |      |      |      |       |
| AIR CHANGE HEAT GAIN          |           |          |      | 95    |      | 279  |      |      |      |       |
| DUCT LOSS                     |           |          | 0    |       | 0    |      |      |      |      |       |
| DUCT GAIN                     |           |          | 0    |       | 0    |      |      |      |      |       |
| HEAT GAIN PEOPLE              | 240       | 0        | 0    | 0     | 0    |      |      |      |      |       |
| HEAT GAIN APPLIANCES/LIGHTS   |           |          | 627  |       | 627  |      |      |      |      |       |
| TOTAL HT LOSS BTU/H           |           |          | 3336 | 7332  | 1344 | 830  | 3010 | 1761 | 1175 | 14791 |
| TOTAL HT GAIN x 1.3 BTU/H     |           |          | 2483 | 6748  | 1776 | 120  | 754  | 1059 | 572  | 540   |

TOTAL HEAT GAIN BTU/H: 28751

TONS: 2.40

LOSS DUE TO VENTILATION LOAD BTU/H: 1593

STRUCTURAL HEAT LOSS: 48196

TOTAL COMBINED HEAT LOSS BTU/H: 49088

SITE NAME: MINNISSALE HOMES CORP  
BUILDER: GREENPARK HOMES

TYPE: MILLWOOD 2

DATE: Aug-18

GFA: 2654 LO# 79581

HEATING CFM 1131 COOLING CFM 1131  
TOTAL HEAT LOSS 48,106 TOTAL HEAT GAIN 28,515  
AIR FLOW RATE CFM 23.51 AIR FLOW RATE CFM 39.66

furnace pressure 0.6  
furnace filter 0.05  
a/c coil pressure 0.2  
available pressure for s/a & r/a 0.35

#GOODMAN  
GMEC960603BNA 60  
FAN SPEED LOW  
MEDLOW  
MEDIUM  
MEDIUM HIGH  
HIGH 1131

AFUE = 96 %  
INPUT (BTU/H) = 60,000  
OUTPUT (BTU/H) = 57,600

DESIGN CFM = 1131  
CFM @ 8" E.S.P.

TEMPERATURE RISE 47 °F

| RUN COUNT | 4th | 3rd | 2nd | 1st | Bas |
|-----------|-----|-----|-----|-----|-----|
| S/A       | 0   | 0   | 11  | 7   | 4   |
| R/A       | 0   | 0   | 4   | 2   | 1   |

All S/A diffusers 4"x10" unless noted otherwise on layout.  
All S/A runs 5"Ø unless noted otherwise on layout.

plenium pressure s/a 0.18  
max s/a dif. press. loss 0.02  
min adjusted pressure s/a 0.16  
r/a pressure 0.17  
r/a grille press. Loss 0.02  
adjusted pressure r/a 0.15

| RUN #                     | 1    | 2    | 4     | 5     | 6     | 7    | 8     | 9     | 10   | 11    | 12   | 14    | 15    | 16    | 17   | 18   | 19   | 20   | 21   | 22   | 23   | 24   |
|---------------------------|------|------|-------|-------|-------|------|-------|-------|------|-------|------|-------|-------|-------|------|------|------|------|------|------|------|------|
| ROOM NAME                 | MBR  | ENS  | BED-2 | BED-3 | BED-4 | BATH | BED-2 | BED-3 | MBR  | ENS-2 | LIV  | KT/FM | KT/FM | KT/FM | LAUN | WIR  | FOY  | MUD  | BAS  | BAS  | BAS  | BAS  |
| RM LOSS MBH               | 1.51 | 2.03 | 1.38  | 1.46  | 1.15  | 0.95 | 1.38  | 1.46  | 1.51 | 1.71  | 3.34 | 2.44  | 2.44  | 2.44  | 1.34 | 0.83 | 3.01 | 1.76 | 3.99 | 3.99 | 3.99 | 3.99 |
| CFM PER RUN HEAT          | 35   | 48   | 32    | 34    | 27    | 22   | 32    | 34    | 35   | 40    | 78   | 57    | 57    | 57    | 32   | 20   | 71   | 41   | 94   | 94   | 94   | 94   |
| RM GAIN MBH               | 1.89 | 1.89 | 1.48  | 1.67  | 1.79  | 1.30 | 1.48  | 1.67  | 1.89 | 0.37  | 2.49 | 1.92  | 1.92  | 1.92  | 1.78 | 0.12 | 0.75 | 1.07 | 0.28 | 0.28 | 0.28 | 0.28 |
| CFM PER RUN COOLING       | 75   | 75   | 59    | 66    | 71    | 52   | 59    | 66    | 75   | 15    | 99   | 76    | 76    | 76    | 70   | 5    | 30   | 42   | 11   | 11   | 11   | 11   |
| ADJUSTED PRESSURE         | 0.17 | 0.17 | 0.17  | 0.17  | 0.17  | 0.17 | 0.17  | 0.17  | 0.17 | 0.17  | 0.16 | 0.17  | 0.17  | 0.17  | 0.17 | 0.17 | 0.17 | 0.17 | 0.16 | 0.16 | 0.16 | 0.16 |
| ACTUAL DUCT LGH           | 55   | 54   | 46    | 33    | 15    | 37   | 47    | 47    | 45   | 38    | 15   | 48    | 44    | 49    | 39   | 39   | 29   | 32   | 39   | 39   | 20   | 10   |
| EQUIVALENT LENGTH         | 190  | 160  | 140   | 140   | 160   | 110  | 140   | 160   | 150  | 140   | 120  | 130   | 110   | 140   | 130  | 140  | 90   | 160  | 150  | 160  | 110  | 150  |
| TOTAL EFFECTIVE LENGTH    | 245  | 214  | 186   | 173   | 175   | 147  | 187   | 207   | 195  | 178   | 135  | 178   | 154   | 189   | 169  | 179  | 119  | 192  | 189  | 199  | 130  | 160  |
| ADJUSTED PRESSURE         | 0.07 | 0.08 | 0.09  | 0.1   | 0.1   | 0.12 | 0.09  | 0.08  | 0.09 | 0.1   | 0.12 | 0.1   | 0.11  | 0.09  | 0.1  | 0.1  | 0.14 | 0.09 | 0.09 | 0.08 | 0.12 | 0.1  |
| ROUND DUCT SIZE           | 6    | 6    | 5     | 5     | 5     | 4    | 5     | 5     | 5    | 4     | 6    | 5     | 5     | 5     | 5    | 4    | 5    | 4    | 6    | 6    | 6    | 6    |
| HEATING VELOCITY (ft/min) | 178  | 245  | 235   | 250   | 198   | 252  | 235   | 250   | 257  | 459   | 398  | 419   | 419   | 419   | 235  | 229  | 521  | 470  | 479  | 479  | 479  | 479  |
| COOLING VELOCITY (ft/min) | 382  | 382  | 433   | 485   | 521   | 597  | 433   | 485   | 551  | 172   | 505  | 558   | 558   | 558   | 514  | 57   | 220  | 482  | 56   | 56   | 56   | 56   |
| OUTLET GRILL SIZE         | 4X10 | 4X10 | 3X10  | 3X10  | 3X10  | 3X10 | 3X10  | 3X10  | 3X10 | 3X10  | 4X10 | 3X10  | 3X10  | 3X10  | 3X10 | 3X10 | 3X10 | 3X10 | 4X10 | 4X10 | 4X10 | 4X10 |
| TRUNK                     | A    | B    | D     | C     | B     | D    | D     | C     | A    | D     | C    | A     | A     | A     | D    | B    | C    | B    | A    | A    | C    | B    |

| RUN # | ROOM NAME | RM LOSS MBH | CFM PER RUN HEAT | RM GAIN MBH | CFM PER RUN COOLING | ADJUSTED PRESSURE | ACTUAL DUCT LGH | EQUIVALENT LENGTH | TOTAL EFFECTIVE LENGTH | ADJUSTED PRESSURE | ROUND DUCT SIZE | HEATING VELOCITY (ft/min) | COOLING VELOCITY (ft/min) | OUTLET GRILL SIZE | TRUNK |
|-------|-----------|-------------|------------------|-------------|---------------------|-------------------|-----------------|-------------------|------------------------|-------------------|-----------------|---------------------------|---------------------------|-------------------|-------|
| 1     | MBR       | 1.51        | 35               | 1.89        | 75                  | 0.17              | 55              | 190               | 245                    | 0.07              | 6               | 178                       | 382                       | 4X10              | A     |
| 2     | ENS       | 2.03        | 48               | 1.89        | 75                  | 0.17              | 54              | 160               | 214                    | 0.08              | 6               | 245                       | 382                       | 4X10              | B     |
| 4     | BED-2     | 1.38        | 32               | 1.48        | 59                  | 0.17              | 46              | 140               | 186                    | 0.09              | 5               | 235                       | 433                       | 3X10              | D     |
| 5     | BED-3     | 1.46        | 34               | 1.67        | 66                  | 0.17              | 33              | 140               | 173                    | 0.1               | 5               | 250                       | 485                       | 3X10              | C     |
| 6     | BED-4     | 1.15        | 27               | 1.79        | 71                  | 0.17              | 15              | 160               | 175                    | 0.1               | 5               | 198                       | 521                       | 3X10              | B     |
| 7     | BATH      | 0.95        | 22               | 1.30        | 52                  | 0.17              | 37              | 110               | 147                    | 0.12              | 4               | 252                       | 597                       | 3X10              | D     |
| 8     | BED-2     | 1.38        | 32               | 1.48        | 59                  | 0.17              | 47              | 140               | 187                    | 0.09              | 5               | 235                       | 433                       | 3X10              | D     |
| 9     | BED-3     | 1.46        | 34               | 1.67        | 66                  | 0.17              | 47              | 160               | 207                    | 0.08              | 5               | 250                       | 485                       | 3X10              | C     |
| 10    | MBR       | 1.51        | 35               | 1.89        | 75                  | 0.17              | 45              | 150               | 195                    | 0.09              | 5               | 257                       | 551                       | 3X10              | A     |
| 11    | ENS-2     | 1.71        | 40               | 0.37        | 15                  | 0.17              | 38              | 140               | 178                    | 0.1               | 4               | 459                       | 172                       | 3X10              | D     |
| 12    | LIV       | 3.34        | 78               | 2.49        | 99                  | 0.16              | 15              | 120               | 135                    | 0.12              | 6               | 398                       | 505                       | 4X10              | C     |
| 14    | KT/FM     | 2.44        | 57               | 1.92        | 76                  | 0.17              | 48              | 130               | 178                    | 0.1               | 5               | 419                       | 558                       | 3X10              | A     |
| 15    | KT/FM     | 2.44        | 57               | 1.92        | 76                  | 0.17              | 44              | 110               | 154                    | 0.11              | 5               | 419                       | 558                       | 3X10              | A     |
| 16    | KT/FM     | 2.44        | 57               | 1.92        | 76                  | 0.17              | 49              | 140               | 189                    | 0.09              | 5               | 419                       | 558                       | 3X10              | A     |
| 17    | LAUN      | 1.34        | 32               | 1.78        | 70                  | 0.17              | 39              | 130               | 169                    | 0.1               | 5               | 235                       | 514                       | 3X10              | D     |
| 18    | WIR       | 0.83        | 20               | 0.12        | 5                   | 0.17              | 39              | 140               | 179                    | 0.1               | 4               | 229                       | 57                        | 3X10              | B     |
| 19    | FOY       | 3.01        | 71               | 0.75        | 30                  | 0.17              | 29              | 90                | 119                    | 0.14              | 5               | 521                       | 220                       | 3X10              | C     |
| 20    | MUD       | 1.76        | 41               | 1.07        | 42                  | 0.17              | 32              | 160               | 192                    | 0.09              | 4               | 470                       | 482                       | 3X10              | B     |
| 21    | BAS       | 3.99        | 94               | 0.28        | 11                  | 0.16              | 39              | 150               | 189                    | 0.09              | 6               | 479                       | 56                        | 4X10              | A     |
| 22    | BAS       | 3.99        | 94               | 0.28        | 11                  | 0.16              | 39              | 160               | 199                    | 0.08              | 6               | 479                       | 56                        | 4X10              | A     |
| 23    | BAS       | 3.99        | 94               | 0.28        | 11                  | 0.16              | 20              | 110               | 130                    | 0.12              | 6               | 479                       | 56                        | 4X10              | C     |
| 24    | BAS       | 3.99        | 94               | 0.28        | 11                  | 0.16              | 10              | 150               | 160                    | 0.1               | 6               | 479                       | 56                        | 4X10              | B     |

CITY OF BRAMPTON  
BUILDING DIVISION  
REVIEWED  
NOV 28 2018  
HVAC BY  
MONICA CRISAN

| SUPPLY AIR TRUNK SIZE |       |        |       |      |   |   |          |  |         |        |       |      |   |   | RETURN AIR TRUNK SIZE |      |         |        |       |      |    |     |          |      |      |      |    |   |   |     |
|-----------------------|-------|--------|-------|------|---|---|----------|--|---------|--------|-------|------|---|---|-----------------------|------|---------|--------|-------|------|----|-----|----------|------|------|------|----|---|---|-----|
|                       | TRUNK | STATIC | ROUND | RECT |   |   | VELOCITY |  | TRUNK   | STATIC | ROUND | RECT |   |   | VELOCITY              |      | TRUNK   | STATIC | ROUND | RECT |    |     | VELOCITY |      |      |      |    |   |   |     |
|                       | CFM   | PRESS. | DUCT  | DUCT |   |   | (ft/min) |  | CFM     | PRESS. | DUCT  | DUCT |   |   | (ft/min)              |      | CFM     | PRESS. | DUCT  | DUCT |    |     | (ft/min) |      |      |      |    |   |   |     |
| TRUNK A               | 429   | 0.07   | 10.6  | 14   | x | 8 | 552      |  | TRUNK G | 0      | 0.00  | 0    | 0 | x | 8                     | 0    | TRUNK O | 0      | 0.07  | 0    | 0  | x   | 8        | 0    |      |      |    |   |   |     |
| TRUNK B               | 659   | 0.07   | 12.4  | 18   | x | 8 | 659      |  | TRUNK H | 0      | 0.00  | 0    | 0 | x | 8                     | 0    | TRUNK P | 0      | 0.07  | 0    | 0  | x   | 8        | 0    |      |      |    |   |   |     |
| TRUNK C               | 311   | 0.08   | 9.1   | 10   | x | 8 | 560      |  | TRUNK I | 0      | 0.00  | 0    | 0 | x | 8                     | 0    | TRUNK Q | 0      | 0.07  | 0    | 0  | x   | 8        | 0    |      |      |    |   |   |     |
| TRUNK D               | 469   | 0.08   | 10.6  | 14   | x | 8 | 603      |  | TRUNK J | 0      | 0.00  | 0    | 0 | x | 8                     | 0    | TRUNK R | 0      | 0.07  | 0    | 0  | x   | 8        | 0    |      |      |    |   |   |     |
| TRUNK E               | 0     | 0.00   | 0     | 0    | x | 8 | 0        |  | TRUNK K | 0      | 0.00  | 0    | 0 | x | 8                     | 0    | TRUNK S | 0      | 0.07  | 0    | 0  | x   | 8        | 0    |      |      |    |   |   |     |
| TRUNK F               | 0     | 0.00   | 0     | 0    | x | 8 | 0        |  | TRUNK L | 0      | 0.00  | 0    | 0 | x | 8                     | 0    | TRUNK T | 0      | 0.07  | 0    | 0  | x   | 8        | 0    |      |      |    |   |   |     |
|                       |       |        |       |      |   |   |          |  |         |        |       |      |   |   | TRUNK U               | 0    | 0.07    | 0      | 0     | x    | 8  | 0   | TRUNK V  | 0    | 0.07 | 0    | 0  | x | 8 | 0   |
|                       |       |        |       |      |   |   |          |  |         |        |       |      |   |   | TRUNK W               | 0    | 0.07    | 0      | 0     | x    | 8  | 0   | TRUNK X  | 1131 | 0.07 | 15.2 | 30 | x | 8 | 679 |
|                       |       |        |       |      |   |   |          |  |         |        |       |      |   |   | TRUNK Y               | 290  | 0.07    | 9.1    | 10    | x    | 8  | 522 | TRUNK Z  | 0    | 0.07 | 0    | 0  | x | 8 | 0   |
|                       |       |        |       |      |   |   |          |  |         |        |       |      |   |   | DROP                  | 1131 | 0.07    | 15.2   | 24    | x    | 10 | 679 |          |      |      |      |    |   |   |     |

|                    |      |      |      |      |      |      |       |       |       |       |       |       |       |       |      |  |    |
|--------------------|------|------|------|------|------|------|-------|-------|-------|-------|-------|-------|-------|-------|------|--|----|
| RETURN AIR #       | 1    | 2    | 3    | 4    | 5    | 6    |       |       |       |       |       |       |       |       |      |  | BR |
| AIR VOLUME         | 155  | 155  | 95   | 95   | 135  | 310  | 0     | 0     | 0     | 0     | 0     | 0     | 0     | 0     | 186  |  |    |
| PLENUM PRESSURE    | 0.15 | 0.15 | 0.15 | 0.15 | 0.15 | 0.15 | 0.15  | 0.15  | 0.15  | 0.15  | 0.15  | 0.15  | 0.15  | 0.15  | 0.15 |  |    |
| ACTUAL DUCT LCH    | 58   | 43   | 42   | 48   | 38   | 15   | 1     | 1     | 1     | 1     | 1     | 1     | 1     | 1     | 17   |  |    |
| EQUIVALENT LENGTH  | 150  | 135  | 175  | 175  | 145  | 135  | 0     | 0     | 0     | 0     | 0     | 0     | 0     | 0     | 145  |  |    |
| TOTAL EFFECTIVE LH | 208  | 178  | 217  | 223  | 183  | 150  | 1     | 1     | 1     | 1     | 1     | 1     | 1     | 1     | 162  |  |    |
| ADJUSTED PRESSURE  | 0.07 | 0.08 | 0.07 | 0.07 | 0.08 | 0.10 | 14.80 | 14.80 | 14.80 | 14.80 | 14.80 | 14.80 | 14.80 | 14.80 | 0.09 |  |    |
| ROUND DUCT SIZE    | 7.2  | 7    | 6    | 6    | 6.6  | 8.6  | 0     | 0     | 0     | 0     | 0     | 0     | 0     | 0     | 7.3  |  |    |
| INLET GRILL SIZE   | 8    | 8    | 8    | 8    | 8    | 8    | 0     | 0     | 0     | 0     | 0     | 0     | 0     | 0     | 8    |  |    |
|                    | X    | X    | X    | X    | X    | X    | X     | X     | X     | X     | X     | X     | X     | X     | X    |  |    |
| INLET GRILL SIZE   | 14   | 14   | 14   | 14   | 14   | 30   | 0     | 0     | 0     | 0     | 0     | 0     | 0     | 0     | 14   |  |    |

| CSA F280-12 Residential Heat Loss and Heat Gain Calculations   | |
|---|
| Formula Sheet (For Air Leakage / Ventilation Calculation)   | |
| LO#: 79581   | Model: MILLWOOD 2 | Builder: GREENPARK HOMES                            | Date: 8/8/2018   | |
| Volume Calculation   |                   |                                                     | Air Change & Delta T Data   | |
| <b>House Volume</b><br><table border="1" style="width: 100%; border-collapse: collapse;"> <thead> <tr> <th>Level</th> <th>Floor Area (ft²)</th> <th>Floor Height (ft)</th> <th>Volume (ft³)</th> </tr> </thead> <tbody> <tr> <td>Bsmt</td> <td>1148</td> <td>9</td> <td>10332</td> </tr> <tr> <td>First</td> <td>1148</td> <td>10</td> <td>11480</td> </tr> <tr> <td>Second</td> <td>1506</td> <td>9</td> <td>13554</td> </tr> <tr> <td>Third</td> <td>0</td> <td>9</td> <td>0</td> </tr> <tr> <td>Fourth</td> <td>0</td> <td>9</td> <td>0</td> </tr> <tr> <td colspan="3" style="text-align: right;">Total:</td> <td>35,366.0 ft³</td> </tr> <tr> <td colspan="3" style="text-align: right;">Total:</td> <td>1001.5 m³</td> </tr> </tbody> </table>   |                   |                                                     | Level   | Floor Area (ft²)                                          | Floor Height (ft) | Volume (ft³)      | Bsmt                                                | 1148                                               | 9                                                         | 10332 | First | 1148   | 10    | 11480 | Second | 1506 | 9      | 13554 | Third | 0   | 9      | 0     | Fourth | 0 | 9 | 0     | Total: |   |   | 35,366.0 ft³ | Total: |  |  | 1001.5 m³ | <table border="1" style="width: 100%; border-collapse: collapse;"> <tr> <td style="width: 70%;">WINTER NATURAL AIR CHANGE RATE</td> <td style="width: 30%;">0.354</td> </tr> <tr> <td>SUMMER NATURAL AIR CHANGE RATE</td> <td>0.115</td> </tr> </table><br><table border="1" style="width: 100%; border-collapse: collapse;"> <tr> <th colspan="5" style="text-align: center;">Design Temperature Difference</th> </tr> <tr> <th></th> <th>Tin °C</th> <th>Tout °C</th> <th>ΔT °C</th> <th>ΔT °F</th> </tr> <tr> <td>Winter DTDh</td> <td>22</td> <td>-19</td> <td>41</td> <td>74</td> </tr> <tr> <td>Summer DTDc</td> <td>24</td> <td>30</td> <td>6</td> <td>11</td> </tr> </table> |  | WINTER NATURAL AIR CHANGE RATE | 0.354 | SUMMER NATURAL AIR CHANGE RATE | 0.115 | Design Temperature Difference |  |  |  |  |  | Tin °C | Tout °C | ΔT °C | ΔT °F | Winter DTDh | 22 | -19 | 41 | 74 | Summer DTDc | 24 | 30 | 6 | 11 |
| Level   | Floor Area (ft²)  | Floor Height (ft)                                   | Volume (ft³)   | |
| Bsmt   | 1148              | 9                                                   | 10332   | |
| First   | 1148              | 10                                                  | 11480   | |
| Second   | 1506              | 9                                                   | 13554   | |
| Third   | 0                 | 9                                                   | 0   | |
| Fourth   | 0                 | 9                                                   | 0   | |
| Total:   |                   |                                                     | 35,366.0 ft³   | |
| Total:   |                   |                                                     | 1001.5 m³   | |
| WINTER NATURAL AIR CHANGE RATE   | 0.354             | |
| SUMMER NATURAL AIR CHANGE RATE   | 0.115             | |
| Design Temperature Difference   | |
|   | Tin °C            | Tout °C                                             | ΔT °C   | ΔT °F                                                     | |
| Winter DTDh   | 22                | -19                                                 | 41   | 74                                                        | |
| Summer DTDc   | 24                | 30                                                  | 6   | 11                                                        | |
| 5.2.3.1 Heat Loss due to Air Leakage   |                   |                                                     | 6.2.6 Sensible Gain due to Air Leakage                                                                                               | |
| $HL_{airb} = LR_{airh} \times \frac{V_b}{3.6} \times DTD_h \times 1.2$ <p>0.354 x 278.18 x 41 °C x 1.2 = 4875 W</p> <p>= 16633 Btu/h</p>   |                   |                                                     | $HG_{salb} = LR_{airc} \times \frac{V_b}{3.6} \times DTD_c \times 1.2$ <p>0.115 x 278.18 x 6 °C x 1.2 = 235 W</p> <p>= 802 Btu/h</p> | |
| 5.2.3.2 Heat Loss due to Mechanical Ventilation   |                   |                                                     | 6.2.7 Sensible heat Gain due to Ventilation                                                                                          | |
| $HL_{vaib} = PVC \times DTD_h \times 1.08 \times (1 - E)$ <p>80 CFM x 74 °F x 1.08 x 0.25 = 1593 Btu/h</p>   |                   |                                                     | $HL_{vaib} = PVC \times DTD_h \times 1.08 \times (1 - E)$ <p>80 CFM x 11 °F x 1.08 x 0.25 = 236 Btu/h</p>                            | |
| 5.2.3.3 Calculation of Air Change Heat Loss for Each Room (Floor Multiplier Section)   | |
| $HL_{airr} = Level\ Factor \times HL_{airbv} \times ((HL_{agcr} + HL_{bgcr}) + (HL_{agclel} + HL_{bgclel}))$ <table border="1" style="width: 100%; border-collapse: collapse;"> <thead> <tr> <th>Level</th> <th>Level Factor (LF)</th> <th>HLairbv Air Leakage + Ventilation Heat Loss (Btu/h)</th> <th>Level Conductive Heat Loss: (HL<sub>level</sub>)</th> <th>Air Leakage Heat Loss Multiplier (LF x HLairbv / HLlevel)</th> </tr> </thead> <tbody> <tr> <td>1</td> <td>0.5</td> <td rowspan="5" style="text-align: center;">16,633</td> <td>7,649</td> <td>1.087</td> </tr> <tr> <td>2</td> <td>0.3</td> <td>11,278</td> <td>0.442</td> </tr> <tr> <td>3</td> <td>0.2</td> <td>12,017</td> <td>0.277</td> </tr> <tr> <td>4</td> <td>0</td> <td>0</td> <td>0.000</td> </tr> <tr> <td>5</td> <td>0</td> <td>0</td> <td>0.000</td> </tr> </tbody> </table> <p>*HLairbv = Air leakage heat loss + ventilation heat loss<br/> *For a balanced or supply only ventilation system HLairv = 0</p> |                   |                                                     |   |                                                           | Level             | Level Factor (LF) | HLairbv Air Leakage + Ventilation Heat Loss (Btu/h) | Level Conductive Heat Loss: (HL <sub>level</sub> ) | Air Leakage Heat Loss Multiplier (LF x HLairbv / HLlevel) | 1     | 0.5   | 16,633 | 7,649 | 1.087 | 2      | 0.3  | 11,278 | 0.442 | 3     | 0.2 | 12,017 | 0.277 | 4      | 0 | 0 | 0.000 | 5      | 0 | 0 | 0.000        |        |  
| Level   | Level Factor (LF) | HLairbv Air Leakage + Ventilation Heat Loss (Btu/h) | Level Conductive Heat Loss: (HL <sub>level</sub> )                                                                                   | Air Leakage Heat Loss Multiplier (LF x HLairbv / HLlevel) | |
| 1   | 0.5               | 16,633                                              | 7,649   | 1.087                                                     | |
| 2   | 0.3               |                                                     | 11,278   | 0.442                                                     | |
| 3   | 0.2               |                                                     | 12,017   | 0.277                                                     | |
| 4   | 0                 |                                                     | 0   | 0.000                                                     | |
| 5   | 0                 |                                                     | 0   | 0.000                                                     | |

CITY OF BRAMPTON  
BUILDING DIVISION  
REVIEWED

NOV 28 2010

HVAC BY  
MONICA CRISAN

**HEAT LOSS AND GAIN SUMMARY SHEET****MODEL:** MILLWOOD 2**BUILDER:** GREENPARK HOMES**SFQT:** 2654**LO#** 79581**SITE:** MINNISSALE HOMES CORP**DESIGN ASSUMPTIONS**

|                      |    |                                |    |
|----------------------|----|--------------------------------|----|
| HEATING              | *F | COOLING                        | *F |
| OUTDOOR DESIGN TEMP. | -2 | OUTDOOR DESIGN TEMP.           | 86 |
| INDOOR DESIGN TEMP.  | 72 | INDOOR DESIGN TEMP. (MAX 75°F) | 75 |

**BUILDING DATA**

|                                     |                 |                           |          |
|-------------------------------------|-----------------|---------------------------|----------|
| ATTACHMENT:                         | DETACHED        | # OF STORIES (+BASEMENT): | 3        |
| FRONT FACES:                        | EAST            | ASSUMED (Y/N):            | Y        |
| AIR CHANGES PER HOUR:               | 3.57            | ASSUMED (Y/N):            | Y        |
| AIR TIGHTNESS CATEGORY:             | AVERAGE         | ASSUMED (Y/N):            | Y        |
| WIND EXPOSURE:                      | SHELTERED       | ASSUMED (Y/N):            | Y        |
| HOUSE VOLUME (ft³):                 | 35366.0         | ASSUMED (Y/N):            | Y        |
| INTERNAL SHADING:                   | BLINDS/CURTAINS | ASSUMED OCCUPANTS:        | 5        |
| INTERIOR LIGHTING LOAD (Btu/h/ft²): | 1.65            | DC BRUSHLESS MOTOR (Y/N): | Y        |
| FOUNDATION CONFIGURATION            | BCIN_1          | DEPTH BELOW GRADE:        | 6.0 ft   |
| LENGTH: 46.0 ft                     | WIDTH: 31.0 ft  | EXPOSED PERIMETER:        | 154.0 ft |

**2012 OBC - COMPLIANCE PACKAGE****Component**

|                                                                            |
|----------------------------------------------------------------------------|
| Ceiling with Attic Space Minimum RSI (R)-Value                             |
| Ceiling Without Attic Space Minimum RSI (R)-Value                          |
| Exposed Floor Minimum RSI (R)-Value                                        |
| Walls Above Grade Minimum RSI (R)-Value                                    |
| Basement Walls Minimum RSI (R)-Value                                       |
| Below Grade Slab Entire surface > 600 mm below grade Minimum RSI (R)-Value |
| Edge of Below Grade Slab ≤ 600 mm Below Grade Minimum RSI (R)-Value        |
| Heated Slab or Slab ≤ 600 mm below grade Minimum RSI (R)-Value             |
| Windows and Sliding Glass Doors Maximum U-Value                            |
| Skylights Maximum U-Value                                                  |
| Space Heating Equipment Minimum AFUE                                       |
| HRV Minimum Efficiency                                                     |
| Domestic Hot Water Heater Minimum EF                                       |

**Compliance Package****A1**

| Nominal | Min. Eff. |
|---------|-----------|
| 60      | 59.22     |
| 31      | 27.65     |
| 31      | 29.80     |
| 22      | 17.03     |
| 20 ci   | 21.12     |
| -       | -         |
| 10      | 10        |
| 10      | 11.13     |
| 0.28    | -         |
| 0.49    | -         |
| 0.96    | -         |
| 75%     | -         |
| 0.8     | -         |

INDIVIDUAL BCIN: 19669

MICHAEL O'ROURKE

*Michael O'Rourke*

TYPE: MILLWOOD 2  
SITE NAME: MINNISSALE HOMES CORP

LO # 79581

### RESIDENTIAL MECHANICAL VENTILATION DESIGN SUMMARY

**COMBUSTION APPLIANCES** 9.32.3.1(1)

a) ☐ Direct vent (sealed combustion) only

b) ☐ Positive venting induced draft (except fireplaces)

c) ☐ Natural draft, B-vent or induced draft gas fireplace

d) ☐ Solid Fuel (including fireplaces)

e) ☐ No Combustion Appliances

**HEATING SYSTEM**

☒ Forced Air ☐ Non Forced Air

☐ Electric Space Heat

**HOUSE TYPE** 9.32.1(2)

☐ I Type a) or b) appliance only, no solid fuel

☐ II Type I except with solid fuel (including fireplaces)

☐ III Any Type c) appliance

☐ IV Type I, or II with electric space heat

☐ Other: Type I, II or IV no forced air

**SYSTEM DESIGN OPTIONS** O.N.H.W.P.

☐ 1 Exhaust only/Forced Air System

☐ 2 HRV with Ducting/Forced Air System

☒ 3 HRV Simplified/connected to forced air system

☐ 4 HRV with Ducting/non forced air system

☐ Part 6 Design

**TOTAL VENTILATION CAPACITY** 9.32.3.3(1)

|                           |   |            |              |                  |
|---------------------------|---|------------|--------------|------------------|
| Basement + Master Bedroom | 2 | @ 21.2 cfm | 42.4         | cfm              |
| Other Bedrooms            | 3 | @ 10.6 cfm | 31.8         | cfm              |
| Kitchen & Bathrooms       | 5 | @ 10.6 cfm | 53           | cfm              |
| Other Rooms               | 6 | @ 10.6 cfm | 63.6         | cfm              |
| Table 9.32.3.A.           |   |            | <b>TOTAL</b> | <b>190.8</b> cfm |

**PRINCIPAL VENTILATION CAPACITY REQUIRED** 9.32.3.4(1)

|              |             |            |
|--------------|-------------|------------|
| 1 Bedroom    | 31.8        | cfm        |
| 2 Bedroom    | 47.7        | cfm        |
| 3 Bedroom    | 63.6        | cfm        |
| 4 Bedroom    | 79.5        | cfm        |
| 5 Bedroom    | 95.4        | cfm        |
| <b>TOTAL</b> | <b>79.5</b> | <b>cfm</b> |

**SUPPLEMENTAL VENTILATION CAPACITY** 9.32.3.5

|                                 |       |     |
|---------------------------------|-------|-----|
| Total Ventilation Capacity      | 190.8 | cfm |
| Less Principal Ventil. Capacity | 79.5  | cfm |
| Required Supplemental Capacity  | 111.3 | cfm |

**PRINCIPAL EXHAUST FAN CAPACITY**

Model: VANEE 65H Location: BSMT

79.5 cfm 3.0 sones ☒ HVI Approved

**PRINCIPAL EXHAUST HEAT LOSS CALCULATION**

| CFM      | ΔT °F | FACTOR | % LOSS |
|----------|-------|--------|--------|
| 79.5 CFM | 74 F  | 1.08   | 0.25   |

**SUPPLEMENTAL FANS** PANASONIC

| Location | Model       | cfm | HVI | Sones |
|----------|-------------|-----|-----|-------|
| ENS      | FV-05-11VK1 | 50  | ✓   | 0.3   |
| BATH     | FV-05-11VK1 | 50  | ✓   | 0.3   |
| ENS-2    | FV-05-11VK1 | 50  | ✓   | 0.3   |
| WIR      | FV-05-11VK1 | 50  | ✓   | 0.3   |

**HEAT RECOVERY VENTILATOR** 9.32.3.11

Model: VANEE 65H

155 cfm high 64 cfm low

75 % Sensible Efficiency @ 32 deg F (0 deg C) ☒ HVI Approved

**LOCATION OF INSTALLATION**

Lot: Concession

Township: Plan:

Address:

Roll # Building Permit #

**BUILDER:** GREENPARK HOMES

Name:

Address:

City:

Telephone #: Fax #:

**INSTALLING CONTRACTOR**

Name:

Address:

City:

Telephone #: Fax #:

**DESIGNER CERTIFICATION**

I hereby certify that this ventilation system has been designed in accordance with the Ontario Building Code.

Name: HVAC Designs Ltd.


Signature: *Michael O'Rourke*

HRAI # 001820

Date: August-18

## Residential Foundation Thermal Load Calculator

Supplemental tool for CAN/CSA-F280
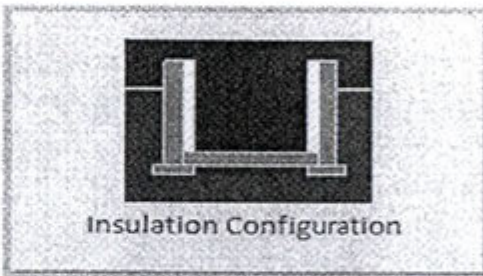
| Weather Station Description    |                                           |   |
|--------------------------------|-------------------------------------------|---|
| Province:                      | Ontario                                   |   |
| Region:                        | Brampton                                  |   |
| Site Description               |                                           |   |
| Soil Conductivity:             | Normal conductivity: dry sand, loam, clay |   |
| Water Table:                   | Normal (7-10 m, 23-33 ft)                 |   |
| Foundation Dimensions          |                                           |   |
| Floor Length (m):              | 14.0                                      | <br>Insulation Configuration |
| Floor Width (m):               | 9.4                                       |   |
| Exposed Perimeter (m):         | 0.0                                       |   |
| Wall Height (m):               | 2.7                                       |   |
| Depth Below Grade (m):         | 1.83                                      |   |
| Window Area (m <sup>2</sup> ): | 1.4                                       |   |
| Door Area (m <sup>2</sup> ):   | 1.9                                       |   |
| Radiant Slab                   |                                           |   |
| Heated Fraction of the Slab:   | 0                                         |   |
| Fluid Temperature (°C):        | 33                                        |   |
| Design Months                  |                                           |   |
| Heating Month                  | 1                                         |   |
| Foundation Loads               |                                           |   |
| Heating Load (Watts):          |                                           | 1537   |



TYPE: MILLWOOD 2  
LO# 79581

## Air Infiltration Residential Load Calculator


Supplemental tool for CAN/CSA-F280

| Weather Station Description       |                            |                                       |    |
|-----------------------------------|----------------------------|---------------------------------------|----|
| Province:                         | Ontario                    |                                       |    |
| Region:                           | Brampton                   |                                       |    |
| Weather Station Location:         | Open flat terrain, grass   |                                       |    |
| Anemometer height (m):            | 10                         |                                       |    |
| Local Shielding                   |                            |                                       |    |
| Building Site:                    | Suburban, forest           |                                       |    |
| Walls:                            | Heavy                      |                                       |    |
| Flue:                             | Heavy                      |                                       |    |
| Highest Ceiling Height (m):       | 7.62                       |                                       |    |
| Building Configuration            |                            |                                       |    |
| Type:                             | Detached                   |                                       |    |
| Number of Stories:                | Two                        |                                       |    |
| Foundation:                       | Full                       |                                       |    |
| House Volume (m <sup>3</sup> ):   | 1001.5                     |                                       |    |
| Air Leakage/Ventilation           |                            |                                       |    |
| Air Tightness Type:               | Present (1961-) (3.57 ACH) |                                       |    |
| Custom BDT Data:                  | ELA @ 10 Pa.<br>3.57       | 1335.0 cm <sup>2</sup><br>ACH @ 50 Pa |    |
| Mechanical Ventilation (L/s):     | Total Supply<br>37.5       | Total Exhaust<br>37.5                 |    |
| Flue Size                         |                            |                                       |    |
| Flue #:                           | #1                         | #2                                    | #3 |
| Diameter (mm):                    | 0                          | 0                                     | 0  |
|                                   | #4                         | 0                                     |    |
| Natural Infiltration Rates        |                            |                                       |    |
| Heating Air Leakage Rate (ACH/H): | 0.354                      |                                       |    |
| Cooling Air Leakage Rate (ACH/H): | 0.115                      |                                       |    |

TYPE: MILLWOOD 2  
LO# 79581

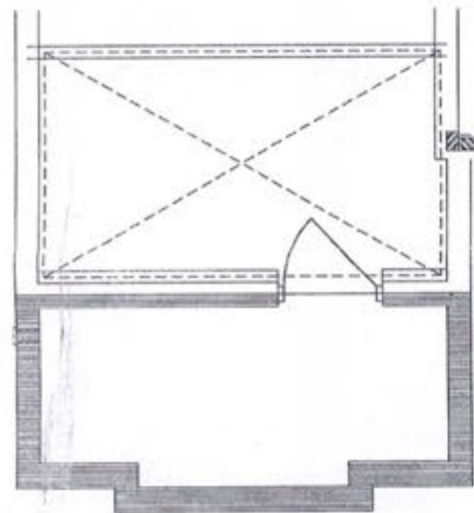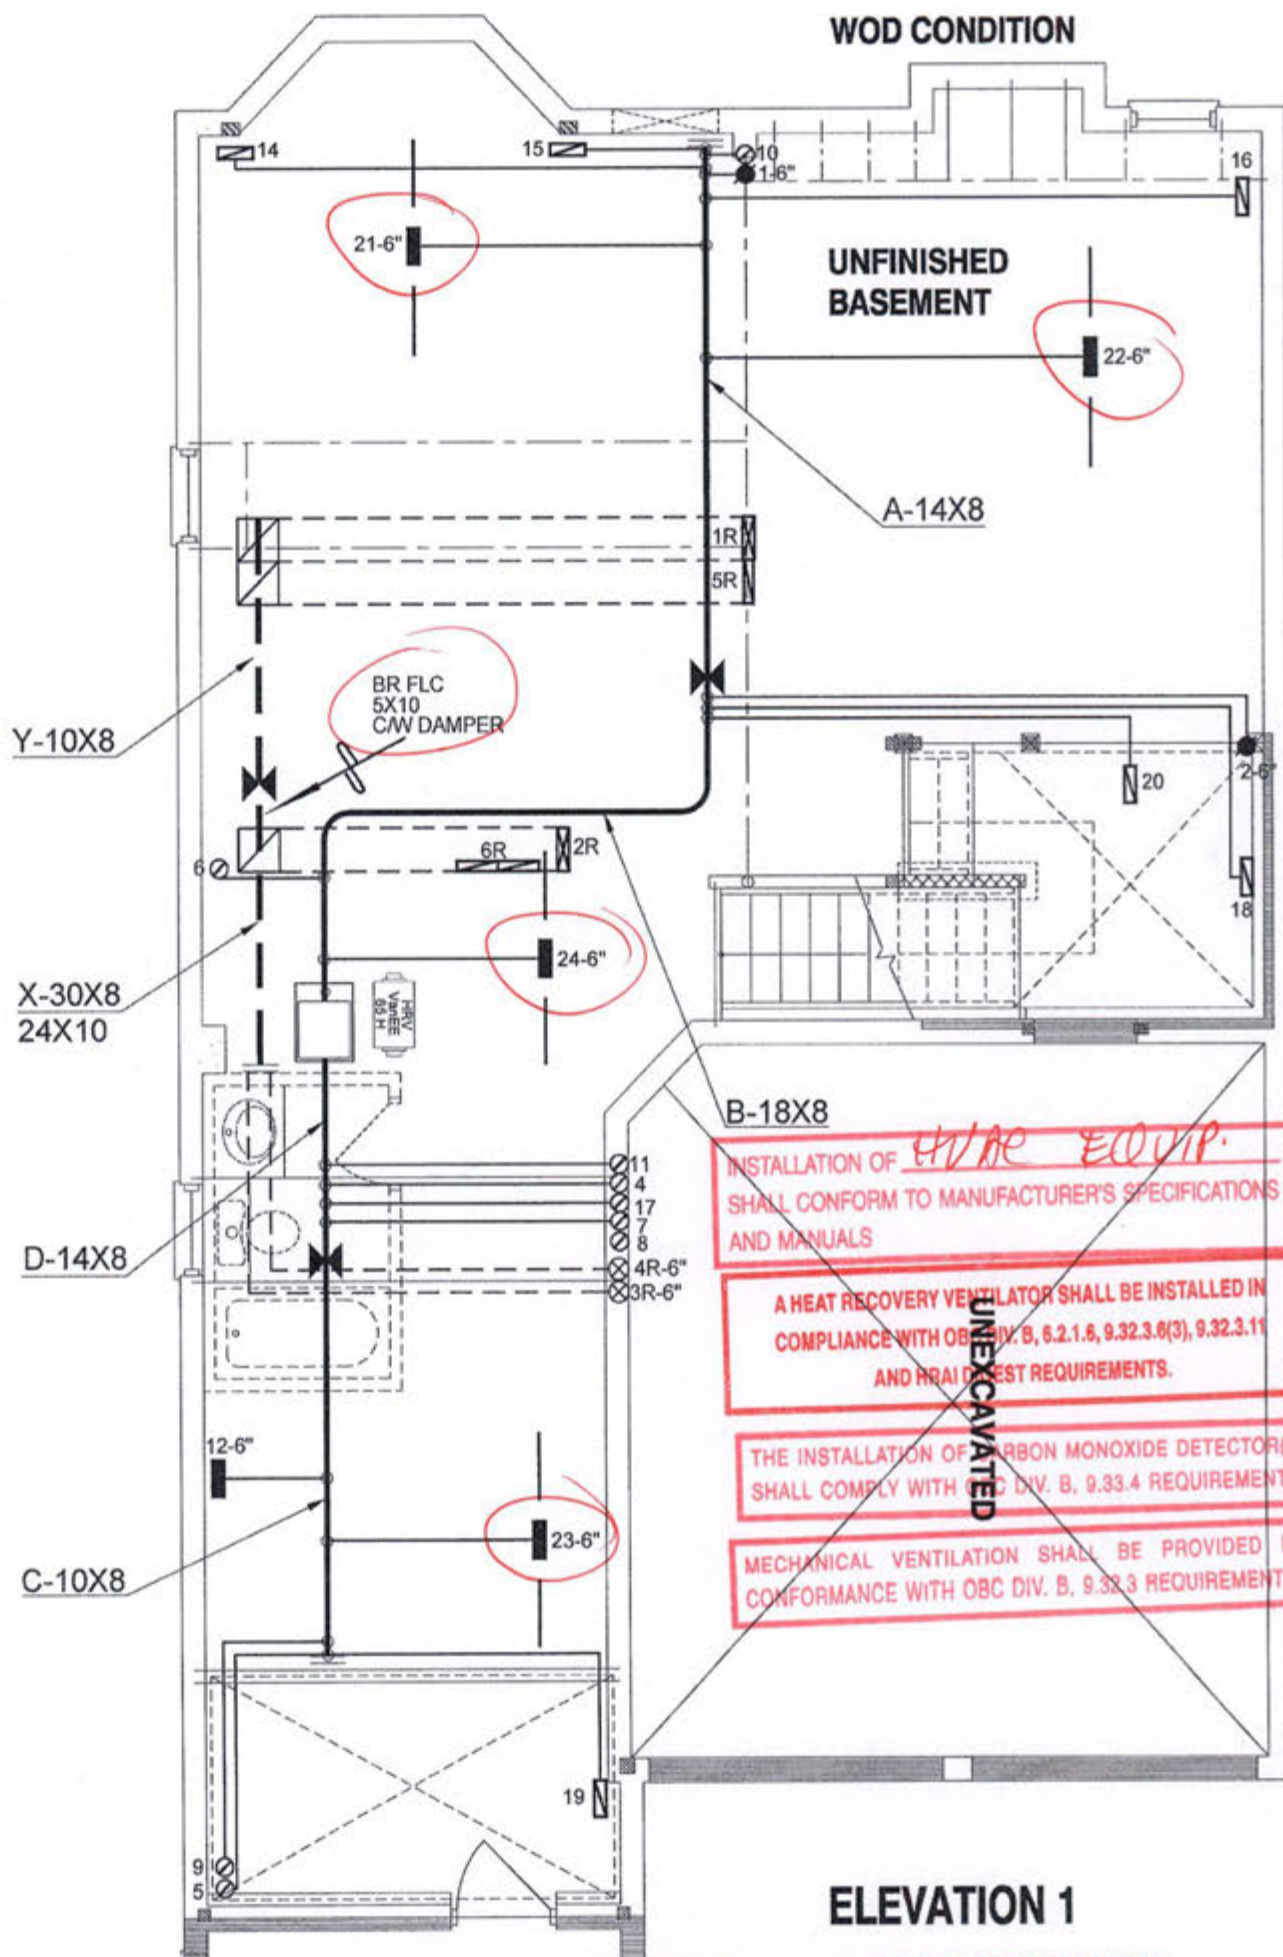

ELEVATION 2

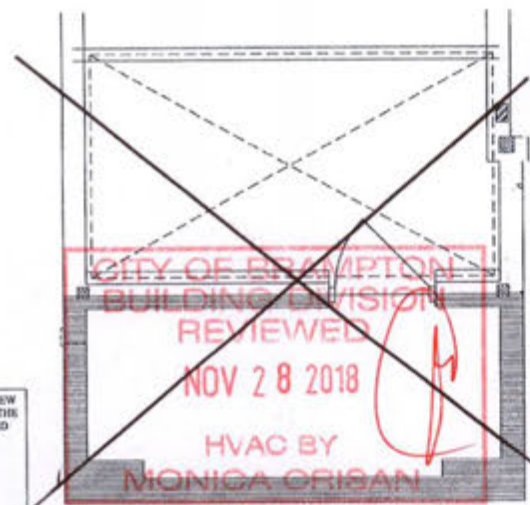

ELEVATION

ENSURE THAT MIN THERMAL PERFORMANCE OF BLDG ENVELOPE AND EQUIPMENT SHALL CONFORM TO OBC SB-12, 3.1.1.2 TABLES REQUIREMENTS. FURNACE SHALL BE EQUIPPED WITH BRUSHLESS DIRECT CURRENT MOTOR OBC DIV B 12.3.1.5. SEAL ALL DUCTWORK WITHIN UNCONDITIONED SPACE or OUTDOORS PER OBC DIV B6.2.4.3(11) REQUIREMENTS. SEAL ALL SUPPLY DUCTS LOCATED IN CONDITIONED SPACE IN COMPLIANCE WITH OBC DIV B6.2.4.3(12) REQUIREMENTS. SEPARATE ANY INTAKES FROM BUILDING ENVELOPE PENETRATIONS THAT ARE POTENTIAL SOURCES OF CONTAMINANTS (GAS VENTS, OIL FILL PIPES, etc. BY MIN 900mm (2FT 11IN) - OBC Div B 9.32.3.12. INSTALLATION OF KITCHEN EXHAUST DUCT LARGER THAN 6" dia SHALL BE PRECEDED BY APPLICATION FOR REVISION OF DESIGN PER OBC PART 6 REQUIREMENTS. EXHAUST FAN SHALL DISCHARGE DIRECTLY TO OUTSIDE. CLOTHES DRYER EXHAUST SYSTEM SHALL COMPLY WITH OBC DIV B 9.32.1.2, 9.32.1.3 & 9.32.3 REQ'S. BALANCE THE RETURN AIRFLOW ON THE UPPER FLOOR TO MATCH THE SUPPLY. WHEN HRV IS USED AS PRINCIPAL EXHAUST FAN, THE CONTROLLER SHALL BE WIRED TO THE HRV UNIT AND INTERCONNECTED TO THE FURNACE FAN. THE FURNACE BLOWER MUST BE IN OPERATION WHEN THE HRV IS IN OPERATION. INSTALL ADDITIONAL S/A REGISTER AS REQUIRED IN ORDER TO ENSURE MIN 72degF - OBC DIV B 9.33.3.1(1). UNDERCUT BY MIN 1" THE DOOR TO ANY ROOM WITHOUT RETURN AIR GRILLE. ENSURE RETURN AIR INTAKE SHALL BE CONNECTED TO THE MAIN R/A DUCT AT A HORIZONTAL DISTANCE OF MIN 6FT FROM THE CASING OF THE UNIT (HRAI DIGEST).

**UNEXCAVATED**

INSTALLATION OF HVAC EQUIP. SHALL CONFORM TO MANUFACTURER'S SPECIFICATIONS AND MANUALS

A HEAT RECOVERY VENTILATOR SHALL BE INSTALLED IN COMPLIANCE WITH OBC DIV. B, 6.2.1.5, 9.32.3.8(3), 9.32.3.11 AND HRAI TEST REQUIREMENTS.

THE INSTALLATION OF CARBON MONOXIDE DETECTOR(S) SHALL COMPLY WITH OBC DIV. B, 9.33.4 REQUIREMENTS.

MECHANICAL VENTILATION SHALL BE PROVIDED IN CONFORMANCE WITH OBC DIV. B, 9.32.3 REQUIREMENTS.

ELEVATION 1

HVAC LEGEND

| SYMBOL | DESCRIPTION                     | SYMBOL | DESCRIPTION                     | SYMBOL | DESCRIPTION                  | SYMBOL | DESCRIPTION                |
|--------|---------------------------------|--------|---------------------------------|--------|------------------------------|--------|----------------------------|
|        | FLOOR SUPPLY AIR GRILLE         |        | 6" SUPPLY AIR BOOT ABOVE        |        | 14"x8" RETURN AIR GRILLE     |        | RETURN AIR STACK ABOVE     |
|        | FLOOR SUPPLY AIR GRILLE 6" BOOT |        | SUPPLY AIR STACK FROM 2nd FLOOR |        | 30"x8" RETURN AIR GRILLE     |        | RETURN AIR STACK 2nd FLOOR |
|        | SUPPLY AIR BOOT ABOVE           |        | 6" SUPPLY AIR STACK 2nd FLOOR   |        | FRA- FLOOR RETURN AIR GRILLE |        | REDUCER                    |

|           |             |      |
|-----------|-------------|------|
| 3.        |             |      |
| 2.        |             |      |
| 1.        |             |      |
| No.       | Description | Date |
| REVISIONS |             |      |

ALL DRAWINGS, CALCULATIONS AND SPECIFICATIONS ARE THE PROPERTY OF HVAC DESIGNS LTD. © AND MAY NOT BE REPRODUCED, MODIFIED OR ALTERED WITHOUT EXPRESSED WRITTEN CONSENT. THE DRAWINGS ARE DATED AND USE OF THESE DRAWINGS AFTER ONE YEAR FROM THE DATED NOTED IS NOT AUTHORIZED. CONTRACTOR SHALL CHECK ALL CONDITIONS BEFORE PROCEEDING WITH WORK. LATEST MUNICIPAL APPROVED DRAWINGS ONLY TO BE USED DURING INSTALLATION OF HEATING SYSTEM. HVAC DESIGNS LTD. IS NOT LIABLE FOR ANY CLAIMS ARISING FROM UNAUTHORIZED USE OF THE DRAWINGS OR FROM ANY CHANGES TO ACCEPTED STANDARDS AND/OR THE ONTARIO BUILDING CODE.

Client  
**GREENPARK HOMES**

Project Name  
**MINNISALE HOMES CORP.  
BRAMPTON, ONTARIO**

**LOT 7**

**MILLWOOD 2**      **2654 sqft**

**HVACDESIGNS LTD.**

375 Finley Ave. Suite 202 - Ajax, Ontario  
L1S 2E2 Tel. 905.619.2300 - 905.420.5300 Fax 905.619.2375  
Email: info@hvacdsgns.ca  
Web: www.hvacdsgns.ca

Specializing in Residential Mechanical Design Services

Installation to comply with the latest Ontario Building Code. All supply branch outlets shall be equipped with a manual balancing damper. Ductwork which passes through the garage or unheated spaces shall be adequately insulated and be gas-proofed.

|                                |  |   |  |     |     |      |
|--------------------------------|--|---|--|-----|-----|------|
| HEAT LOSS 49698 BTU/H          |  | # OF RUNS   |  | S/A | R/A | FANS |
| UNIT DATA                      |  | 3RD FLOOR   |  |     |     |      |
| MAKE GOODMAN                   |  | 2ND FLOOR   |  | 11  | 4   | 3    |
| MODEL GMEC960603BNA-60         |  | 1ST FLOOR   |  | 7   | 2   | 2    |
| INPUT 60 MBTU/H                |  | BASEMENT   |  | 4   | 1   | 0    |
| OUTPUT 57.6 MBTU/H             |  | ALL S/A DIFFUSERS 4 "x10" UNLESS NOTED OTHERWISE ON LAYOUT. ALL S/A RUNS 5"Ø UNLESS NOTED OTHERWISE ON LAYOUT. UNDERCUT DOORS 1" min. FOR R/A |  |     |     |      |
| COOLING 2.5 TONS               |  |   |  |     |     |      |
| FAN SPEED 1131 cfm @ 0.6" w.c. |  |   |  |     |     |      |

Sheet Title  
**BASEMENT HEATING LAYOUT**


Date  
**AUG/2018**

Scale  
**3/16" = 1'-0"**


BCIN# 19669

LO# **79581**


18-333294 000 00 R2

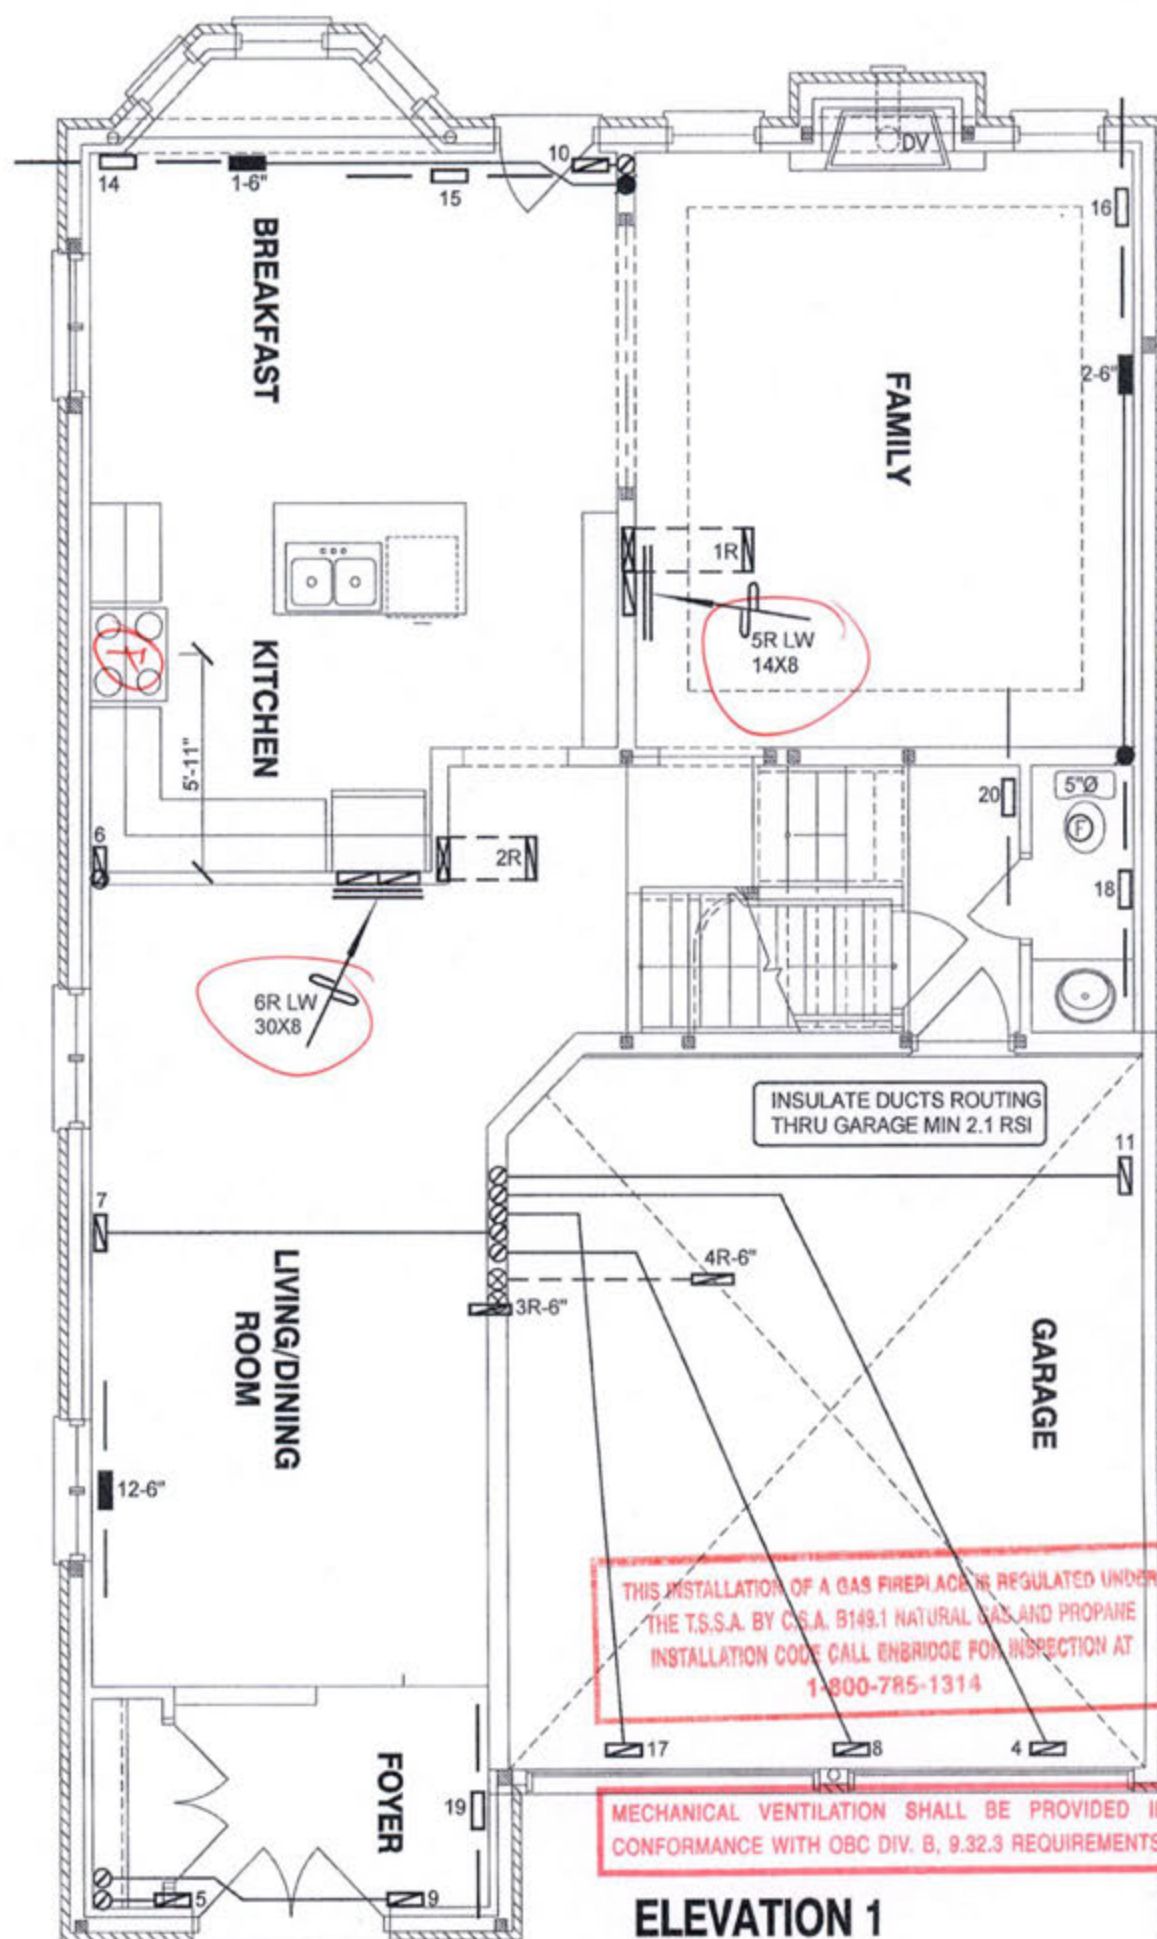

### ELEVATION 1

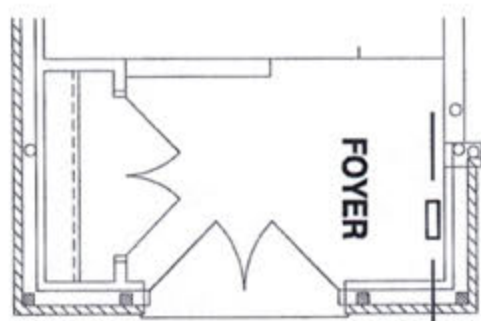

## ELEVATION 2

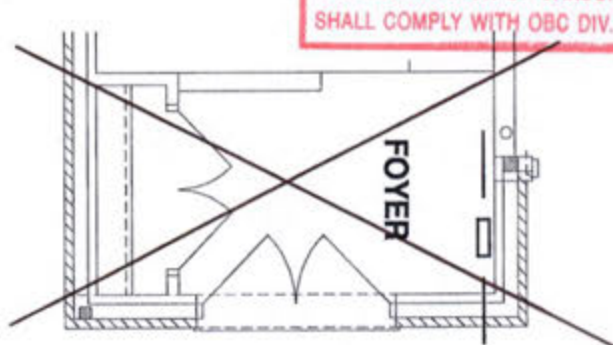

### ELEVATION 3



|             |
|-------------|
| CSA-F280-12 |
| PACKAGE A1  |

| HVAC LEGEND                                                                        |                                 |                                                                                    |                                 |                                                                                    |                              |                                                                                    |                            | 3.        |             |      |
|------------------------------------------------------------------------------------|---------------------------------|------------------------------------------------------------------------------------|---------------------------------|------------------------------------------------------------------------------------|------------------------------|------------------------------------------------------------------------------------|----------------------------|-----------|-------------|------|
| SYMBOL                                                                             | DESCRIPTION                     | SYMBOL                                                                             | DESCRIPTION                     | SYMBOL                                                                             | DESCRIPTION                  | SYMBOL                                                                             | DESCRIPTION                | 2.        |             |      |
|  | SUPPLY AIR BOOT ABOVE           |  | 6" SUPPLY AIR STACK 2nd FLOOR   |  | FRA- FLOOR RETURN AIR GRILLE |  | REDUCER                    | REVISIONS |             |      |

ALL DRAWINGS, CALCULATIONS AND SPECIFICATIONS ARE THE PROPERTY OF HVAC DESIGNS LTD.© AND MAY NOT BE REPRODUCED, MODIFIED OR ALTERED WITHOUT EXPRESSED WRITTEN CONSENT. THE DRAWINGS ARE DATED AND USE OF THESE DRAWINGS AFTER ONE YEAR FROM THE DATED NOTED IS NOT AUTHORIZED. CONTRACTOR SHALL CHECK ALL CONDITIONS BEFORE PROCEEDING WITH WORK. LATEST MUNICIPAL APPROVED DRAWINGS ONLY TO BE USED DURING INSTALLATION OF HEATING SYSTEM. HVAC DESIGNS LTD. IS NOT LIABLE FOR ANY CLAIMS ARISING FROM UNAUTHORIZED USE OF THE DRAWINGS OR FROM ANY CHANGES TO ACCEPTED STANDARDS AND/OR THE ONTARIO BUILDING CODE.

Client  
GREENPARK HOMES

Project Name  
MINNISALE HOMES CORP.  
BRAMPTON, ONTARIO

LOT 7


MILLWOOD 2 2654 sqft

**HVAC DESIGNS LTD.**  
375 Finley Ave. Suite 202 - Ajax, Ontario  
L1S 2E2 Tel. 905.619.2300 - 905.420.5300 Fax 905.619.2375  
Email: [info@hvacdsgns.ca](mailto:info@hvacdsgns.ca)  
Web: [www.hvacdsgns.ca](http://www.hvacdsgns.ca)  
Specializing in Residential Mechanical Design Services

Installation to comply with the latest Ontario Building Code. All supply branch outlets shall be equipped with a manual balancing damper. Ductwork which passes through the garage or unheated spaces shall be adequately insulated and be gas-proofed.

CITY OF BRAMPTON  
BUILDING DIVISION  
REVIEWED  
NOV 28 2018  
HVAC BY  
MONICA CRISAN

|                                  |               |
|----------------------------------|---------------|
| Sheet Title                      |               |
| FIRST FLOOR<br>HEATING<br>LAYOUT |               |
| Date                             | AUG/2018      |
| Scale                            | 3/16" = 1'-0" |
| BCIN# 19669                      |               |
| LO#                              | 79581         |

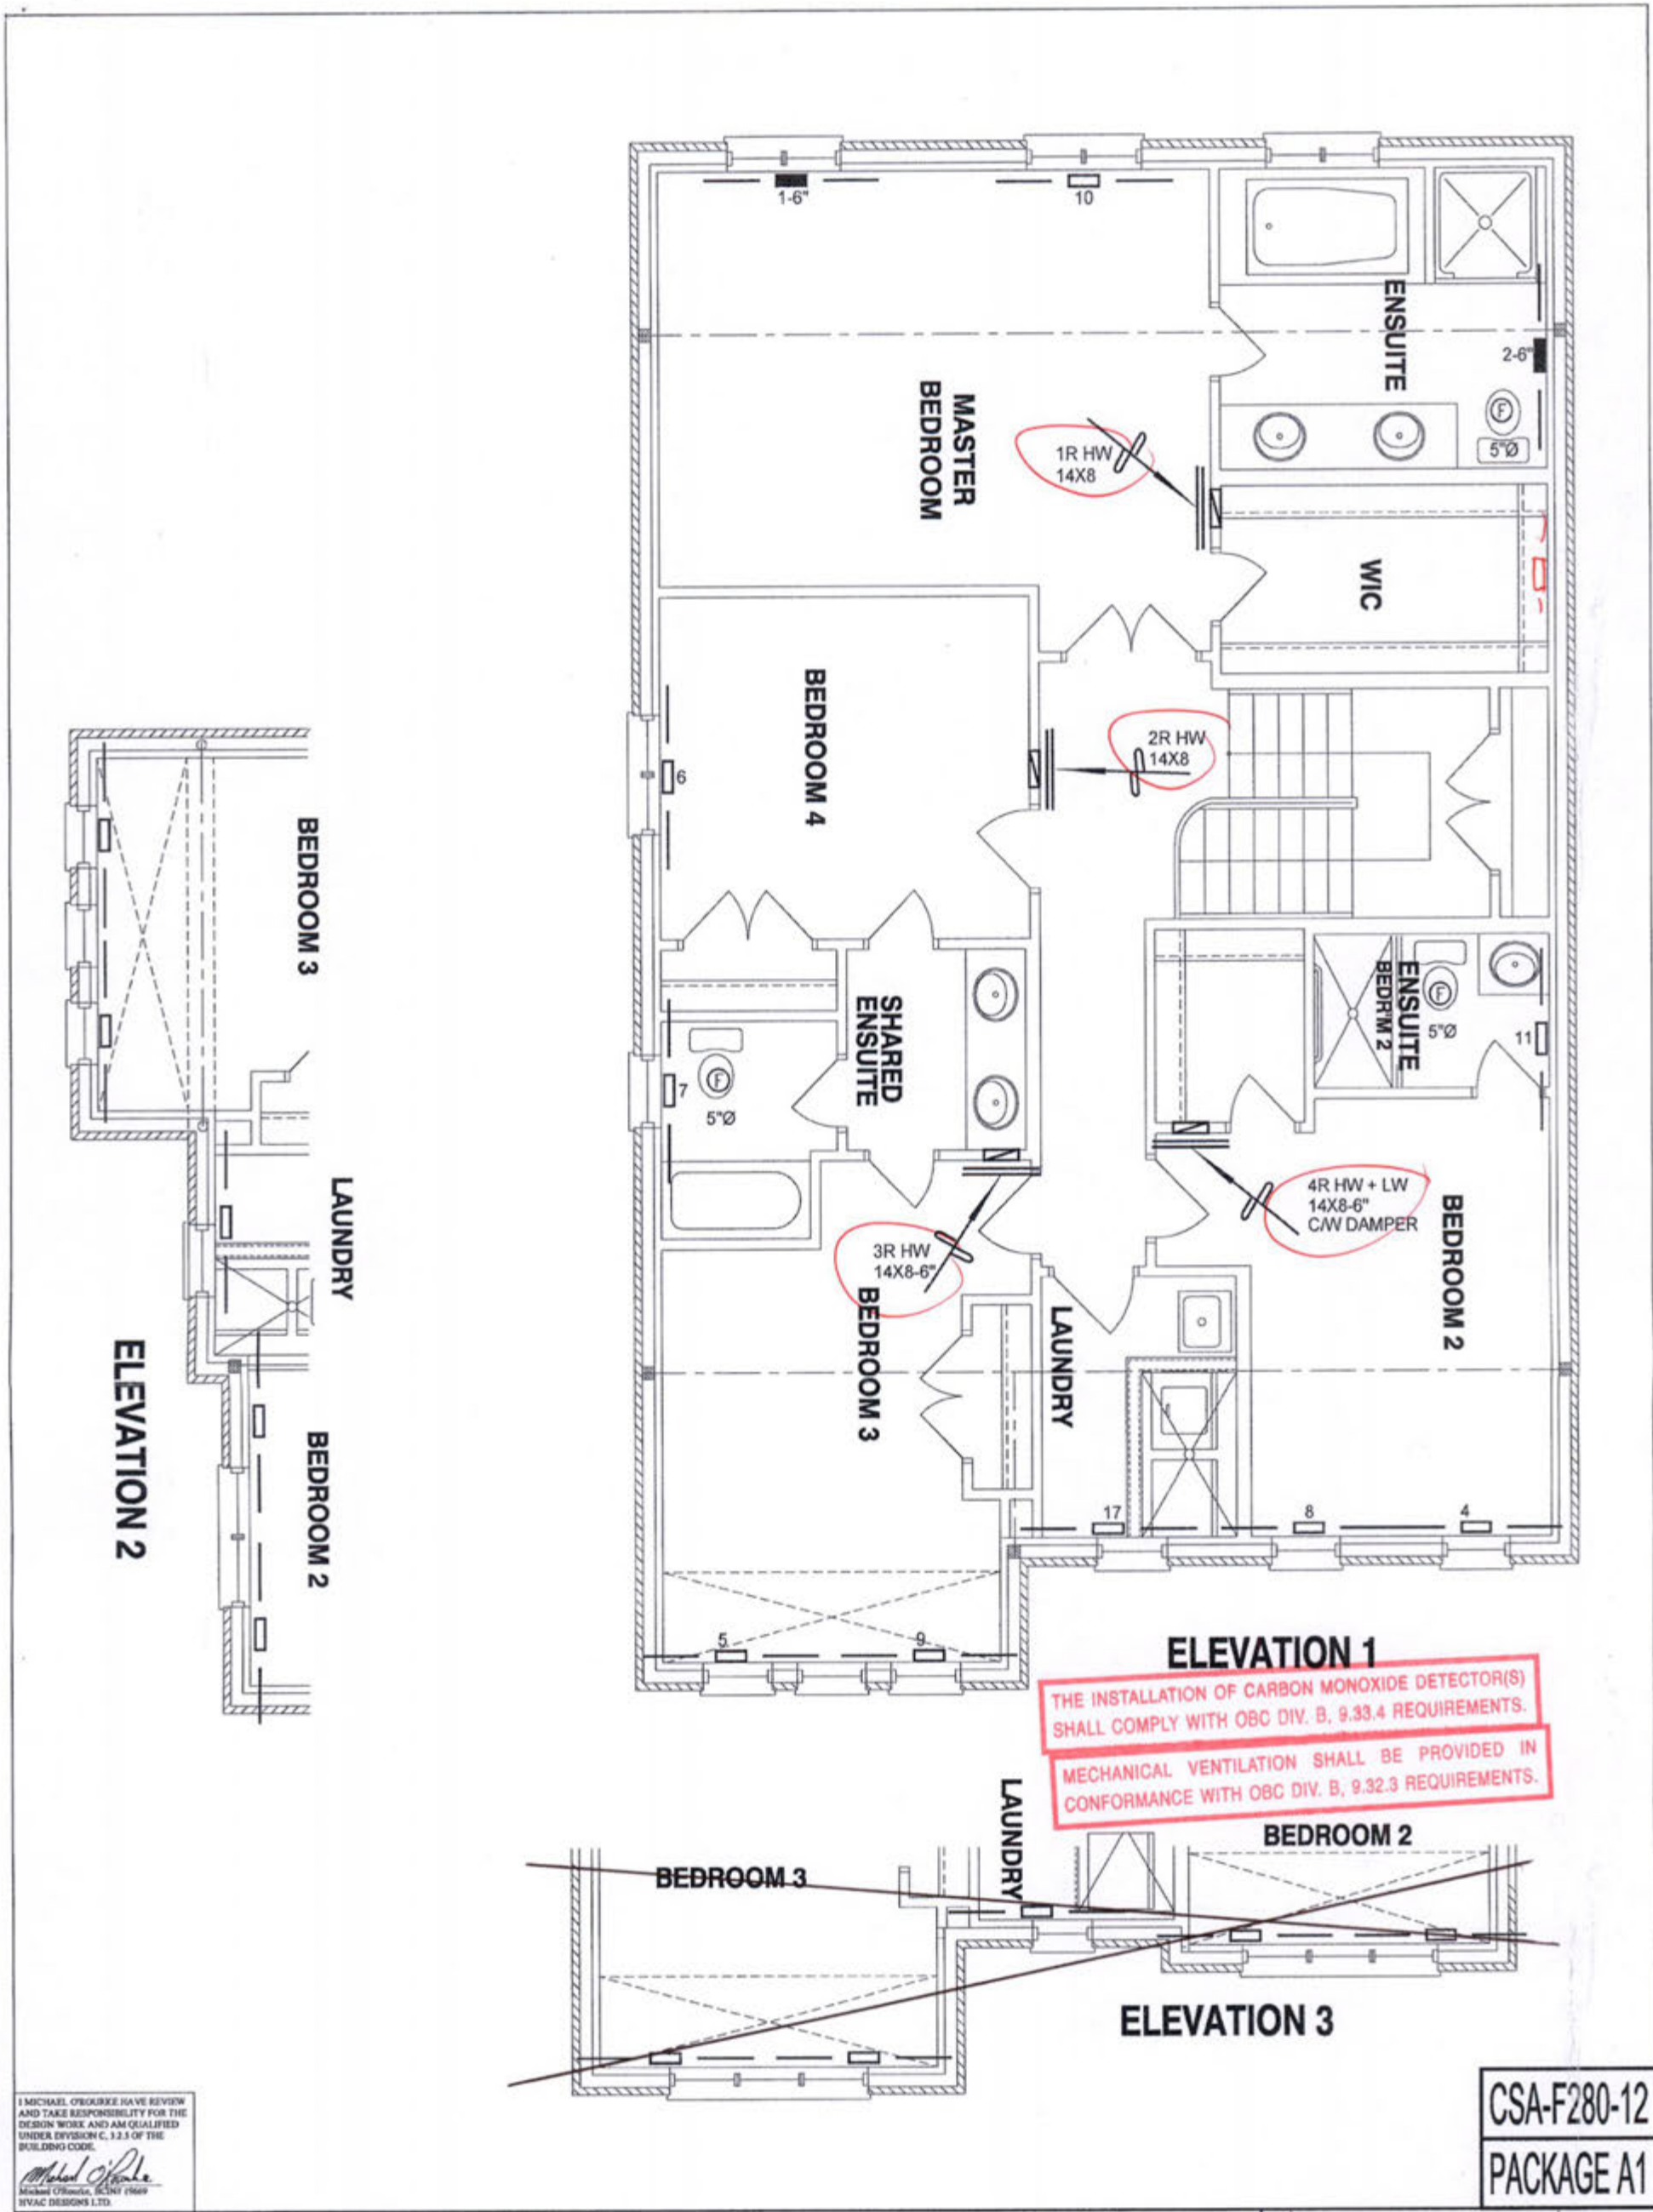

| HVAC LEGEND |                                 |        |                                 |        |                              |        | REVISIONS |      |
|-------------|---------------------------------|--------|---------------------------------|--------|------------------------------|--------|-----------|------|
| SYMBOL      | DESCRIPTION                     | SYMBOL | DESCRIPTION                     | SYMBOL | DESCRIPTION                  | SYMBOL |           |      |
|             | FLOOR SUPPLY AIR GRILLE         |        | 6" SUPPLY AIR BOOT ABOVE        |        | 14"x8" RETURN AIR GRILLE     |        | 3.        |      |
|             | FLOOR SUPPLY AIR GRILLE 6" BOOT |        | SUPPLY AIR STACK FROM 2nd FLOOR |        | 30"x8" RETURN AIR GRILLE     |        | 2.        |      |
|             | SUPPLY AIR BOOT ABOVE           |        | 6" SUPPLY AIR STACK 2nd FLOOR   |        | FRA- FLOOR RETURN AIR GRILLE |        | 1.        |      |
|             |                                 |        |                                 |        |                              |        | No.       | Date |

ALL DRAWINGS, CALCULATIONS AND SPECIFICATIONS ARE THE PROPERTY OF HVAC DESIGNS LTD. AND MAY NOT BE REPRODUCED, MODIFIED OR ALTERED WITHOUT EXPRESSED WRITTEN CONSENT. THE DRAWINGS ARE DATED AND USE OF THESE DRAWINGS AFTER ONE YEAR FROM THE DATED NOTED IS NOT AUTHORIZED. CONTRACTOR SHALL CHECK ALL CONDITIONS BEFORE PROCEEDING WITH WORK. LATEST MUNICIPAL APPROVED DRAWINGS ONLY TO BE USED DURING INSTALLATION OF HEATING SYSTEM. HVAC DESIGNS LTD. IS NOT LIABLE FOR ANY CLAIMS ARISING FROM UNAUTHORIZED USE OF THE DRAWINGS OR FROM ANY CHANGES TO ACCEPTED STANDARDS AND/OR THE ONTARIO BUILDING CODE.

Client

GREENPARK HOMES

Project Name

MINNISALE HOMES CORP.  
BRAMPTON, ONTARIO

LOT 7

MILLWOOD 2      2654 sqft

**HVACDESIGNS LTD.**

375 Finley Ave. Suite 202 - Ajax, Ontario  
L1S 2E2 Tel. 905.619.2300 - 905.420.5300 Fax 905.619.2375  
Email: info@hvacdsgns.ca  
Web: www.hvacdsgns.ca  
Specializing in Residential Mechanical Design Services

Installation to comply with the latest Ontario Building Code. All supply branch outlets shall be equipped with a manual balancing damper. Ductwork which passes through the garage or unheated spaces shall be adequately insulated and be gas-proofed.

CITY OF BRAMPTON  
BUILDING DIVISION  
REVIEWED  
NOV 28 2018  
HVAC BY  
MONICA CRISAN

Sheet Title

SECOND FLOOR  
HEATING  
LAYOUT

Date

AUG/2018

Scale

3/16" = 1'-0"

BCIN# 19669

LO# 79581