

SITE NAME: MINNISALE HOMES CORP
BUILDER: GREENPARK HOMES

TYPE: MILLWOOD 12

GFA: 2642

DATE: Aug-18
LO# 79588

WINTER NATURAL AIR CHANGE RATE 0.254
SUMMER NATURAL AIR CHANGE RATE 0.115

HEAT LOSS AT °F.	74
HEAT GAIN AT °F.	11

CSA-F280-12
12 PACKAGE A.1

ROOM USE		MBR		ENS		WIC		BED-2		BED-3		BED-4		BATH		ENS-2	
EXP. WALL		37		24		9		27		34		17		9		8	
CLG. HT.		9		9		9		9		9		9		9		9	
FACTORS																	
GRS.WALL AREA		333		216		81		243		308		183		81		72	
GLAZING		LOSS GAIN		LOSS GAIN		LOSS GAIN		LOSS GAIN		LOSS GAIN		LOSS GAIN		LOSS GAIN		LOSS GAIN	
NORTH		20.8	15.5	0	0	0	0	0	0	0	0	0	0	0	0	0	0
EAST		20.8	41.0	0	0	0	0	0	0	0	24	499	985	0	0	0	0
SOUTH		20.8	24.4	33	686	805	0	0	0	0	21	436	512	33	686	805	11 229 268
WEST		20.8	41.0	24	499	985	16	332	657	0	0	0	0	0	0	0	0
SKYLT.		26.4	100.7	0	0	0	0	0	0	0	0	0	0	0	0	0	0
DOORS		24.7	3.7	0	0	0	0	0	0	0	0	0	0	0	0	0	0
NET EXPOSED WALL		4.4	0.6	276	1203	178	200	871	129	81	353	62	243	1069	157	261	1137
NET EXPOSED BMT WALL ABOVE GR		3.5	0.5	0	0	0	0	0	0	0	0	0	0	0	0	0	0
EXPOSED CLG		1.3	0.6	284	356	158	144	180	80	108	135	60	166	208	93	157	197
NO ATTIC EXPOSED CLG		2.7	1.2	36	97	43	0	0	0	0	0	0	28	75	33	36	97
EXPOSED FLOOR		2.5	0.4	0	0	0	0	0	0	0	0	0	16	40	8	24	60
BASEMENT/CRAWL HEAT LOSS				0		0		0		0		0		0		0	
SLAB ON GRADE HEAT LOSS				0		0		0		0		0		0		0	
SUBTOTAL HT LOSS				2839		1384		485		1680		2384		1630		691	
SUB TOTAL HT GAIN					2170		866		113		311		1793		1008		384
LEVEL FACTOR / MULTIPLIER		0.20	0.26			0.20	0.26			0.20	0.26			0.20	0.26		
AIR CHANGE HEAT LOSS				742		362		128		439		623		400		181	
AIR CHANGE HEAT GAIN					133		53		7		19		110		62		23
DUCT LOSS				0		0		0		212		301		193		0	
DUCT GAIN				0		0		0		152		309		226		0	
HEAT GAIN PEOPLE		240		2	480	0	0	0	0	1	240	1	240	1	240	0	0
HEAT GAIN APPLIANCES/LIGHTS					947		0		0	2769		947		947		0	
TOTAL HT LOSS BTU/H				3581		1746		616		2331		3307		2123		872	
TOTAL HT GAIN x 1.3 BTU/H					4848		1195		155		2168		4417		3226		629

CITY OF BRAMPTON
BUILDING DIVISION
REVIEWED BY: S. DESAI

NOV 28 2018

ATTACHED NOTES ARE PART

ROOM USE	LVIDN					KT/FM					LAUN					WIR					FOY					MUD					WOOD					BAS														
EXP. WALL	66					69					9					13					11					13					38					166														
CLG. HT.	10					10					9					10					10					10					9					9														
FACTORS	
GRS.WALL AREA	LOSS		GAIN		680					690					81					130					110					130					324					1212										
GLAZING	LOSS		GAIN		LOSS					GAIN					LOSS					GAIN					LOSS					GAIN					LOSS					GAIN										
NORTH	20.8	15.5	0	0	0	0					0					0					0					0					0					0					0									
EAST	20.8	41.0	42	873	1724	0					0					0					0					0					0					0					0									
SOUTH	20.8	24.4	66	1371	1610	30					623					732					0					6					125					146					0									
WEST	20.8	41.0	0	0	0	88					1828					3612					0					0					0					0					0									
SKYL.T.	36.4	100.7	0	0	0	0					0					0					0					0					0					0					0									
DOORS	24.7	3.7	0	0	0	0					0					0					0					40					986					146					20									
NET EXPOSED WALL	4.4	0.6	552	2405	357	572					2492					309					81					253					52					130					566					84				
NET EXPOSED BASMT WALL ABOVE GR	3.5	0.5	0	0	0	0					0					0					0					0					0					0					0					0				
EXPOSED CLG	1.3	0.8	0	0	0	0					0					0					153					192					86					0					0					0				
NO ATTIC EXPOSED CLG	2.7	1.2	0	0	0	10					27					12					0					0					0					0					0					0				
EXPOSED FLOOR	2.5	0.4	0	0	0	0					0					0					68					169					25					0					0					0				
BASEMENT/CRAWL HEAT LOSS	0					0					0					0					0					0					0					0					0									
SLAB ON GRADE HEAT LOSS	0					0					0					0					0					0					0					0					0									
SUBTOTAL HT LOSS	4649					4971					714					566					1390					972					862					7341														
SUB TOTAL HT GAIN	3691					4725					163					84					334					144					356					36														
LEVEL FACTOR / MULTIPLIER	0.30	0.40				0.30	0.40				0.20	0.26				0.30	0.40				0.30	0.40				0.50	1.01																							
AIR CHANGE HEAT LOSS	1841					1968					186					224					550					385					8282																			
AIR CHANGE HEAT GAIN	226					289					10					5					20					9					4																			
DUCT LOSS	0					0					90					0					0					0					0																			
DUCT GAIN	0					0					112					0					0					0					0																			
HEAT GAIN PEOPLE	260	0	0	0			0	0	0			0	0	0			0	0	0			0	0	0			0	0	0																					
HEAT GAIN APPLIANCES/LIGHTS	947					947					947					0					0					0					0																			
TOTAL HT LOSS BTU/H	6490					6939					990					791					1940					1367					862					16623														
TOTAL HT GAIN x 1.3 BTU/H	6322					7750					1650					116					461					189					467																			

TOTAL HEAT GAIN BTU/H:

34805

TONS: 2.90

LOSS DUE TO VENTILATION LOAD BTUH: 1593

STRUCTURAL HEAT LOSS: 50914

TOTAL COMBINED HEAT LOSS BTU/H: 5250

SITE NAME: MINNISSALE HOMES CORP
BUILDER: GREENPARK HOMES

TYPE: MILLWOOD 12

DATE: Aug-18

GFA: 2642 LO# 79598

HEATING CFM 1131
TOTAL HEAT LOSS 50,914
AIR FLOW RATE CFM 22.21COOLING CFM 1131
TOTAL HEAT GAIN 34,569
AIR FLOW RATE CFM 32.72furnace pressure 0.6
furnace filter 0.05
a/c coil pressure 0.2
available pressure for s/a & r/a 0.35plenium pressure s/a 0.18
max s/a dif press. loss 0.02
min adjusted pressure s/a 0.16r/a pressure 0.17
r/a grille press. Loss 0.02
adjusted pressure r/a 0.15#GOODMAN
GMCC960603BNA 60
FAN SPEED LOW
MEDLOW
MEDIUM
MEDIUM HIGHAFUE = 96 %
INPUT (BTU/H) = 60,000
OUTPUT (BTU/H) = 57,600DESIGN CFM = 1131
CFM @ 8" E.S.P.

TEMPERATURE RISE 47 °F

RUN COUNT	4th	3rd	2nd	1st	Bas
S/A	0	0	11	8	4
R/A	0	0	4	2	1

All S/A diffusers 4"x10" unless noted otherwise on layout.
All S/A runs 5"Ø unless noted otherwise on layout.

RUN #	1	2	3	4	5	6	7	8	10	11	12	13	14	15	16	17	18	19	20	21	22	23	24
ROOM NAME	MBR	ENS	WC	BED-2	BED-3	BED-4	BATH	BED-3	MBR	ENS-2	LV/DN	LV/DN	KT/FM	KT/FM	KT/FM	LAUN	WR	FOY	MUD	BAS	BAS	BAS	BAS
RM LOSS MBH	1.79	1.75	0.62	2.33	1.65	2.12	0.87	1.65	1.79	1.35	3.24	3.24	2.31	2.31	2.31	0.99	0.79	1.94	1.36	4.12	4.12	4.12	4.12
CFM PER RUN HEAT	40	39	14	52	37	47	19	37	40	30	72	72	51	51	51	22	18	43	30	92	92	92	92
RM GAIN MBH	2.42	1.20	0.16	2.17	2.21	3.23	0.53	2.21	2.42	0.59	3.16	3.16	2.58	2.58	2.58	1.60	0.12	0.46	0.20	0.25	0.25	0.25	0.25
CFM PER RUN COOLING	79	39	5	71	72	108	17	72	79	19	103	103	85	85	85	52	4	15	7	8	8	8	8
ADJUSTED PRESSURE	0.17	0.17	0.17	0.17	0.17	0.16	0.17	0.17	0.17	0.17	0.16	0.16	0.16	0.16	0.16	0.17	0.17	0.17	0.17	0.16	0.16	0.16	0.16
ACTUAL DUCT LGH	46	32	15	77	82	73	45	78	38	74	42	60	16	31	45	69	13	25	11	29	13	45	52
EQUIVALENT LENGTH	150	120	190	170	160	150	200	170	140	170	150	160	190	150	190	180	140	140	170	190	140	190	170
TOTAL EFFECTIVE LENGTH	196	152	205	247	242	223	245	248	178	244	192	220	206	181	235	249	153	165	181	219	153	235	222
ADJUSTED PRESSURE	0.09	0.11	0.08	0.07	0.07	0.07	0.07	0.07	0.1	0.07	0.08	0.07	0.08	0.09	0.07	0.07	0.11	0.1	0.1	0.07	0.11	0.07	0.07
ROUND DUCT SIZE	5	4	4	6	6	6	4	6	5	4	6	6	6	6	6	5	4	4	4	6	6	6	6
HEATING VELOCITY (ft/min)	294	447	181	265	189	240	218	189	294	344	367	367	260	260	260	162	207	493	344	469	469	469	469
COOLING VELOCITY (ft/min)	580	447	57	362	367	540	195	367	580	218	525	525	433	433	433	382	46	172	80	41	41	41	41
OUTLET GRILL SIZE	3X10	3X10	3X10	4X10	4X10	4X10	3X10	4X10	3X10	3X10	4X10	4X10	4X10	4X10	4X10	3X10	3X10	3X10	3X10	4X10	4X10	4X10	4X10
TRUNK	C	D	C	B	A	B	B	A	C	B	B	A	C	C	C	B	D	C	C	C	D	B	A

RUN #
ROOM NAME
RM LOSS MBH
CFM PER RUN HEAT
RM GAIN MBH
CFM PER RUN COOLING
ADJUSTED PRESSURE
ACTUAL DUCT LGH
EQUIVALENT LENGTH
TOTAL EFFECTIVE LENGTH
ADJUSTED PRESSURE
ROUND DUCT SIZE
HEATING VELOCITY (ft/min)
COOLING VELOCITY (ft/min)
OUTLET GRILL SIZE
TRUNK

SUPPLY AIR TRUNK SIZE

	TRUNK CFM	STATIC PRESS.	ROUND DUCT	RECT DUCT	VELOCITY (ft/min)
TRUNK A	238	0.07	8.5	10	8
TRUNK B	572	0.07	11.8	18	8
TRUNK C	984	0.07	14.4	26	8
TRUNK D	149	0.11	6.3	6	8
TRUNK E	0	0.00	0	0	8
TRUNK F	0	0.00	0	0	8

RETURN AIR TRUNK SIZE

	TRUNK CFM	STATIC PRESS.	ROUND DUCT	RECT DUCT	VELOCITY (ft/min)
TRUNK G	0	0.00	0	0	8
TRUNK H	0	0.00	0	0	8
TRUNK I	0	0.00	0	0	8
TRUNK J	0	0.00	0	0	8
TRUNK K	0	0.00	0	0	8
TRUNK L	0	0.00	0	0	8
TRUNK M	0	0.05	0	0	8
TRUNK N	0	0.05	0	0	8
TRUNK O	0	0.05	0	0	8
TRUNK P	0	0.05	0	0	8
TRUNK Q	0	0.05	0	0	8
TRUNK R	0	0.05	0	0	8
TRUNK S	0	0.05	0	0	8
TRUNK T	0	0.05	0	0	8
TRUNK U	0	0.05	0	0	8
TRUNK V	0	0.05	0	0	8
TRUNK W	0	0.05	0	0	8
TRUNK X	1131	0.05	16.5	26	10
TRUNK Y	440	0.05	11.6	16	8
TRUNK Z	0	0.05	0	0	8
DROP	1131	0.05	16.5	24	10

RETURN AIR

	1	2	3	4	5	6	7	8	9	10	11	12	13	14	15	16	17	18	19	20	21	22	23	24
AIR VOLUME	0	0	0	0	0	0	0	0	0	0	0	0	0	0	0	0	0	0	0	0	0	0	0	0
PLENUM PRESSURE	0.15	0.15	0.15	0.15	0.15	0.15	0.15	0.15	0.15	0.15	0.15	0.15	0.15	0.15	0.15	0.15	0.15	0.15	0.15	0.15	0.15	0.15	0.15	0.15
ACTUAL DUCT LGH	20	52	82	78	24	47	1	1	1	1	1	1	1	1	1	1	1	1	1	1	1	1	1	1
EQUIVALENT LENGTH	165	195	235	240	205	235	0	0	0	0	0	0	0	0	0	0	0	0	0	0	0	0	0	0
TOTAL EFFECTIVE LH	185	247	317	318	229	282	1	1	1	1	1	1	1	1	1	1	1	1	1	1	1	1	1	1
ADJUSTED PRESSURE	0.08	0.06	0.05	0.05	0.06	0.05	14.80	14.80	14.80	14.80	14.80	14.80	14.80	14.80	14.80	14.80	14.80	14.80	14.80	14.80	14.80	14.80	14.80	14.80
ROUND DUCT SIZE	7.3	7.5	6	6	10	7.5	0	0	0	0	0	0	0	0	0	0	0	0	0	0	0	0	0	0
INLET GRILL SIZE	8	8	8	8	8	8	0	0	0	0	0	0	0	0	0	0	0	0	0	0	0	0	0	0
INLET GRILL SIZE	X	X	X	X	X	X	X	X	X	X	X	X	X	X	X	X	X	X	X	X	X	X	X	X
INLET GRILL SIZE	14	14	14	14	30	14	0	0	0	0	0	0	0	0	0	0	0	0	0	0	0	0	0	0

CITY OF BRAMPTON
BUILDING DIVISION
REVIEWED BY: S. DESAI
NOV 28 2018
NOTES ARE PART
OF REVIEWED DRAWINGS
ALL WORK MUST COMPLY WITH OBC

TYPE: MILLWOOD 12
SITE NAME: MINNISSALE HOMES CORP

LO # 79588

RESIDENTIAL MECHANICAL VENTILATION DESIGN SUMMARY

COMBUSTION APPLIANCES		9.32.3.1(1)
a)	☒ Direct vent (sealed combustion) only	
b)	☐ Positive venting induced draft (except fireplaces)	
c)	☐ Natural draft, B-vent or induced draft gas fireplace	
d)	☐ Solid Fuel (including fireplaces)	
e)	☐ No Combustion Appliances	

HEATING SYSTEM	
☒ Forced Air	☐ Non Forced Air
☐ Electric Space Heat	

HOUSE TYPE		9.32.1(2)
☒ I	Type a) or b) appliance only, no solid fuel	
☐ II	Type I except with solid fuel (including fireplaces)	
☐ III	Any Type c) appliance	
☐ IV	Type I, or II with electric space heat	
☐	Other: Type I, II or IV no forced air	

SYSTEM DESIGN OPTIONS		O.N.H.W.P.
☐ 1	Exhaust only/Forced Air System	
☐ 2	HRV with Ducting/Forced Air System	
☒ 3	HRV Simplified/connected to forced air system	
☐ 4	HRV with Ducting/non forced air system	
☐	Part 6 Design	

TOTAL VENTILATION CAPACITY		9.32.3.3(1)
Basement + Master Bedroom	2 @ 21.2 cfm	42.4 cfm
Other Bedrooms	3 @ 10.6 cfm	31.8 cfm
Kitchen & Bathrooms	5 @ 10.6 cfm	53 cfm
Other Rooms	4 @ 10.6 cfm	42.4 cfm
Table 9.32.3.A.	TOTAL	169.6 cfm

PRINCIPAL VENTILATION CAPACITY REQUIRED		9.32.3.4(1)
1 Bedroom	31.8	cfm
2 Bedroom	47.7	cfm
3 Bedroom	63.6	cfm
4 Bedroom	79.5	cfm
5 Bedroom	95.4	cfm
TOTAL		79.5 cfm

SUPPLEMENTAL VENTILATION CAPACITY		9.32.3.5.
Total Ventilation Capacity	169.6	cfm
Less Principal Ventil. Capacity	79.5	cfm
Required Supplemental Capacity	90.1	cfm

PRINCIPAL EXHAUST FAN CAPACITY	
Model: VANEE 65H	Location: BSMT
79.5 cfm	3.0 sones
☒ HVI Approved	

PRINCIPAL EXHAUST HEAT LOSS CALCULATION				
CFM	ΔT °F	FACTOR	% LOSS	
79.5 CFM	74 F	1.08	X	0.25

SUPPLEMENTAL FANS		PANASONIC		
Location	Model	cfm	HVI	Sones
ENS	FV-05-11VK1	50	✓	0.3
BATH	FV-05-11VK1	50	✓	0.3
ENS-2	FV-05-11VK1	50	✓	0.3
WIR	FV-05-11VK1	50	✓	0.3

HEAT RECOVERY VENTILATOR		9.32.3.11.
Model: VANEE 65H		
155	cfm high	64 cfm low
75	% Sensible Efficiency	☒ HVI Approved
@ 32 deg F (0 deg C)		

LOCATION OF INSTALLATION	
Lot:	Concession
Township:	Plan:
Address:	
Roll #	Building Permit #

BUILDER:	
GREENPARK HOMES	
Name:	

Address:	
City:	
Telephone #:	Fax #:

INSTALLING CONTRACTOR	
Name:	
Address:	
City:	
Telephone #:	Fax #:

DESIGNER CERTIFICATION	
I hereby certify that this ventilation system has been designed in accordance with the Ontario Building Code.	
Name:	HVAC Designs Ltd.
Signature:	<i>Michael O'Rourke</i>
HRAI #	001820
Date:	August-18

I REVIEW AND TAKE RESPONSIBILITY FOR THE DESIGN WORK AND AM QUALIFIED IN THE APPROPRIATE CATEGORY AS AN "OTHER DESIGNER" UNDER DIVISION C, 3.2.4 OF THE BUILDING CODE.
INDIVIDUAL BCIN: 19669 MICHAEL O'ROURKE

CITY OF BRAMPTON
BUILDING DIVISION
REVIEWED BY: S. DESAI
NOV 28 2018

ATTACHED NOTES ARE PART
OF REVIEWED DRAWINGS
ALL WORK MUST COMPLY WITH OBC

CSA F280-12 Residential Heat Loss and Heat Gain Calculations
Formula Sheet (For Air Leakage / Ventilation Calculation)

LO#: 79588

Model: MILLWOOD 12

Builder: GREENPARK HOMES

Date: 8/9/2018

Volume Calculation
House Volume

Level	Floor Area (ft ²)	Floor Height (ft)	Volume (ft ³)
Bsmt	1144	9	10296
First	1144	10	11440
Second	1498	9	13482
Third	0	9	0
Fourth	0	9	0
Total:			35,218.0 ft ³
Total:			997.3 m ³

Air Change & Delta T Data

WINTER NATURAL AIR CHANGE RATE	0.354
SUMMER NATURAL AIR CHANGE RATE	0.115

Design Temperature Difference

	Tin °C	Tout °C	ΔT °C	ΔT °F
Winter DTDh	22	-19	41	74
Summer DTDc	24	30	6	11

5.2.3.1 Heat Loss due to Air Leakage

$$HL_{airb} = LR_{airh} \times \frac{V_b}{3.6} \times DTD_h \times 1.2$$

$$0.354 \times 277.02 \times 41^\circ\text{C} \times 1.2 = 4854 \text{ W}$$

$$= 16563 \text{ Btu/h}$$

6.2.6 Sensible Gain due to Air Leakage

$$HG_{salb} = LR_{airc} \times \frac{V_b}{3.6} \times DTD_c \times 1.2$$

$$= 0.115 \times 277.02 \times 6^\circ\text{C} \times 1.2 = 234 \text{ W}$$

$$= 798 \text{ Btu/h}$$

5.2.3.2 Heat Loss due to Mechanical Ventilation

$$HL_{valrb} = PVC \times DTD_h \times 1.08 \times (1 - E)$$

$$80 \text{ CFM} \times 74^\circ\text{F} \times 1.08 \times 0.25 = 1593 \text{ Btu/h}$$

6.2.7 Sensible heat Gain due to Ventilation

$$HL_{valrb} = PVC \times DTD_h \times 1.08 \times (1 - E)$$

$$80 \text{ CFM} \times 11^\circ\text{F} \times 1.08 \times 0.25 = 236 \text{ Btu/h}$$

5.2.3.3 Calculation of Air Change Heat Loss for Each Room (Floor Multiplier Section)

$$HL_{airr} = \text{Level Factor} \times HL_{airbv} \times \{(HL_{agcr} + HL_{bgcr}) + (HL_{agcleve} + HL_{bgcleve})\}$$

Level	Level Factor (LF)	HLairbv Air Leakage + Ventilation Heat Loss (Btu/h)	Level Conductive Heat Loss: (HL _{level})	Air Leakage Heat Loss Multiplier (LF x HLairbv / HL _{level})
1	0.5	16,563	8,203	1.010
2	0.3		12,548	0.396
3	0.2		12,682	0.261
4	0		0	0.000
5	0		0	0.000

*HLairbv = Air leakage heat loss + ventilation heat loss

*For a balanced or supply only ventilation system HLairve = 0

CITY OF BRAMPTON
BUILDING DIVISION
REVIEWED BY: S. DESAI
NOV 28 2018
ATTACHED NOTES ARE PART
OF REVIEWED DRAWINGS
ALL WORK MUST COMPLY WITH OBC

HEAT LOSS AND GAIN SUMMARY SHEET

MODEL: MILLWOOD 12

BUILDER: GREENPARK HOMES

SFQT: 2642

LO# 79588

SITE: MINNISSALE HOMES CORP

DESIGN ASSUMPTIONS

HEATING	°F	COOLING	°F
OUTDOOR DESIGN TEMP.	-2	OUTDOOR DESIGN TEMP.	86
INDOOR DESIGN TEMP.	72	INDOOR DESIGN TEMP. (MAX 75°F)	75

BUILDING DATA

ATTACHMENT:	DETACHED	# OF STORIES (+BASEMENT):	3
FRONT FACES:	EAST	ASSUMED (Y/N):	Y
AIR CHANGES PER HOUR:	3.57	ASSUMED (Y/N):	Y
AIR TIGHTNESS CATEGORY:	AVERAGE	ASSUMED (Y/N):	Y
WIND EXPOSURE:	SHELTERED	ASSUMED (Y/N):	Y
HOUSE VOLUME (ft³):	35218.0	ASSUMED (Y/N):	Y
INTERNAL SHADING:	BLINDS/CURTAINS	ASSUMED OCCUPANTS:	5
INTERIOR LIGHTING LOAD (Btu/h/ft²):	1.75	DC BRUSHLESS MOTOR (Y/N):	Y
FOUNDATION CONFIGURATION	BCIN_1	DEPTH BELOW GRADE:	6.0 ft
LENGTH: 51.0 ft	WIDTH: 32.0 ft	EXPOSED PERIMETER:	166.0 ft

2012 OBC - COMPLIANCE PACKAGE

Component


Ceiling with Attic Space Minimum RSI (R)-Value
Ceiling Without Attic Space Minimum RSI (R)-Value
Exposed Floor Minimum RSI (R)-Value
Walls Above Grade Minimum RSI (R)-Value
Basement Walls Minimum RSI (R)-Value
Below Grade Slab Entire surface > 600 mm below grade Minimum RSI (R)-Value
Edge of Below Grade Slab ≤ 600 mm Below Grade Minimum RSI (R)-Value
Heated Slab or Slab ≤ 600 mm below grade Minimum RSI (R)-Value
Windows and Sliding Glass Doors Maximum U-Value
Skylights Maximum U-Value
Space Heating Equipment Minimum AFUE
HRV Minimum Efficiency
Domestic Hot Water Heater Minimum EF

ALL WORK MUST COMPLY WITH OBC
 ATTACHED NOTES ARE PART
 OF REVIEWED DRAWINGS
 NOV 28 2018
 REVIEWED BY: S. DESAI
 BUILDING DIVISION
 CITY OF BRAMPTON

Compliance Package A1


Nominal	Min. Eff.
60	59.22
31	27.65
31	29.80
22	17.03
20 cl	21.12
-	-
10	10
10	11.13
0.28	-
0.49	-
0.96	-
75%	-
0.8	-

INDIVIDUAL BCIN: 19669
MICHAEL O'ROURKE

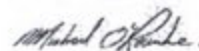

Residential Foundation Thermal Load Calculator

Supplemental tool for CAN/CSA-F280

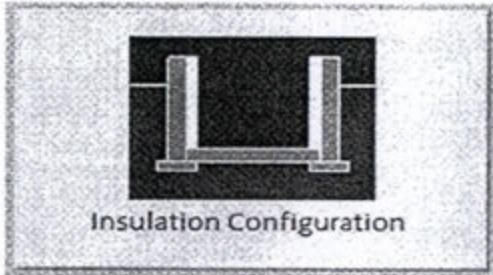Weather Station Description		
Province:	Ontario	
Region:	Brampton	
Site Description		
Soil Conductivity:	Normal conductivity: dry sand, loam, clay	
Water Table:	Normal (7-10 m, 23-33 ft)	
Foundation Dimensions		
Floor Length (m):	15.5	 Insulation Configuration
Floor Width (m):	9.8	
Exposed Perimeter (m):	0.0	
Wall Height (m):	2.7	
Depth Below Grade (m):	1.83	
Window Area (m ²):	1.1	
Door Area (m ²):	1.9	
Radiant Slab		
Heated Fraction of the Slab:	0	
Fluid Temperature (°C):	33	
Design Months		
Heating Month	1	
Foundation Loads		
Heating Load (Watts):	1680	

CITY OF BRAMPTON
BUILDING DIVISION
REVIEWED BY: S. DESAI
NOV 28 2018
ATTACHED NOTES ARE PART
OF REVIEWED DRAWINGS
ALL WORK MUST COMPLY WITH OAC

TYPE: MILLWOOD 12
LO# 79588

Air Infiltration Residential Load Calculator

Supplemental tool for CAN/CSA-F280

Weather Station Description				
Province:	Ontario			
Region:	Brampton			
Weather Station Location:	Open flat terrain, grass			
Anemometer height (m):	10			
Local Shielding				
Building Site:	Suburban, forest			
Walls:	Heavy			
Flue:	Heavy			
Highest Ceiling Height (m):	7.62			
Building Configuration				
Type:	Detached			
Number of Stories:	Two			
Foundation:	Full			
House Volume (m ³):	997.3			
Air Leakage/Ventilation				
Air Tightness Type:	Present (1961-) (3.57 ACH)			
Custom BDT Data:	ELA @ 10 Pa.	1329.4 cm ²		
	3.57	ACH @ 50 Pa		
Mechanical Ventilation (L/s):	Total Supply	Total Exhaust		
	37.5	37.5		
Flue Size				
Flue #:	#1	#2	#3	#4
Diameter (mm):	0	0	0	0
Natural Infiltration Rates				
Heating Air Leakage Rate (ACH/H):	0.354			
Cooling Air Leakage Rate (ACH/H):	0.115			

TYPE: MILLWOOD 12
LO# 79588CITY OF BRAMPTON
BUILDING DIVISION
REVIEWED BY: S. DESAI

NOV 28 2018

ATTACHED NOTES ARE PART
OF REVIEWED DRAWINGS
ALL WORK MUST COMPLY WITH OBC

INSTALLATION OF KITCHEN EXHAUST DUCT LARGER THAN 6" dia SHALL BE PRECEDED BY APPLICATION FOR REVISION OF DESIGN PER OBC PART 6 REQUIREMENTS. EXHAUST FAN SHALL DISCHARGE DIRECTLY TO OUTSIDE. CLOTHES DRYER EXHAUST SYSTEM SHALL COMPLY WITH OBC DIV B 9.32.1.2, 9.32.1.3 & 9.32.3 REQ'S. BALANCE THE RETURN AIRFLOW ON THE UPPER FLOOR TO MATCH THE SUPPLY. WHEN HRV IS USED AS PRINCIPAL EXHAUST FAN, THE CONTROLLER SHALL BE WIRED TO THE HRV UNIT AND INTERCONNECTED TO THE FURNACE FAN. THE FURNACE BLOWER MUST BE IN OPERATION WHEN THE HRV IS IN OPERATION. INSTALL ADDITIONAL S/A REGISTER AS REQUIRED IN ORDER TO ENSURE MIN 72degF - OBC DIV B 9.33.3.1(1). UNDERCUT BY MIN 1" THE DOOR TO ANY ROOM WITHOUT RETURN AIR GRILLE. ENSURE RETURN AIR INTAKE SHALL BE CONNECTED TO THE MAIN R/A DUCT AT A HORIZONTAL DISTANCE OF MIN 6FT FROM THE CASING OF THE UNIT (HRAI DIGEST).

ENSURE THAT MIN THERMAL PERFORMANCE OF BLOG ENVELOPE AND EQUIPMENT SHALL CONFORM TO OBC SB-12, 3.1.1.2 TABLES REQUIREMENTS. FURNACE SHALL BE EQUIPPED WITH BRUSHLESS DIRECT CURRENT MOTOR OBC DIV B 12.3.1.5. SEAL ALL DUCTWORK WITHIN UNCONDITIONED SPACE or OUTDOORS PER OBC DIV B6.2.4.3(11) REQUIREMENTS. SEAL ALL SUPPLY DUCTS LOCATED IN CONDITIONED SPACE IN COMPLIANCE WITH OBC DIV B6.2.4.3(12) REQUIREMENTS. SEPARATE ANY INTAKES FROM BUILDING ENVELOPE PENETRATIONS THAT ARE POTENTIAL SOURCES OF CONTAMINANTS (GAS VENTS, OIL FILL PIPES, etc. BY MIN 900mm (2FT 11IN) - OBC Div B 9.32.3.12.

INSTALLATION OF HVAC EQUIP. SHALL CONFORM TO MANUFACTURER'S SPECIFICATIONS AND MANUALS

THE INSTALLATION OF CARBON MONOXIDE DETECTOR(S) SHALL COMPLY WITH OBC DIV B, 9.33.4 REQUIREMENTS.

A HEAT RECOVERY VENTILATOR SHALL BE INSTALLED IN COMPLIANCE WITH OBC DIV. B, 6.2.1.6, 9.32.3.6(3), 9.32.3.11 AND HRAI DIGEST REQUIREMENTS.

CITY OF BRAMPTON
BUILDING DIVISION
REVIEWED BY: S. DESAI

NOV 28 2018

ATTACHED NOTES ARE PART
OF REVIEWED DRAWINGS
ALL WORK MUST COMPLY WITH OBC

MECHANICAL VENTILATION SHALL BE PROVIDED IN CONFORMANCE WITH OBC DIV. B, 9.32.3 REQUIREMENTS.

BASEMENT FLOOR PLAN 2

BASEMENT FLOOR PLAN 1



HVAC DESIGNS LTD.

HVAC LEGEND						3.	
SYMBOL	DESCRIPTION	SYMBOL	DESCRIPTION	SYMBOL	DESCRIPTION	SYMBOL	DESCRIPTION
	FLOOR SUPPLY AIR GRILLE		6" SUPPLY AIR BOOT ABOVE		14"x8" RETURN AIR GRILLE		RETURN AIR STACK ABOVE
	FLOOR SUPPLY AIR GRILLE 6" BOOT		SUPPLY AIR STACK FROM 2nd FLOOR		30"x8" RETURN AIR GRILLE		RETURN AIR STACK 2nd FLOOR
	SUPPLY AIR BOOT ABOVE		6" SUPPLY AIR STACK 2nd FLOOR		FRA- FLOOR RETURN AIR GRILLE		REDUCER

REVISIONS

ALL DRAWINGS, CALCULATIONS AND SPECIFICATIONS ARE THE PROPERTY OF HVAC DESIGNS LTD. AND MAY NOT BE REPRODUCED, MODIFIED OR ALTERED WITHOUT EXPRESSED WRITTEN CONSENT. THE DRAWINGS ARE DATED AND USED OF THESE DRAWINGS AFTER ONE YEAR FROM THE DATED NOTED IS NOT AUTHORIZED. CONTRACTOR SHALL CHECK ALL CONDITIONS BEFORE PROCEEDING WITH WORK. LATEST MUNICIPAL APPROVED DRAWINGS ONLY TO BE USED DURING INSTALLATION OF HEATING SYSTEM. HVAC DESIGNS LTD. IS NOT LIABLE FOR ANY CLAIMS ARISING FROM UNAUTHORIZED USE OF THE DRAWINGS OR FROM ANY CHANGES TO ACCEPTED STANDARDS AND/OR THE ONTARIO BUILDING CODE.

Client GREENPARK HOMES Project Name MINNISALE HOMES CORP BRAMPTON, ONTARIO	 375 Finlay Ave. Suite 202 - Ajax, Ontario L1S 2E2 Tel. 905.619.2300 - 905.420.5300 Fax 905.619.2375 Email: info@hvacdsgns.ca Web: www.hvacdsgns.ca Specializing in Residential Mechanical Design Services Installation to comply with the latest Ontario Building Code. All supply branch outlets shall be equipped with a manual balancing damper. Ductwork which passes through the garage or unheated spaces shall be adequately insulated and be gas-proofed.	HEAT LOSS 52507 BTU/H UNIT DATA MAKE GOODMAN MODEL GMEC960603BNA-60 INPUT 60 MBTUH OUTPUT 57.6 MBTUH COOLING 3.0 TONS FAN SPEED 1131 cfm @ 0.5" w.c.	# OF RUNS S/A R/A FANS 3RD FLOOR 2ND FLOOR 11 4 4 1ST FLOOR 8 2 2 BASEMENT 4 1 0	Sheet Title BASEMENT HEATING LAYOUT Date AUG/2018 Scale 3/16" = 1'-0" BCIN# 19669 LO# 79588

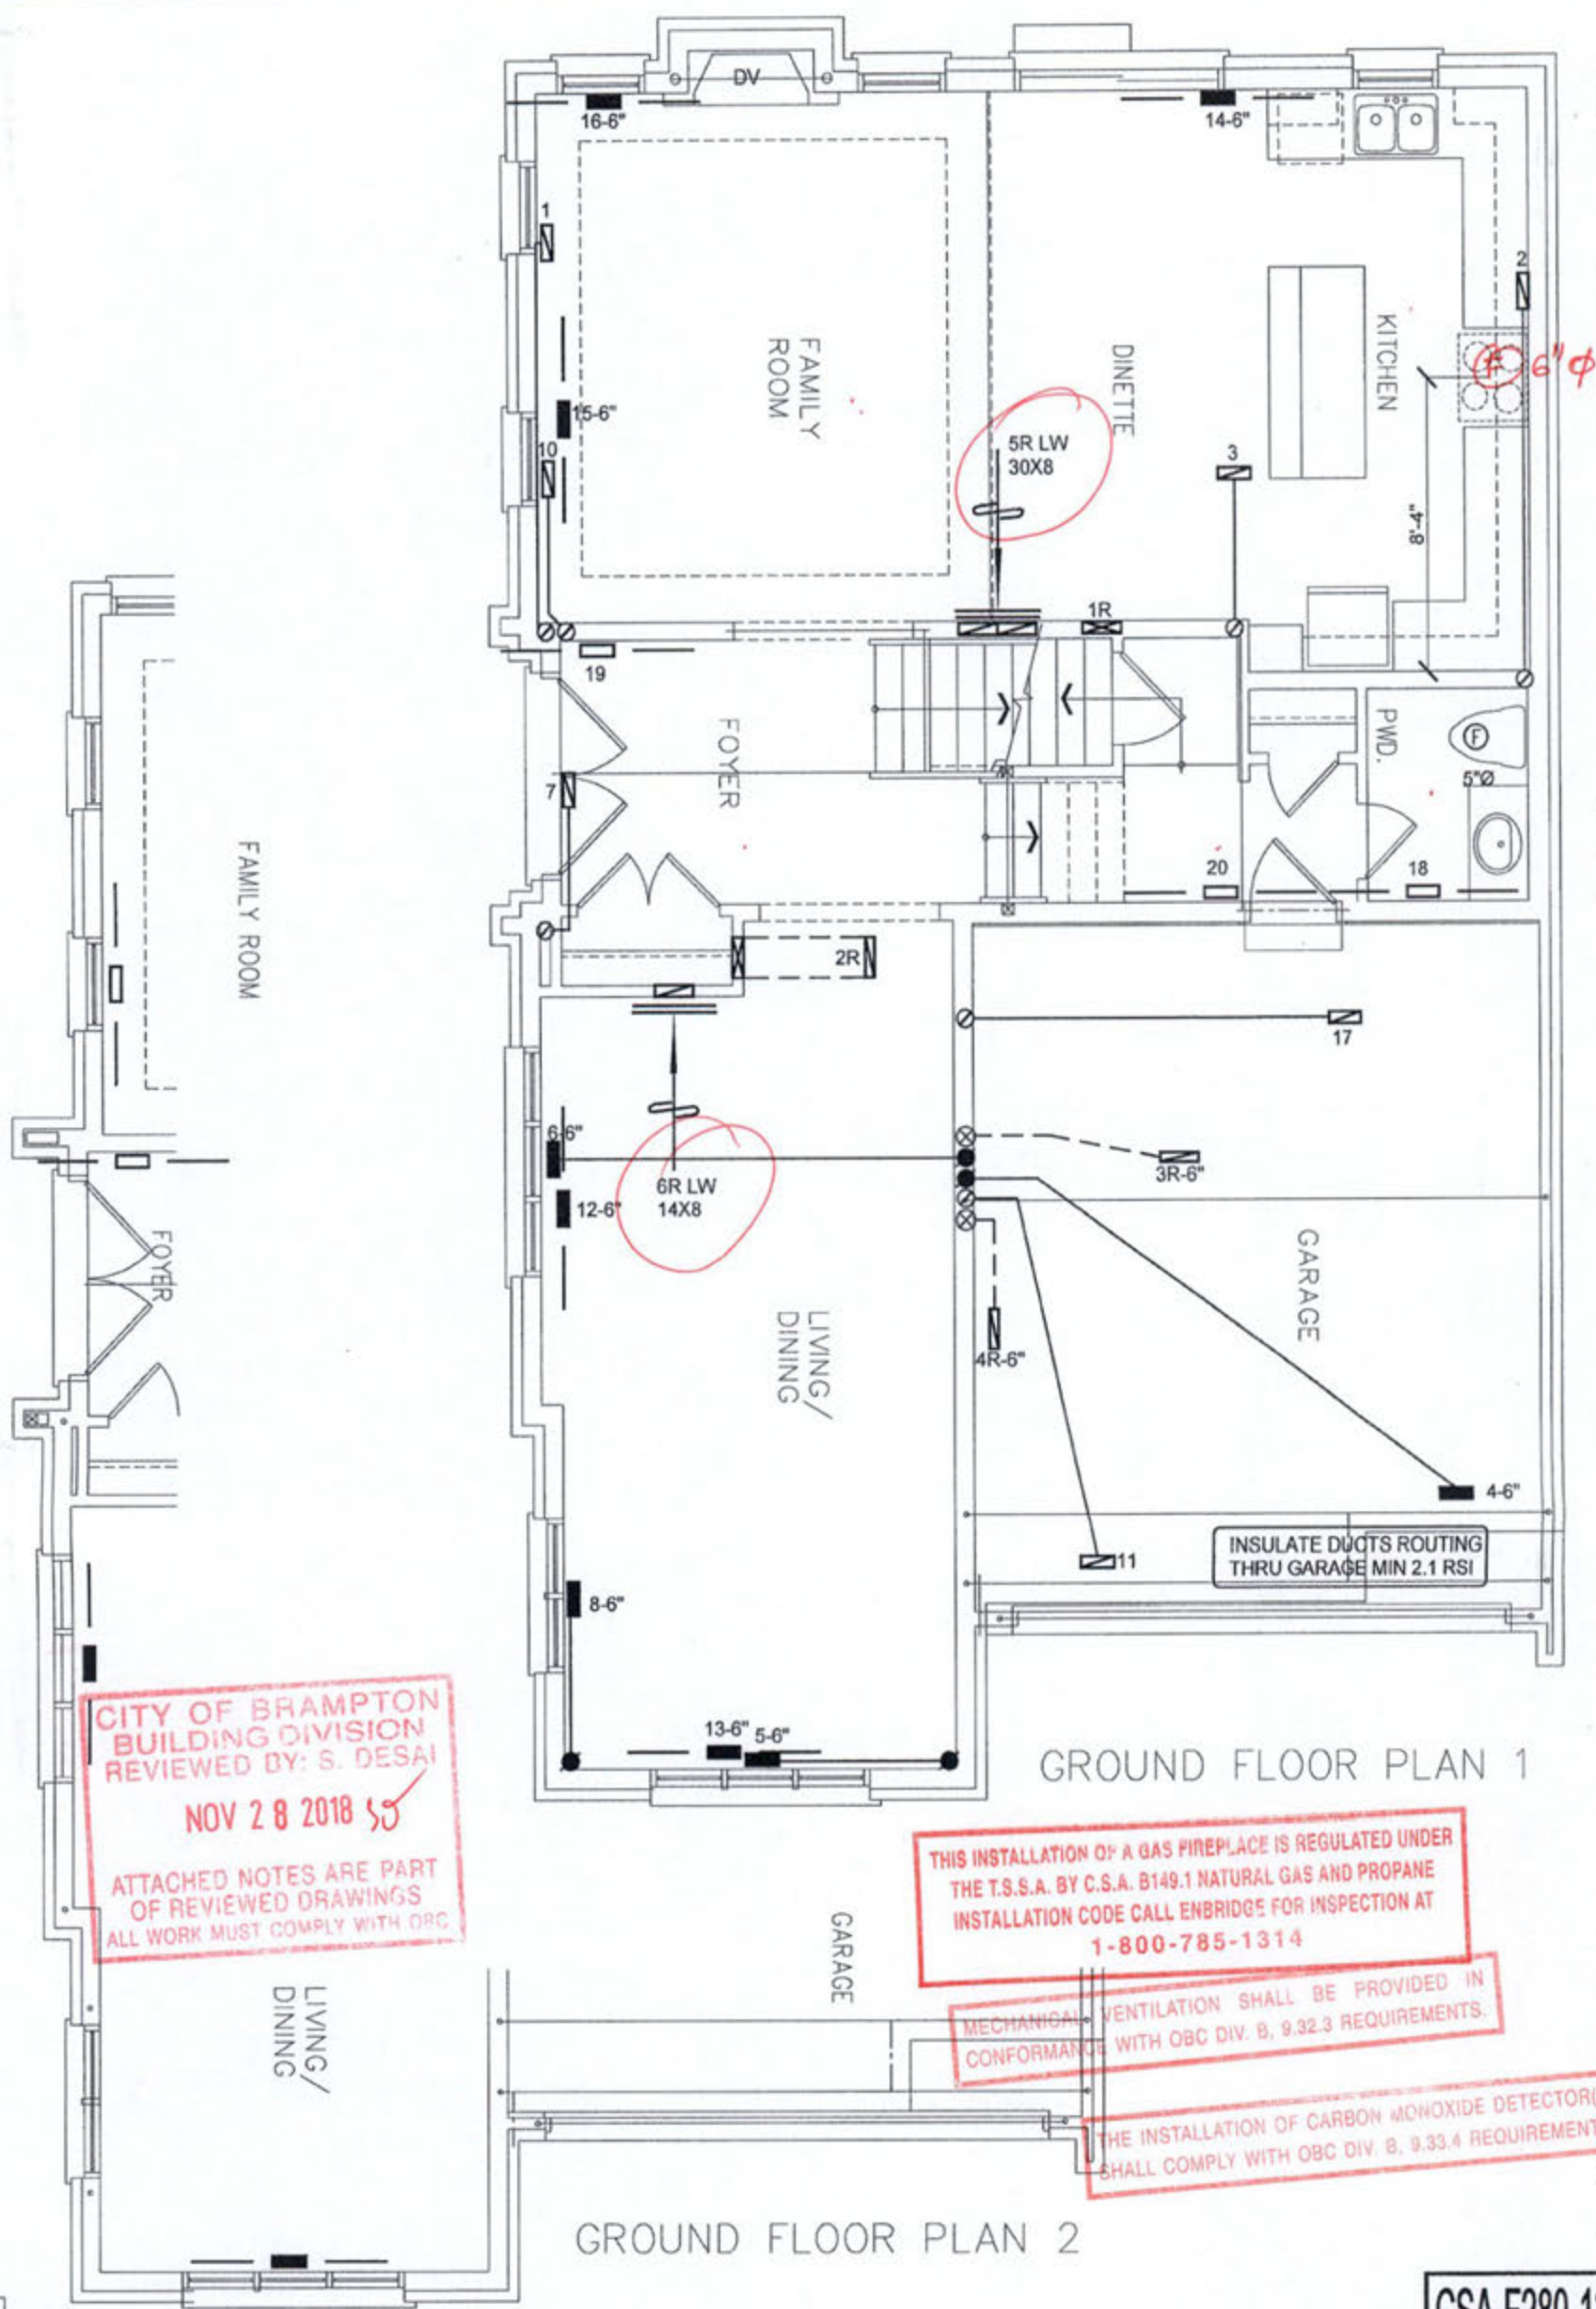


I MICHAEL O'BROUKE HAVE REVIEWED AND ACCEPTED RESPONSIBILITY FOR THE DESIGN WORK AND AM QUALIFIED UNDER DIVISION C, 3.2.5 OF THE BUILDING CODE.

CSA-F280-12
PACKAGE A1

HVAC LEGEND								REVISIONS	
SYMBOL	DESCRIPTION	SYMBOL	DESCRIPTION	SYMBOL	DESCRIPTION	SYMBOL	DESCRIPTION	No.	Date
	FLOOR SUPPLY AIR GRILLE		6" SUPPLY AIR BOOT ABOVE		14"x8" RETURN AIR GRILLE		RETURN AIR STACK ABOVE	3.	
	FLOOR SUPPLY AIR GRILLE 6" BOOT		SUPPLY AIR STACK FROM 2nd FLOOR		30"x8" RETURN AIR GRILLE		RETURN AIR STACK 2nd FLOOR	2.	
	SUPPLY AIR BOOT ABOVE		6" SUPPLY AIR STACK 2nd FLOOR		FRA- FLOOR RETURN AIR GRILLE		REDUCER	1.	

ALL DRAWINGS, CALCULATIONS AND SPECIFICATIONS ARE THE PROPERTY OF HVAC DESIGNS LTD. AND MAY NOT BE REPRODUCED, MODIFIED OR ALTERED WITHOUT EXPRESSED WRITTEN CONSENT. THE DRAWINGS ARE DATED AND USE OF THESE DRAWINGS AFTER ONE YEAR FROM THE DATED NOTED IS NOT AUTHORIZED. CONTRACTOR SHALL CHECK ALL CONDITIONS BEFORE PROCEEDING WITH WORK. LATEST MUNICIPAL APPROVED DRAWINGS ONLY TO BE USED DURING INSTALLATION OF HEATING SYSTEM. HVAC DESIGNS LTD. IS NOT LIABLE FOR ANY CLAIMS ARISING FROM UNAUTHORIZED USE OF THE DRAWINGS OR FROM ANY CHANGES TO ACCEPTED STANDARDS AND/OR THE ONTARIO BUILDING CODE.

GREENPARK HOMES Project Name MINNISALE HOMES CORP BRAMPTON, ONTARIO	HVAC DESIGNS LTD. 375 Finley Ave. Suite 202 - Ajax, Ontario L1S 2E2 Tel. 905.619.2300 - 905.420.5300 Fax 905.619.2375 Email: info@hvacdesigns.ca Web: www.hvacdesigns.ca Specializing in Residential Mechanical Design Services Installation to comply with the latest Ontario Building Code. All supply branch outlets shall be equipped with a manual balancing damper. Ductwork which passes through the garage or unheated spaces shall be adequately insulated and be gas-proofed.	Sheet Title FIRST FLOOR HEATING LAYOUT Date AUG/2018 Scale 3/16" = 1'-0" BCIN# 19669 LO# 79588
---	--	--

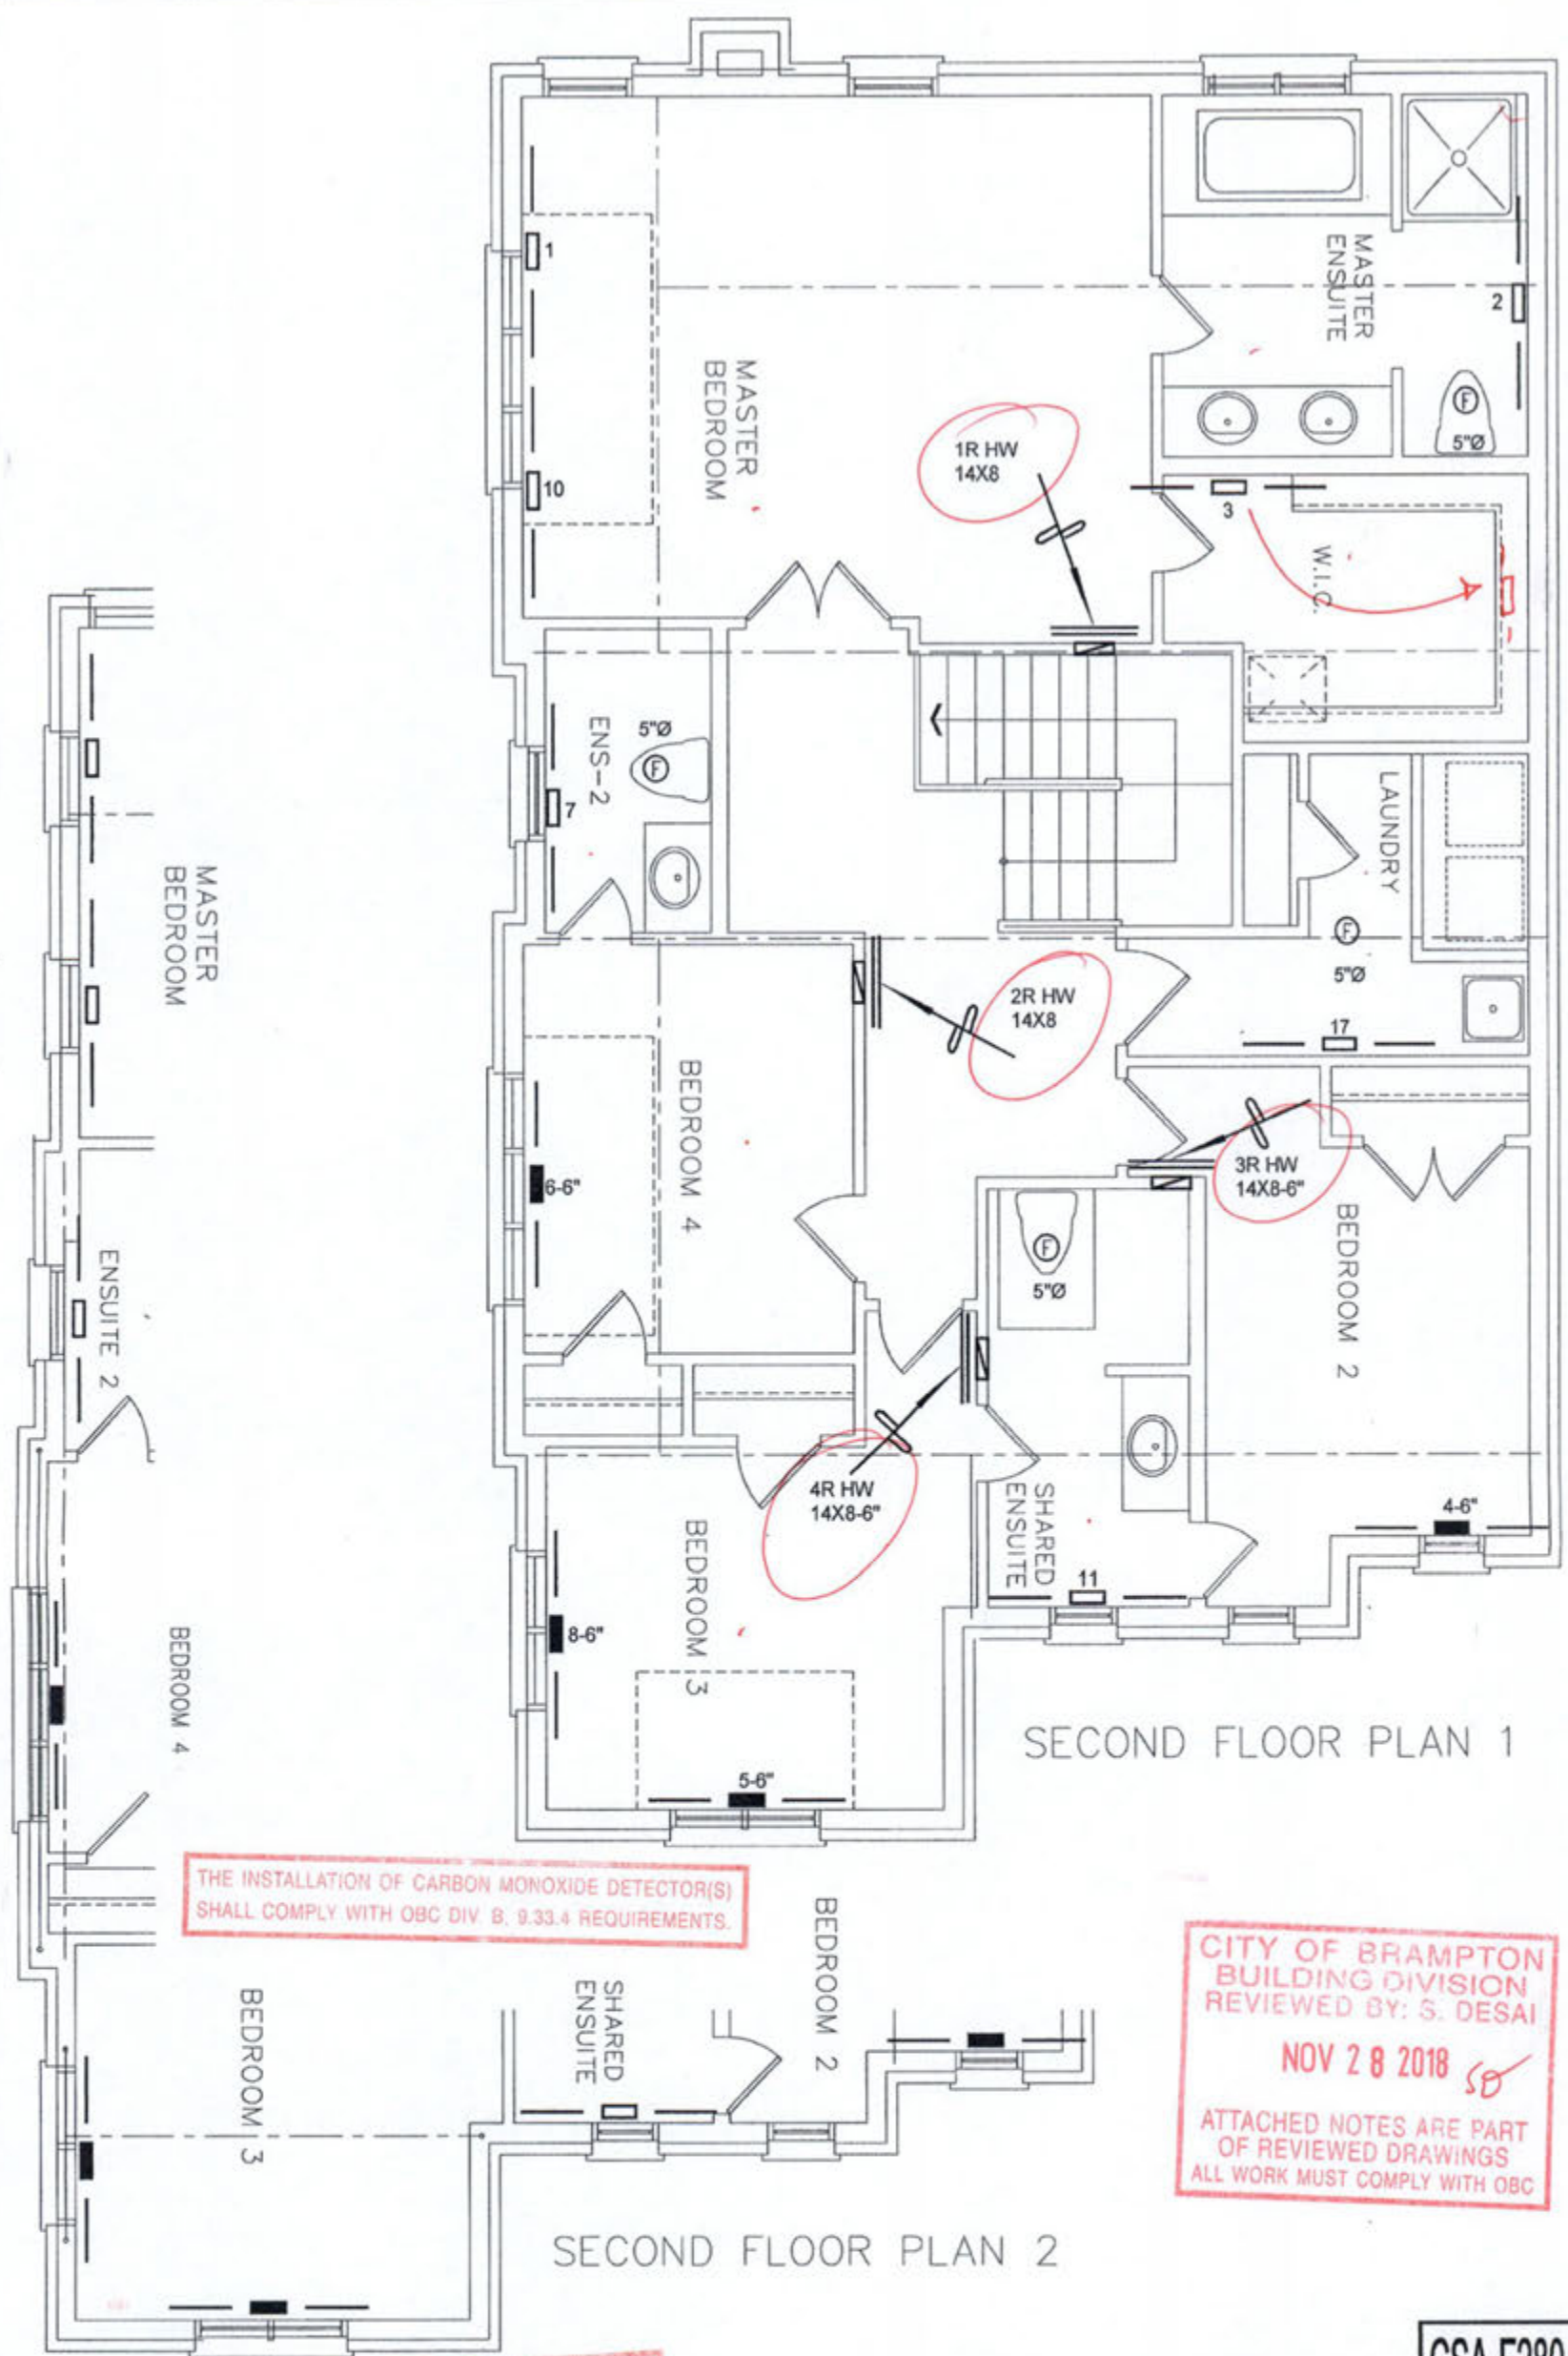

I, MICHAEL O'DRISCOLL, HAVE REVIEWED AND TAKE RESPONSIBILITY FOR THE DESIGN WORK AND AM QUALIFIED UNDER DIVISION C, 3.2.5 OF THE BUILDING CODE.

Michael O'Driscoll
Michael O'Driscoll, BCIN# 19669
HVAC DESIGNS LTD.

CSA-F280-12
PACKAGE A1

HVAC LEGEND									
SYMBOL	DESCRIPTION	SYMBOL	DESCRIPTION	SYMBOL	DESCRIPTION	SYMBOL	DESCRIPTION	No.	Date
	FLOOR SUPPLY AIR GRILLE		6" SUPPLY AIR BOOT ABOVE		14"x8" RETURN AIR GRILLE		RETURN AIR STACK ABOVE	1.	
	FLOOR SUPPLY AIR GRILLE 6" BOOT		SUPPLY AIR STACK FROM 2nd FLOOR		30"x8" RETURN AIR GRILLE		RETURN AIR STACK 2nd FLOOR		
	SUPPLY AIR BOOT ABOVE		6" SUPPLY AIR STACK 2nd FLOOR		FRA- FLOOR RETURN AIR GRILLE		REDUCER		

ALL DRAWINGS, CALCULATIONS AND SPECIFICATIONS ARE THE PROPERTY OF HVAC DESIGNS LTD. AND MAY NOT BE REPRODUCED, MODIFIED OR ALTERED WITHOUT EXPRESSED WRITTEN CONSENT. THE DRAWINGS ARE DATED AND USE OF THESE DRAWINGS AFTER ONE YEAR FROM THE DATED NOTED IS NOT AUTHORIZED. CONTRACTOR SHALL CHECK ALL CONDITIONS BEFORE PROCEEDING WITH WORK. LATEST MUNICIPAL APPROVED DRAWINGS ONLY TO BE USED DURING INSTALLATION OF HEATING SYSTEM. HVAC DESIGNS LTD. IS NOT LIABLE FOR ANY CLAIMS ARISING FROM UNAUTHORIZED USE OF THE DRAWINGS OR FROM ANY CHANGES TO ACCEPTED STANDARDS AND/OR THE ONTARIO BUILDING CODE.

Client GREENPARK HOMES		HVACDESIGNS LTD. 375 Finley Ave. Suite 202 - Ajax, Ontario L1S 2E2 Tel. 905.619.2300 - 905.420.5300 Fax 905.619.2375 Email: info@hvacdesigns.ca Web: www.hvacdesigns.ca Specializing in Residential Mechanical Design Services Installation to comply with the latest Ontario Building Code. All supply branch outlets shall be equipped with a manual balancing damper. Ductwork which passes through the garage or unheated spaces shall be adequately insulated and be gas-proofed.	Sheet Title SECOND FLOOR HEATING LAYOUT	
Project Name MINNISALE HOMES CORP BRAMPTON, ONTARIO			Date AUG/2018	
MILLWOOD 12 2642 sqft			Scale 3/16" = 1'-0"	
			BCIN# 19669	
			LO# 79588	