



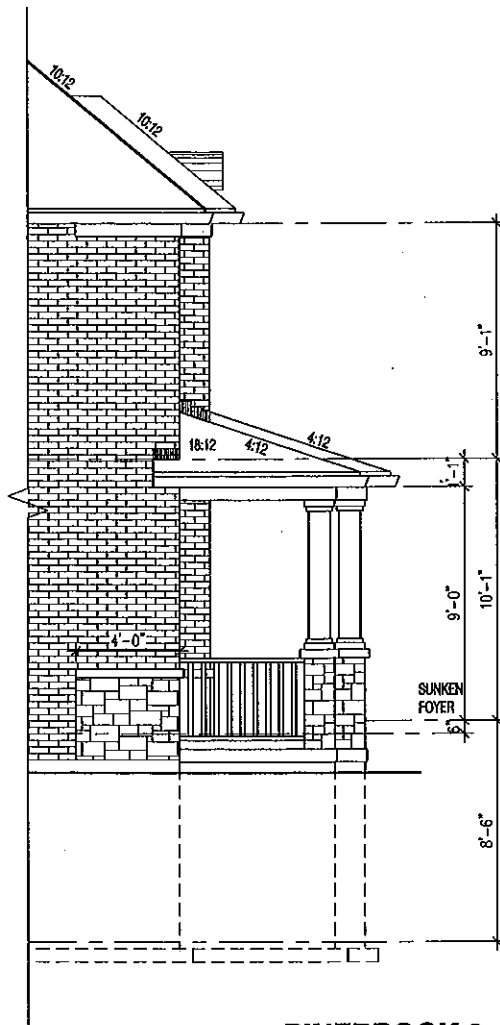


PINEBROOK 2
PARTIAL LEFT ELEVATION 1

REVISIONS:

1. STONE IN FRONT AS PER SKETCH

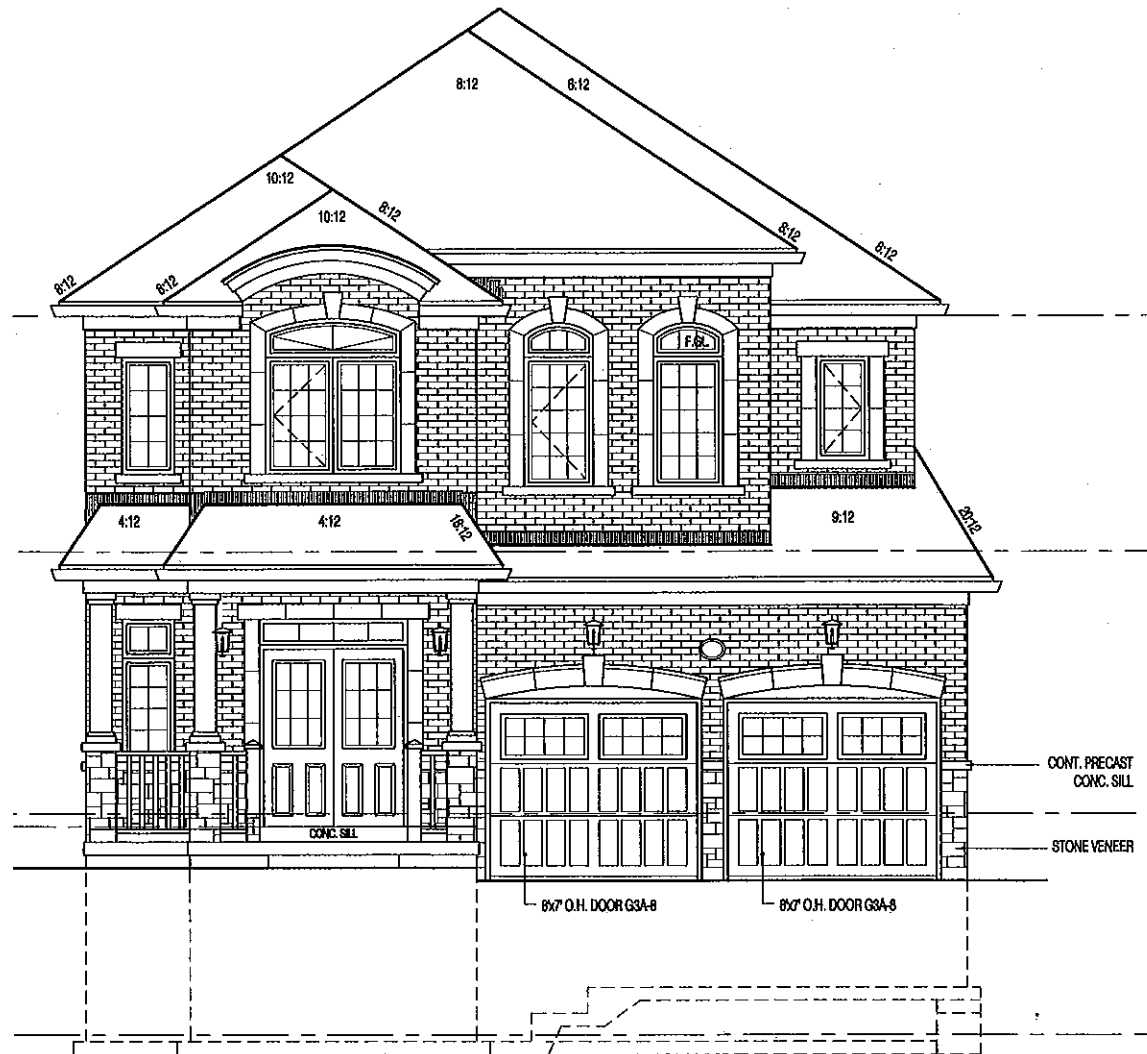

PINEBROOK 2
ELEVATION 1

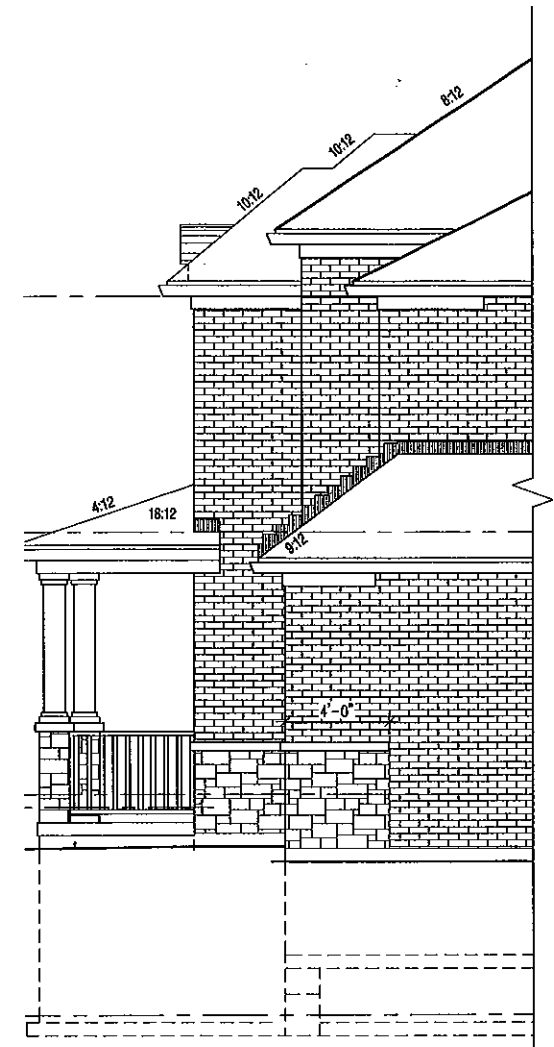

PINEBROOK 2
PARTIAL RIGHT ELEVATION 1

DISCLAIMERS: SKETCH NOT TO SCALE. DIMENSIONS, SPECIFICATIONS AND ARCHITECTURAL DETAILS SUBJECT TO MODIFICATION BY THE VENDOR. SKETCH IS ONLY FOR THE PURPOSE OF ILLUSTRATING REVISIONS REQUESTED BY THE PURCHASER AND ALL REVISIONS ARE SUBJECT TO VENDOR'S FINAL APPROVAL. ONLY REVISIONS ACCEPTED IN WRITING BY THE PURCHASER AND VENDOR ON A PURCHASER'S EXTRA SHEET WILL BE INCORPORATED INTO THE PLANS FILED WITH THE MUNICIPALITY. E. & O.E.

PROJECT		SECONDINO VALES ESTATES		LOT	23
MODEL		PINEBROOK 2		ELEVATION	1
REGION DESIGN INC.	SCALE	N.T.S.			
	BY	VG	PAGE No. 1 OF 1		