SANITARY CONNECTION
WATER CONNECTION
HYDRO CONNECTION
DOUBLE CATCH BASIN
CATCH BASIN
HYDRANT
VALVE AND CHAMBER
GARAGE DOOR LOCATION
ENGINEERED FILL LOT
SANITARY MANHOLE
STORM MANHOLE
COMMUNITY MAILBOX
DOWNSPOUT LOCATION
SWALE DIRECTION
TRANSFORMER
CABLE TV PEDESTAL
BELL PEDESTAL
BELL/ROG. FLUSH TO GRADE
HYDRO METER
GAS METER
AIR-CONDITIONING UNIT
F.F.LR. FINISHED FLOOR ELEVATION
T/WALL TOP OF FOUNDATION WALL
F.SLAB FIN. BASEMENT FLOOR SLAB
U/FTG. UNDERSIDE FOOTING ELEVATION
PROPOSED 3:1 SLOPE
100.00 PROPOSED GRADE
SW ×100.00 PROPOSED SWALE GRADE

NORTH

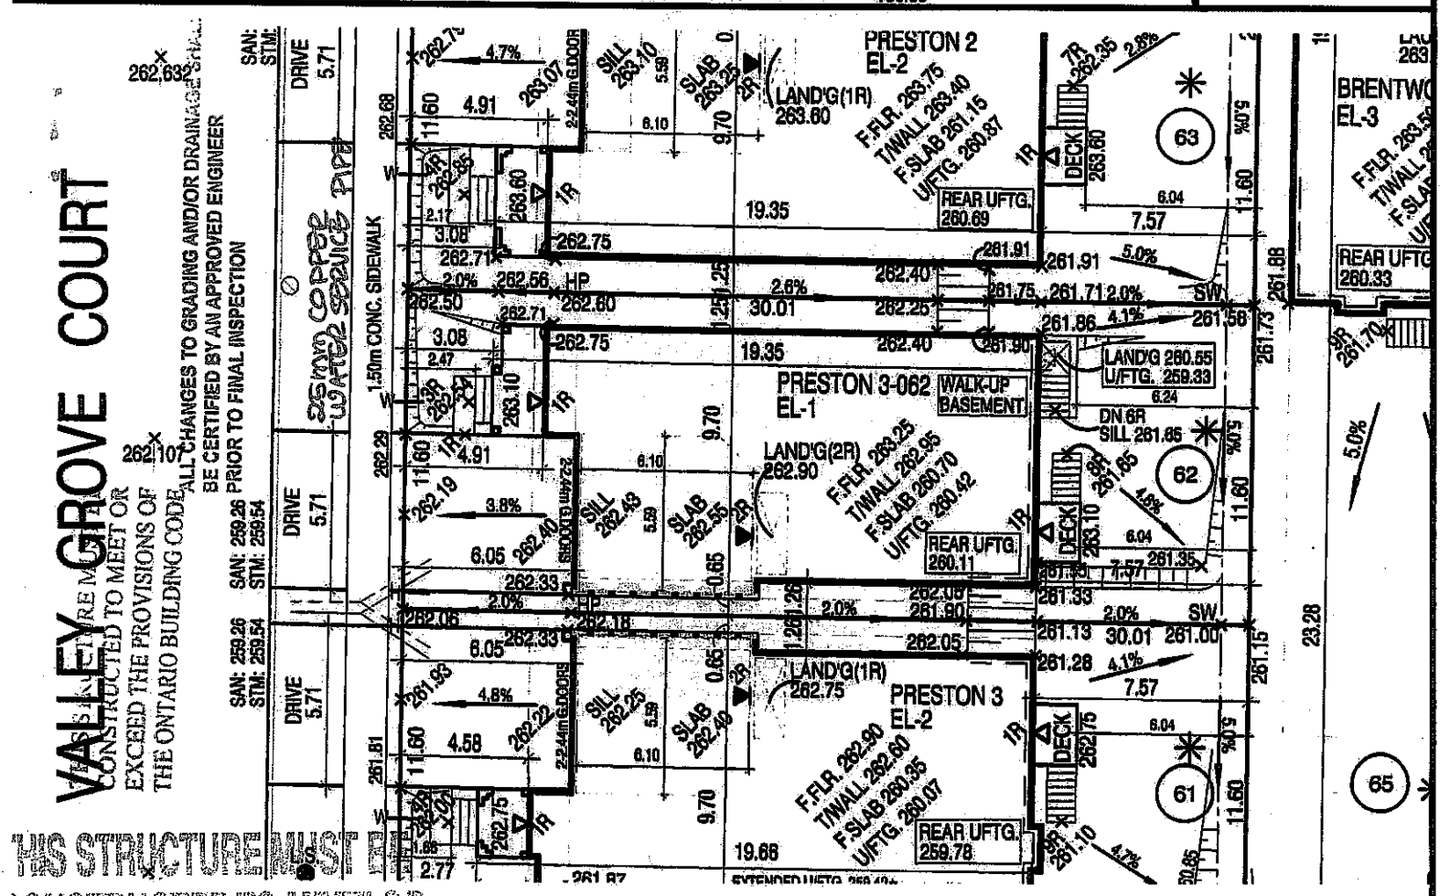

THIS STRUCTURE MUST BE CONSTRUCTED TO MEET OR EXCEED THE PROVISIONS OF THE ONTARIO BUILDING CODE

BUILDING INSPECTOR IS REQUIRED TO BE ON SITE FOR ALL MANDATORY INSPECTIONS. REFER TO ATTACHED BUILDING PERMIT FOR DETAILS

APPROVED
For construction as per the Ontario Building Code
Town of Caledon Building Department
Initial K.Miller
Date SEPT 4/19
File # BA1191047I

NOTE:
THE AS-CONSTRUCTED STORM AND SANITARY CONNECTION INVERTS HAVE BEEN PROVIDED BY CON-DRAIN GROUP

NOTE:
ANY ENGINEERED FILL LOTS NOTED ARE ESTIMATED AND FOR REFERENCE ONLY AND THE ENGINEERED FILL CERTIFICATE PROVIDED BY THE PROJECT GEOTECHNICAL CONSULTANT WILL GOVERN

NOTE:
IT IS THE BUILDER'S RESPONSIBILITY TO CONFIRM IN THE FIELD THAT ALL SANITARY AND STORM LATERALS ELEVATIONS ARE ACCEPTABLE PRIOR TO POURING FOOTINGS

RECEIVED
AUG 08 2019
TOWN OF CALEDON
BUILDING SECTION
FILE NO.

3/4HE
FRR

: 45 MINUTE RATED WALL WITH SIDE YARD < 1.2m

DSEL
david schaeffer engineering ltd
LOT GRADING REVIEW

The review of the lot grading design of the above-noted lot(s) by the Engineer is for the sole purposes of ascertaining general conformance of the design with that of the overall lot grading design as prepared by the Engineer and that proper drainage principles have been observed. The undersigned assumes no responsibility for the correctness of the building grades shown hereon or conformity to any applicable zoning by-law.

Registered Plan No. 43M-2071
Lot No(s). 62
Date JULY 23/2019

LICENSED PROFESSIONAL ENGINEER
PROVINCE OF ONTARIO

It is the builder's complete responsibility to ensure that all plans submitted for approval fully comply with the Architectural Guidelines and all applicable regulations and requirements including zoning provisions and any provisions in the subdivision agreement. The Control Architect is not responsible in any way for examining or approving site (lotting) plans or working drawings with respect to any zoning or building code or permit matter or that any house can be properly built or located on its lot.

This is to certify that these plans comply with the applicable Architectural Design Guidelines approved by the Town of CALEDON.

JOHN G. WILLIAMS LTD., ARCHITECT
ARCHITECTURAL CONTROL REVIEW AND APPROVAL
APPROVED BY:
DATE: AUG 06, 2019
This stamp certifies compliance with the applicable Design Guidelines only and bears no further professional responsibility.

5		
4	JULY 18, 2019	REV. AS PER ENGINEERS COMMENTS AND ISSUED FOR PERMIT.
3	JULY 15, 2019	REVISED & ISSUED FOR ENGINEERS GRADING REVIEW.
2	JULY 12, 2019	ISSUED FOR ENGINEERS GRADING REVIEW.
1	JULY 11, 2019	ISSUED FOR ENGINEERS GRADING REVIEW.

REVISIONS:

Greenpark

SCALE 1:250
5m 0m 5m 10m

The undersigned has reviewed and takes responsibility for this design and has the qualifications and meets the requirements set out in the Ontario Building Code to be a designer
QUALIFICATION INFORMATION
Required unless design is exempt under Division C, Subsection 3.2.5. of the Building Code
Walter Bottel 21031
NAME SIGNATURE BCIN
REGISTRATION INFORMATION
Required unless design is exempt under Division C, Subsection 3.2.4 of the building code
jardin design group inc. 27763
FIRM NAME BCIN

jardin DESIGN GROUP INC.
64 JARDIN DR. SUITE 3A
VAUGHAN ONT. L4K 3P3
TEL: 905 660-3377 FAX: 905 660-3713
EMAIL: info@jardindesign.ca

LAMBERTS LANE HOME CORP. PH-2

PROJ. No. 18-18	MUNICIPAL ADDRESS
LOT No. 62	5 VALLEY GROVE COURT

BILD

REG. PLAN: PLAN OF SUBDIVISION OF PART OF LOTS 21 AND 22 CONCESSION 1 EAST OF HURONTARIO STREET
REGIONAL MUNICIPALITY OF PEEL (GEOGRAPHIC TOWNSHIP OF CHINGUACOUSY)
TOWN OF CALEDON REGISTERED PLAN 43M-

THE CONTRACTOR SHALL CHECK AND VERIFY ALL DIMENSIONS AND CONDITIONS ON SITE BEFORE PROCEEDING WITH CONSTRUCTION, AND DISCREPANCIES SHALL BE REPORTED TO JARDIN DESIGN GROUP INC. PRIOR TO COMMENCEMENT OF WORK.
JARDIN DESIGN GROUP INC. IS (ARE) NOT RESPONSIBLE FOR THE INTERPRETATION OF SUBSTITUTIONS OR DEVIATIONS FROM THE CONTRACT DOCUMENTS MADE ON THE JOB SITE UNLESS SUCH SUBSTITUTIONS OR DEVIATIONS HAVE BEEN REVIEWED AND APPROVED BY JARDIN DESIGN GROUP INC. PRIOR TO THE SUBMISSION OF A BUILDING PERMIT AND/OR TO THE APPROVED ENGINEERING DRAWINGS BEFORE PROCEEDING WITH WORK.

AS CONSTRUCTED INVERTS MUST BE VERIFIED PRIOR TO POURING FOOTINGS.
JARDIN DESIGN GROUP INC. HAS NOT BEEN RETAINED TO CARRY OUT GENERAL REVIEW OF THE WORK AND ASSUMES NO RESPONSIBILITY FOR THE FAILURE OF THE CONTRACTOR TO PERFORM HIS CONTRACT TO CARRY OUT THE WORK IN ACCORDANCE WITH THE CONTRACT DOCUMENTS.
THE DISPOSITION AND INSTALLATION OF SERVICES IS PROVIDED BY OTHERS. THE PROPERTY OF JARDIN DESIGN GROUP INC. THIS DRAWING IS NOT TO BE SCALED

APPLICANT COPY

A COMPLETE SET OF REVIEWED DRAWINGS & SPECIFICATIONS MUST BE KEPT ON SITE AT ALL TIMES DURING CONSTRUCTION AS PER O.B.C.