


-

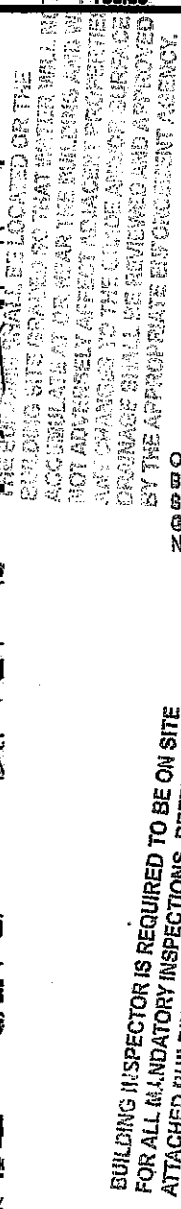

OPENINGS WITHIN GUARDS AND SPACES
BETWEEN GUARDS AND ALL FINISHED
SURFACES SHALL NOT EXCEED 100 MM.
GUARDS SHALL BE DESIGNED TO
NOT FACILITATE CLIMBING

NOTE:
IT IS THE BUILDER'S RESPONSIBILITY TO
CONFIRM IN THE FIELD THAT ALL SANITARY
AND STORM LATERALS ELEVATIONS ARE
ACCEPTABLE PRIOR TO POURING FOOTINGS

BUILDING INSPECTOR IS REQUIRED TO BE ON SITE
FOR ALL MANDATORY INSPECTIONS. REFER TO
ATTACHED BUILDING PERMIT FOR DETAILS

jardin
DESIGN GROUP INC

64 JARDIN DR. SUITE 3A
VAUGHAN ONT. L4K 3P3
TEL: 905 660-3377 FAX: 905 660-3713
EMAIL: info@jardin.ca