


	CON	[CTDLICTION CV	EIVED NOV 2 9 2019	
	Lotus Dei	STRUCTION SUMMARY		
PURCHASERS: Ramanda	Lotus Poli	nte 2 (G) - Lamberts Lane Home Corp		
PURCHASERS: Ramandeep Singh KAINTH and Jasmeet KAINTH				TEL:
LOT / PHASE 77 / 2	REG. PLAN#	HOUSE TYPE		
7772	43M-2071	Brentwood Three-A Elev 3		
CONSTRUCTION				
1 - MASTER ENSUITE- FR	AMELESS GLASS SHOWER	ENCLOSUBE		
28Nov19 Note:	THE CENTED STIOWER	ENCLOSURE		
ELECTRICAL				
	OOM LIGHT TO BE CENTED	ED DECKY (CIRCLE)		
28Nov19 Note:	JOM EIGHT TO BE CENTER	ED BETWEEN LIVING AND DINING ROOM		
1 - PLUG - ELECTRICAL PI	LUG - TO BE INSTALLED O	VER FIREPLACE		
28Nov19 Note:				
MIRRORS AND GLASS				
1 - FRAMELESS GLASS SH	OWER ENCLOSURE WITH (	CHROME KNOB- MASTER ENSUITE		
28Nov19 Note:		MASTER ENSUITE		
PROMOTIONAL				
1 - PARTIAL REDEMTION (	OF PROMOTIONAL PACKAC	GE \$3,175 BALANCE FORWARD \$4,325 TO B		
	PACKAGE OF \$7,500 AS PE	SE \$5,175 BALANCE FORWARD \$4,325 TO B SR SCHEDULE PE DATED MMMDDYYYY.	BE USED AT A LATER DATE.	
28Nov19 Note:				
	EXTI	RAS AS PER OFFER		
Cl. D. I.				
ne Purchaser acknowledge	s that the Purchase Price is i	nclusive of all credits and promotional packa	ages available at the time of	T = T
Vorksheet Note:				
7,5) The Vendor agrees that	t notwithstanding any other t	term or provision in this Agreement included	in the Purchase Price and in	+
ddition to those items detail <i>Torksheet</i> Note:	led in Schedule GP to the Ag	greement of Purchase and Sale, the Purchase	er is entitled to a credit	
ormanical Note.				

This Document is Extremely Time Sensitive - Printed 28 Nov 19 at 14:56

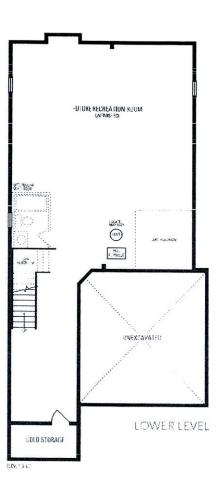



Brentwood
THREE - A
INCLUDES 21 SQ.FT. OF OPEN AREA



