



FROM PLAN DATED:

BUILDER: GREENPARK HOMES

SITE: RUSSELL GARDENS PH 3

MODEL: VALLEYCREEK 3

ELEVATION: 1,2

LOT:

CITY: WATERDOWN

SALESMAN: MARIO DICIANO

DESIGNER: AJ

REVISION:

NOTES:

REFER TO THE NORDIC INSTALLATION GUIDE FOR PROPER STORAGE AND INSTALLATION.

**SQUASH BLOCKS** OF 2x4, 2x6, 2x8 #2 S.P.F REQ'D UNDER INTERIOR UNIFORM LOAD BEARING WALLS. **MULTIPLE SQUASH BLOCKS** REQ'D UNDER CONCENTRATED LOADS. SEE FIGURE 1. **CANTILEVERED JOISTS** INCLUDING CANT' OVER BRICK REQ. I-JOIST BLOCKING ALONG BEARING AND RIMBOARD CLOSURE AT ENDS. SEE FIGURES 4 & 5 FOR REINFORCEMENT REQUIREMENTS. FOR HOLES INCLUDING **DUCT CHASE** AND **FIELD CUT OPENINGS** SEE FIGURE 7, TABLES 1 & 2. **CERAMIC TILE** APPLICATION AS PER O.B.C 9.30.6.

LOADING:

DESIGN LOADS: L/480.000


LIVE LOAD: 40.0 lb/ft<sup>2</sup>

DEAD LOAD: 20.0 lb/ft<sup>2</sup>

**SUBFLOOR: 3/4" GLUED AND NAILED**

DATE: 2020-02-20

**1st FLOOR**

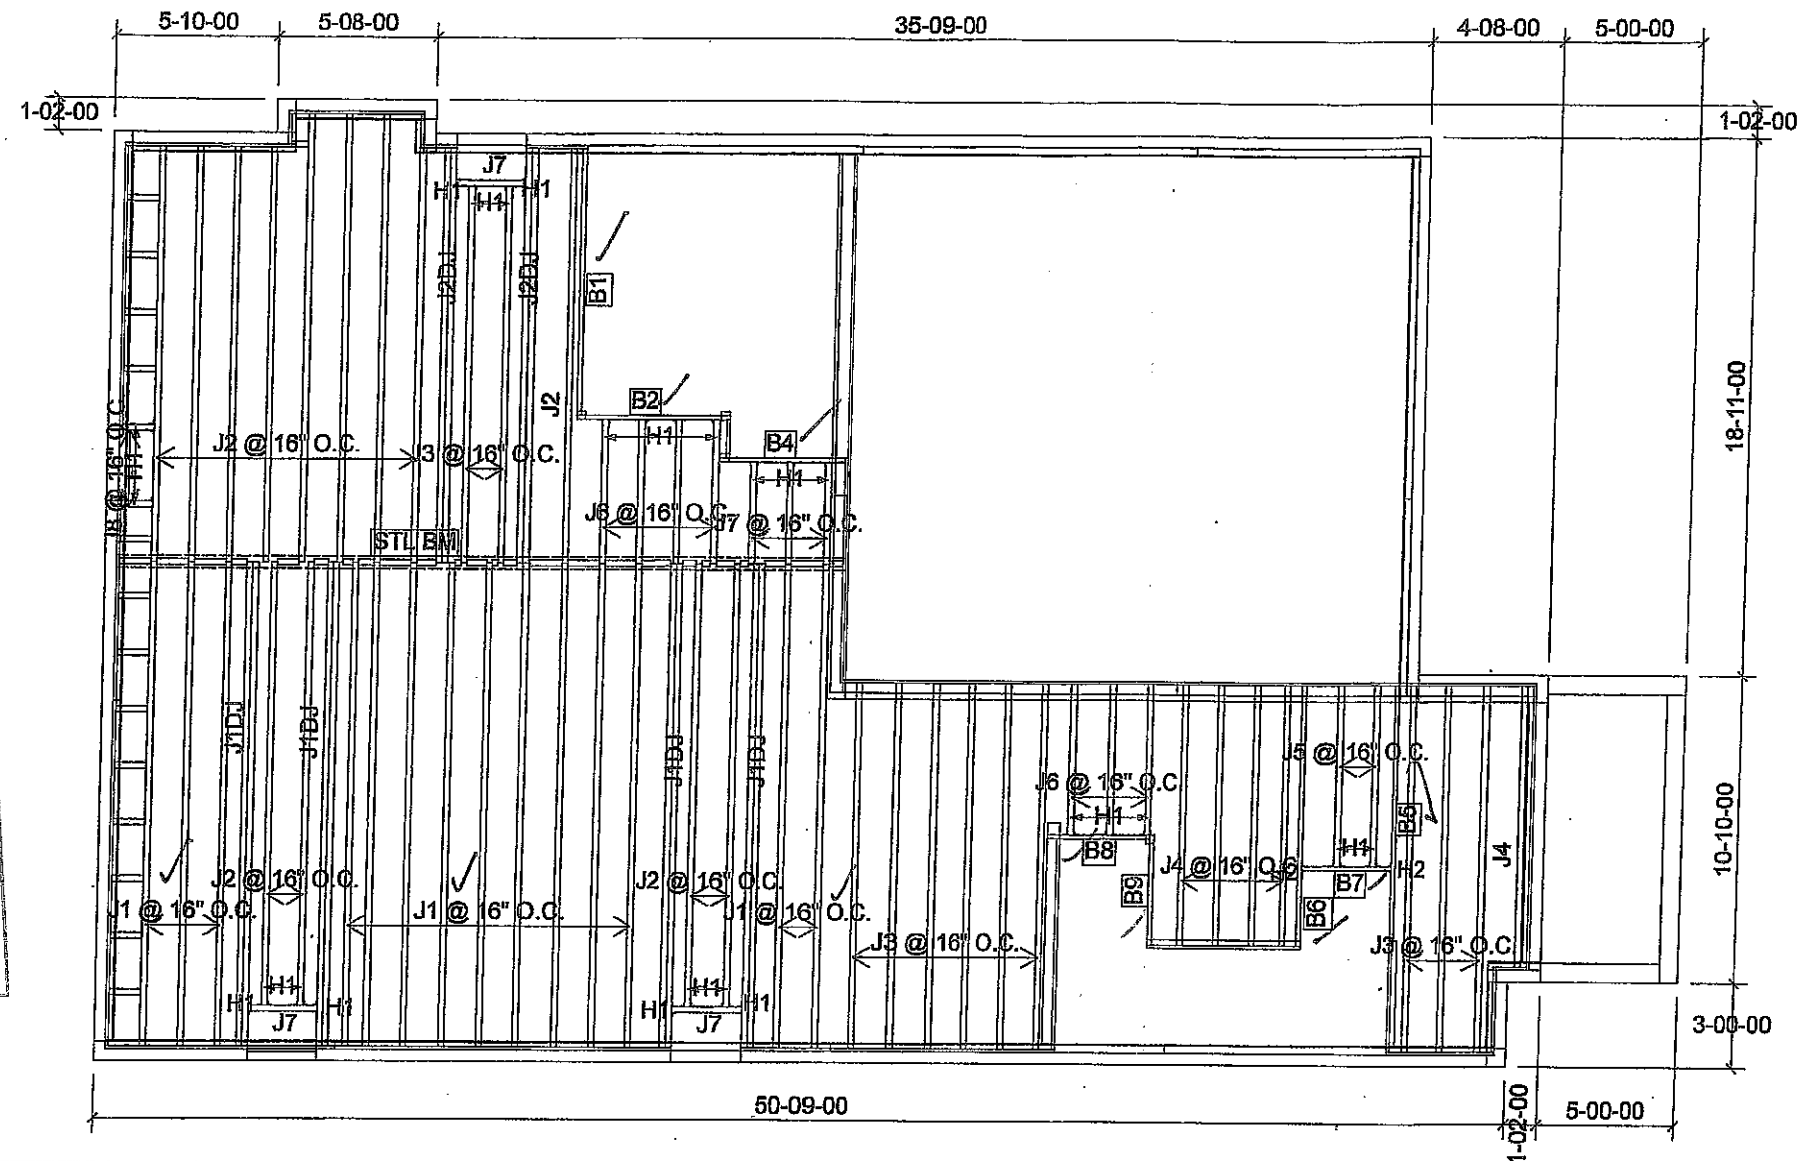

Products					
PlotID	Length	Product	Plies	Net Qty	Fab Type
J1	18-00-00	11 7/8" NI-40x	1	14	MFD
J1DJ	18-00-00	11 7/8" NI-40x	2	8	MFD
J2	16-00-00	11 7/8" NI-40x	1	13	MFD
J2DJ	16-00-00	11 7/8" NI-40x	2	4	MFD
J3	14-00-00	11 7/8" NI-40x	1	11	MFD
J4	10-00-00	11 7/8" NI-40x	1	5	MFD
J5	8-00-00	11 7/8" NI-40x	1	2	MFD
J6	6-00-00	11 7/8" NI-40x	1	7	MFD
J7	4-00-00	11 7/8" NI-40x	1	6	MFD
J8	2-00-00	11 7/8" NI-40x	1	2	MFD
B1	10-00-00	1-3/4" x 11-7/8" VERSA-LAM® 2.0 3100 SP	1	1	MFD
B5	10-00-00	1-3/4" x 11-7/8" VERSA-LAM® 2.0 3100 SP	1	1	MFD
B6	10-00-00	1-3/4" x 11-7/8" VERSA-LAM® 2.0 3100 SP	1	1	MFD
B2	6-00-00	1-3/4" x 11-7/8" VERSA-LAM® 2.0 3100 SP	1	1	MFD
B4	6-00-00	1-3/4" x 11-7/8" VERSA-LAM® 2.0 3100 SP	1	1	MFD
B7	4-00-00	1-3/4" x 11-7/8" VERSA-LAM® 2.0 3100 SP	1	1	MFD
B8	4-00-00	1-3/4" x 11-7/8" VERSA-LAM® 2.0 3100 SP	1	1	MFD
B9	4-00-00	1-3/4" x 11-7/8" VERSA-LAM® 2.0 3100 SP	1	1	MFD

Connector Summary		
Qty	Manuf	Product
12	H1	IUS2.56/11.88
6	H1	IUS2.56/11.88
8	H1	IUS2.56/11.88
2	H2	HUS1.81/10

CITY OF HAMILTON  
Building Division

Permit No. 187710


THESE STAMPED DRAWINGS SHALL BE AVAILABLE ON SITE


THE OWNER AND/OR CONTRACTOR SHALL COMPLY WITH  
THE ONTARIO BUILDING CODE AND ALL OTHER APPLICABLE LAW

These drawings and/or specifications have been reviewed by

*[Signature]*  
FOR CHIEF BUILDING OFFICIAL

Dec 10/20

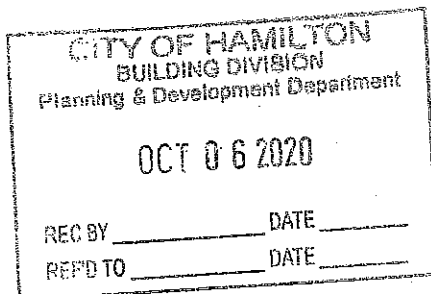

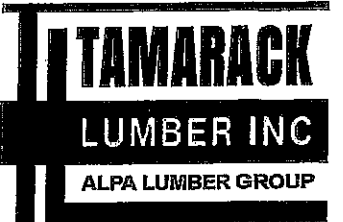

FROM PLAN DATED:

BUILDER: GREENPARK HOMES

SITE: RUSSELL GARDENS PH 3

MODEL: VALLEYCREEK 3

ELEVATION: 3

LOT:

CITY: WATERDOWN

SALESMAN: MARIO DICIANO

DESIGNER: AJ

REVISION:

NOTES:

REFER TO THE NORDIC INSTALLATION GUIDE FOR PROPER STORAGE AND INSTALLATION.

SQUASH BLOCKS OF 2x4, 2x6, 2x8 #2 S.P.F REQ'D UNDER INTERIOR UNIFORM LOAD BEARING WALLS. MULTIPLE SQUASH BLOCKS REQ'D UNDER CONCENTRATED LOADS. SEE FIGURE 1. CANTILEVERED JOISTS INCLUDING CANT' OVER BRICK REQ. JOIST BLOCKING ALONG BEARING AND RIMBOARD CLOSURE AT ENDS. SEE FIGURES 4 & 5 FOR REINFORCEMENT REQUIREMENTS. FOR HOLES INCLUDING DUCT CHASE AND FIELD CUT OPENINGS SEE FIGURE 7, TABLES 1 & 2. CERAMIC TILE APPLICATION AS PER O.B.C 9.30.6.

LOADING:

DESIGN LOADS: L/480.000


LIVE LOAD: 40.0 lb/ft<sup>2</sup>

DEAD LOAD: 20.0 lb/ft<sup>2</sup>

SUBFLOOR: 3/4" GLUED AND NAILED

DATE: 2020-02-20

1st FLOOR

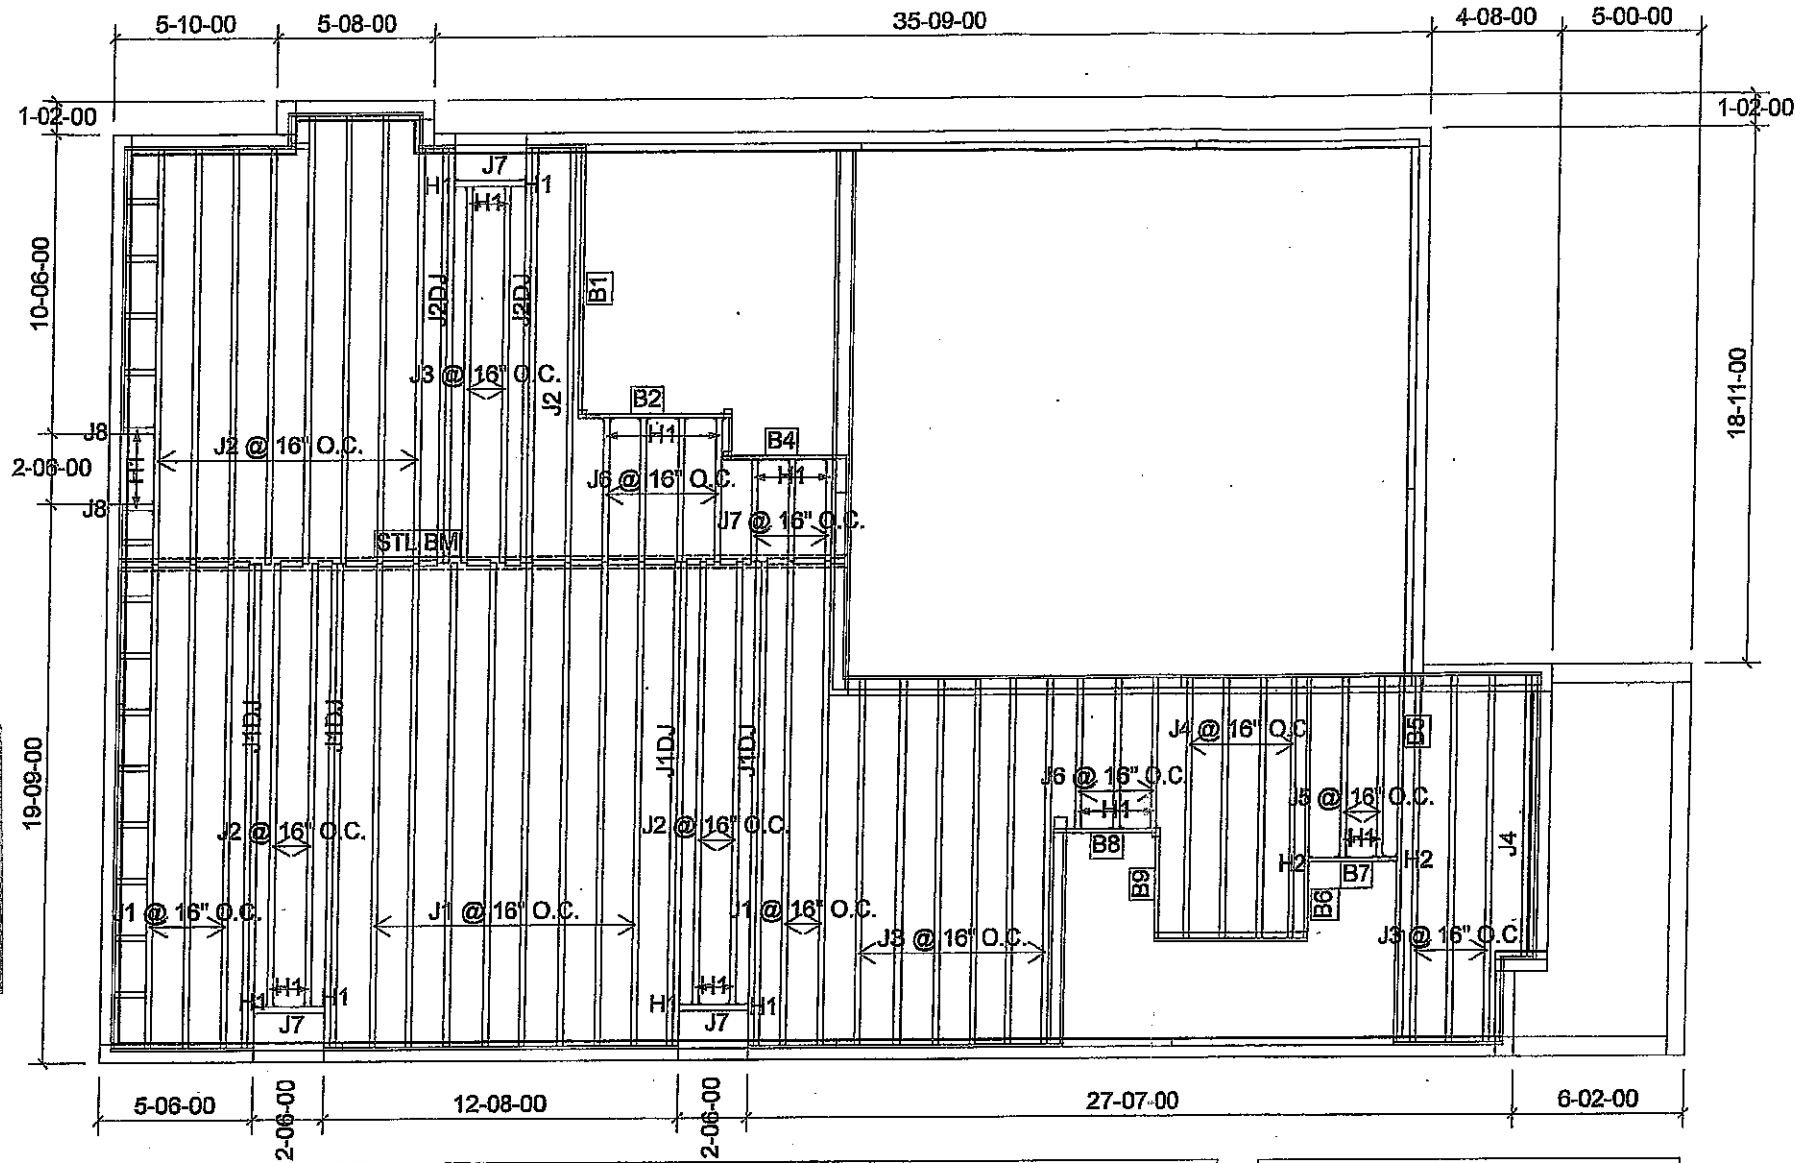

CITY OF HAMILTON  
BUILDING DIVISION  
Planning & Development Department  
OC 1 0 6 2020  
REC BY \_\_\_\_\_ DATE \_\_\_\_\_  
REP'D TO \_\_\_\_\_ DATE \_\_\_\_\_

Products					
PlotID	Length	Product	Plies	Net Qty	Fab Type
J1	18-00-00	11 7/8" NI-40x	1	13	MFD
J1DJ	18-00-00	11 7/8" NI-40x	2	8	MFD
J2	16-00-00	11 7/8" NI-40x	1	13	MFD
J2DJ	16-00-00	11 7/8" NI-40x	2	4	MFD
J3	14-00-00	11 7/8" NI-40x	1	11	MFD
J4	10-00-00	11 7/8" NI-40x	1	5	MFD
J5	8-00-00	11 7/8" NI-40x	1	2	MFD
J6	6-00-00	11 7/8" NI-40x	1	7	MFD
J7	4-00-00	11 7/8" NI-40x	1	6	MFD
J8	2-00-00	11 7/8" NI-40x	1	2	MFD
B1	10-00-00	1-3/4" x 11-7/8" VERSA-LAM® 2.0 3100 SP	1	1	MFD
B5	10-00-00	1-3/4" x 11-7/8" VERSA-LAM® 2.0 3100 SP	1	1	MFD
B6	10-00-00	1-3/4" x 11-7/8" VERSA-LAM® 2.0 3100 SP	1	1	MFD
B2	6-00-00	1-3/4" x 11-7/8" VERSA-LAM® 2.0 3100 SP	1	1	MFD
B4	6-00-00	1-3/4" x 11-7/8" VERSA-LAM® 2.0 3100 SP	1	1	MFD
B7	4-00-00	1-3/4" x 11-7/8" VERSA-LAM® 2.0 3100 SP	1	1	MFD
B8	4-00-00	1-3/4" x 11-7/8" VERSA-LAM® 2.0 3100 SP	1	1	MFD
B9	4-00-00	1-3/4" x 11-7/8" VERSA-LAM® 2.0 3100 SP	1	1	MFD

Connector Summary		
Qty	Manuf	Product
12	H1	IUS2.56/11.88
6	H1	IUS2.56/11.88
8	H1	IUS2.56/11.88
2	H2	HUS1.81/10

CITY OF HAMILTON  
Building Division


Permit No. 1977-1-1

THESE STAMPED DRAWINGS SHALL BE AVAILABLE ON SITE

THE OWNER AND/OR CONTRACTOR SHALL COMPLY WITH  
THE ONTARIO BUILDING CODE AND ALL OTHER APPLICABLE LAW

These drawings and/or specifications have been reviewed by

JDC Dec 10/20  
FOR CHIEF BUILDING OFFICIAL DATE

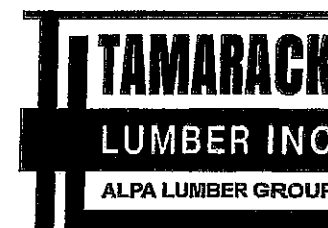

FROM PLAN DATED:

BUILDER: GREENPARK HOMES

SITE: RUSSELL GARDENS PH 3

MODEL: VALLEYCREEK 3

ELEVATION: 1,2

LOT:

CITY: WATERDOWN

SALESMAN: MARIO DICIANO

DESIGNER: AJ

REVISION:

NOTES:

REFER TO THE NORDIC INSTALLATION GUIDE FOR PROPER STORAGE AND INSTALLATION.

**SQUASH BLOCKS** OF 2x4, 2x6, 2x8 #2 S.P.F REQ'D UNDER INTERIOR UNIFORM LOAD BEARING WALLS. **MULTIPLE SQUASH BLOCKS** REQ'D UNDER CONCENTRATED LOADS. SEE FIGURE 1. **CANTILEVERED JOISTS** INCLUDING **CANT' OVER BRICK** REQ. I-JOIST BLOCKING ALONG BEARING AND RIMBOARD CLOSURE AT ENDS. SEE FIGURES 4 & 5 FOR REINFORCEMENT REQUIREMENTS. FOR HOLES INCLUDING **DUCT CHASE** AND **FIELD CUT OPENINGS** SEE FIGURE 7, TABLES 1 & 2. **CERAMIC TILE** APPLICATION AS PER O.B.C 9.30.6.

LOADING:

DESIGN LOADS: L/480.000

LIVE LOAD: 40.0 lb/ft<sup>2</sup>



DEAD LOAD: 20.0 lb/ft<sup>2</sup>

**SUBFLOOR: 3/4" GLUED AND NAILED**

DATE: 2020-03-24

**1st FLOOR**

DECK CONDITION

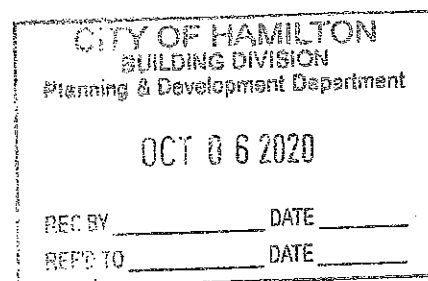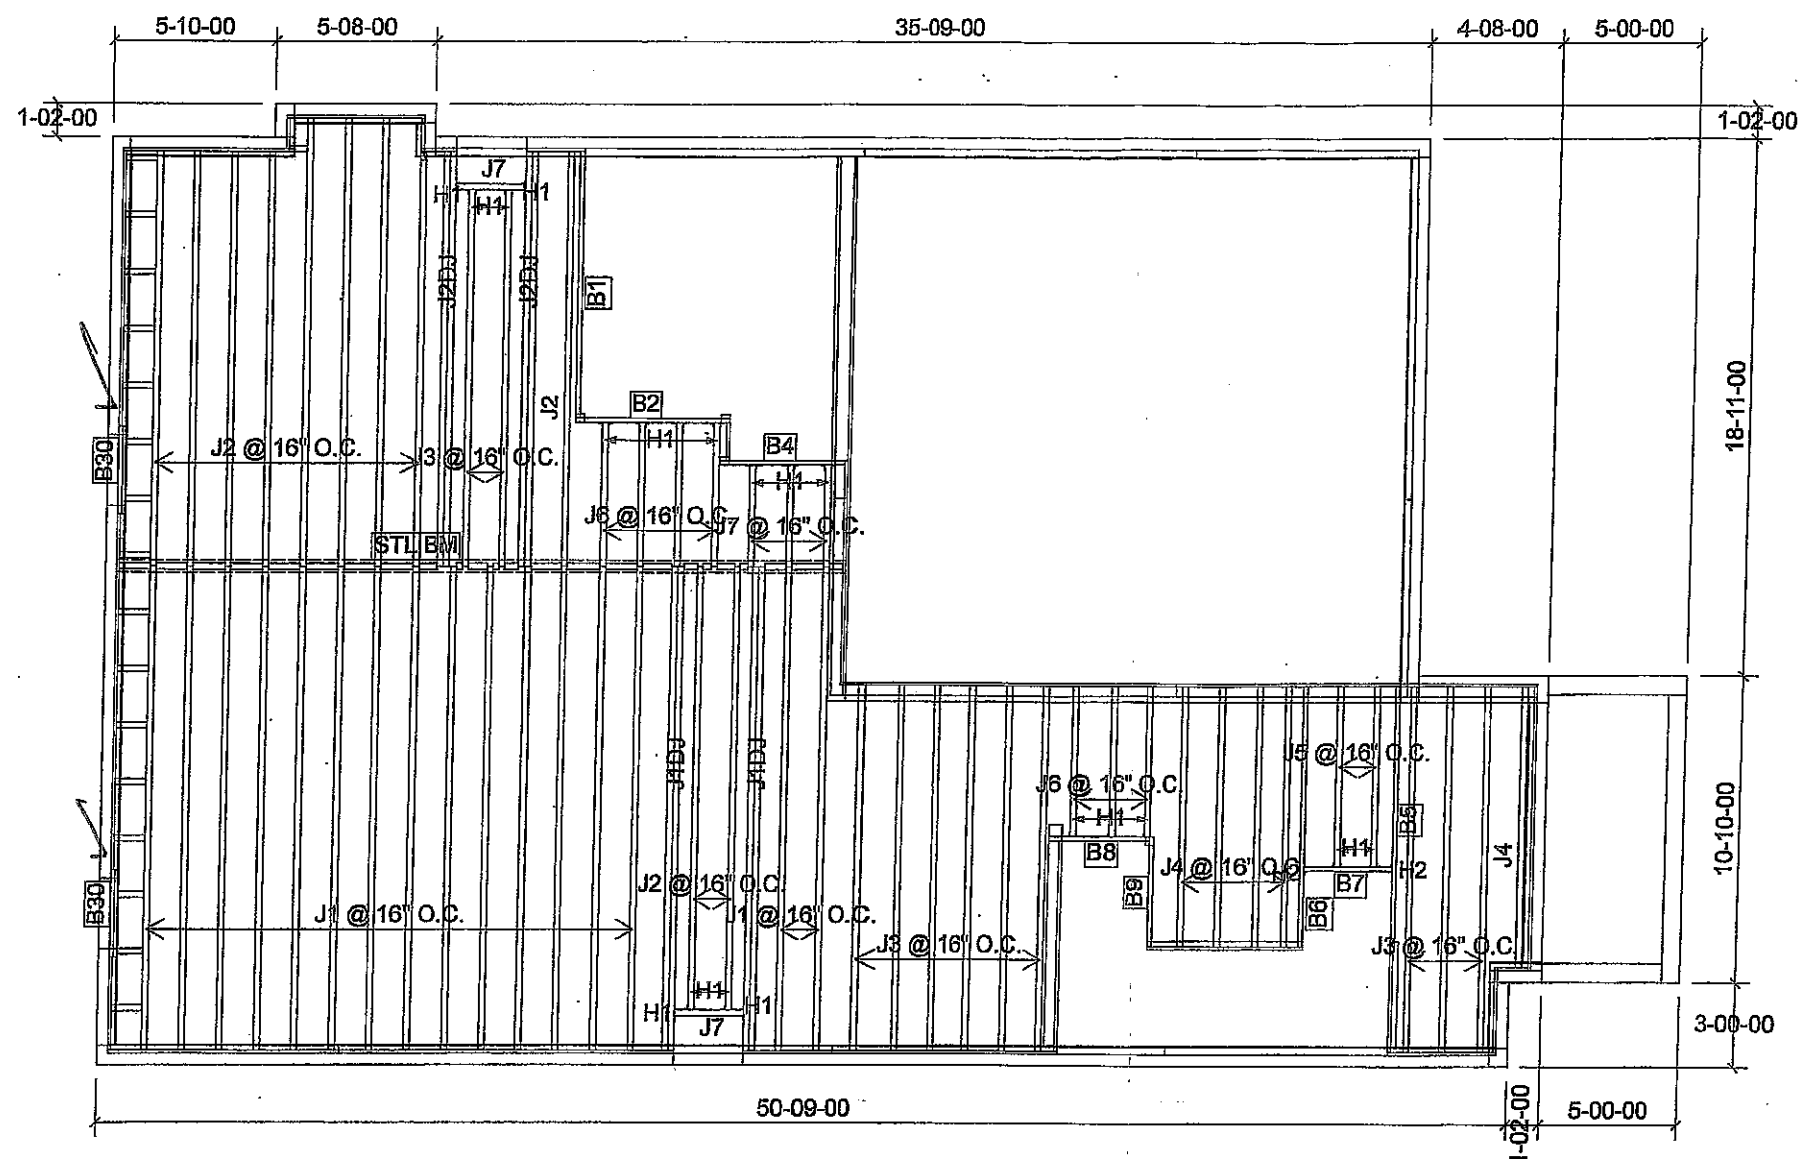

Products					
PlotID	Length	Product	Plies	Net Qty	Fab Type
J1	18-00-00	11 7/8" NI-40x	1	16	MFD
J1DJ	18-00-00	11 7/8" NI-40x	2	4	MFD
J2	16-00-00	11 7/8" NI-40x	1	11	MFD
J2DJ	16-00-00	11 7/8" NI-40x	2	4	MFD
J3	14-00-00	11 7/8" NI-40x	1	11	MFD
J4	10-00-00	11 7/8" NI-40x	1	5	MFD
J5	8-00-00	11 7/8" NI-40x	1	2	MFD
J6	6-00-00	11 7/8" NI-40x	1	7	MFD
J7	4-00-00	11 7/8" NI-40x	1	5	MFD
B1	10-00-00	1-3/4" x 11-7/8" VERSA-LAM® 2.0 3100 SP	1	1	MFD
B5	10-00-00	1-3/4" x 11-7/8" VERSA-LAM® 2.0 3100 SP	1	1	MFD
B6	10-00-00	1-3/4" x 11-7/8" VERSA-LAM® 2.0 3100 SP	1	1	MFD
B2	6-00-00	1-3/4" x 11-7/8" VERSA-LAM® 2.0 3100 SP	1	1	MFD
B4	6-00-00	1-3/4" x 11-7/8" VERSA-LAM® 2.0 3100 SP	1	1	MFD
B7	4-00-00	1-3/4" x 11-7/8" VERSA-LAM® 2.0 3100 SP	1	1	MFD
B8	4-00-00	1-3/4" x 11-7/8" VERSA-LAM® 2.0 3100 SP	1	1	MFD
B9	4-00-00	1-3/4" x 11-7/8" VERSA-LAM® 2.0 3100 SP	1	1	MFD
B30	4-00-00	1-3/4" x 11-7/8" VERSA-LAM® 2.0 3100 SP	2	4	MFD

Connector Summary		
Qty	Manuf	Product
12	H1	IUS2.56/11.88
4	H1	IUS2.56/11.88
4	H1	IUS2.56/11.88
2	H2	HUS1.81/10

CITY OF HAMILTON  
Building Division


Permit No. 187710

THESE STAMPED DRAWINGS SHALL BE AVAILABLE ON SITE

THE OWNER AND/OR CONTRACTOR SHALL COMPLY WITH  
THE ONTARIO BUILDING CODE AND ALL OTHER APPLICABLE LAW

These drawings and/or specifications have been reviewed by

JDL Dec 10/20  
FOR CHIEF BUILDING OFFICIAL DATE

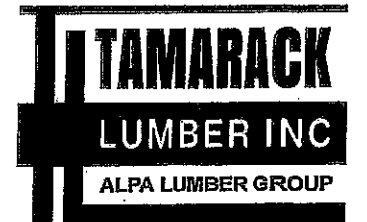

FROM PLAN DATED:

BUILDER: GREENPARK HOMES

SITE: RUSSELL GARDENS PH 3

MODEL: VALLEYCREEK 3

ELEVATION: 3

LOT:

CITY: WATERDOWN

SALESMAN: MARIO DICIANO

DESIGNER: AJ

REVISION:

NOTES:

REFER TO THE NORDIC INSTALLATION GUIDE FOR PROPER STORAGE AND INSTALLATION.

**SQUASH BLOCKS** OF 2x4, 2x6, 2x8 #2 S.P.F REQ'D UNDER INTERIOR UNIFORM LOAD BEARING WALLS. **MULTIPLE SQUASH BLOCKS** REQ'D UNDER CONCENTRATED LOADS. SEE FIGURE 1. **CANTILEVERED JOISTS** INCLUDING CANT' OVER BRICK REQ. I-JOIST BLOCKING ALONG BEARING AND RIMBOARD CLOSURE AT ENDS. SEE FIGURES 4 & 5 FOR REINFORCEMENT REQUIREMENTS. FOR HOLES INCLUDING **DUCT CHASE AND FIELD CUT OPENINGS** SEE FIGURE 7, TABLES 1 & 2. **CERAMIC TILE** APPLICATION AS PER O.B.C 9.30.6.

LOADING:

DESIGN LOADS: L/480.000

LIVE LOAD: 40.0 lb/ft<sup>2</sup>


DEAD LOAD: 20.0 lb/ft<sup>2</sup>

**SUBFLOOR: 3/4" GLUED AND NAILED**

DATE: 2020-03-24

**1st FLOOR**

DECK CONDITION

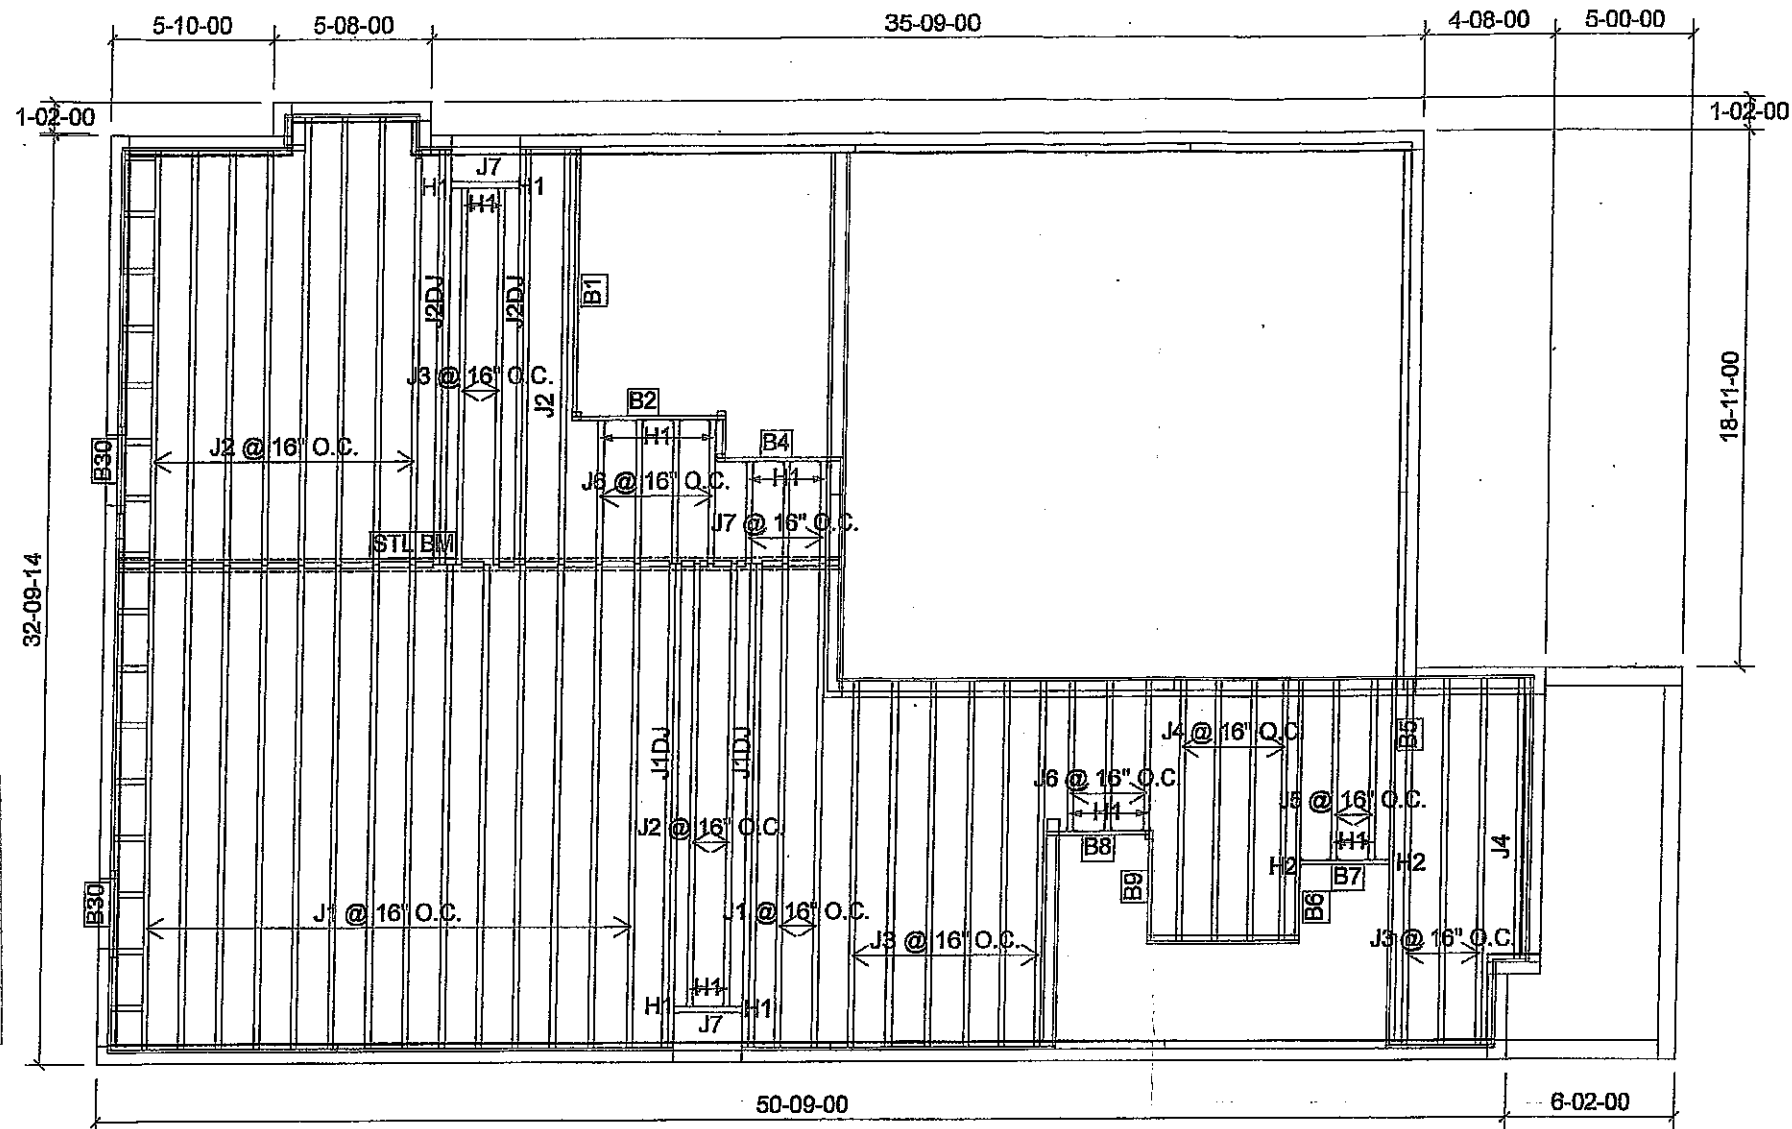

CITY OF HAMILTON  
BUILDING DIVISION  
Planning & Development Department  
OCT 6 6 2020  
REC BY \_\_\_\_\_ DATE \_\_\_\_\_  
REF TO \_\_\_\_\_ DATE \_\_\_\_\_

Products					
PlotID	Length	Product	Plies	Net Qty	Fab Type
J1	18-00-00	11 7/8" NI-40x	1	16	MFD
J1DJ	18-00-00	11 7/8" NI-40x	2	4	MFD
J2	16-00-00	11 7/8" NI-40x	1	11	MFD
J2DJ	16-00-00	11 7/8" NI-40x	2	4	MFD
J3	14-00-00	11 7/8" NI-40x	1	11	MFD
J4	10-00-00	11 7/8" NI-40x	1	5	MFD
J5	8-00-00	11 7/8" NI-40x	1	2	MFD
J6	6-00-00	11 7/8" NI-40x	1	7	MFD
J7	4-00-00	11 7/8" NI-40x	1	5	MFD
B1	10-00-00	1-3/4" x 11-7/8" VERSA-LAM@ 2.0 3100 SP	1	1	MFD
B5	10-00-00	1-3/4" x 11-7/8" VERSA-LAM@ 2.0 3100 SP	1	1	MFD
B6	10-00-00	1-3/4" x 11-7/8" VERSA-LAM@ 2.0 3100 SP	1	1	MFD
B2	6-00-00	1-3/4" x 11-7/8" VERSA-LAM@ 2.0 3100 SP	1	1	MFD
B4	6-00-00	1-3/4" x 11-7/8" VERSA-LAM@ 2.0 3100 SP	1	1	MFD
B7	4-00-00	1-3/4" x 11-7/8" VERSA-LAM@ 2.0 3100 SP	1	1	MFD
B8	4-00-00	1-3/4" x 11-7/8" VERSA-LAM@ 2.0 3100 SP	1	1	MFD
B9	4-00-00	1-3/4" x 11-7/8" VERSA-LAM@ 2.0 3100 SP	1	1	MFD
B30	4-00-00	1-3/4" x 11-7/8" VERSA-LAM@ 2.0 3100 SP	2	4	MFD

Connector Summary		
Qty	Manuf	Product
12	H1	IUS2.56/11.88
4	H1	IUS2.56/11.88
4	H1	IUS2.56/11.88
2	H2	HUS1.81/10

CITY OF HAMILTON  
Building Division

Permit No. 184710

THESE STAMPED DRAWINGS SHALL BE AVAILABLE ON SITE

THE OWNER AND/OR CONTRACTOR SHALL COMPLY WITH  
THE ONTARIO BUILDING CODE AND ALL OTHER APPLICABLE LAW

These drawings and/or specifications have been reviewed by

JDL Dec 10/20  
FOR CHIEF BUILDING OFFICIAL DATE

FROM PLAN DATED:

BUILDER: GREENPARK HOMES

SITE: RUSSELL GARDENS PH 3

MODEL: VALLEYCREEK 3

ELEVATION: 1

LOT:

CITY: WATERDOWN

SALESMAN: MARIO DICIANO

DESIGNER: AJ

REVISION:

NOTES:

REFER TO THE NORDIC INSTALLATION GUIDE FOR PROPER STORAGE AND INSTALLATION. **SQUASH BLOCKS** OF 2x4, 2x6, 2x8 #2 S.P.F. REQ'D UNDER INTERIOR UNIFORM LOAD BEARING WALLS. **MULTIPLE SQUASH BLOCKS** REQ'D UNDER CONCENTRATED LOADS. SEE FIGURE 1. **CANTILEVERED JOISTS** INCLUDING **CANT' OVER BRICK** REQ. I-JOIST BLOCKING ALONG BEARING AND RIMBOARD CLOSURE AT ENDS. SEE FIGURE 7 TABLES 4 & 5 FOR REINFORCEMENT REQUIREMENTS. FOR **HOLES** INCLUDING **DUCT CHASE** AND **FIELD CUT OPENINGS** SEE FIGURE 7 TABLES 1 & 2 OF THE INSTALLATION GUIDE. **CERAMIC TILE** APPLICATION AS PER O.B.C. 9.30.6

LOADING:

DESIGN LOADS: L/480.000


LIVE LOAD: 40.0 lb/ft<sup>2</sup>

DEAD LOAD: 20.0 lb/ft<sup>2</sup>

SUBFLOOR: 5/8" GLUED AND NAILED

DATE: 2020-02-21

2nd FLOOR

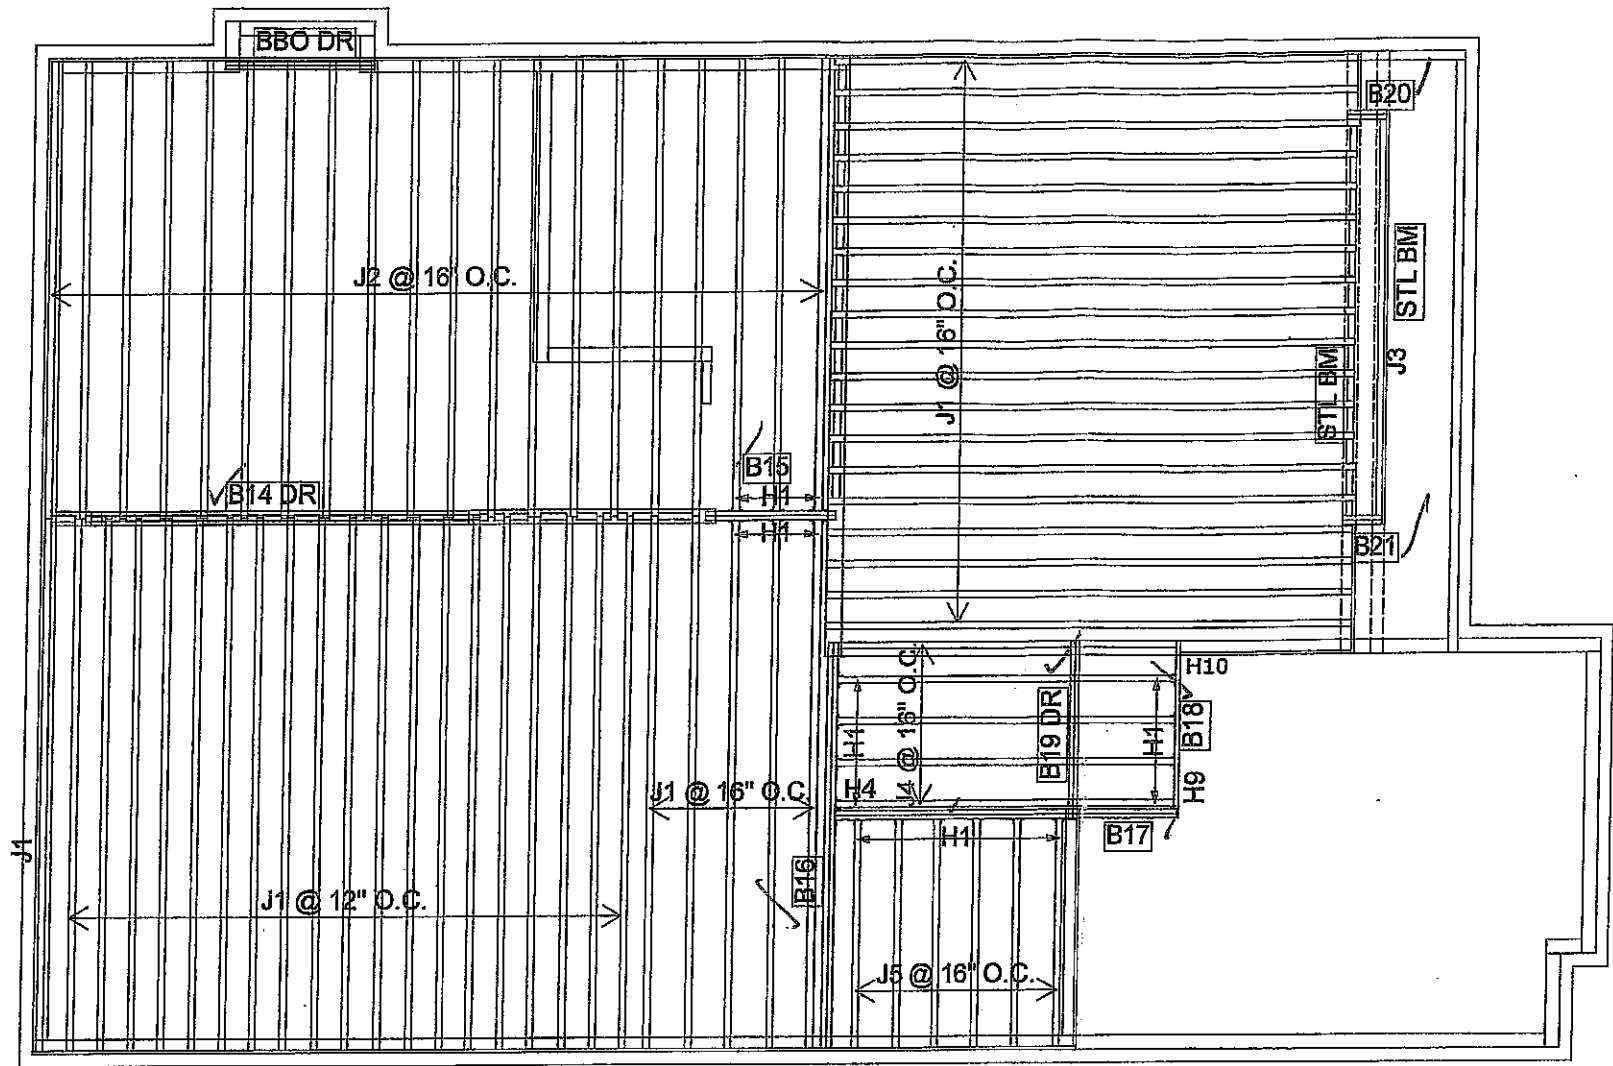

Products					
PlotID	Length	Product	Plies	Net Qty	Fab Type
J1	18-00-00	11 7/8" NI-40x	1	44	MFD
J2	16-00-00	11 7/8" NI-40x	1	20	MFD
J3	14-00-00	11 7/8" NI-40x	1	1	MFD
J4	12-00-00	11 7/8" NI-40x	1	5	MFD
J5	8-00-00	11 7/8" NI-40x	1	6	MFD
B16	14-00-00	1-3/4" x 11-7/8" VERSA-LAM@ 2.0 3100 SP	2	2	MFD
B14 DR	14-00-00	1-3/4" x 11-7/8" VERSA-LAM@ 2.0 3100 SP	3	3	MFD
B17	12-00-00	1-3/4" x 11-7/8" VERSA-LAM@ 2.0 3100 SP	2	2	MFD
B18	6-00-00	1-3/4" x 11-7/8" VERSA-LAM@ 2.0 3100 SP	1	1	MFD
B15	6-00-00	1-3/4" x 11-7/8" VERSA-LAM@ 2.0 3100 SP	2	2	MFD
B19 DR	6-00-00	1-3/4" x 11-7/8" VERSA-LAM@ 2.0 3100 SP	2	2	MFD
B20	2-00-00	1-3/4" x 11-7/8" VERSA-LAM@ 2.0 3100 SP	2	2	MFD
B21	2-00-00	1-3/4" x 11-7/8" VERSA-LAM@ 2.0 3100 SP	2	2	MFD

Connector Summary		
Qty	Manuf	Product
4	H1	IUS2.56/11.88
16	H1	IUS2.56/11.88
1	H4	HGUS410
1	H9	LS90
1	H10	H2.5A*

CITY OF HAMILTON  
Building Division

Permit No. 187710

THESE STAMPED DRAWINGS SHALL BE AVAILABLE ON SITE


THE OWNER AND/OR CONTRACTOR SHALL COMPLY WITH  
THE ONTARIO BUILDING CODE AND ALL OTHER APPLICABLE LAW

These drawings and/or specifications have been reviewed by

JDG  
FOR CHIEF BUILDING OFFICIAL

Dec 10/20  
DATE

CITY OF HAMILTON  
BUILDING DIVISION  
Planning & Development Department  
  
OCT 06 2020  
  
REC BY \_\_\_\_\_ DATE \_\_\_\_\_  
REF'D TO \_\_\_\_\_ DATE \_\_\_\_\_

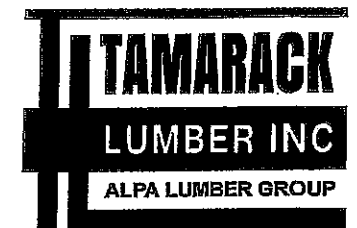

FROM PLAN DATED:

BUILDER: GREENPARK HOMES

SITE: RUSSELL GARDENS PH 3

MODEL: VALLEYCREEK 3

ELEVATION: 2

LOT:

CITY: WATERDOWN

SALESMAN: MARIO DICIANO

DESIGNER: AJ

REVISION:

NOTES:

REFER TO THE NORDIC INSTALLATION GUIDE FOR PROPER STORAGE AND INSTALLATION. **SQUASH BLOCKS** OF 2x4, 2x6, 2x8 #2 S.P.F. REQ'D UNDER INTERIOR UNIFORM LOAD BEARING WALLS. **MULTIPLE SQUASH BLOCKS** REQ'D UNDER CONCENTRATED LOADS. SEE FIGURE 1. **CANTILEVERED JOISTS** INCLUDING **CANT' OVER BRICK** REQ. I-JOIST BLOCKING ALONG BEARING AND RIMBOARD CLOSURE AT ENDS. SEE FIGURE 7 TABLES 4 & 5 FOR REINFORCEMENT REQUIREMENTS. FOR **HOLES** INCLUDING **DUCT CHASE** AND **FIELD CUT OPENINGS** SEE FIGURE 7 TABLES 1 & 2 OF THE INSTALLATION GUIDE. **CERAMIC TILE** APPLICATION AS PER O.B.C. 9.30.6

LOADING:

DESIGN LOADS: L/480.000


LIVE LOAD: 40.0 lb/ft<sup>2</sup>

DEAD LOAD: 20.0 lb/ft<sup>2</sup>

SUBFLOOR: 5/8" GLUED AND NAILED

DATE: 2020-02-21

2nd FLOOR

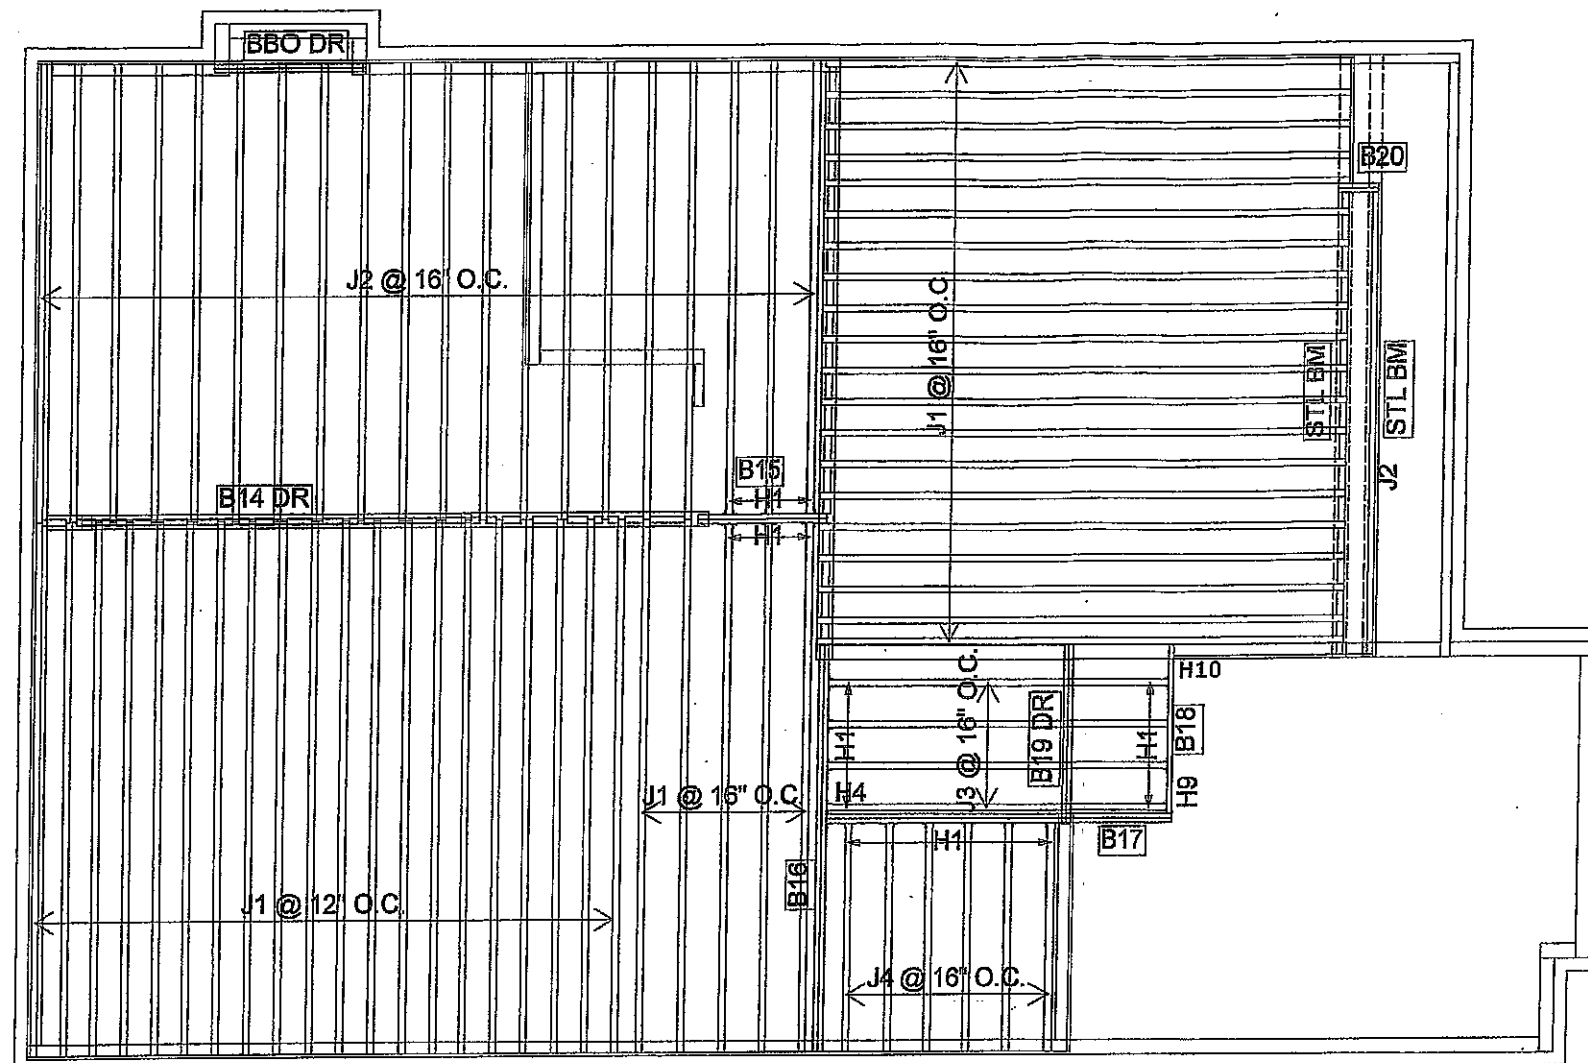

CITY OF HAMILTON  
BUILDING DIVISION  
Planning & Development Department

OC1 06 2020

REC BY \_\_\_\_\_ DATE \_\_\_\_\_  
REF'D TO \_\_\_\_\_ DATE \_\_\_\_\_

Products					
PlotID	Length	Product	Plies	Net Qty	Fab Type
J1	18-00-00	11 7/8" NI-40x	1	45	MFD
J2	16-00-00	11 7/8" NI-40x	1	21	MFD
J3	12-00-00	11 7/8" NI-40x	1	4	MFD
J4	8-00-00	11 7/8" NI-40x	1	6	MFD
B16	14-00-00	1-3/4" x 11-7/8" VERSA-LAM@ 2.0 3100 SP	2	2	MFD
B14 DR	14-00-00	1-3/4" x 11-7/8" VERSA-LAM@ 2.0 3100 SP	3	3	MFD
B17	12-00-00	1-3/4" x 11-7/8" VERSA-LAM@ 2.0 3100 SP	2	2	MFD
B18	6-00-00	1-3/4" x 11-7/8" VERSA-LAM@ 2.0 3100 SP	1	1	MFD
B15	6-00-00	1-3/4" x 11-7/8" VERSA-LAM@ 2.0 3100 SP	2	2	MFD
B19 DR	6-00-00	1-3/4" x 11-7/8" VERSA-LAM@ 2.0 3100 SP	2	2	MFD
B20	2-00-00	1-3/4" x 11-7/8" VERSA-LAM@ 2.0 3100 SP	2	2	MFD

Connector Summary		
Qty	Manuf	Product
4	H1	IUS2.56/11.88
16	H1	IUS2.56/11.88
1	H4	HGUS410
1	H9	LS90
1	H10	H2.5A*

CITY OF HAMILTON  
Building Division

Permit No. 1877-1-18

THESE STAMPED DRAWINGS SHALL BE AVAILABLE ON SITE


THE OWNER AND/OR CONTRACTOR SHALL COMPLY WITH  
THE ONTARIO BUILDING CODE AND ALL OTHER APPLICABLE LAW

These drawings and/or specifications have been reviewed by

SDC  
FOR CHIEF BUILDING OFFICIAL

DATE

Dec 10/20

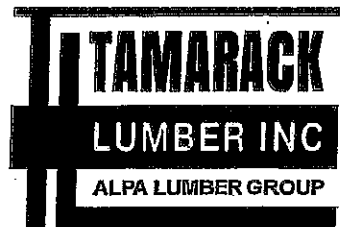

FROM PLAN DATED:

BUILDER: GREENPARK HOMES

SITE: RUSSELL GARDENS PH 3

MODEL: VALLEYCREEK 3

ELEVATION: 3

LOT:

CITY: WATERDOWN

SALESMAN: MARIO DICIANO

DESIGNER: AJ

REVISION:

**NOTES:**  
REFER TO THE NORDIC INSTALLATION GUIDE FOR PROPER STORAGE AND INSTALLATION. **SQUASH BLOCKS** OF 2x4, 2x6, 2x8 #2 S.P.F. REQ'D UNDER INTERIOR UNIFORM LOAD BEARING WALLS. **MULTIPLE SQUASH BLOCKS** REQ'D UNDER CONCENTRATED LOADS. SEE FIGURE 1. **CANTILEVERED JOISTS** INCLUDING **CANT' OVER BRICK** REQ. I-JOIST BLOCKING ALONG BEARING AND RIMBOARD CLOSURE AT ENDS. SEE FIGURE 7 TABLES 4 & 5 FOR REINFORCEMENT REQUIREMENTS. FOR **HOLES** INCLUDING **DUCT CHASE** AND **FIELD CUT OPENINGS** SEE FIGURE 7 TABLES 1 & 2 OF THE INSTALLATION GUIDE. **CERAMIC TILE** APPLICATION AS PER O.B.C. 9.30.6

**LOADING:**

DESIGN LOADS: L/480.000

LIVE LOAD: 40.0 lb/ft<sup>2</sup>

DEAD LOAD: 20.0 lb/ft<sup>2</sup>

**SUBFLOOR:** 5/8" GLUED AND NAILED


DATE: 2020-02-21

**2nd FLOOR**

CITY OF HAMILTON  
BUILDING DIVISION  
Planning & Development Department

OC1 06 2020

REC BY \_\_\_\_\_ DATE \_\_\_\_\_  
CLPD TO \_\_\_\_\_ DATE \_\_\_\_\_

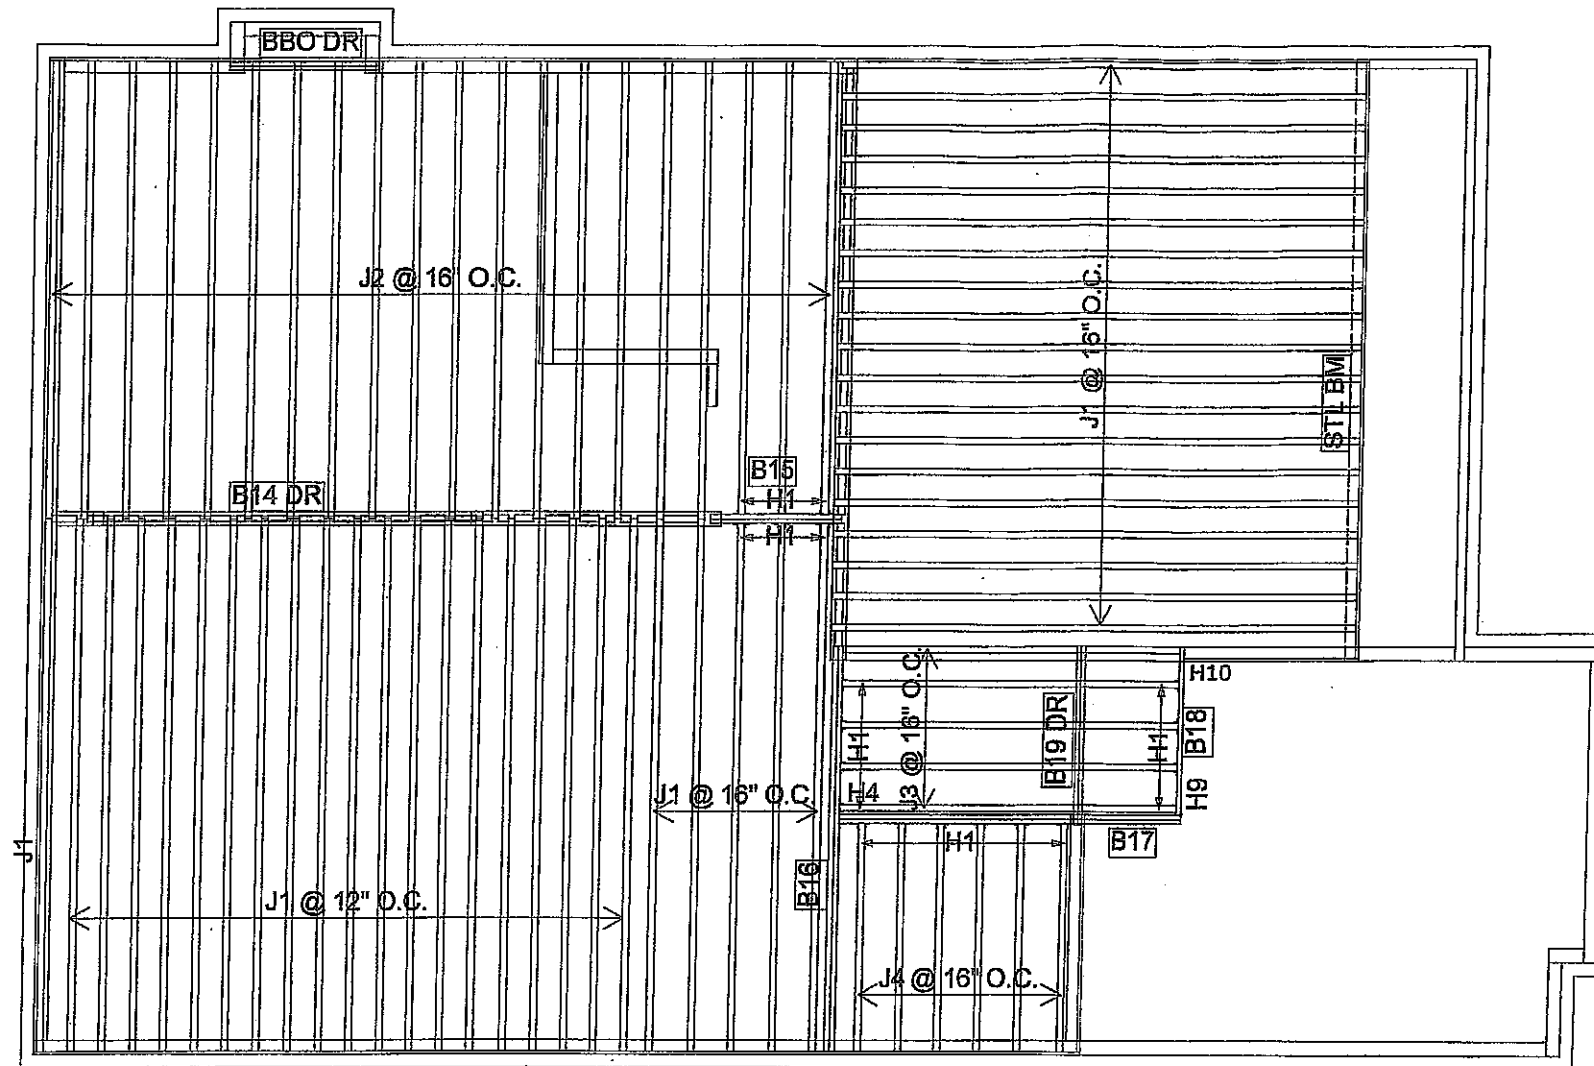

Products					
PlotID	Length	Product	Plies	Net Qty	Fab Type
J1	18-00-00	11 7/8" NI-40x	1	44	MFD
J2	16-00-00	11 7/8" NI-40x	1	20	MFD
J3	12-00-00	11 7/8" NI-40x	1	5	MFD
J4	8-00-00	11 7/8" NI-40x	1	6	MFD
B16	14-00-00	1-3/4" x 11-7/8" VERSA-LAM® 2.0 3100 SP	2	2	MFD
B14 DR	14-00-00	1-3/4" x 11-7/8" VERSA-LAM® 2.0 3100 SP	3	3	MFD
B17	12-00-00	1-3/4" x 11-7/8" VERSA-LAM® 2.0 3100 SP	2	2	MFD
B18	6-00-00	1-3/4" x 11-7/8" VERSA-LAM® 2.0 3100 SP	1	1	MFD
B15	6-00-00	1-3/4" x 11-7/8" VERSA-LAM® 2.0 3100 SP	2	2	MFD
B19 DR	6-00-00	1-3/4" x 11-7/8" VERSA-LAM® 2.0 3100 SP	2	2	MFD

Connector Summary		
Qty	Manuf	Product
4	H1	IUS2.56/11.88
16	H1	IUS2.56/11.88
1	H4	HGUS410
1	H9	LS90
1	H10	H2.5A*

CITY OF HAMILTON  
Building Division

Permit No. 187730

THESE STAMPED DRAWINGS SHALL BE AVAILABLE ON SITE

THE OWNER AND/OR CONTRACTOR SHALL COMPLY WITH  
THE ONTARIO BUILDING CODE AND ALL OTHER APPLICABLE LAW

These drawings and/or specifications have been reviewed by

*JD* Dec 10/20

FOR CHIEF BUILDING OFFICIAL

DATE



Boise Cascade



Double 1-3/4" x 11-7/8" VERSA-LAM® 2.0 3100 SP

PASSED

BC CALC® Member Report

Build 7239

Job name:

Address:

City, Province, Postal Code: WATERDOWN

Customer:

Code reports: CCMC 12472-R

Dry | 1 span | No cant.

March 24, 2020 15:43:43


File name: VALLEYCREEK 3 EL 1 DECK CONDITION.mmdl

Description: 1ST FLR FRAMING\Flush Beams\B30(I5007) (Flush Beam)

Specifier:

Designer: AJ

Company:

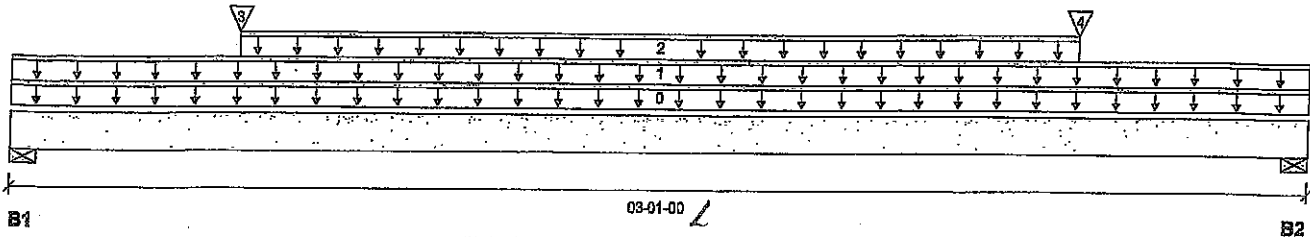

## Reaction Summary (Down / Uplift) (lbs)

Bearing	Live	Dead	Snow	Wind
B1, 3"	90 / 0	197 / 0		
B2, 3"	90 / 0	197 / 0		

## Load Summary

Tag	Description	Load Type	Ref.	Start	End	Loc.	Live 1.00	Dead 0.65	Snow 1.00	Wind 1.15	Tributary
0	Self-Weight	Unf. Lin. (lb/ft)	L	00-00-00	03-01-00	Top		12			00-00-00
1	E13(I1289)	Unf. Lin. (lb/ft)	L	00-00-00	03-01-00	Top	31	102			n/a
2	FC1 Floor Material	Unf. Lin. (lb/ft)	L	00-06-08	02-06-08	Top	27	13			n/a
3	Bk2(I4987)	Conc. Pt. (lbs)	L	00-06-08	00-06-08	Top	16	8			n/a
4	Bk2(I4995)	Conc. Pt. (lbs)	L	02-06-08	02-06-08	Top	16	8			n/a

## Controls Summary

	Factored Demand	Factored Resistance	Demand/ Resistance	Case	Location
Pos. Moment	166 ft-lbs	23005 ft-lbs	0.7%	0	01-06-08
End Shear	124 lbs	14464 lbs	0.9%	1	01-02-14
Total Load Deflection	L/999 (0")	n/a	n/a	4	01-06-08
Live Load Deflection	L/999 (0")	n/a	n/a	5	01-06-08
Max Defl.	0"	n/a	n/a	4	01-06-08
Span / Depth	2.7				



DWG NO. TAN 5511 -20

STRUCTURAL  
COMPONENT ONLY

## Disclosure

Use of the Boise Cascade Software is subject to the terms of the End User License Agreement (EULA). Completeness and accuracy of input must be reviewed and verified by a qualified engineer or other appropriate expert to assure its adequacy, prior to anyone relying on such output as evidence of suitability for a particular application. The output here is based on building code-accepted design properties and analysis methods. Installation of Boise Cascade engineered wood products must be in accordance with current Installation Guide and applicable building codes. To obtain Installation Guide or ask questions, please call (800)232-0788 before installation.

BC CALC®, BC FRAMER®, AJS™, ALLJOIST®, BC RIM BOARD™, BC1®, BOISE GLULAM™, BC FloorValue®, VERSA-LAM®, VERSA-RIM PLUS®

Bearing Supports	Dim. (LxW)	Demand	Demand/ Resistance Support	Demand/ Resistance Member	Material
B1	Wall/Plate 3" x 3-1/2"	276 lbs	6.6%	3.3%	Spruce-Pine-Fir
B2	Wall/Plate 3" x 3-1/2"	276 lbs	6.6%	3.3%	Spruce-Pine-Fir

## Notes

Design meets Code minimum (L/240) Total load deflection criteria.

Design meets Code minimum (L/360) Live load deflection criteria.

Calculations assume member is fully braced.

Resistance Factor  $\phi$  has been applied to all presented results per CSA O86.

BC CALC® analysis is based on Canadian Limit States Design, as per NBCC 2015 and CSA O86.


Design based on Dry Service Condition.

Importance Factor: Normal Part code: Part 9

CONFORMS TO CBC 2012

AMENDED 2020

PROVIDE 3 ROWS OF 3 1/2" ARDOX SPIRAL NAILS @ 8" O/C FOR MULTI-PLY NAILING. MAINTAIN A MIN. 2" LUMBER EDGE/END DISTANCE. DO NOT USE AIR NAILS

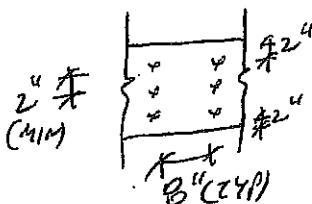



# NORDIC STRUCTURES

COMPANY  
Feb. 19, 2020 09:13


PROJECT  
J1 2ND FLOOR.wwb

## Design Check Calculation Sheet Nordic Sizer - Canada 7.2

### Loads:

Load	Type	Distribution	Pat- tern	Location [ft] Start End	Magnitude Start End	Unit
Load1	Dead	Full Area			20.00	psf
Load2	Live	Full Area			40.00	psf

### Maximum Reactions (lbs) and Support Bearing (in):

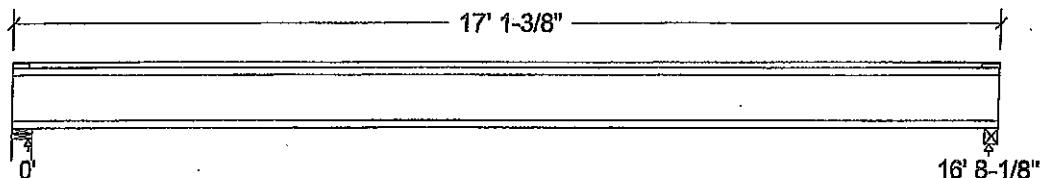

Unfactored:			
Dead	222		222
Live	445		445
Factored:			
Total	945		945
Bearing:			
Capacity			
Joist	2336		2138
Support	7735		4043
Des ratio			
Joist	0.40		0.44
Support	0.12		0.23
Load case	#2		#2
Length	4-3/8		2-5/8
Min req'd	1-3/4		1-3/4
Stiffener	No		No
KD	1.00		1.00
KB support	-		1.00
fcp sup	769		769
Kzcp sup	-		1.00

Bearing for wall supports is perpendicular-to-grain bearing on top plate. No stud design included.

### Nordic Joist 11-7/8" NI-40x Floor joist @ 16" o.c.


Supports: 1 - Lumber Wall, No.1/No.2; 2 - Lumber Beam, No.1/No.2;

Total length: 17' 1-3/8"; Clear span: 16' 6-3/8"; 5/8" nailed and glued OSB sheathing with 1/2" gypsum ceiling

This section PASSES the design code check.

### Limit States Design using CSA-O86-09 and Vibration Criterion:

Criterion	Analysis Value	Design Value	Unit	Analysis/Design
Shear	Vf = 945	Vr = 2336	lbs	Vf/Vr = 0.40
Moment (+)	Mf = 3940	Mr = 6255	lbs-ft	Mf/Mr = 0.63
Perm. Defl'n	0.12 = < L/999	0.56 = L/360	in	0.21
Live Defl'n	0.24 = L/847	0.42 = L/480	in	0.57
Total Defl'n	0.35 = L/564	0.83 = L/240	in	0.42
Bare Defl'n	0.28 = L/717	0.56 = L/360	in	0.50
Vibration	Lmax = 16'-8.1	Lv = 17'-8.1	ft	0.94
Defl'n	= 0.032	= 0.038	in	0.83

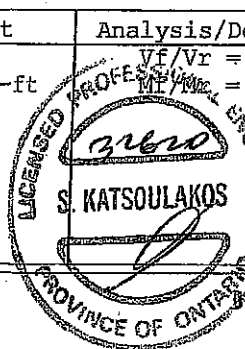

NO. YAM 5492-20  
STRUCTURAL  
COMPONENT ONLY

**Additional Data:**

FACTORS:	f/E	KD	KH	KZ	KL	KT	KS	KN	LC#
Vr	2336	1.00	1.00	-	-	-	-	-	#2
Mr+	6255	1.00	1.00	-	1.000	-	-	-	#2
EI	371.1 million	-	-	-	-	-	-	-	#2

**CRITICAL LOAD COMBINATIONS:**

Shear : LC #2 = 1.25D + 1.5L

Moment(+) : LC #2 = 1.25D + 1.5L

Deflection: LC #1 = 1.0D (permanent)

LC #2 = 1.0D + 1.0L (live)

LC #2 = 1.0D + 1.0L (total)

LC #2 = 1.0D + 1.0L (bare joist)

Bearing : Support 1 - LC #2 = 1.25D + 1.5L

Support 2 - LC #2 = 1.25D + 1.5L

Load Types: D=dead W=wind S=snow H=earth, groundwater E=earthquake  
L=live (use, occupancy) Ls=live (storage, equipment) f=fire

Load Patterns: s=S/2 L=L+Ls =no pattern load in this span

All Load Combinations (LCs) are listed in the Analysis output

**CALCULATIONS:**E<sub>I</sub>eff = 447.63 lb-in<sup>2</sup> K= 6.18e06 lbs

"Live" deflection is due to all non-dead loads (live, wind, snow...)

CONFORMS TO UBC 2012

AMENDED 2020

**Design Notes:**

1. WoodWorks analysis and design are in accordance with the 2010 National Building Code of Canada (NBC), Division B, Part 4, and the CSA O86-09 Engineering Design in Wood standard, which includes Update No.1
2. Please verify that the default deflection limits are appropriate for your application.
3. Refer to Nordic Structures technical documentation for installation guidelines and construction details.
4. Nordic I-joists are listed in CCMC evaluation report 13032-R.
5. Joists shall be laterally supported at supports and continuously along the compression edge.
6. The design assumptions and specifications have been provided by the client. Any damages resulting from faulty or incorrect information, specifications, and/or designs furnished, and the correctness or accuracy of this information is their responsibility. This analysis does not constitute a record of the structural integrity of the building nor suitability of the design assumptions made. Nordic Structures is responsible only for the structural adequacy of this component based on the design criteria and loadings shown.



10/26  
 DWG NO. YAW 5482-20  
 STRUCTURAL  
 COMPONENT ONLY



Boise Cascade



Triple 1-3/4" x 11-7/8" VERSA-LAM® 2.0 3100 SP

PASSED

2ND FLR FRAMING\Dropped Beams\B14 DR(I3211)\Dropped Beam)

Dry | 1 span | No cant.

February 19, 2020 08:54:40

BC CALC® Member Report

Build 7239

Job name:

Address:

City, Province, Postal Code: WATERDOWN

Customer:

Code reports: CCMC 12472-R


File name: VALLEYCREEK 3 EL 1.mmd

Description: 2ND FLR FRAMING\Dropped Beams\B14 DR(I3211)

Specifier:

Designer: AJ

Company:

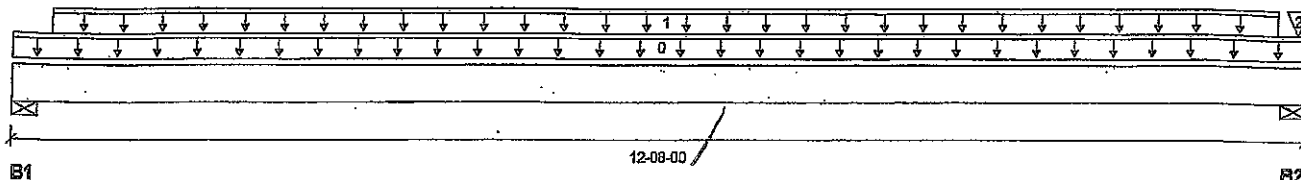

Total Horizontal Product Length = 12-08-00

## Reaction Summary (Down / Uplift) (lbs)

Bearing	Live	Dead	Snow	Wind
B1, 4"	3849 / 0	2042 / 0		
B2, 4"	4038 / 0	2135 / 0		

## Load Summary

Tag	Description	Load Type	Ref.	Start	End	Loc.	Live	Dead	Snow	Wind	Tributary
0	Self-Weight	Unf. Lin. (lb/ft)	L	00-00-00	12-08-00	Top	1.00	0.65	1.00	1.15	00-00-00
1	Smoothed Load	Unf. Lin. (lb/ft)	L	00-04-08	12-04-08	Top	629	315			n/a
2	J1(I3750)	Conc. Pt. (lbs)	L	12-06-14	12-06-14	Top	339	169			n/a

## Controls Summary

	Factored Demand	Factored Resistance	Demand/Resistance	Case	Location
Pos. Moment	25143 ft-lbs	55212 ft-lbs	45.5%	1	06-04-08
End Shear	7518 lbs	21696 lbs	34.7%	1	01-03-14
Total Load Deflection	L/454 (0.32")	n/a	52.8%	4	06-04-08
Live Load Deflection	L/895 (0.209")	n/a	51.8%	5	06-04-08
Max Defl.	0.32"	n/a	n/a	4	06-04-08
Span / Depth	12.3				



## Bearing Supports

	Dim. (LxW)	Demand	Demand/Resistance Support	Demand/Resistance Member	Material
B1	Wall/Plate 4" x 5-1/4"	8327 lbs	29.7%	32.5%	Spruce-Pine-Fir
B2	Wall/Plate 4" x 5-1/4"	8726 lbs	31.1%	34.1%	Spruce-Pine-Fir

DWG NO. TAM5503 -20  
STRUCTURAL  
COMPONENT ONLY

## Notes

Design meets Code minimum (L/240) Total load deflection criteria.

Design meets Code minimum (L/360) Live load deflection criteria.

Calculations assume unbraced length of Top: 00-03-02, Bottom: 00-03-02.

Resistance Factor phi has been applied to all presented results per CSA O86.

BC CALC® analysis is based on Canadian Limit States Design, as per NBCC 2015 and CSA O86.

Design based on Dry Service Condition.


Importance Factor : Normal Part code : Part 9

CONFORMS TO OBC 2012

AMENDED 2020

## Disclosure

Use of the Boise Cascade Software is subject to the terms of the End User License Agreement (EULA). Completeness and accuracy of input must be reviewed and verified by a qualified engineer or other appropriate expert to assure its adequacy, prior to anyone relying on such output as evidence of suitability for a particular application. The output here is based on building code-accepted design properties and analysis methods. Installation of Boise Cascade engineered wood products must be in accordance with current Installation Guide and applicable building codes. To obtain Installation Guide or ask questions, please call (800)232-0788 before installation.

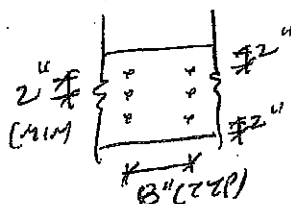

PROVIDE 3 ROWS OF 3/4" ARDOX SPIRAL NAILS @ 8" O/C FOR MULTI-PLY NAILING, MAINTAIN A MIN. 2" LUMBER EDGE/END DISTANCE. DO NOT USE AIR NAILS. STAGGER NAILS 4" BETWEEN PLYS.

BC CALC®, BC FRAMER®, AJS™, ALLJOIST®, BC RIM BOARD™, BCIO®, BOISE GLULAM™, BC FloorValue®, VERSA-LAM®, VERSA-RIM PLUS®,



Boise Cascade



Double 1-3/4" x 11-7/8" VERSA-LAM® 2.0 3100 SP

PASSED

2ND FLR FRAMING\Dropped Beams\B19 DR(i3169) (Dropped Beam)

Dry | 1 span | No girt.

February 19, 2020 08:54:40

BC CALC® Member Report

Build 7239

Job name:

File name: VALLEYCREEK 3 EL 1.mmdl

Address:

Description: 2ND FLR FRAMING\Dropped Beams\B19 DR(i3169)

City, Province, Postal Code: WATERDOWN

Specifier:


Customer:

Designer: AJ

Code reports:

CCMC 12472-R

Company:

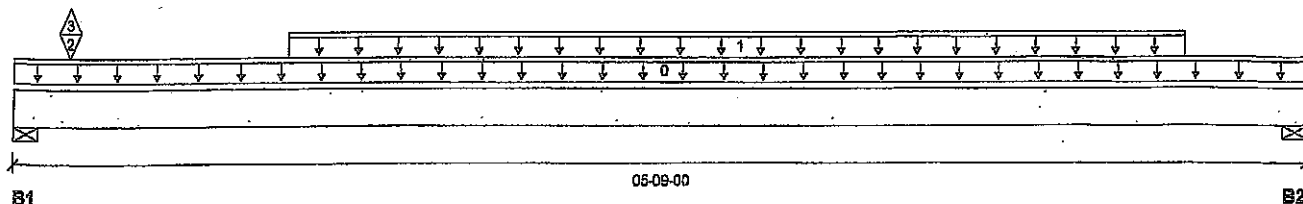

Total Horizontal Product Length = 05-09-00

## Reaction Summary (Down / Uplift) (lbs)

Bearing	Live	Dead	Snow	Wind
B1, 4"	2180 / 234	1128 / 0		
B2, 5-1/2"	759 / 0	414 / 0		

## Load Summary

Tag	Description	Load Type	Ref.	Start	End	Loc.	Live	Dead	Snow	Wind	Tributary
0	Self-Weight	Unf. Lin. (lb/ft)	L	00-00-00	05-09-00	Top	1.00	0.65	1.00	1.15	00-00-00
1	Smoothed Load	Unf. Lin. (lb/ft)	L	01-02-08	05-02-08	Top	322	161			n/a
2	-	Conc. Pt. (lbs)	L	00-03-01	00-03-01	Top	1652	831			n/a
3	-	Conc. Pt. (lbs)	L	00-03-01	00-03-01	Top	-234				n/a

Controls Summary	Factored Demand	Factored Resistance	Demand/Resistance	Case	Location
Pos. Moment	2289 ft-lbs	35392 ft-lbs	6.5%	1	03-02-08
End Shear	1413 lbs	14464 lbs	9.8%	1	04-03-10
Total Load Deflection	L/999 (0.008")	n/a	n/a	6	02-09-08
Live Load Deflection	L/999 (0.005")	n/a	n/a	8	02-09-08
Max Defl.	0.008"	n/a	n/a	6	02-09-08
Span / Depth	5.1				

Bearing Supports	Dim. (LxW)	Demand	Demand/Resistance Support	Demand/Resistance Member	Material
B1	Wall/Plate 4" x 3-1/2"	4681 lbs	25.1%	27.4%	Spruce-Pine-Fir
B2	Wall/Plate 5-1/2" x 3-1/2"	1655 lbs	6.4%	7.0%	Spruce-Pine-Fir

## Notes

Design meets Code minimum (L/240) Total load deflection criteria.

Design meets Code minimum (L/360) Live load deflection criteria.

Calculations assume unbraced length of Top: 01-01-08, Bottom: 01-01-08.

Resistance Factor phi has been applied to all presented results per CSA O86.


BC CALC® analysis is based on Canadian Limit States Design, as per NBCC 2015 and CSA O86.

Design based on Dry Service Condition.

Importance Factor : Normal Part code : Part 9

CONFORMS TO OBC 2012

AMENDED 2020

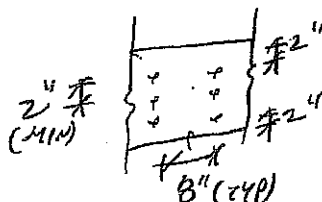

PROVIDE 3 ROWS OF 3/4" ARDOX SPIRAL NAILS @ 8" O/C FOR MULTI-PLY NAILING, MAINTAIN A MIN. 2" LUMBER EDGE/END DISTANCE. DO NOT USE AIR NAILS



ONE NO. 1AM 5504 -20  
STRUCTURAL  
COMPONENT ONLY

## Disclosure

Use of the Boise Cascade Software is subject to the terms of the End User License Agreement (EULA). Completeness and accuracy of input must be reviewed and verified by a qualified engineer or other appropriate expert to assure its adequacy, prior to anyone relying on such output as evidence of suitability for a particular application. The output here is based on building code-accepted design properties and analysis methods. Installation of Boise Cascade engineered wood products must be in accordance with current Installation Guide and applicable building codes. To obtain Installation Guide or ask questions, please call (800)232-0788 before installation.

BC CALC®, BC FRAMER®, AJS™, ALLJOIST®, BC RIM BOARD™, BC®, BOISE GLULAM™, BC FloorValue®, VERSA-LAM®, VERSA-RIM PLUS®,



**2ND FLR FRAMING\Flush Beams\B15(j8358) (Flush Beam)**

BC CALC®, BC FRAMER®, AJS™,  
ALLJOIST®, BC RIM BOARD™, BCi®,  
BOISE GLULAM™, BC FloorValue®,  
VERSA-LAM®, VERSA-RIM PLUS®.



✓ Double 1-3/4" x 11-7/8" VERSA-LAM® 2.0 3100 SP

**PASSED**

2ND FLR FRAMING\Flush Beams\B16\3235) (Flush Beam)

Dry | 1 span | No cant

February 19, 2020 08:54:40

BC CALC® Member Report

Build 7239

Job name:

File name: VALLEYCREEK 3 EL 1.mmdl

Address:

Description: 2ND FLR FRAMING\Flush Beams\B16\3235)

City, Province, Postal Code: WATERDOWN

Specifier:


Customer:

Designer: AJ

Code reports:

CCMC 12472-R

Company:

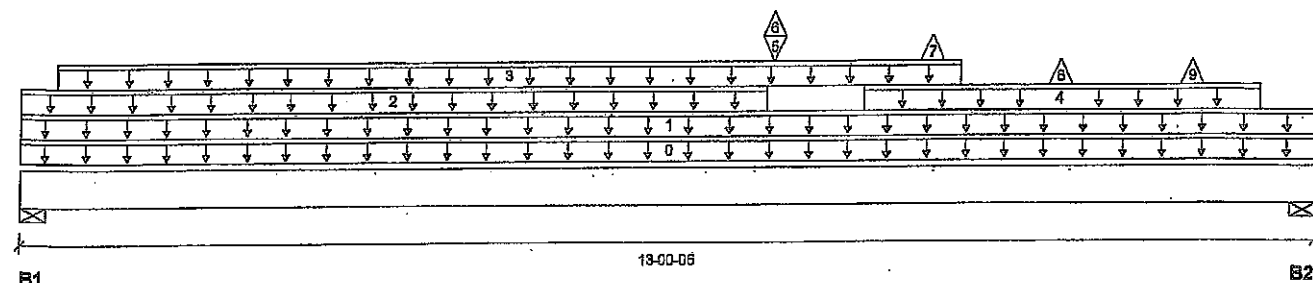


Total Horizontal Product Length = 13-00-06

### Reaction Summary (Down / Uplift) (lbs)

Bearing	Live	Dead	Snow	Wind
B1, 4-3/8"	527 / 77	672 / 0		
B2, 5-1/2"	939 / 113	734 / 0		

### Load Summary

Tag	Description	Load Type	Ref.	Start	End	Loc.	Live	Dead	Snow	Wind	Tributary
0	Self-Weight	Unf. Lin. (lb/ft)	L	00-00-00	13-00-06	Top	12				00-00-00
1	FC2 Floor Material	Unf. Lin. (lb/ft)	L	00-00-00	13-00-06	Top	10	5			n/a
2	FC2 Floor Material	Unf. Lin. (lb/ft)	L	00-00-00	07-05-10	Top	17	9			n/a
3	WALL	Unf. Lin. (lb/ft)	L	00-04-06	09-05-06	Top		60			n/a
4	Smoothed Load	Unf. Lin. (lb/ft)	L	08-05-14	12-05-14	Top	135	66			n/a
5	-	Conc. Pt. (lbs)	L	07-06-08	07-06-08	Top	673	31			n/a
6	-	Conc. Pt. (lbs)	L	07-06-08	07-06-08	Top	-181				n/a
7	J3(i3270)	Conc. Pt. (lbs)	L	09-01-14	09-01-14	Top	-3				n/a
8	J3(i3269)	Conc. Pt. (lbs)	L	10-05-14	10-05-14	Top	-3				n/a
9	J3(i3268)	Conc. Pt. (lbs)	L	11-09-14	11-09-14	Top	-3				n/a

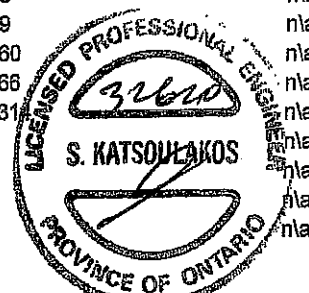

DWG NO. TAM5506 -20

STRUCTURAL

COMPONENT ONLY

### Disclosure

Use of the Boise Cascade Software is subject to the terms of the End User License Agreement (EULA). Completeness and accuracy of input must be reviewed and verified by a qualified engineer or other appropriate expert to assure its adequacy, prior to anyone relying on such output as evidence of suitability for a particular application. The output here is based on building code-accepted design properties and analysis methods. Installation of Boise Cascade engineered wood products must be in accordance with current Installation Guide and applicable building codes. To obtain Installation Guide or ask questions, please call (800)232-0788 before installation.

BC CALC®, BC FRAMER®, AJS™, ALLJOIST®, BC RIM BOARD™, BCi®, BOISE GLULAM™, BC FloorValue®, VERSA-LAM®, VERSA-RIM PLUS®,

### Controls Summary

	Factored Demand	Factored Resistance	Demand/Resistance	Case	Location
Pos. Moment	7794 ft-lbs	35392 ft-lbs	22.0%	1	07-05-10
End Shear	2182 lbs	14464 lbs	15.1%	1	11-07-00
Total Load Deflection	L/1040 (0.142")	n/a	23.1%	6	06-08-07
Live Load Deflection	L/999 (0.074")	n/a	n/a	8	06-10-12
Max Defl.	0.142"	n/a	n/a	6	06-08-07
Span / Depth	12.5				

Bearing Supports	Dim. (LxW)	Demand	Demand/Resistance Support	Demand/Resistance Member	Material
B1	Wall/Plate 4-3/8" x 3-1/2"	1630 lbs	17.3%	8.7%	Spruce-Pine-Fir
B2	Wall/Plate 5-1/2" x 3-1/2"	2325 lbs	19.6%	9.9%	Spruce-Pine-Fir

### Notes

Design meets Code minimum (L/240) Total load deflection criteria.

Design meets Code minimum (L/360) Live load deflection criteria.

Calculations assume member is fully braced.

Resistance Factor phi has been applied to all presented results per CSA O86.

BC CALC® analysis is based on Canadian Limit States Design, as per NBCC 2015 and CSA O86.


Design based on Dry Service Condition.

Importance Factor: Normal Part code: Part 9

CONFORMS TO CBC 2012

AMENDED 2020

PROVIDE 3 ROWS OF 3/4" ARDDX SPIRAL NAILS @ 12" O/C FOR MULTI-PLY NAILING. MAINTAIN A MIN. 2" LUMBER EDGE/END DISTANCE. DO NOT USE AIR NAILS

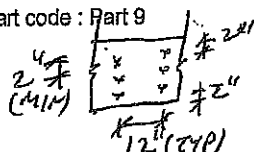



Boise Cascade

**Double 1-3/4" x 11-7/8" VERSA-LAM® 2.0 3100 SP****2ND FLR FRAMING\Flush Beams\B17(i3222)\(Flush Beam)****PASSED**

BC CALC® Member Report

Build 7239

Job name:

Address:

City, Province, Postal Code: WATERDOWN

Customer:

Code reports: CCMC 12472-R

Dry | 2 spans | R cant.

February 19, 2020 08:54:40


File name: VALLEYCREEK 3 EL 1.mmdl

Description: 2ND FLR FRAMING\Flush Beams\B17(i3222)

Specifier:

Designer: AJ

Company:

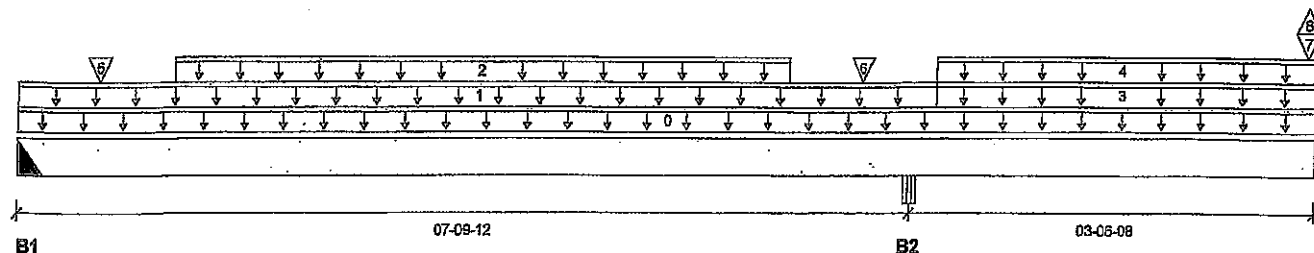**Reaction Summary (Down / Uplift) (lbs)**

Bearing	Live	Dead	Snow	Wind
B1, 4"	652 / 190	264 / 0		
B2, 3-1/2"	1367 / 235	687 / 0		

**Load Summary**

Tag	Description	Load Type	Ref.	Start	End	Loc.	Live 1.00	Dead 0.65	Snow 1.00	Wind 1.15	Tributary
0	Self-Weight	Unf. Lin. (lb/ft)	L	00-00-00	11-04-04	Top		12			00-00-00
1	FC2 Floor Material	Unf. Lin. (lb/ft)	L	00-00-00	08-00-08	Top	7	4			n/a
2	Smoothed Load	Unf. Lin. (lb/ft)	L	01-04-08	06-08-08	Top	146	73			n/a
3	STAIR	Unf. Lin. (lb/ft)	L	08-00-08	11-04-04	Top	120	60			n/a
4	FC2 Floor Material	Unf. Lin. (lb/ft)	L	08-00-08	11-04-04	Top	10	5			n/a
5	J5(i3257)	Conc. Pt. (lbs)	L	00-08-08	00-08-08	Top	160	80			n/a
6	J5(i3262)	Conc. Pt. (lbs)	L	07-04-08	07-04-08	Top	144	72			n/a
7	B18(i3204)	Conc. Pt. (lbs)	L	11-03-06	11-03-06	Top	179	24			n/a
8	B18(i3204)	Conc. Pt. (lbs)	L	11-03-06	11-03-06	Top	-161				n/a

**Controls Summary**

	Factored Demand	Factored Resistance	Demand/Resistance	Case	Location
Pos. Moment	2448 ft-lbs	35392 ft-lbs	6.9%	3	04-06-08
Neg. Moment	-2856 ft-lbs	-35392 ft-lbs	8.1%	1	07-09-12
End Shear	1056 lbs	14464 lbs	7.3%	3	01-03-14
Cont. Shear	1384 lbs	14464 lbs	9.6%	1	06-08-02
Total Load Deflection	2xL/1998 (0.034")	n/a	n/a	13	11-04-04
Live Load Deflection	2xL/1998 (0.032")	n/a	n/a	17	11-04-04
Total Neg. Defl.	2xL/1998 (-0.027")	n/a	n/a	12	11-04-04
Max Defl.	0.018"	n/a	n/a	12	04-00-08
Span / Depth	7.6				

**Bearing Supports**

	Dim. (LxW)	Demand	Demand/Resistance Support	Demand/Resistance Member	Material
B1	Hanger 4" x 3-1/2"	1307 lbs	n/a	7.7%	HGUS410
B2	Beam 3-1/2" x 3-1/2"	2908 lbs	19.5%	19.5%	VL 2.0 3100 SP

**Cautions**

Header for the hanger HGUS410 at B1 is a Double 1-3/4" x 11-7/8" VERSA-LAM® 1.7 2400 DF.

Hanger model HGUS410 and seat length were input by the user. Hanger has not been analyzed for adequate capacity.

Long Cantilever: Sheathing required on bottom flange and adjacent back span or bracing designed by the design professional of record. Design professional of record must address uplift at supports.



ENG NO. YAM 5507 -20  
**STRUCTURAL**  
 COMPONENT ONLY



Boise Cascade



# Double 1-3/4" x 11-7/8" VERSA-LAM® 2.0 3100 SP 2ND FLR FRAMING\Flush Beams\B17\I3222) (Flush Beam)

**PASSED**

BC CALC® Member Report

Dry | 2 spans | R cant.

February 19, 2020 08:54:40

Build 7239

Job name:

File name: VALLEYCREEK 3 EL 1.mmdl

Address:

Description: 2ND FLR FRAMING\Flush Beams\B17\I3222)

City, Province, Postal Code: WATERDOWN

Specifier:

Customer:

Designer: AJ

Code reports: CCMC 12472-R

Company:

## Notes

Design meets User specified (2xL/240) Total load deflection criteria.

Design meets User specified (2xL/360) Live load deflection criteria.

Calculations assume member is fully braced.

Hanger Manufacturer: Unassigned

CONFORMS TO OBC 2012

Resistance Factor phi has been applied to all presented results per CSA O86.


AMENDED 2020

BC CALC® analysis is based on Canadian Limit States Design, as per NBCC 2015 and CSA O86.

Design based on Dry Service Condition.

Importance Factor : Normal Part code : Part 9

Cantilevers require sheathed bottom flanges, blocking at cantilever support and closure at ends.

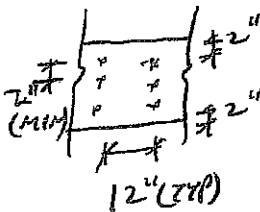

PROVIDE 3 ROWS OF 3/4" ARBOX  
SPIRAL NAILS @ 12" O/C FOR  
MULTI-PLY NAILING, MAINTAIN  
A MIN. 2" LUMBER EDGE/END  
DISTANCE. DO NOT USE AIR NAILS



ENG. NO. TAM 5507 -20  
STRUCTURAL  
COMPONENT ONLY

## Disclosure

Use of the Boise Cascade Software is subject to the terms of the End User License Agreement (EULA). Completeness and accuracy of input must be reviewed and verified by a qualified engineer or other appropriate expert to assure its adequacy, prior to anyone relying on such output as evidence of suitability for a particular application. The output here is based on building code-accepted design properties and analysis methods. Installation of Boise Cascade engineered wood products must be in accordance with current Installation Guide and applicable building codes. To obtain Installation Guide or ask questions, please call (800)232-0788 before installation.

BC CALC®, BC FRAMER®, AJS™, ALLJOIST®, BC RIM BOARD™, BCI®, BOISE GLULAM™, BC FloorValue®, VERSA-LAM®, VERSA-RIM PLUS®,





Boise Cascade



# Single 1-3/4" x 11-7/8" VERSA-LAM® 2.0 3100 SP 2ND FLR FRAMING\Flush Beams\B18(i3204) (Flush Beam)

**PASSED**

BC CALC® Member Report

Dry | 1 span | No cant.

February 19, 2020 08:54:40

Build 7239

Job name:

File name: VALLEYCREEK 3 EL 1.mmdl

Address:

Description: 2ND FLR FRAMING\Flush Beams\B18(i3204)

City, Province, Postal Code: WATERDOWN

Specifier:


Customer:

Designer: AJ

Code reports:

CCMC 12472-R

Company:

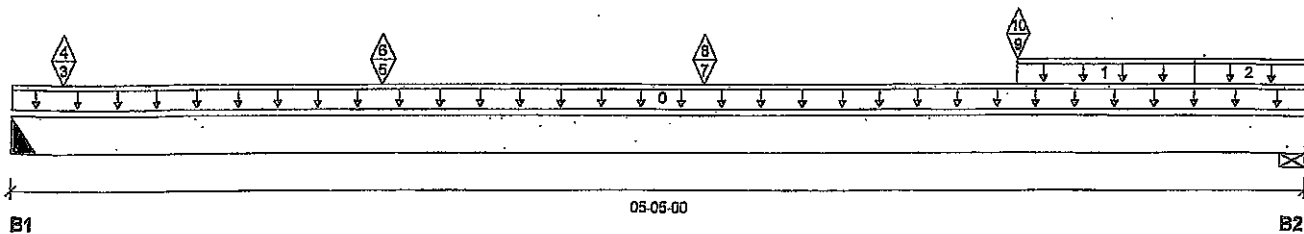

Total Horizontal Product Length = 05-05-00

**Reaction Summary (Down / Uplift) (lbs)**

Bearing	Live	Dead	Snow	Wind
B1, 2"	180 / 162	25 / 0		
B2, 5-1/2"	158 / 143	25 / 0		

**Load Summary**

Tag	Description	Load Type	Ref.	Start	End	Loc.	Live 1.00	Dead 0.65	Snow 1.00	Wind 1.15	Tributary
0	Self-Weight	Unf. Lin. (lb/ft)	L	00-00-00	05-05-00	Top		6			00-00-00
1	FC2 Floor Material	Unf. Lin. (lb/ft)	L	04-02-08	04-11-08	Top		1			n/a
2	FC2 Floor Material	Unf. Lin. (lb/ft)	L	04-11-08	05-05-00	Top		2			n/a
3	J3(i3360)	Conc. Pt. (lbs)	L	00-02-08	00-02-08	Top	62	4			n/a
4	J3(i3360)	Conc. Pt. (lbs)	L	00-02-08	00-02-08	Top	-53				n/a
5	J3(i3270)	Conc. Pt. (lbs)	L	01-06-08	01-06-08	Top	91	4			n/a
6	J3(i3270)	Conc. Pt. (lbs)	L	01-06-08	01-06-08	Top	-84				n/a
7	J3(i3269)	Conc. Pt. (lbs)	L	02-10-08	02-10-08	Top	91	4			n/a
8	J3(i3269)	Conc. Pt. (lbs)	L	02-10-08	02-10-08	Top	-84				n/a
9	J3(i3268)	Conc. Pt. (lbs)	L	04-02-08	04-02-08	Top	90	3			n/a
10	J3(i3268)	Conc. Pt. (lbs)	L	04-02-08	04-02-08	Top	-84				n/a

**Controls Summary**

	Factored Demand	Factored Resistance	Demand/Resistance	Case	Location
Pos. Moment	351 ft-lbs	17696 ft-lbs	2.0%	1	02-10-08
Neg. Moment	-268 ft-lbs	-17696 ft-lbs	1.5%	4	02-10-08
End Shear	220 lbs	7232 lbs	3.0%	1	03-11-10
Total Load Deflection	L/999 (0.002")	n/a	n/a	6	02-07-00
Live Load Deflection	L/999 (0.002")	n/a	n/a	8	02-07-00
Total Neg. Defl.	L/999 (-0.001")	n/a	n/a	7	02-07-00
Max Defl.	0.002"	n/a	n/a	6	02-07-00
Span / Depth	5.0				

Bearing Supports			Dim. (LxW)	Demand	Demand/ Resistance Support	Demand/ Resistance Member	Material
B1	Hanger	2" x 1-3/4"		300 lbs	n/a	7.0%	LS90
B1	Uplift			221 lbs			
B2	Wall/Plate	5-1/2" x 1-3/4"		268 lbs	4.5%	2.3%	Spruce-Pine-Fir
B2	Uplift			192 lbs			



DWG NO. TAM 5508 -20  
STRUCTURAL  
COMPONENT ONLY



Single 1-3/4" x 11-7/8" VERSA-LAM® 2.0 3100 SP  
2ND FLR FRAMING\Flush Beams\B18(i3204) (Flush Beam)

PASSED

BC CALC® Member Report  
Build 7239

Dry | 1 span | No cant.

February 19, 2020 08:54:40

Job name:

File name: VALLEYCREEK 3 EL 1.mmdl

Address:

Description: 2ND FLR FRAMING\Flush Beams\B18(i3204)

City, Province, Postal Code: WATERDOWN

Specifier:

Customer:

Designer: AJ

Code reports: CCMC 12472-R

Company:

### Cautions

Uplift of 221 lbs found at bearing B1.

Hanger B1 cannot handle uplift of -221 lbs

*(SIMPSON H25A FL90 @ B1)*

Header for the hanger LS90 at B1 is a Double 1-3/4" x 11-7/8" VERSA-LAM® 1.7 2400 DF.

Hanger model LS90 and seat length were input by the user. Hanger has not been analyzed for adequate capacity.

### Notes

Design meets Code minimum (L/240) Total load deflection criteria.

Design meets Code minimum (L/360) Live load deflection criteria.

Calculations assume member is fully braced.

Hanger Manufacturer: Unassigned

Resistance Factor phi has been applied to all presented results per CSA O86.

BC CALC® analysis is based on Canadian Limit States Design, as per NBCC 2015 and CSA O86.

Design based on Dry Service Condition.

Importance Factor : Normal Part code : Part 9

CONFORMS TO NBC 2012

AMENDED 2020



DOB NO. YAW 5508-20  
STRUCTURAL  
COMPONENT ONLY

### Disclosure

Use of the Boise Cascade Software is subject to the terms of the End User License Agreement (EULA).

Completeness and accuracy of input must be reviewed and verified by a qualified engineer or other appropriate expert to assure its adequacy, prior to anyone relying on such output as evidence of suitability for a particular application. The output here is based on building code-accepted design properties and analysis methods.

Installation of Boise Cascade engineered wood products must be in accordance with current Installation Guide and applicable building codes. To obtain Installation Guide or ask questions, please call (800)232-0788 before installation.

BC CALC®, BC FRAMER®, AJS™,  
ALLJOIST®, BC RIM BOARD™, BCi®,  
BOISE GLULAM™, BC FloorValue®,  
VERSA-LAM®, VERSA-RIM PLUS®,



Boise Cascade



# Double 1-3/4" x 11-7/8" VERSA-LAM® 2.0 3100 SP 2ND FLR FRAMING\Flush Beams\B20(i3182) (Flush Beam)

**PASSED**

BC CALC® Member Report  
Build 7239

Dry | 1 span | No cant.

February 19, 2020 08:54:40

Job name:

File name: VALLEYCREEK 3 EL 1.mmdl

Address:

Description: 2ND FLR FRAMING\Flush Beams\B20(i3182)

City, Province, Postal Code: WATERDOWN

Specifier:


Customer:

Designer: AJ

Code reports:

CCMC 12472-R

Company:

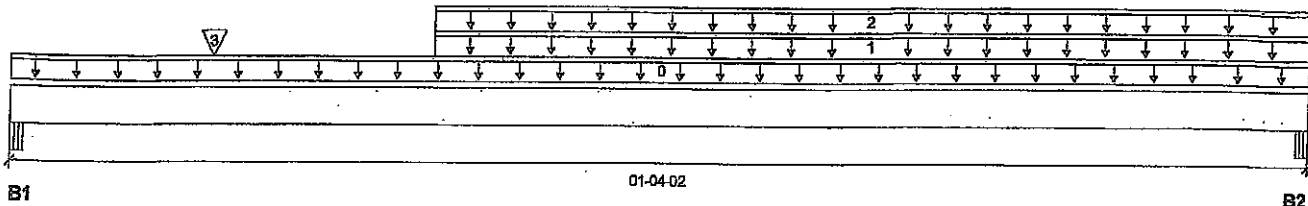

Total Horizontal Product Length = 01-04-02

**Reaction Summary (Down / Uplift) (lbs)**

Bearing	Live	Dead	Snow	Wind
B1, 5-1/4"	30 / 0	94 / 0	47 / 0	
B2, 4-1/8"	32 / 0	82 / 0	39 / 0	

**Load Summary**

Tag	Description	Load Type	Ref.	Start	End	Loc.	Live 1.00	Dead 0.65	Snow 1.00	Wind 1.15	Tributary
0	Self-Weight	Unf. Lin. (lb/ft)	L	00-00-00	01-04-02	Top		12			00-00-00
1	E29(i2653)	Unf. Lin. (lb/ft)	L	00-05-04	01-04-02	Top	33	111	63		n/a
2	FC2 Floor Material	Unf. Lin. (lb/ft)	L	00-05-04	01-04-02	Top	19	9			n/a
3	E28(i2652)	Conc. Pt. (lbs)	L	00-02-08	00-02-08	Top	15	51	29		n/a

**Controls Summary**

	Factored Demand	Factored Resistance	Demand/Resistance	Case	Location
Pos. Moment	18 ft-lbs	35392 ft-lbs	n/a	13	00-08-10
End Shear	88 lbs	14464 lbs	0.6%	13	00-05-04
Span / Depth	0.7				

**Bearing Supports**

	Dim. (LxW)	Demand	Demand/Resistance Support	Demand/Resistance Member	Material
B1	Beam 5-1/4" x 3-1/2"	217 lbs	2.2%	1.0%	Unspecified
B2	Beam 4-1/8" x 3-1/2"	194 lbs	2.5%	1.1%	Unspecified

**Notes**

Calculations assume member is fully braced.

Resistance Factor phi has been applied to all presented results per CSA O86.

BC CALC® analysis is based on Canadian Limit States Design, as per NBCC 2015 and CSA O86.


Unbalanced snow loads determined from building geometry were used in selected product's verification.

Design based on Dry Service Condition.

Importance Factor : Normal Part code : Part 9

CONFORMS TO OBC 2012

AMENDED 2020

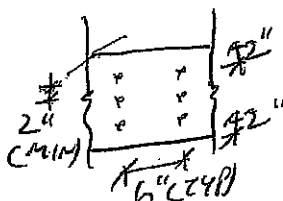

PROVIDE 3 ROWS OF 3/4" ARDOX  
SPIRAL NAILS @ 6" O/C FOR  
MULTI-PLY NAILING. MAINTAIN  
A MIN. 2" LUMBER EDGE/END  
DISTANCE. DO NOT USE AIR NAILS



DWG NO. YAM 5509-20

STRUCTURAL

COMPONENT ONLY

**Disclosure**

Use of the Boise Cascade Software is subject to the terms of the End User License Agreement (EULA).

Completeness and accuracy of input must be reviewed and verified by a qualified engineer or other appropriate expert to assure its adequacy, prior to anyone relying on such output as evidence of suitability for a particular application. The output here is based on building code-accepted design properties and analysis methods. Installation of Boise Cascade engineered wood products must be in accordance with current Installation Guide and applicable building codes. To obtain Installation Guide or ask questions, please call (800)232-0788 before installation.

BC CALC®, BC FRAMER®, AJS™, ALLJOIST®, BC RIM BOARD™, BCi®, BOISE GLULAM™, BC FloorValue®, VERSA-LAM®, VERSA-RIM PLUS®,



Boise Cascade



Double 1-3/4" x 11-7/8" VERSA-LAM® 2.0 3100 SP

**PASSED**

2ND FLR FRAMING\Flush Beams\B21\I3201 (Flush Beam)

Dry | 1 span | No cant.

February 19, 2020 08:54:40

BC CALC® Member Report

Build 7239

Job name:

Address:

City, Province, Postal Code: WATERDOWN

Customer:

Code reports:

CCMC 12472-R


File name: VALLEYCREEK 3 EL 1.mmdl

Description: 2ND FLR FRAMING\Flush Beams\B21\I3201

Specifier:

Designer: AJ

Company:

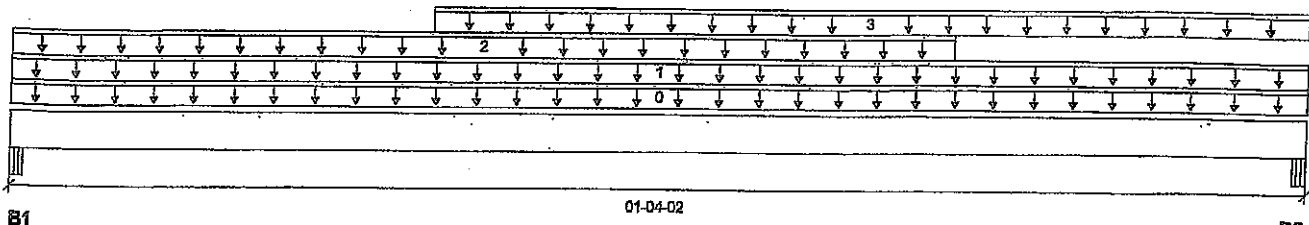

Total Horizontal Product Length = 01-04-02

**Reaction Summary (Down / Uplift) (lbs)**

Bearing	Live	Dead	Snow	Wind
B1, 5-1/4"	18 / 0	51 / 0	22 / 0	
B2, 4-1/8"	12 / 0	26 / 0	8 / 0	

**Load Summary**

Tag	Description	Load Type	Ref.	Start	End	Loc.	Live	Dead	Snow	Wind	Tributary
0	Self-Weight	Unf. Lin. (lb/ft)	L	00-00-00	01-04-02	Top	1.00	0.65	1.00	1.15	00-00-00
1	FC2 Floor Material	Unf. Lin. (lb/ft)	L	00-00-00	01-04-02	Top	6	3			n/a
2	E31(I2650)	Unf. Lin. (lb/ft)	L	00-00-00	00-11-12	Top	16	56	32		n/a
3	FC2 Floor Material	Unf. Lin. (lb/ft)	L	00-05-04	01-04-02	Top	6	3			n/a

**Controls Summary**

	Factored Demand	Factored Resistance	Demand/Resistance	Case	Location
Pos. Moment	10 ft-lbs	35392 ft-lbs	n/a	13	00-08-10
End Shear	46 lbs	14464 lbs	0.3%	1	00-05-04
Span / Depth	0.7				

Bearing Supports	Dim. (LxW)	Demand	Demand/Resistance Support	Demand/Resistance Member	Material
B1 Beam	5-1/4" x 3-1/2"	116 lbs	1.2%	0.5%	Unspecified
B2 Beam	4-1/8" x 3-1/2"	59 lbs	0.8%	0.3%	Unspecified

**Notes**

Calculations assume member is fully braced.

Resistance Factor phi has been applied to all presented results per CSA O86.

BC CALC® analysis is based on Canadian Limit States Design, as per NBCC 2015 and CSA O86.


Unbalanced snow loads determined from building geometry were used in selected product's verification.

Design based on Dry Service Condition.

Importance Factor : Normal Part code : Part 9

CONFORMS TO OBC 2012

AMENDED 2020

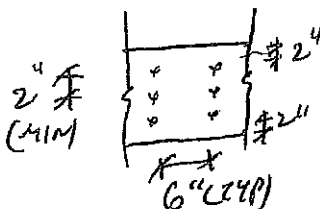

PROVIDE 3 ROWS OF 3/4" ARDOX SPIRAL NAILS @ 6" O/C FOR MULTI-PLY NAILING. MAINTAIN A MIN. 2" LUMBER EDGE/END DISTANCE. DO NOT USE AIR NAILS

**Disclosure**

Use of the Boise Cascade Software is subject to the terms of the End User License Agreement (EULA).

Completeness and accuracy of input must be reviewed and verified by a qualified engineer or other appropriate expert to assure its adequacy, prior to anyone relying on such output as evidence of suitability for a particular application. The output here is based on building code-accepted design properties and analysis methods. Installation of Boise Cascade engineered wood products must be in accordance with current Installation Guide and applicable building codes. To obtain Installation Guide or ask questions, please call (800)232-0788 before installation.

BC CALC®, BC FRAMER®, AJS™, ALLJOIST®, BC RIM BOARD™, BCI®, BOISE GLULAM™, BC FloorValue®, VERSA-LAM®, VERSA-RIM PLUS®

# NORDIC STRUCTURES

COMPANY  
Feb. 19, 2020 09:11


PROJECT  
J1 1ST FLOOR.wvb

## Design Check Calculation Sheet Nordic Sizer - Canada 7.2

### Loads:

Load	Type	Distribution	Pat-tern	Location [ft] Start End	Magnitude Start End	Unit
Load1	Dead	Full Area			20.00	psf
Load2	Live	Full Area			40.00	psf

### Maximum Reactions (lbs) and Support Bearing (in):

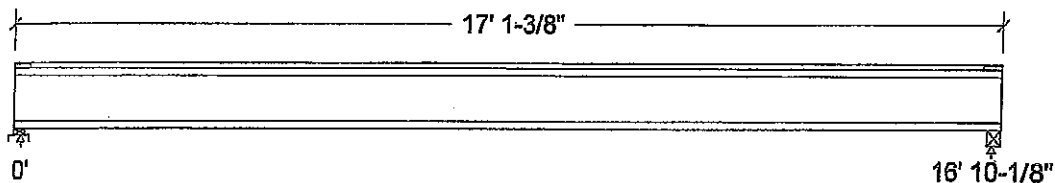

Unfactored:			
Dead	225		225
Live	449		449
Factored:			
Total	954		954
Bearing:			
Capacity			
Joist	2101		2138
Support	3971		4043
Des ratio			
Joist	0.45		0.45
Support	0.24		0.24
Load case	#2		#2
Length	2-3/8		2-5/8
Min req'd	1-3/4		1-3/4
Stiffener	No		No
KD	1.00		1.00
KB support	1.00		1.00
fcp sup	769		769
Kzcp sup	1.09		1.00

### Nordic Joist 11-7/8" NI-40x Floor joist @ 16" o.c.

Supports: 1 - Lumber Sill plate, No.1/No.2; 2 - Lumber Beam, No.1/No.2;

Total length: 17' 1-3/8"; Clear span: 16' 8-3/8"; 3/4" nailed and glued OSB sheathing

This section PASSES the design code check.

### Limit States Design using CSA-O86-09 and Vibration Criterion:

Criterion	Analysis Value	Design Value	Unit	Analysis/Design
Shear	Vf = 954	Vr = 2336	lbs	Vf/Vr = 0.41
Moment (+)	Mf = 4019	Mr = 6255	lbs-ft	Mf/Mr = 0.64
Perm. Defl'n	0.12 = < L/999	0.56 = L/360	in	0.21
Live Defl'n	0.24 = L/844	0.42 = L/480	in	0.57
Total Defl'n	0.36 = L/562	0.84 = L/240	in	0.43
Bare Defl'n	0.29 = L/697	0.56 = L/360	in	0.52
Vibration	Lmax = 16'-10.1	Lv = 18'-1.3	ft	0.93
Defl'n	= 0.030	= 0.038	in	0.80



NO. YAW 5491 -20  
STRUCTURAL  
COMPONENT ONLY

**Additional Data:**

FACTORS:	f/E	KD	KH	KZ	KL	KT	KS	KN	LC#
Vr	2336	1.00	1.00	-	-	-	-	-	#2
Mr+	6255	1.00	1.00	-	1.000	-	-	-	#2
EI	371.1 million	-	-	-	-	-	-	-	#2

**CRITICAL LOAD COMBINATIONS:**

Shear : LC #2 = 1.25D + 1.5L

Moment(+) : LC #2 = 1.25D + 1.5L

Deflection: LC #1 = 1.0D (permanent)

LC #2 = 1.0D + 1.0L (live)

LC #2 = 1.0D + 1.0L (total)

LC #2 = 1.0D + 1.0L (bare joist)

Bearing : Support 1 - LC #2 = 1.25D + 1.5L

Support 2 - LC #2 = 1.25D + 1.5L

Load Types: D=dead W=wind S=snow H=earth,groundwater E=earthquake  
L=live(use,occupancy) Ls=live(storage,equipment) f=fire

Load Patterns: s=S/2 L=L+Ls \_=no pattern load in this span

All Load Combinations (LCs) are listed in the Analysis output

**CALCULATIONS:**E<sub>I</sub>eff = 459.76 lb-in<sup>2</sup> K= 6.18e06 lbs

CONFORMS TO OBC 2012

"Live" deflection is due to all non-dead loads (live, wind, snow...)

AMENDED 2020

**Design Notes:**

1. WoodWorks analysis and design are in accordance with the 2010 National Building Code of Canada (NBC), Division B, Part 4, and the CSA O86-09 Engineering Design in Wood standard, which includes Update No.1
2. Please verify that the default deflection limits are appropriate for your application.
3. Refer to Nordic Structures technical documentation for installation guidelines and construction details.
4. Nordic I-joists are listed in CCMC evaluation report 13032-R.
5. Joists shall be laterally supported at supports and continuously along the compression edge.
6. The design assumptions and specifications have been provided by the client. Any damages resulting from faulty or incorrect information, specifications, and/or designs furnished, and the correctness or accuracy of this information is their responsibility. This analysis does not constitute a record of the structural integrity of the building nor suitability of the design assumptions made. Nordic Structures is responsible only for the structural adequacy of this component based on the design criteria and loadings shown.



HWB NO. YAM 5491 -20  
STRUCTURAL  
COMPONENT ONLY



Boise Cascade



# Single 1-3/4" x 11-7/8" VERSA-LAM® 2.0 3100 SP

## 1ST FLR FRAMING\Flush Beams\B1(i3068) (Flush Beam)

**PASSED**

BC CALC® Member Report

Dry | 1 span | No cant.

February 19, 2020 08:54:40

Build 7239

Job name:

File name: VALLEYCREEK 3 EL 1.mmdl

Address:

Description: 1ST FLR FRAMING\Flush Beams\B1(i3068)

City, Province, Postal Code: WATERDOWN

Specifier:


Customer:

Designer: AJ

Code reports:

CCMC 12472-R

Company:

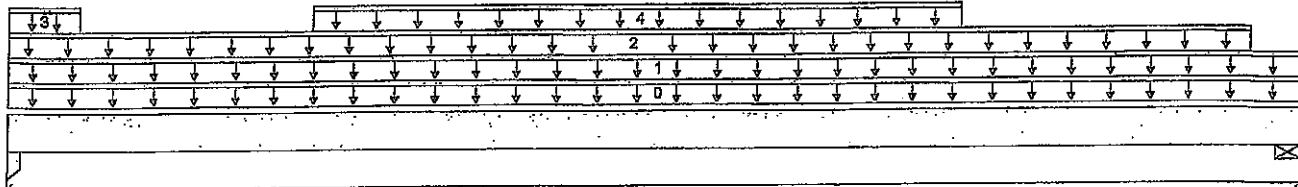

B1

09-04-10

B2

Total Horizontal Product Length = 09-04-10

**Reaction Summary (Down / Uplift) (lbs)**

Bearing	Live	Dead	Snow	Wind
B1, 1-3/4"	396 / 0	590 / 0		
B2, 1-7/8"	192 / 0	468 / 0		

**Load Summary**

Tag	Description	Load Type	Ref.	Start	End	Loc.	Live 1.00	Dead 0.65	Snow 1.00	Wind 1.15	Tributary
0	Self-Weight	Unf. Lin. (lb/ft)	L	00-00-00	09-04-10	Top		6			00-00-00
1	FC1 Floor Material	Unf. Lin. (lb/ft)	L	00-00-00	09-04-10	Top	9	4			n/a
2	12(i1307)	Unf. Lin. (lb/ft)	L	00-00-00	09-00-04	Top		81			n/a
3	12(i1307)	Unf. Lin. (lb/ft)	L	00-00-00	00-06-04	Top	392	181			n/a
4	12(i1307)	Unf. Lin. (lb/ft)	L	02-02-08	06-10-14	Top	64	29			

**Controls Summary**

	Factored Demand	Factored Resistance	Demand/ Resistance	Case	Location
Pos. Moment	1693 ft-lbs	11502 ft-lbs	14.7%	0	04-08-07
End Shear	1082 lbs	7232 lbs	15.0%	1	01-01-10
Total Load Deflection	L/999 (0.056")	n/a	n/a	4	04-08-07
Live Load Deflection	L/999 (0.019")	n/a	n/a	5	04-08-07
Max Defl.	0.056"	n/a	n/a	4	04-08-07
Span / Depth	9.3				

			Demand/ Resistance Support	Demand/ Resistance Member	Material	
Bearing Supports	Dim. (LxW)	Demand				
B1	Column	1-3/4" x 1-3/4"	1332 lbs	53.6%	35.7%	Unspecified
B2	Wall/Plate	1-7/8" x 1-3/4"	656 lbs	50.0%	25.2%	Spruce-Pine-Fir

**Notes**

Design meets Code minimum (L/240) Total load deflection criteria.

Design meets Code minimum (L/360) Live load deflection criteria.

Calculations assume unbraced length of Top: 00-00-00, Bottom: 00-00-00.

Resistance Factor phi has been applied to all presented results per CSA O86. **AMENDED 2020**

BC CALC® analysis is based on Canadian Limit States Design, as per NBCC 2015 and CSA O86.

Design based on Dry Service Condition.

Importance Factor : Normal Part code : Part 9

**CONFORMS TO OBC 2012**

DWG NO. YAM 5493-20  
STRUCTURAL  
COMPONENT ONLY

**Disclosure**

Use of the Boise Cascade Software is subject to the terms of the End User License Agreement (EULA). Completeness and accuracy of input must be reviewed and verified by a qualified engineer or other appropriate expert to assure its adequacy, prior to anyone relying on such output as evidence of suitability for a particular application. The output here is based on building code-accepted design properties and analysis methods. Installation of Boise Cascade engineered wood products must be in accordance with current Installation Guide and applicable building codes. To obtain Installation Guide or ask questions, please call (800)232-0788 before installation.

BC CALC®, BC FRAMER®, AJS™, ALLJOIST®, BC RIM BOARD™, BCIO®, BOISE GLULAM™, BC FloorValue®, VERSA-LAM®, VERSA-RIM PLUS®,



Boise Cascade



Single 1-3/4" x 11-7/8" VERSA-LAM® 2.0 3100 SP

**PASSED**

1ST FLR FRAMING\Flush Beams\B2(i2954) (Flush Beam)

Dry | 1 span | No cant.

February 19, 2020 08:54:40

BC CALC® Member Report

Build 7239

Job name:

Address:

City, Province, Postal Code: WATERDOWN

Customer:

Code reports: CCMC 12472-R


File name: VALLEYCREEK 3 EL 1.mmdl

Description: 1ST FLR FRAMING\Flush Beams\B2(i2954)

Specifier:

Designer: AJ

Company:

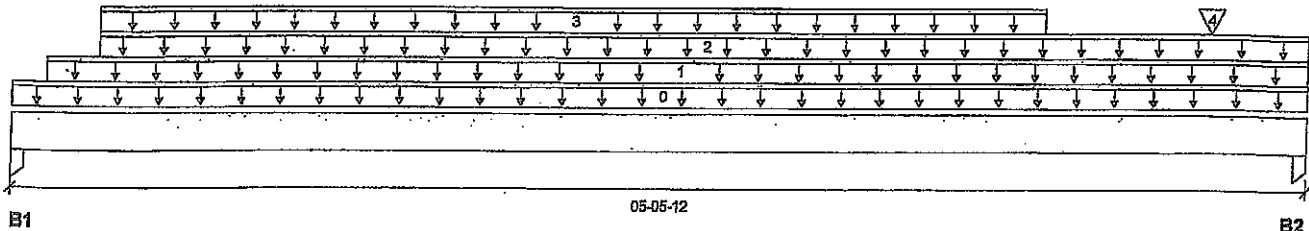

Total Horizontal Product Length = 05-05-12

**Reaction Summary (Down / Uplift) (lbs)**


Bearing	Live	Dead	Snow	Wind
B1, 3-1/2"	1150 / 0	802 / 0		
B2, 3-1/2"	1329 / 0	946 / 0		

**Load Summary**

Tag	Description	Load Type	Ref.	Start	End	Loc.	Live	Dead	Snow	Wind	Tributary
0	Self-Weight	Unf. Lin. (lb/ft)	L	00-00-00	05-05-12	Top	1.00	0.65	1.00	1.15	00-00-00
1	13(i1308)	Unf. Lin. (lb/ft)	L	00-01-12	05-05-12	Top		81			n/a
2	13(i1308)	Unf. Lin. (lb/ft)	L	00-04-06	05-05-12	Top	380	190			n/a
3	Smoothed Load	Unf. Lin. (lb/ft)	L	00-04-06	04-04-06	Top	105	52			n/a
4	-	Conc. Pt. (lbs)	L	05-01-00	05-01-00	Top	108	100			n/a

**Controls Summary**

	Factored Demand	Factored Resistance	Demand/Resistance	Case	Location
Pos. Moment	3584 ft-lbs	17696 ft-lbs	20.3%	1	02-07-14
End Shear	2529 lbs	7232 lbs	35.0%	1	01-03-06
Total Load Deflection	L/999 (0.024")	n/a	n/a	4	02-08-06
Live Load Deflection	L/999 (0.014")	n/a	n/a	5	02-08-06
Max Defl.	0.024"	n/a	n/a	4	02-08-06
Span / Depth	5.1				

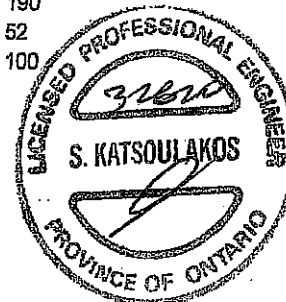

HWB NO. 1AM 5496-20

**STRUCTURAL  
COMPONENT ONLY**

Bearing Supports	Dim. (LxW)	Demand	Demand/Resistance Support	Demand/Resistance Member	Material
B1	Column 3-1/2" x 1-3/4"	2728 lbs	54.9%	36.5%	Unspecified
B2	Column 3-1/2" x 1-3/4"	3176 lbs	63.9%	42.5%	Unspecified

**Notes**

Design meets Code minimum (L/240) Total load deflection criteria.

Design meets Code minimum (L/360) Live load deflection criteria.

Calculations assume member is fully braced.

Resistance Factor phi has been applied to all presented results per CSA O86.

BC CALC® analysis is based on Canadian Limit States Design, as per NBCC 2015 and CSA O86.

Design based on Dry Service Condition.

Importance Factor : Normal Part code : Part 9

**CONFORMS TO OBC 2012****AMENDED 2020****Disclosure**

Use of the Boise Cascade Software is subject to the terms of the End User License Agreement (EULA). Completeness and accuracy of input must be reviewed and verified by a qualified engineer or other appropriate expert to assure its adequacy, prior to anyone relying on such output as evidence of suitability for a particular application. The output here is based on building code-accepted design properties and analysis methods. Installation of Boise Cascade engineered wood products must be in accordance with current Installation Guide and applicable building codes. To obtain Installation Guide or ask questions, please call (800)232-0788 before installation.

BC CALC®, BC FRAMER®, AJS™, ALLJOIST®, BC RIM BOARD™, BCI®, BOISE GLULAM™, BC FloorValue®, VERSA-LAM®, VERSA-RIM PLUS®,





Boise Cascade



Single 1-3/4" x 11-7/8" VERSA-LAM® 2.0 3100 SP

PASSED

1ST FLR FRAMING\Flush Beams\B4(I3034) (Flush Beam)

Dry | 1 span | No cant.

February 19, 2020 08:54:40

BC CALC® Member Report

Build 7239

Job name:

Address:

City, Province, Postal Code: WATERDOWN

Customer:

Code reports: CCMC 12472-R


File name: VALLEYCREEK 3 EL 1.mmdl

Description: 1ST FLR FRAMING\Flush Beams\B4(I3034)

Specifier:

Designer: AJ

Company:

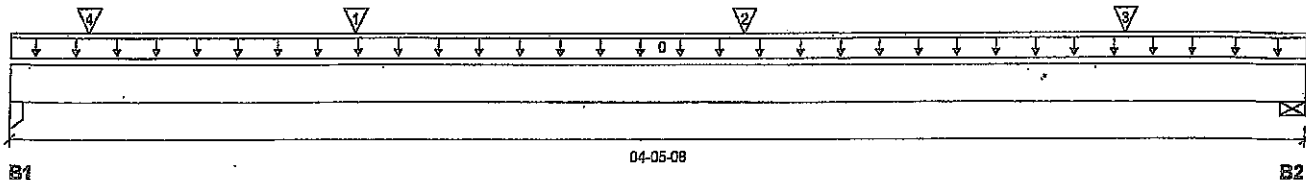

Total Horizontal Product Length = 04-05-08

## Reaction Summary (Down / Uplift) (lbs)


Bearing	Live	Dead	Snow	Wind
B1, 3-1/2"	130 / 0	119 / 0		
B2, 4-3/8"	152 / 0	90 / 0		

## Load Summary

Tag	Description	Load Type	Ref.	Start	End	Loc.	Live 1.00	Dead 0.65	Snow 1.00	Wind 1.15	Tributary
0	Self-Weight	Unf. Lin. (lb/ft)	L	00-00-00	04-05-08	Top		6			00-00-00
1	J7(I3073)	Conc. Pt. (lbs)	L	01-02-02	01-02-02	Top	100	50			n/a
2	J7(I3097)	Conc. Pt. (lbs)	L	02-06-02	02-06-02	Top	100	50			n/a
3	J7(I3055)	Conc. Pt. (lbs)	L	03-10-02	03-10-02	Top	76	38			n/a
4	-	Conc. Pt. (lbs)	L	00-03-03	00-03-03	Top	7	44			n/a

## Controls Summary

	Factored Demand	Factored Resistance	Demand/ Resistance	Case	Location
Pos. Moment	331 ft-lbs	17696 ft-lbs	1.9%	1	02-06-02
End Shear	248 lbs	7232 lbs	3.4%	1	01-03-06
Total Load Deflection	L/999 (0.001")	n/a	n/a	4	02-02-07
Live Load Deflection	L/999 (0.001")	n/a	n/a	5	02-02-07
Max Defl.	0.001"	n/a	n/a	4	02-02-07
Span / Depth	4.0				

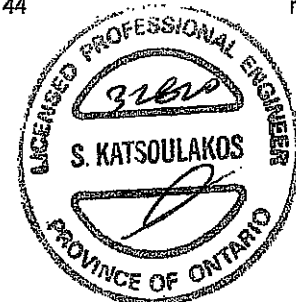

DWG NO. YAM 54997 -20

STRUCTURAL

COMPONENT ONLY

## Disclosure

Use of the Boise Cascade Software is subject to the terms of the End User License Agreement (EULA). Completeness and accuracy of input must be reviewed and verified by a qualified engineer or other appropriate expert to assure its adequacy, prior to anyone relying on such output as evidence of suitability for a particular application. The output here is based on building code-accepted design properties and analysis methods. Installation of Boise Cascade engineered wood products must be in accordance with current Installation Guide and applicable building codes. To obtain Installation Guide or ask questions, please call (800)232-0788 before installation.

BC CALC®, BC FRAMER®, AJS™, ALLJOIST®, BC RIM BOARD™, BCI®, BOISE GLULAM™, BC FloorValue®, VERSA-LAM®, VERSA-RIM PLUS®,

Bearing Supports	Dim. (LxW)	Demand	Demand/ Resistance Support	Demand/ Resistance Member	Material
B1 Column	3-1/2" x 1-3/4"	344 lbs	6.9%	4.6%	Unspecified
B2 Wall/Plate	4-3/8" x 1-3/4"	340 lbs	7.2%	3.6%	Spruce-Pine-Fir

## Notes

Design meets Code minimum (L/240) Total load deflection criteria.

Design meets Code minimum (L/360) Live load deflection criteria.

Calculations assume member is fully braced.

Resistance Factor phi has been applied to all presented results per CSA O86.

BC CALC® analysis is based on Canadian Limit States Design, as per NBCC 2015 and CSA O86.

Design based on Dry Service Condition.

Importance Factor : Normal Part code : Part 9

CONFORMS TO OBC 2012

AMENDED 2020



Single 1-3/4" x 11-7/8" VERSA-LAM® 2.0 3100 SP  
1ST FLR FRAMING\Flush Beams\B5(13064) (Flush Beam)

PASSED

BC CALC® Member Report

Build 7239

Job name:

Address:

City, Province, Postal Code: WATERDOWN

Customer:

Code reports: CCMC 12472-R

Dry | 1 span | No cant

February 19, 2020 08:54:40


File name: VALLEYCREEK 3 EL 1.mmdl

Description: 1ST FLR FRAMING\Flush Beams\B5(13064)

Specifier:

Designer: AJ

Company:

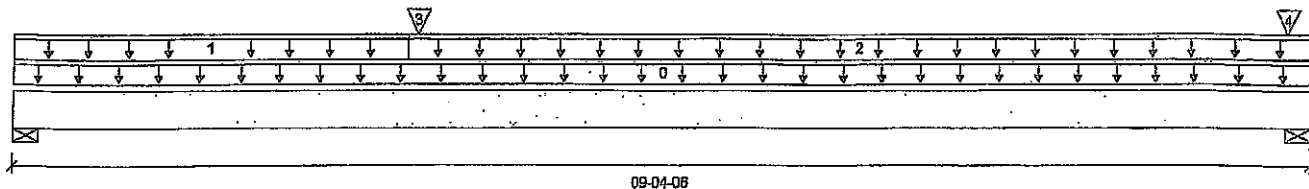

B1

09-04-06

B2

Total Horizontal Product Length = 09-04-06

Reaction Summary (Down / Uplift) (lbs)

Bearing	Live	Dead	Snow	Wind
B1, 4"	340 / 0	205 / 0		
B2, 4-3/8"	227 / 0	160 / 0		

Load Summary

Tag	Description	Load Type	Ref.	Start	End	Loc.	Live 1.00	Dead 0.65	Snow 1.00	Wind 1.15	Tributary
0	Self-Weight	Unf. Lin. (lb/ft)	L	00-00-00	09-04-06	Top		6			00-00-00
1	FC1 Floor Material	Unf. Lin. (lb/ft)	L	00-00-00	02-10-00	Top	13	7			n/a
2	FC1 Floor Material	Unf. Lin. (lb/ft)	L	02-10-00	09-04-06	Top	27	13			n/a
3	B7(13091)	Conc. Pt. (lbs)	L	02-10-14	02-10-14	Top	355	187			n/a
4	FC1 Floor Material	Conc. Pt. (lbs)	L	09-02-03	09-02-03	Top		16			n/a

Controls Summary

	Factored Demand	Factored Resistance	Demand/ Resistance	Case	Location
Pos. Moment	1869 ft-lbs	17696 ft-lbs	10.6%	1	02-10-14
End Shear	719 lbs	7232 lbs	9.9%	1	01-03-14
Total Load Deflection	L/999 (0.033")	n/a	n/a	4	04-05-01
Live Load Deflection	L/999 (0.021")	n/a	n/a	5	04-04-02
Max Defl.	0.033"	n/a	n/a	4	04-05-01
Span / Depth	8.9				



HWB NO. TAM 5498-20  
STRUCTURAL  
COMPONENT ONLY

Bearing Supports

	Dim. (LxW)	Demand	Demand/ Resistance Support	Demand/ Resistance Member	Material
B1	Wall/Plate 4" x 1-3/4"	766 lbs	17.8%	9.0%	Spruce-Pine-Fir
B2	Wall/Plate 4-3/8" x 1-3/4"	541 lbs	11.5%	5.8%	Spruce-Pine-Fir

Notes

Design meets Code minimum (L/240) Total load deflection criteria.

Design meets Code minimum (L/360) Live load deflection criteria.

Calculations assume member is fully braced.

Resistance Factor phi has been applied to all presented results per CSA O86.

BC CALC® analysis is based on Canadian Limit States Design, as per NBCC 2015 and CSA O86.

Design based on Dry Service Condition.

Importance Factor : Normal Part code : Part 9

CONFORMS TO OBC 2012

AMENDED 2020

Disclosure

Use of the Boise Cascade Software is subject to the terms of the End User License Agreement (EULA). Completeness and accuracy of input must be reviewed and verified by a qualified engineer or other appropriate expert to assure its adequacy, prior to anyone relying on such output as evidence of suitability for a particular application. The output here is based on building code-accepted design properties and analysis methods. Installation of Boise Cascade engineered wood products must be in accordance with current Installation Guide and applicable building codes. To obtain Installation Guide or ask questions, please call (800)232-0788 before installation.

BC CALC®, BC FRAMER®, AJS™, ALLJOIST®, BC RIM BOARD™, BC®, BOISE GLULAM™, BC FloorValue®, VERSA-LAM®, VERSA-RIM PLUS®



Boise Cascade



Single 1-3/4" x 11-7/8" VERSA-LAM® 2.0 3100 SP

PASSED

1ST FLR FRAMING\Flush Beams\B6(i3054) (Flush Beam)

February 19, 2020 08:54:40

BC CALC® Member Report

Build 7239

Job name:

Address:

City, Province, Postal Code: WATERDOWN

Customer:

Code reports: CCMC 12472-R

Dry | 1 span | No cant.


File name: VALLEYCREEK 3 EL 1.mmdl

Description: 1ST FLR FRAMING\Flush Beams\B6(i3054)

Specifier:

Designer: AJ

Company:

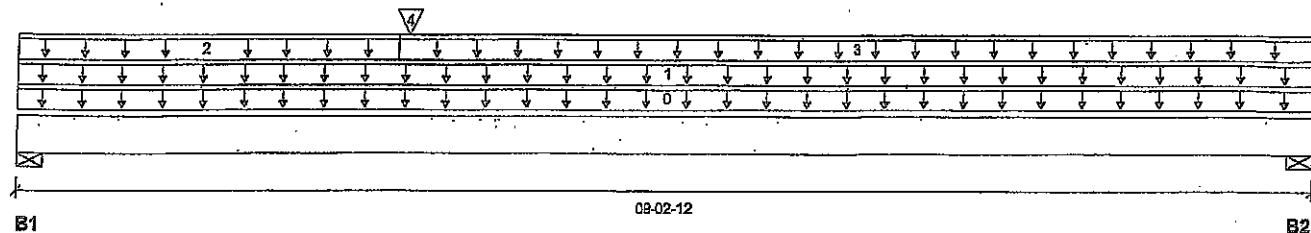

Total Horizontal Product Length = 09-02-12

## Reaction Summary (Down / Uplift) (lbs)


Bearing	Live	Dead	Snow	Wind
B1, 2-3/8"	340 / 0	204 / 0		
B2, 4-3/8"	260 / 0	161 / 0		

## Load Summary

Tag	Description	Load Type	Ref.	Start	End	Loc.	Live	Dead	Snow	Wind	Tributary
0	Self-Weight	Unf. Lin. (lb/ft)	L	00-00-00	09-02-12	Top	1.00	0.65	1.00	1.15	00-00-00
1	FC1 Floor Material	Unf. Lin. (lb/ft)	L	00-00-00	09-02-12	Top	12	6			n/a
2	FC1 Floor Material	Unf. Lin. (lb/ft)	L	00-00-00	02-08-06	Top	3				n/a
3	FC1 Floor Material	Unf. Lin. (lb/ft)	L	02-08-06	09-02-12	Top	25	12			n/a
4	B7(i3091)	Conc. Pt. (lbs)	L	02-09-04	02-09-04	Top	321	170			n/a

## Controls Summary

	Factored Demand	Factored Resistance	Demand/Resistance	Case	Location
Pos. Moment	1867 ft-lbs	17696 ft-lbs	10.5%	1	02-09-04
End Shear	719 lbs	7232 lbs	9.9%	1	01-02-04
Total Load Deflection	L/999 (0.035")	n/a	n/a	4	04-03-07
Live Load Deflection	L/999 (0.022")	n/a	n/a	5	04-03-07
Max Defl.	0.035"	n/a	n/a	4	04-03-07
Span / Depth	8.9				

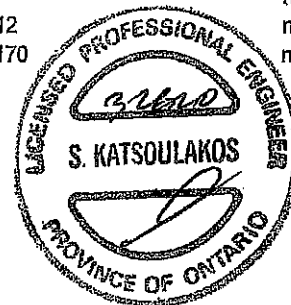DWB NO. TAN 5499 -20  
STRUCTURAL

COMPONENT ONLY

## Disclosure

Use of the Boise Cascade Software is subject to the terms of the End User License Agreement (EULA). Completeness and accuracy of input must be reviewed and verified by a qualified engineer or other appropriate expert to assure its adequacy, prior to anyone relying on such output as evidence of suitability for a particular application. The output here is based on building code-accepted design properties and analysis methods. Installation of Boise Cascade engineered wood products must be in accordance with current Installation Guide and applicable building codes. To obtain Installation Guide or ask questions, please call (800)232-0788 before installation.

Bearing Supports	Dim. (LxW)	Demand	Demand/Resistance Support	Demand/Resistance Member	Material
B1	Wall/Plate 2-3/8" x 1-3/4"	765 lbs	29.9%	15.1%	Spruce-Pine-Fir
B2	Wall/Plate 4-3/8" x 1-3/4"	592 lbs	12.6%	6.3%	Spruce-Pine-Fir

## Notes

Design meets Code minimum (L/240) Total load deflection criteria.

Design meets Code minimum (L/360) Live load deflection criteria.

Calculations assume member is fully braced.

Resistance Factor phi has been applied to all presented results per CSA O86. AMENDED 2020

BC CALC® analysis is based on Canadian Limit States Design, as per NBCC 2015 and CSA O86.

Design based on Dry Service Condition.

Importance Factor : Normal Part code : Part 9

CONFORMS TO OBC 2012

BC CALC®, BC FRAMER®, AJS™, ALLJOIST®, BC RIM BOARD™, BCI®, BOISE GLULAM™, BC FloorValue®, VERSA-LAM®, VERSA-RIM PLUS®,



Boise Cascade



Single 1-3/4" x 11-7/8" VERSA-LAM® 2.0 3100 SP

PASSED

1ST FLR FRAMING\Flush Beams\B7(13091) (Flush Beam)

Dry | 1 span | No cant.

February 19, 2020 08:54:40

BC CALC® Member Report

Build 7239

Job name:

Address:

City, Province, Postal Code: WATERDOWN

Customer:

Code reports: CCMC 12472-R


File name: VALLEYCREEK 3 EL 1.mmdl

Description: 1ST FLR FRAMING\Flush Beams\B7(13091)

Specifier:

Designer: AJ

Company:

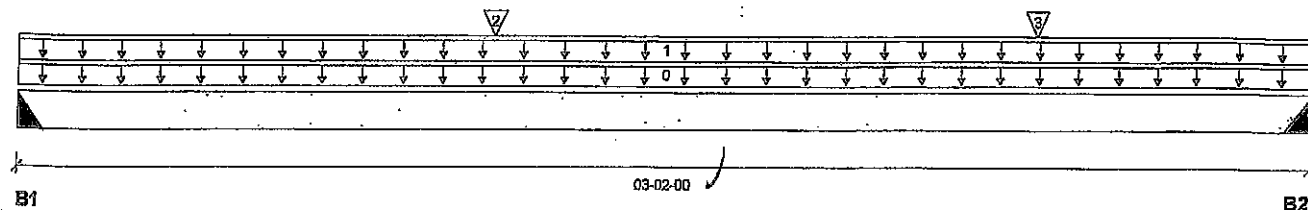

Total Horizontal Product Length = 03-02-00

## Reaction Summary (Down / Uplift) (lbs)

Bearing	Live	Dead	Snow	Wind
B1, 2"	320 / 0	170 / 0		
B2, 2"	356 / 0	187 / 0		

## Load Summary

Tag	Description	Load Type	Ref.	Start	End	Loc.	Live 1.00	Dead 0.65	Snow 1.00	Wind 1.15	Tributary
0	Self-Weight	Unf. Lin. (lb/ft)	L	00-00-00	03-02-00	Top		8			00-00-00
1	STAIR	Unf. Lin. (lb/ft)	L	00-00-00	03-02-00	Top	120	60			n/a
2	J5(13083)	Conc. Pt. (lbs)	L	01-02-00	01-02-00	Top	164	82			n/a
3	J5(13089)	Conc. Pt. (lbs)	L	02-06-00	02-06-00	Top	132	66			n/a

## Controls Summary

	Factored Demand	Factored Resistance	Demand/ Resistance	Case	Location
Pos. Moment	561 ft-lbs	17696 ft-lbs	3.2%	1	01-03-09
End Shear	389 lbs	7232 lbs	5.4%	1	01-01-14
Total Load Deflection	L/999 (0.001")	n/a	n/a	4	01-07-01
Live Load Deflection	L/999 (0.001")	n/a	n/a	5	01-07-01
Max Defl.	0.001"	n/a	n/a	4	01-07-01
Span / Depth	3.0				

## Bearing Supports

	Dim. (LxW)	Demand	Demand/ Resistance Support	Demand/ Resistance Member	Material
B1 Hanger	2" x 1-3/4"	692 lbs	n/a	16.2%	HUS1.81/10
B2 Hanger	2" x 1-3/4"	768 lbs	n/a	18.0%	HUS1.81/10

## Cautions

Header for the hanger HUS1.81/10 at B1 is a Single 1-3/4" x 11-7/8" VERSA-LAM® 1.7 2400 DF.

Hanger model HUS1.81/10 and seat length were input by the user. Hanger has not been analyzed for adequate capacity.

Header for the hanger HUS1.81/10 at B2 is a Single 1-3/4" x 11-7/8" VERSA-LAM® 1.7 2400 DF.

## Notes

Design meets Code minimum (L/240) Total load deflection criteria.

Design meets Code minimum (L/360) Live load deflection criteria.

Calculations assume member is fully braced.

Hanger Manufacturer: Unassigned

Resistance Factor phi has been applied to all presented results per CSA O86.


BC CALC® analysis is based on Canadian Limit States Design, as per NBCC 2015 and CSA O86.

Design based on Dry Service Condition.

Importance Factor: Normal Part code: Part 9

CONFORMS TO OBC 2012

AMENDED 2020

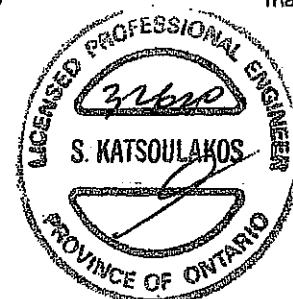

LIC. NO. 32620

STRUCTURAL

COMPONENT ONLY

## Disclosure

Use of the Boise Cascade Software is subject to the terms of the End User License Agreement (EULA). Completeness and accuracy of input must be reviewed and verified by a qualified engineer or other appropriate expert to assure its adequacy, prior to anyone relying on such output as evidence of suitability for a particular application. The output here is based on building code-accepted design properties and analysis methods. Installation of Boise Cascade engineered wood products must be in accordance with current Installation Guide and applicable building codes. To obtain Installation Guide or ask questions, please call (800)232-0788 before installation.

BC CALC®, BC FRAMER®, AJS™, ALLJOIST®, BC RIM BOARD™, BCi®, BOISE GLULAM™, BC FloorValue®, VERSA-LAM®, VERSA-RIM PLUS®



Boise Cascade



Single 1-3/4" x 11-7/8" VERSA-LAM® 2.0 3100 SP

1ST FLR FRAMING\Flush Beams\B8(13040) (Flush Beam)

Dry | 1 span | No cant.

PASSED

February 19, 2020 08:54:40

BC CALC® Member Report

Build 7239

Job name:

Address:

City, Province, Postal Code: WATERDOWN

Customer:

Code reports: CCMC 12472-R


File name: VALLEYCREEK 3 EL 1.mmdl

Description: 1ST FLR FRAMING\Flush Beams\B8(13040)

Specifier:

Designer: AJ

Company:

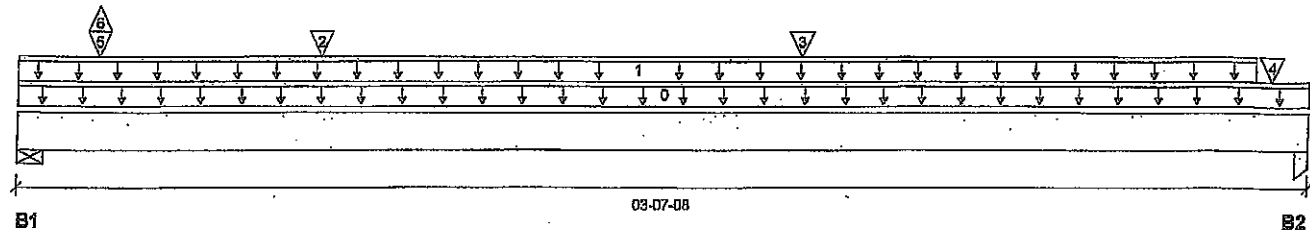

## Reaction Summary (Down / Uplift) (lbs)

Bearing	Live	Dead	Snow	Wind
B1, 5-1/2"	2671 / 245	1398 / 0		
B2, 1-3/4"	423 / 0	221 / 0		

## Load Summary

Tag	Description	Load Type	Ref.	Start	End	Loc.	Live	Dead	Snow	Wind	Tributary
0	Self-Weight	Unf. Lin. (lb/ft)	L	00-00-00	03-07-08	Top	1.00	0.65	1.00	1.15	00-00-00
1	STAIR	Unf. Lin. (lb/ft)	L	00-00-00	03-05-12	Top	120	60			n/a
2	J6(13045)	Conc. Pt. (lbs)	L	00-10-04	00-10-04	Top	126	63			n/a
3	J6(13081)	Conc. Pt. (lbs)	L	02-02-04	02-02-04	Top	142	71			n/a
4	J6(13048)	Conc. Pt. (lbs)	L	03-06-04	03-06-04	Top	142	71			n/a
5	17(11315)	Conc. Pt. (lbs)	L	00-02-12	00-02-12	Top	2263	1182			n/a
6	17(11315)	Conc. Pt. (lbs)	L	00-02-12	00-02-12	Top	-245				n/a

## Controls Summary

	Factored Demand	Factored Resistance	Demand/Resistance	Case	Location
Pos. Moment	604 ft-lbs	17696 ft-lbs	3.4%	1	02-02-04
End Shear	348 lbs	7232 lbs	4.8%	1	02-05-14
Total Load Deflection	L/999 (0.001")	n/a	n/a	6	01-11-08
Live Load Deflection	L/999 (0.001")	n/a	n/a	8	01-11-08
Max Defl.	0.001"	n/a	n/a	6	01-11-08
Span / Depth	3.2				

## Bearing Supports

	Dim. (LxW)	Demand	Demand/Resistance Support	Demand/Resistance Member	Material
B1	Wall/Plate 5-1/2" x 1-3/4"	5754 lbs	97.2%	49.0%	Spruce-Pine-Fir
B2	Column 1-3/4" x 1-3/4"	911 lbs	36.6%	24.4%	Unspecified

## Notes

Design meets Code minimum (L/240) Total load deflection criteria.

Design meets Code minimum (L/360) Live load deflection criteria.

Calculations assume member is fully braced.

Resistance Factor phi has been applied to all presented results per CSA O86. AMENDED 2020

BC CALC® analysis is based on Canadian Limit States Design, as per NBCC 2015 and CSA O86.

Design based on Dry Service Condition.


Importance Factor : Normal Part code : Part 9

CONFORMS TO OBC 2012

## Disclosure

Use of the Boise Cascade Software is subject to the terms of the End User License Agreement (EULA). Completeness and accuracy of input must be reviewed and verified by a qualified engineer or other appropriate expert to assure its adequacy, prior to anyone relying on such output as evidence of suitability for a particular application. The output here is based on building code-accepted design properties and analysis methods. Installation of Boise Cascade engineered wood products must be in accordance with current Installation Guide and applicable building codes. To obtain Installation Guide or ask questions, please call (800)232-0788 before installation.

BC CALC®, BC FRAMER®, AJS™, ALLJOIST®, BC RIM BOARD™, BCi®, BOISE GLULAM™, BC FloorValue®, VERSA-LAM®, VERSA-RIM PLUS®,

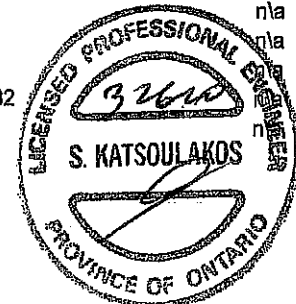

ENG NO. TAM 5501-20  
STRUCTURAL  
COMPONENT ONLY



Boise Cascade



Single 1-3/4" x 11-7/8" VERSA-LAM® 2.0 3100 SP

1ST FLR FRAMING\Flush Beams\B9(i3046) (Flush Beam)

Dry | 1 span | No cant.

PASSED

February 19, 2020 08:54:40

BC CALC® Member Report

Build 7239

Job name:

Address:

City, Province, Postal Code: WATERDOWN

Customer:

Code reports: CCMC 12472-R


File name: VALLEYCREEK 3 EL 1.mmdl

Description: 1ST FLR FRAMING\Flush Beams\B9(i3046)

Specifier:

Designer: AJ

Company:

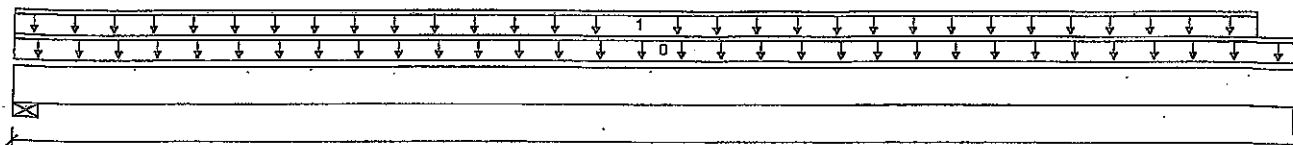

B1

03-10-12

B2

Total Horizontal Product Length = 03-10-12

## Reaction Summary (Down / Uplift) (lbs)

Bearing	Live	Dead	Snow	Wind
B1, 2-3/8"	47 / 0	35 / 0		
B2, 3-1/2"	45 / 0	35 / 0		

## Load Summary

Tag	Description	Load Type	Ref.	Start	End	Loc.	Live	Dead	Snow	Wind	Tributary
0	Self-Weight	Unf. Lin. (lb/ft)	L	00-00-00	03-10-12	Top	1.00	0.65	1.00	1.15	
1	FC1 Floor Material	Unf. Lin. (lb/ft)	L	00-00-00	03-09-00	Top	25	12			n/a

## Controls Summary

	Factored Demand	Factored Resistance	Demand/Resistance	Case	Location
Pos. Moment	93 ft-lbs	17696 ft-lbs	0.5%	1	01-10-13
End Shear	43 lbs	7232 lbs	0.6%	1	01-02-04
Total Load Deflection	L/999 (0")	n/a	n/a	4	01-10-13
Live Load Deflection	L/999 (0")	n/a	n/a	5	01-10-13
Max Defl.	0"	n/a	n/a	4	01-10-13
Span / Depth	3.6				

## Bearing Supports

	Dim. (LxW)	Demand	Demand/Resistance Support	Demand/Resistance Member	Material
B1	Wall/Plate 2-3/8" x 1-3/4"	114 lbs	4.4%	2.2%	Spruce-Pine-Fir
B2	Column 3-1/2" x 1-3/4"	112 lbs	2.2%	1.5%	Unspecified

## Notes

Design meets Code minimum (L/240) Total load deflection criteria.

Design meets Code minimum (L/360) Live load deflection criteria.

Calculations assume member is fully braced.

Resistance Factor phi has been applied to all presented results per CSA O86.

BC CALC® analysis is based on Canadian Limit States Design, as per NBCC 2015 and CSA O86.

Design based on Dry Service Condition.

Importance Factor : Normal Part code : Part 9

CONFORMS TO OBC 2012

AMENDED 2020



DWG NO. YAN5502-20



STRUCTURAL

COMPONENT ONLY

## Disclosure

Use of the Boise Cascade Software is subject to the terms of the End User License Agreement (EULA). Completeness and accuracy of input must be reviewed and verified by a qualified engineer or other appropriate expert to assure its adequacy, prior to anyone relying on such output as evidence of suitability for a particular application. The output here is based on building code-accepted design properties and analysis methods. Installation of Boise Cascade engineered wood products must be in accordance with current Installation Guide and applicable building codes. To obtain Installation Guide or ask questions, please call (800)232-0788 before installation.

BC CALC®, BC FRAMER®, AJS™, ALLJOIST®, BC RIM BOARD™, BCI®, BOISE GLULAM™, BC FloorValue®, VERSA-LAM®, VERSA-RIM PLUS®,

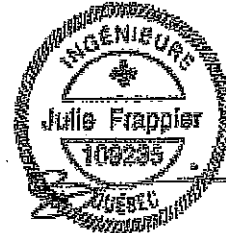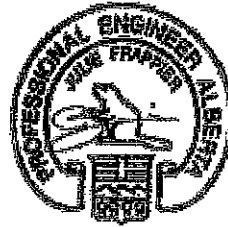

### Maximum Floor Spans

Live Load = 40 psf, Dead Load = 30 psf  
Simple Spans, L/480 Deflection Limit  
3/4" OSB G&N Sheathing

Depth	Series	Bare				1/2" Gypsum Ceiling			
		On Centre Spacing				On Centre Spacing			
		12"	16"	19.2"	24"	12"	16"	19.2"	24"
9-1/2"	NI-20	15'-7"	14'-2"	13'-4"	12'-4"	15'-7"	14'-2"	13'-4"	12'-4"
	NI-40x	17'-0"	16'-0"	15'-1"	13'-11"	17'-5"	16'-1"	15'-1"	13'-11"
	NI-60	17'-2"	16'-2"	15'-5"	14'-3"	17'-6"	16'-5"	15'-5"	14'-3"
	NI-70	18'-0"	16'-11"	16'-3"	15'-6"	18'-5"	17'-3"	16'-7"	15'-6"
	NI-80	18'-3"	17'-1"	16'-5"	15'-9"	18'-8"	17'-5"	16'-9"	15'-10"
11-7/8"	NI-20	17'-10"	16'-10"	16'-0"	14'-10"	18'-6"	17'-4"	16'-0"	14'-10"
	NI-40x	19'-4"	17'-11"	17'-3"	15'-10"	19'-11"	18'-6"	17'-9"	15'-10"
	NI-60	19'-7"	18'-2"	17'-5"	16'-9"	20'-2"	18'-9"	17'-11"	17'-1"
	NI-70	20'-9"	19'-2"	18'-3"	17'-5"	21'-4"	19'-9"	18'-10"	17'-10"
	NI-80	21'-1"	19'-5"	18'-6"	17'-7"	21'-7"	20'-0"	19'-0"	18'-0"
14"	NI-90x	21'-8"	20'-0"	19'-1"	18'-0"	22'-2"	20'-6"	19'-6"	18'-6"
	NI-40x	21'-5"	19'-10"	18'-11"	17'-5"	22'-1"	20'-6"	19'-6"	17'-5"
	NI-60	21'-10"	20'-2"	19'-3"	18'-2"	22'-5"	20'-10"	19'-11"	18'-10"
	NI-70	23'-0"	21'-3"	20'-3"	19'-2"	23'-8"	21'-11"	20'-10"	19'-9"
	NI-80	23'-5"	21'-7"	20'-7"	19'-5"	24'-0"	22'-3"	21'-2"	20'-0"
16"	NI-90x	24'-1"	22'-3"	21'-2"	20'-0"	24'-8"	22'-10"	21'-9"	20'-7"
	NI-60	23'-9"	22'-0"	20'-11"	19'-10"	24'-6"	22'-9"	21'-8"	20'-6"
	NI-70	25'-1"	23'-2"	22'-0"	20'-10"	25'-9"	23'-10"	22'-9"	21'-6"
	NI-80	25'-6"	23'-6"	22'-4"	21'-2"	26'-1"	24'-2"	23'-1"	21'-10"
	NI-90x	26'-4"	24'-3"	23'-1"	21'-10"	26'-11"	24'-11"	23'-8"	22'-5"


  

Depth	Series	Mid-Span Blocking				Mid-Span Blocking and 1/2" Gypsum Ceiling			
		On Centre Spacing				On Centre Spacing			
		12"	16"	19.2"	24"	12"	16"	19.2"	24"
9-1/2"	NI-20	15'-7"	14'-2"	13'-4"	12'-4"	15'-7"	14'-2"	13'-4"	12'-4"
	NI-40x	17'-9"	16'-1"	15'-1"	13'-11"	17'-9"	16'-1"	15'-1"	13'-11"
	NI-60	18'-1"	16'-5"	15'-5"	14'-3"	18'-1"	16'-5"	15'-5"	14'-3"
	NI-70	19'-10"	17'-11"	16'-9"	15'-6"	19'-10"	17'-11"	16'-9"	15'-6"
	NI-80	20'-2"	18'-3"	17'-1"	15'-10"	20'-2"	18'-3"	17'-1"	15'-10"
11-7/8"	NI-20	18'-10"	17'-1"	16'-0"	14'-10"	18'-10"	17'-1"	16'-0"	14'-10"
	NI-40x	21'-3"	19'-3"	17'-9"	15'-10"	21'-3"	19'-3"	17'-9"	15'-10"
	NI-60	21'-9"	19'-8"	18'-5"	17'-1"	21'-9"	19'-8"	18'-5"	17'-1"
	NI-70	23'-4"	21'-5"	20'-1"	18'-6"	23'-8"	21'-5"	20'-1"	18'-6"
	NI-80	23'-7"	21'-10"	20'-5"	18'-11"	24'-1"	21'-10"	20'-5"	18'-11"
14"	NI-90x	24'-3"	22'-6"	21'-3"	19'-7"	24'-8"	22'-7"	21'-3"	19'-7"
	NI-40x	24'-2"	21'-5"	19'-6"	17'-5"	24'-2"	21'-5"	19'-6"	17'-5"
	NI-60	24'-9"	22'-5"	21'-0"	19'-6"	24'-9"	22'-5"	21'-0"	19'-6"
	NI-70	26'-1"	24'-3"	22'-9"	21'-0"	26'-8"	24'-3"	22'-9"	21'-0"
	NI-80	26'-6"	24'-7"	23'-3"	21'-6"	27'-1"	24'-10"	23'-3"	21'-6"
16"	NI-90x	27'-3"	25'-4"	24'-1"	22'-4"	27'-9"	25'-10"	24'-3"	22'-4"
	NI-60	27'-3"	24'-11"	23'-5"	21'-7"	27'-6"	24'-11"	23'-5"	21'-7"
	NI-70	28'-8"	26'-8"	25'-3"	23'-4"	29'-3"	26'-11"	25'-3"	23'-4"
	NI-80	29'-1"	27'-0"	25'-9"	23'-10"	29'-8"	27'-6"	25'-10"	23'-10"
	NI-90x	29'-11"	27'-10"	26'-6"	24'-10"	30'-6"	28'-5"	26'-11"	24'-10"

- Maximum clear span applicable to simple-span residential floor construction with a design live load of 40 psf and dead load of 30 psf. The ultimate limit states are based on the factored loads of 1.50L + 1.25D. The serviceability limit states include the consideration for floor vibration, a live load deflection limit of L/480 and a total load deflection limit of L/240.
- Spans are based on a composite floor with glued-nailed oriented strand board (OSB) sheathing with a minimum thickness of 3/4 inch for a joist spacing of 24 inches or less. The composite floor may include 1/2 inch gypsum ceiling and/or one row of blocking at mid-span with strapping. Strapping shall be minimum 1x4 inch strap applied to underside of joists at blocking line or 1/2 inch gypsum ceiling attached to joists.
- Minimum bearing length shall be 1-3/4 inches for the end bearings.
- Bearing stiffeners are not required when I-joists are used with the spans and spacings given in this table, except as required for hangers.
- This span chart is based on uniform loads. For applications with other than uniformly distributed loads, an engineering analysis may be required based on the use of the design properties. Tables are based on Limit States Design per CSA O86-09, NBC 2010, and OBC 2012.
- Joists shall be laterally supported at supports and continuously along the compression edge. Refer to technical documentation for installation guidelines and construction details. Nordic I-joists are listed in CCMC evaluation report 13032-R and APA Product Report PR-L274C.



Maximum Spans - A1  
Limit States Design (CAN)

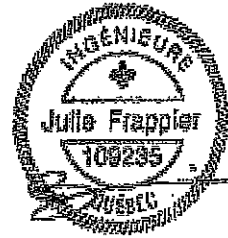

### Maximum Floor Spans

Live Load = 40 psf, Dead Load = 15 psf  
Simple Spans, L/480 Deflection Limit  
5/8" OSB G&N Sheathing

Depth	Series	Bare				1/2" Gypsum Ceiling			
		On Centre Spacing				On Centre Spacing			
		12"	16"	19.2"	24"	12"	16"	19.2"	24"
9'-1/2"	NI-20	15'-1"	14'-2"	13'-9"	N/A	15'-7"	14'-8"	14'-2"	N/A
	NI-40x	16'-1"	15'-2"	14'-8"	N/A	16'-7"	15'-7"	15'-1"	N/A
	NI-60	16'-3"	15'-4"	14'-10"	N/A	16'-8"	15'-9"	15'-3"	N/A
	NI-70	17'-1"	16'-1"	15'-6"	N/A	17'-5"	16'-5"	15'-10"	N/A
	NI-80	17'-3"	16'-3"	15'-8"	N/A	17'-8"	16'-7"	16'-0"	N/A
11'-7/8"	NI-20	16'-11"	16'-0"	15'-5"	N/A	17'-6"	16'-6"	16'-0"	N/A
	NI-40x	18'-1"	17'-0"	16'-5"	N/A	18'-9"	17'-6"	16'-11"	N/A
	NI-60	18'-4"	17'-3"	16'-7"	N/A	19'-0"	17'-8"	17'-1"	N/A
	NI-70	19'-6"	18'-0"	17'-4"	N/A	20'-1"	18'-7"	17'-9"	N/A
	NI-80	19'-9"	18'-3"	17'-6"	N/A	20'-4"	18'-10"	17'-11"	N/A
14"	NI-90x	20'-4"	18'-9"	17'-11"	N/A	20'-10"	19'-3"	18'-5"	N/A
	NI-40x	20'-1"	18'-7"	17'-10"	N/A	20'-10"	19'-4"	18'-6"	N/A
	NI-60	20'-5"	18'-11"	18'-1"	N/A	21'-2"	19'-7"	18'-9"	N/A
	NI-70	21'-7"	20'-0"	19'-1"	N/A	22'-3"	20'-7"	19'-8"	N/A
	NI-80	21'-11"	20'-3"	19'-4"	N/A	22'-7"	20'-11"	20'-0"	N/A
16"	NI-90x	22'-7"	20'-11"	19'-11"	N/A	23'-3"	21'-6"	20'-5"	N/A
	NI-60	22'-3"	20'-8"	19'-9"	N/A	23'-1"	21'-5"	20'-6"	N/A
	NI-70	23'-6"	21'-9"	20'-9"	N/A	24'-3"	22'-5"	21'-5"	N/A
	NI-80	23'-11"	22'-1"	21'-1"	N/A	24'-8"	22'-10"	21'-9"	N/A
	NI-90x	24'-8"	22'-9"	21'-9"	N/A	25'-4"	23'-5"	22'-4"	N/A


Depth	Series	Mid-Span Blocking				Mid-Span Blocking and 1/2" Gypsum Ceiling			
		On Centre Spacing				On Centre Spacing			
		12"	16"	19.2"	24"	12"	16"	19.2"	24"
9'-1/2"	NI-20	16'-8"	15'-3"	14'-5"	N/A	16'-8"	15'-3"	14'-5"	N/A
	NI-40x	17'-11"	16'-11"	16'-1"	N/A	18'-5"	17'-1"	16'-1"	N/A
	NI-60	18'-2"	17'-1"	16'-4"	N/A	18'-7"	17'-4"	16'-4"	N/A
	NI-70	19'-2"	17'-10"	17'-2"	N/A	19'-7"	18'-3"	17'-7"	N/A
	NI-80	19'-5"	18'-0"	17'-4"	N/A	19'-10"	18'-5"	17'-8"	N/A
11'-7/8"	NI-20	19'-6"	18'-1"	17'-3"	N/A	19'-11"	18'-3"	17'-3"	N/A
	NI-40x	21'-0"	19'-6"	18'-8"	N/A	21'-7"	20'-2"	19'-2"	N/A
	NI-60	21'-4"	19'-9"	18'-11"	N/A	21'-11"	20'-4"	19'-6"	N/A
	NI-70	22'-6"	20'-10"	19'-11"	N/A	23'-0"	21'-5"	20'-5"	N/A
	NI-80	22'-9"	21'-1"	20'-1"	N/A	23'-3"	21'-7"	20'-8"	N/A
14"	NI-90x	23'-4"	21'-8"	20'-8"	N/A	23'-10"	22'-2"	21'-2"	N/A
	NI-40x	23'-7"	21'-11"	20'-11"	N/A	24'-3"	22'-7"	21'-7"	N/A
	NI-60	24'-0"	22'-3"	21'-3"	N/A	24'-8"	22'-11"	21'-11"	N/A
	NI-70	25'-3"	23'-4"	22'-3"	N/A	25'-10"	24'-0"	22'-11"	N/A
	NI-80	25'-7"	23'-8"	22'-7"	N/A	26'-2"	24'-4"	23'-2"	N/A
16"	NI-90x	26'-4"	24'-4"	23'-3"	N/A	26'-10"	24'-11"	23'-9"	N/A
	NI-60	26'-5"	24'-6"	23'-4"	N/A	27'-2"	25'-3"	24'-2"	N/A
	NI-70	27'-9"	25'-8"	24'-6"	N/A	28'-5"	26'-5"	25'-2"	N/A
	NI-80	28'-2"	26'-1"	24'-10"	N/A	28'-10"	26'-9"	25'-6"	N/A
	NI-90x	29'-0"	26'-10"	25'-7"	N/A	29'-7"	27'-5"	26'-2"	N/A

- Maximum clear span applicable to simple-span residential floor construction with a design live load of 40 psf and dead load of 15 psf. The ultimate limit states are based on the factored loads of 1.50L + 1.25D. The serviceability limit states include the consideration for floor vibration, a live load deflection limit of L/480 and a total load deflection limit of L/240.
- Spans are based on a composite floor with glued-nailed oriented strand board (OSB) sheathing with a minimum thickness of 5/8 inch for a joist spacing of 19.2 inches or less. The composite floor may include 1/2 inch gypsum ceiling and/or one row of blocking at mid-span with strapping. Strapping shall be minimum 1x4 inch strap applied to underside of joists at blocking line or 1/2 inch gypsum ceiling attached to joists.
- Minimum bearing length shall be 1-3/4 inches for the end bearings.
- Bearing stiffeners are not required when I-joists are used with the spans and spacings given in this table, except as required for hangers.
- This span chart is based on uniform loads. For applications with other than uniformly distributed loads, an engineering analysis may be required based on the use of the design properties. Tables are based on Limit States Design per CSA O86-09, NBC 2010, and OBC 2012.
- Joists shall be laterally supported at supports and continuously along the compression edge. Refer to technical documentation for installation guidelines and construction details. Nordic I-joists are listed in CCMC evaluation report 13032-R and APA Product Report PR-1274C.



## Maximum Floor Spans

Live Load = 40 psf, Dead Load = 15 psf  
Simple Spans, L/480 Deflection Limit  
3/4" OSB G&N Sheathing


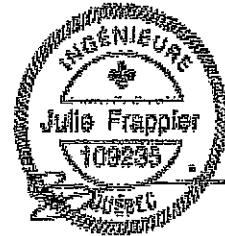


Depth	Series	Bare				1/2" Gypsum Ceiling			
		On Centre Spacing				On Centre Spacing			
		12"	16"	19.2"	24"	12"	16"	19.2"	24"
9-1/2"	NI-20	15'-10"	15'-0"	14'-5"	13'-5"	16'-4"	15'-5"	14'-6"	13'-5"
	NI-40x	17'-0"	16'-0"	15'-5"	14'-9"	17'-5"	16'-5"	15'-10"	15'-2"
	NI-60	17'-2"	16'-2"	15'-7"	14'-11"	17'-6"	16'-7"	15'-11"	15'-3"
	NI-70	18'-0"	16'-11"	16'-3"	15'-7"	18'-5"	17'-3"	16'-7"	15'-11"
	NI-80	18'-3"	17'-1"	16'-5"	15'-9"	18'-8"	17'-5"	16'-9"	16'-1"
11-7/8"	NI-20	17'-10"	16'-10"	16'-2"	15'-6"	18'-6"	17'-4"	16'-9"	16'-1"
	NI-40x	19'-4"	17'-11"	17'-3"	16'-6"	19'-11"	18'-6"	17'-9"	17'-0"
	NI-60	19'-7"	18'-2"	17'-5"	16'-9"	20'-2"	18'-9"	17'-11"	17'-2"
	NI-70	20'-9"	19'-2"	18'-3"	17'-5"	21'-4"	19'-9"	18'-10"	17'-10"
	NI-80	21'-1"	19'-5"	18'-6"	17'-7"	21'-7"	20'-0"	19'-0"	18'-0"
14"	NI-90x	21'-8"	20'-0"	19'-1"	18'-0"	22'-2"	20'-6"	19'-5"	18'-6"
	NI-40x	21'-5"	19'-10"	18'-11"	17'-11"	22'-1"	20'-6"	19'-7"	18'-7"
	NI-60	21'-10"	20'-2"	19'-3"	18'-2"	22'-5"	20'-10"	19'-11"	18'-10"
	NI-70	23'-0"	21'-3"	20'-3"	19'-2"	23'-8"	21'-11"	20'-10"	19'-9"
	NI-80	23'-5"	21'-7"	20'-7"	19'-5"	24'-0"	22'-3"	21'-2"	20'-0"
16"	NI-90x	24'-1"	22'-3"	21'-2"	20'-0"	24'-8"	22'-10"	21'-9"	20'-7"
	NI-60	23'-9"	22'-0"	20'-11"	19'-10"	24'-6"	22'-9"	21'-8"	20'-6"
	NI-70	25'-1"	23'-2"	22'-0"	20'-10"	25'-9"	23'-10"	22'-9"	21'-6"
	NI-80	25'-6"	23'-6"	22'-4"	21'-2"	26'-1"	24'-2"	23'-1"	21'-10"
	NI-90x	26'-4"	24'-3"	23'-1"	21'-10"	26'-11"	24'-11"	23'-8"	22'-5"

Depth	Series	Mid-Span Blocking				Mid-Span Blocking and 1/2" Gypsum Ceiling			
		On Centre Spacing				On Centre Spacing			
		12"	16"	19.2"	24"	12"	16"	19.2"	24"
9-1/2"	NI-20	16'-10"	15'-5"	14'-6"	13'-5"	16'-10"	15'-5"	14'-6"	13'-5"
	NI-40x	18'-8"	17'-2"	16'-3"	15'-2"	18'-10"	17'-2"	16'-3"	15'-2"
	NI-60	18'-11"	17'-6"	16'-6"	15'-5"	19'-2"	17'-6"	16'-6"	15'-5"
	NI-70	20'-0"	18'-7"	17'-9"	16'-7"	20'-5"	18'-11"	17'-10"	16'-7"
	NI-80	20'-3"	18'-10"	17'-11"	16'-10"	20'-8"	19'-3"	18'-2"	16'-10"
11-7/8"	NI-20	20'-1"	18'-5"	17'-5"	16'-2"	20'-1"	18'-5"	17'-5"	16'-2"
	NI-40x	21'-10"	20'-4"	19'-4"	17'-8"	22'-5"	20'-6"	19'-4"	17'-8"
	NI-60	22'-1"	20'-7"	19'-7"	18'-4"	22'-8"	20'-10"	19'-8"	18'-4"
	NI-70	23'-4"	21'-8"	20'-8"	19'-7"	23'-10"	22'-3"	21'-2"	19'-9"
	NI-80	23'-7"	21'-11"	20'-11"	19'-9"	24'-1"	22'-6"	21'-5"	20'-0"
14"	NI-90x	24'-3"	22'-6"	21'-6"	20'-4"	24'-8"	23'-0"	22'-0"	20'-9"
	NI-40x	24'-5"	22'-9"	21'-8"	19'-5"	25'-1"	23'-2"	21'-9"	19'-5"
	NI-60	24'-10"	23'-1"	22'-0"	20'-10"	25'-6"	23'-8"	22'-4"	20'-10"
	NI-70	26'-1"	24'-3"	23'-2"	21'-10"	26'-8"	24'-11"	23'-9"	22'-4"
	NI-80	26'-6"	24'-7"	23'-5"	22'-2"	27'-1"	25'-3"	24'-1"	22'-9"
16"	NI-90x	27'-3"	25'-4"	24'-1"	22'-9"	27'-9"	25'-11"	24'-8"	23'-4"
	NI-60	27'-3"	25'-5"	24'-2"	22'-10"	28'-0"	26'-2"	24'-9"	23'-1"
	NI-70	28'-8"	26'-8"	25'-4"	23'-11"	29'-3"	27'-4"	26'-1"	24'-8"
	NI-80	29'-1"	27'-0"	25'-9"	24'-4"	29'-8"	27'-9"	26'-5"	25'-0"
	NI-90x	29'-11"	27'-10"	26'-6"	25'-0"	30'-6"	28'-5"	27'-2"	25'-8"

- Maximum clear span applicable to simple-span residential floor construction with a design live load of 40 psf and dead load of 15 psf. The ultimate limit states are based on the factored loads of 1.50L + 1.25D. The serviceability limit states include the consideration for floor vibration, a live load deflection limit of L/480 and a total load deflection limit of L/240.
- Spans are based on a composite floor with glued-nailed oriented strand board (OSB) sheathing with a minimum thickness of 3/4 inch for a joist spacing of 24 inches or less. The composite floor may include 1/2 inch gypsum ceiling and/or one row of blocking at mid-span with strapping. Strapping shall be minimum 1x4 inch strap applied to underside of joists at blocking line or 1/2 inch gypsum ceiling attached to joists.
- Minimum bearing length shall be 1-3/4 inches for the end bearings.
- Bearing stiffeners are not required when I-joists are used with the spans and spacings given in this table, except as required for hangers.
- This span chart is based on uniform loads. For applications with other than uniformly distributed loads, an engineering analysis may be required based on the use of the design properties. Tables are based on Limit States Design per CSA O86-09, NBC 2010, and OBC 2012.
- Joists shall be laterally supported at supports and continuously along the compression edge. Refer to technical documentation for installation guidelines and construction details. Nordic I-joists are listed in CCMC evaluation report 13032-R and APA Product Report PR-L274C.

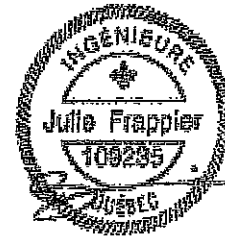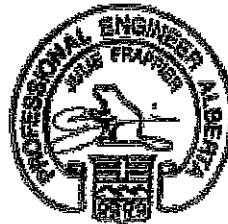

### Maximum Floor Spans

Live Load = 40 psf, Dead Load = 30 psf  
Simple Spans, L/480 Deflection Limit  
5/8" OSB G&N Sheathing

Depth	Series	Bare				1/2" Gypsum Ceiling			
		On Centre Spacing				On Centre Spacing			
		12"	16"	19.2"	24"	12"	16"	19.2"	24"
9-1/2"	NI-20	15'-1"	14'-1"	13'-3"	N/A	15'-7"	14'-1"	13'-3"	N/A
	NI-40x	16'-1"	15'-2"	14'-8"	N/A	16'-7"	15'-7"	15'-1"	N/A
	NI-60	16'-3"	15'-4"	14'-10"	N/A	16'-8"	15'-9"	15'-3"	N/A
	NI-70	17'-1"	16'-1"	15'-6"	N/A	17'-5"	16'-5"	15'-10"	N/A
	NI-80	17'-3"	16'-3"	15'-8"	N/A	17'-8"	16'-7"	16'-0"	N/A
11-7/8"	NI-20	16'-11"	16'-0"	15'-5"	N/A	17'-6"	16'-6"	16'-0"	N/A
	NI-40x	18'-1"	17'-0"	16'-5"	N/A	18'-9"	17'-6"	16'-11"	N/A
	NI-60	18'-4"	17'-3"	16'-7"	N/A	19'-0"	17'-8"	17'-1"	N/A
	NI-70	19'-6"	18'-0"	17'-4"	N/A	20'-1"	18'-7"	17'-9"	N/A
	NI-80	19'-9"	18'-3"	17'-6"	N/A	20'-4"	18'-10"	17'-11"	N/A
14"	NI-90x	20'-4"	18'-9"	17'-11"	N/A	20'-10"	19'-3"	18'-5"	N/A
	NI-40x	20'-1"	18'-7"	17'-10"	N/A	20'-10"	19'-4"	18'-6"	N/A
	NI-60	20'-5"	18'-11"	18'-1"	N/A	21'-2"	19'-7"	18'-9"	N/A
	NI-70	21'-7"	20'-0"	19'-1"	N/A	22'-3"	20'-7"	19'-8"	N/A
	NI-80	21'-11"	20'-3"	19'-4"	N/A	22'-7"	20'-11"	20'-0"	N/A
16"	NI-90x	22'-7"	20'-11"	19'-11"	N/A	23'-3"	21'-6"	20'-6"	N/A
	NI-60	22'-3"	20'-8"	19'-9"	N/A	23'-1"	21'-5"	20'-6"	N/A
	NI-70	23'-6"	21'-9"	20'-9"	N/A	24'-3"	22'-5"	21'-5"	N/A
	NI-80	23'-11"	22'-1"	21'-1"	N/A	24'-8"	22'-10"	21'-9"	N/A
	NI-90x	24'-8"	22'-9"	21'-9"	N/A	25'-4"	23'-5"	22'-4"	N/A

Depth	Series	Mid-Span Blocking				Mid-Span Blocking and 1/2" Gypsum Ceiling			
		On Centre Spacing				On Centre Spacing			
		12"	16"	19.2"	24"	12"	16"	19.2"	24"
9-1/2"	NI-20	15'-7"	14'-1"	13'-3"	N/A	15'-7"	14'-1"	13'-3"	N/A
	NI-40x	17'-9"	16'-1"	15'-1"	N/A	17'-9"	16'-1"	15'-1"	N/A
	NI-60	18'-1"	16'-4"	15'-4"	N/A	18'-1"	16'-4"	15'-4"	N/A
	NI-70	19'-2"	17'-10"	16'-9"	N/A	19'-7"	17'-10"	16'-9"	N/A
	NI-80	19'-5"	18'-0"	17'-1"	N/A	19'-10"	18'-3"	17'-1"	N/A
11-7/8"	NI-20	18'-9"	17'-0"	16'-0"	N/A	18'-9"	17'-0"	16'-0"	N/A
	NI-40x	21'-0"	19'-3"	17'-9"	N/A	21'-3"	19'-3"	17'-9"	N/A
	NI-60	21'-4"	19'-8"	18'-5"	N/A	21'-8"	19'-8"	18'-5"	N/A
	NI-70	22'-6"	20'-10"	19'-11"	N/A	23'-0"	21'-4"	20'-0"	N/A
	NI-80	22'-9"	21'-1"	20'-1"	N/A	23'-3"	21'-7"	20'-5"	N/A
14"	NI-90x	23'-4"	21'-8"	20'-8"	N/A	23'-10"	22'-2"	21'-2"	N/A
	NI-40x	23'-7"	21'-5"	19'-6"	N/A	24'-1"	21'-5"	19'-6"	N/A
	NI-60	24'-0"	22'-3"	21'-0"	N/A	24'-8"	22'-5"	21'-0"	N/A
	NI-70	25'-3"	23'-4"	22'-3"	N/A	25'-10"	24'-0"	22'-9"	N/A
	NI-80	25'-7"	23'-8"	22'-7"	N/A	26'-2"	24'-4"	23'-2"	N/A
16"	NI-90x	26'-4"	24'-4"	23'-3"	N/A	26'-10"	24'-11"	23'-9"	N/A
	NI-60	26'-5"	24'-6"	23'-4"	N/A	27'-2"	24'-10"	23'-4"	N/A
	NI-70	27'-9"	25'-8"	24'-6"	N/A	28'-5"	26'-5"	25'-2"	N/A
	NI-80	28'-2"	26'-1"	24'-10"	N/A	28'-10"	26'-9"	25'-6"	N/A
	NI-90x	29'-0"	26'-10"	25'-7"	N/A	29'-7"	27'-5"	26'-2"	N/A

- Maximum clear span applicable to simple-span residential floor construction with a design live load of 40 psf and dead load of 30 psf. The ultimate limit states are based on the factored loads of  $1.5DL + 1.25D$ . The serviceability limit states include the consideration for floor vibration, a live load deflection limit of L/480 and a total load deflection limit of L/240.
- Spans are based on a composite floor with glued-nailed oriented strand board (OSB) sheathing with a minimum thickness of 5/8 inch for a joist spacing of 19.2 inches or less. The composite floor may include 1/2 inch gypsum ceiling and/or one row of blocking at mid-span with strapping. Strapping shall be minimum 1x4 inch strap applied to underside of joists at blocking line or 1/2 inch gypsum ceiling attached to joists.
- Minimum bearing length shall be 1-3/4 inches for the end bearings.
- Bearing stiffeners are not required when I-joists are used with the spans and spacings given in this table, except as required for hangers.
- This span chart is based on uniform loads. For applications with other than uniformly distributed loads, an engineering analysis may be required based on the use of the design properties. Tables are based on Limit States Design per CSA O86-09, NBC 2010, and OBC 2012.
- Joists shall be laterally supported at supports and continuously along the compression edge. Refer to technical documentation for installation guidelines and construction details. Nordic I-joists are listed in CCMC evaluation report 13032-R and APA Product Report PR-L274C.




## Construction Detail Limit States Design

### Allowance for Piping (Installation Notes)

The floor layouts have usually not been checked for heating and/or plumbing interference. On-site adjustment of joists of up to 3 inches is permitted to avoid interferences. When moving a joist, the subfloor thickness shall be checked with code requirements when the joist spacing exceeds 19.2 inches. Except for cutting to length, I-joist flanges should never be cut, drilled, or notched.



Installation of Nordic I-joists shall be as per *Nordic Joist Installation Guide for Residential Floors*. Refer to Tables 1 and 2 for maximum web hole and duct chase openings, respectively. These tables are based on the I-joists being used at their maximum spans. The minimum distance given may be reduced for shorter spans; contact your distributor for additional information.

The detail below shows the 3-inch allowance for piping. Every third joist may be shifted up to 3 inches to avoid heating/plumbing interference. For other applications, please contact your distributor.

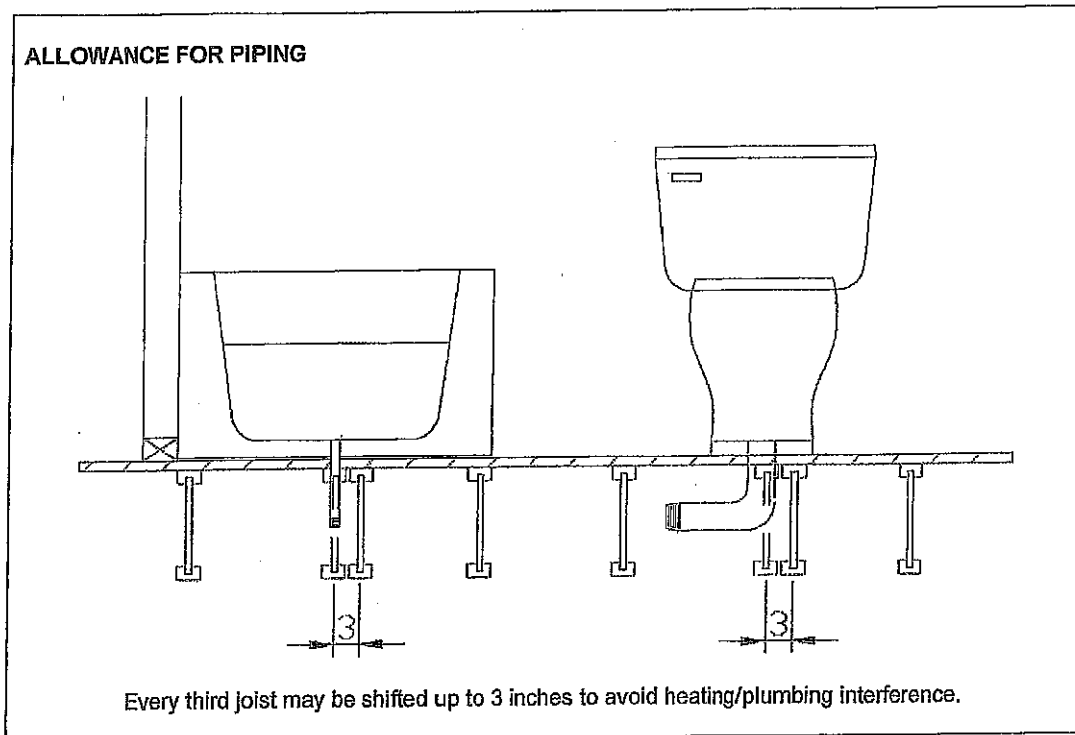

Revised April 12, 2012

1W-1

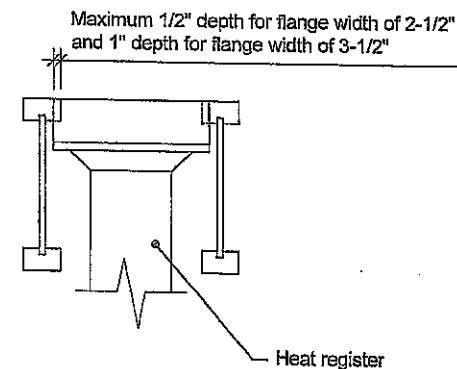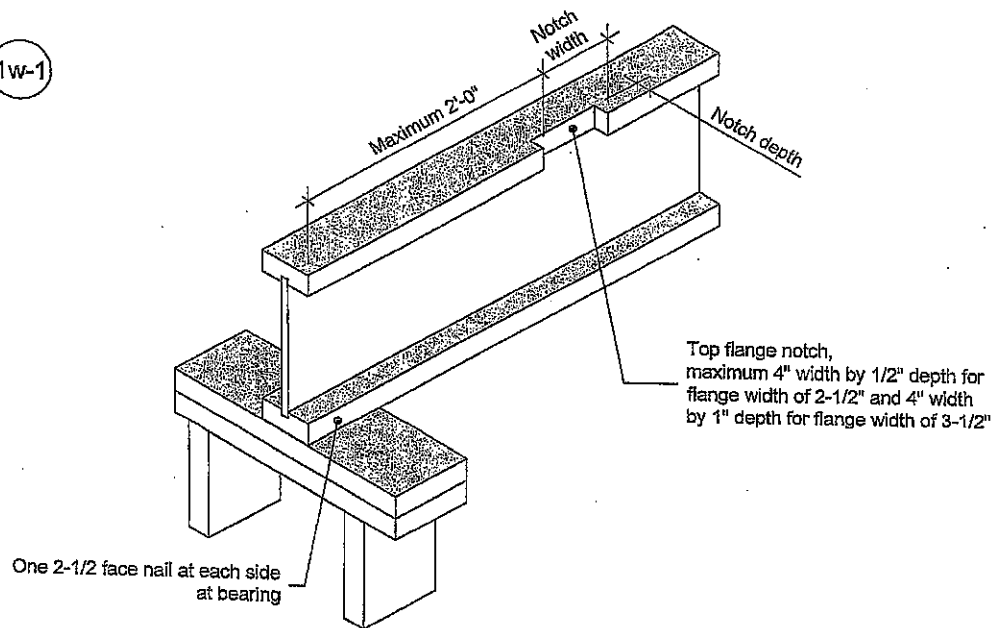

**Notes:**

1. Blocking required at bearing for lateral support, not shown for clarity.
2. The maximum dimensions for a notch on the side of the top flange are 4-inch width by 1/2-inch depth for flange width of 2-1/2 inches, and 4-inch width by 1-inch depth for flange width of 3-1/2 inches.
3. This detail applies to simple-span joists and multiple-span joists where the notch is located at the end half-span.
4. For other applications, contact Nordic Structures.

This document supersedes all previous versions. If the document has been in effect for more than one year, consult [nordic.ca](http://nordic.ca) or contact Nordic Structures.

All nails shown in the details are assumed to be common nails unless otherwise noted. Nails shall have a diameter not less than 0.128 inch for 2-1/2-inch nails, or 0.144 inch for 3-inch nails. Individual components not shown to scale for clarity.

**NORDIC**  
**STRUCTURES**

T 514-871-8526  
1 866 817-3418

[nordic.ca](http://nordic.ca)

**TITLE**

Notch in I-joist for Heat Register

**CATEGORY**

I-joist - Typical Floor Framing and Construction Details

**DOCUMENT**

-

**DATE**

2018-04-10

**NUMBER**

1W-1